
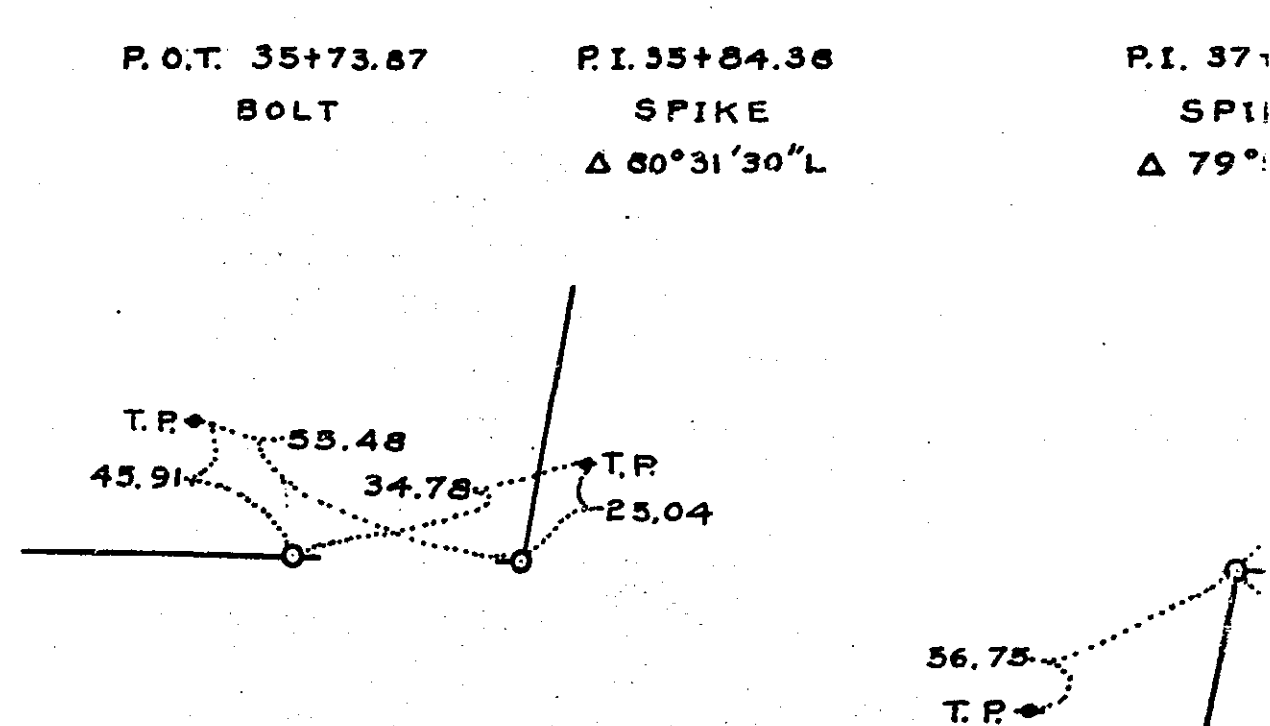
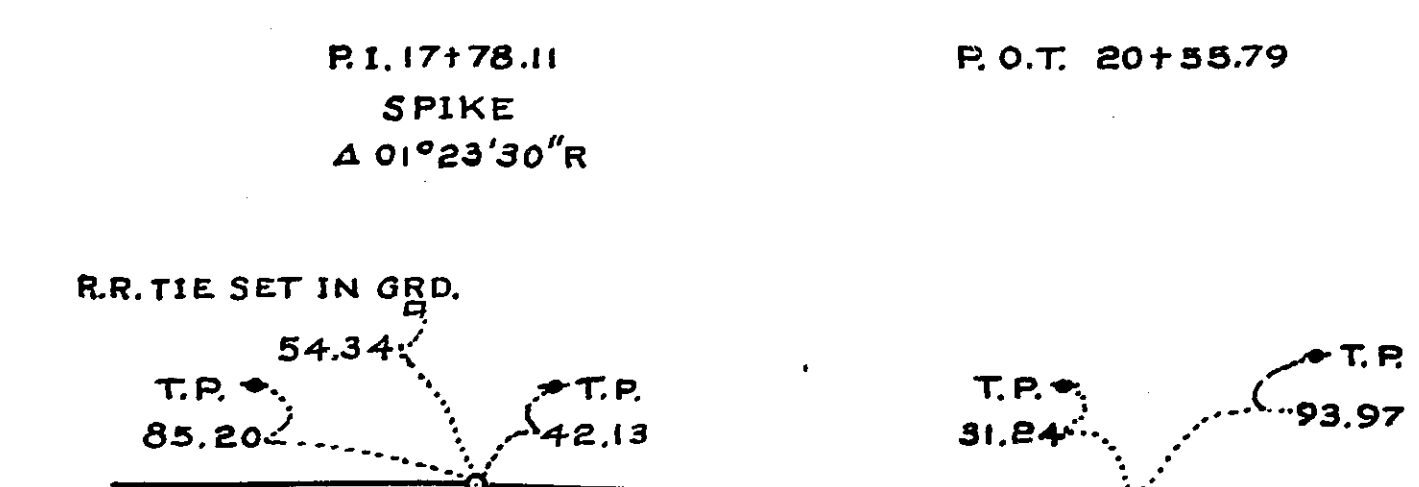
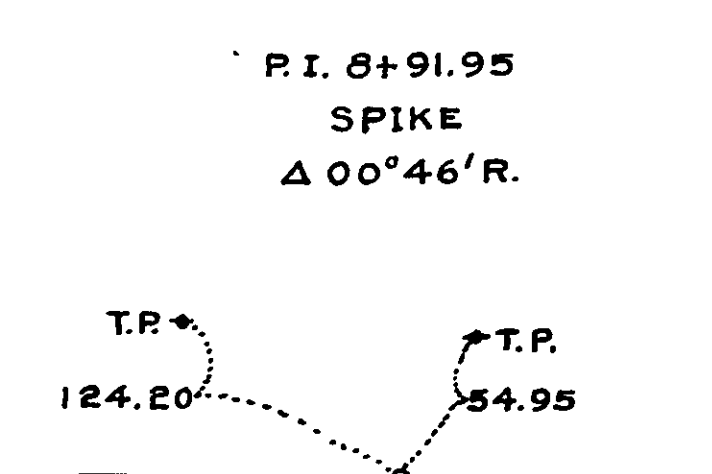
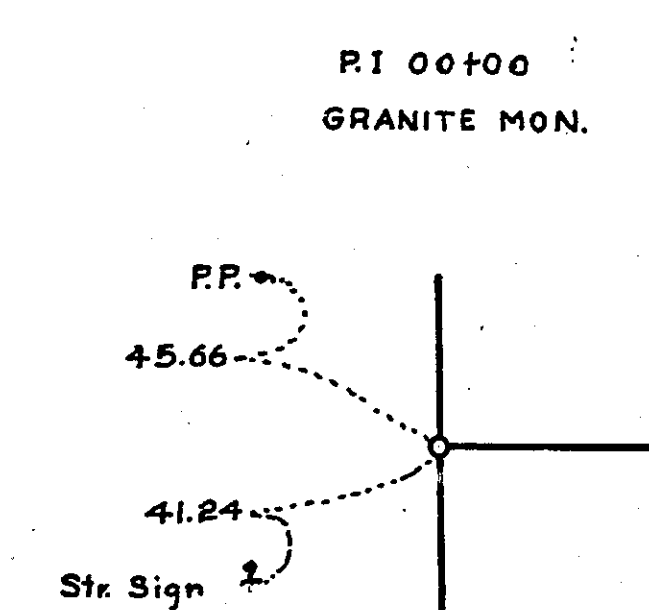


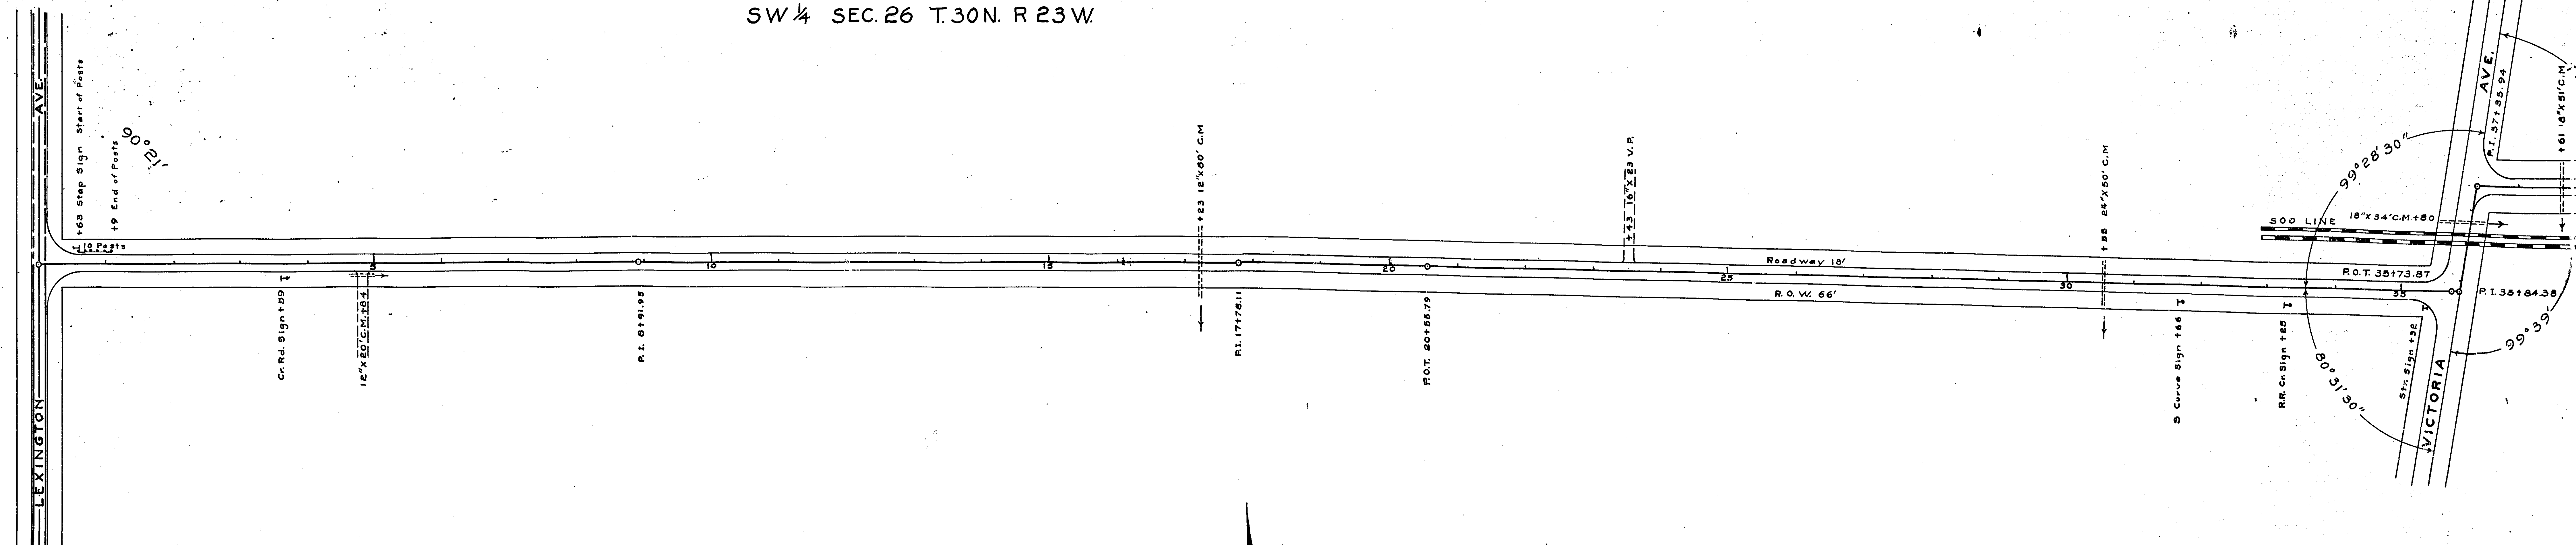



ROAD MAP
COUNTY ROAD E
FROM LEXINGTON AVE. TO RICE STREET
ROAD NO. 6

SE 1/4 SEC. 26 T.30N. R.23W.

SW 1/4 SEC. 25 T.30N. R.23W.

NE 1/4 SEC. 35 T.30N. R.23W.


NW 1/4 SEC. 36 T.30N. R.23W.

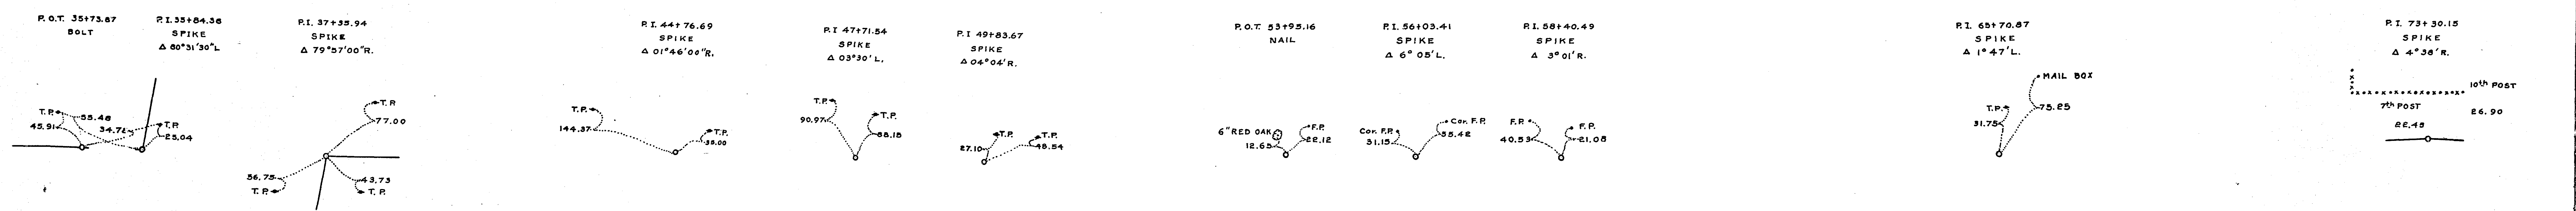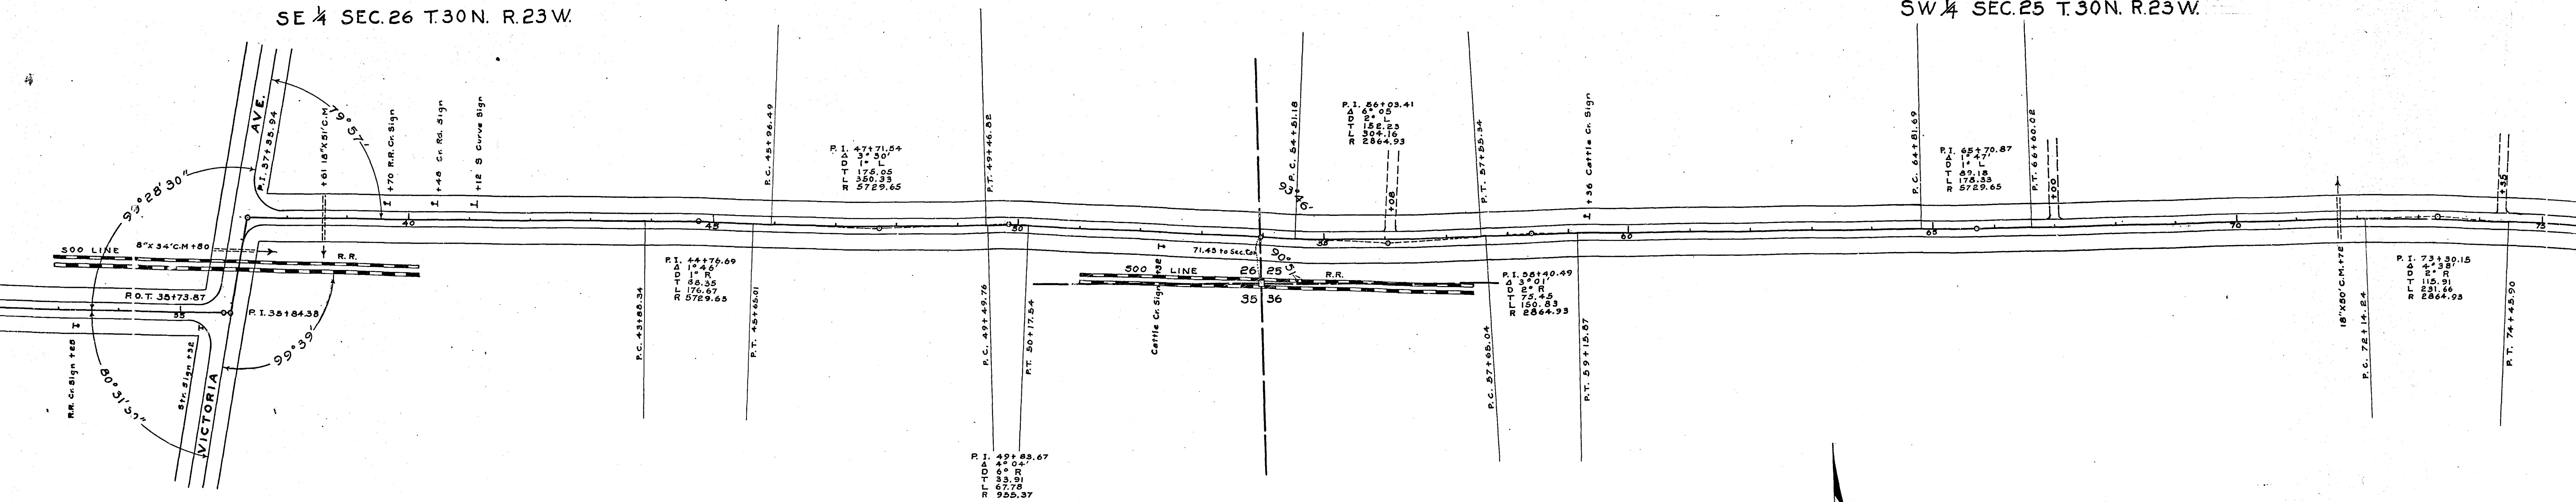

ROAD MAP
COUNTY ROAD E
FROM LEXINGTON AVE. TO RICE STREET
ROAD NO. 6

SE 1/4 SEC. 25 T. 30 N. R. 23 W.

NW 1/4 SEC. 36 T. 30 N. R. 23 W.

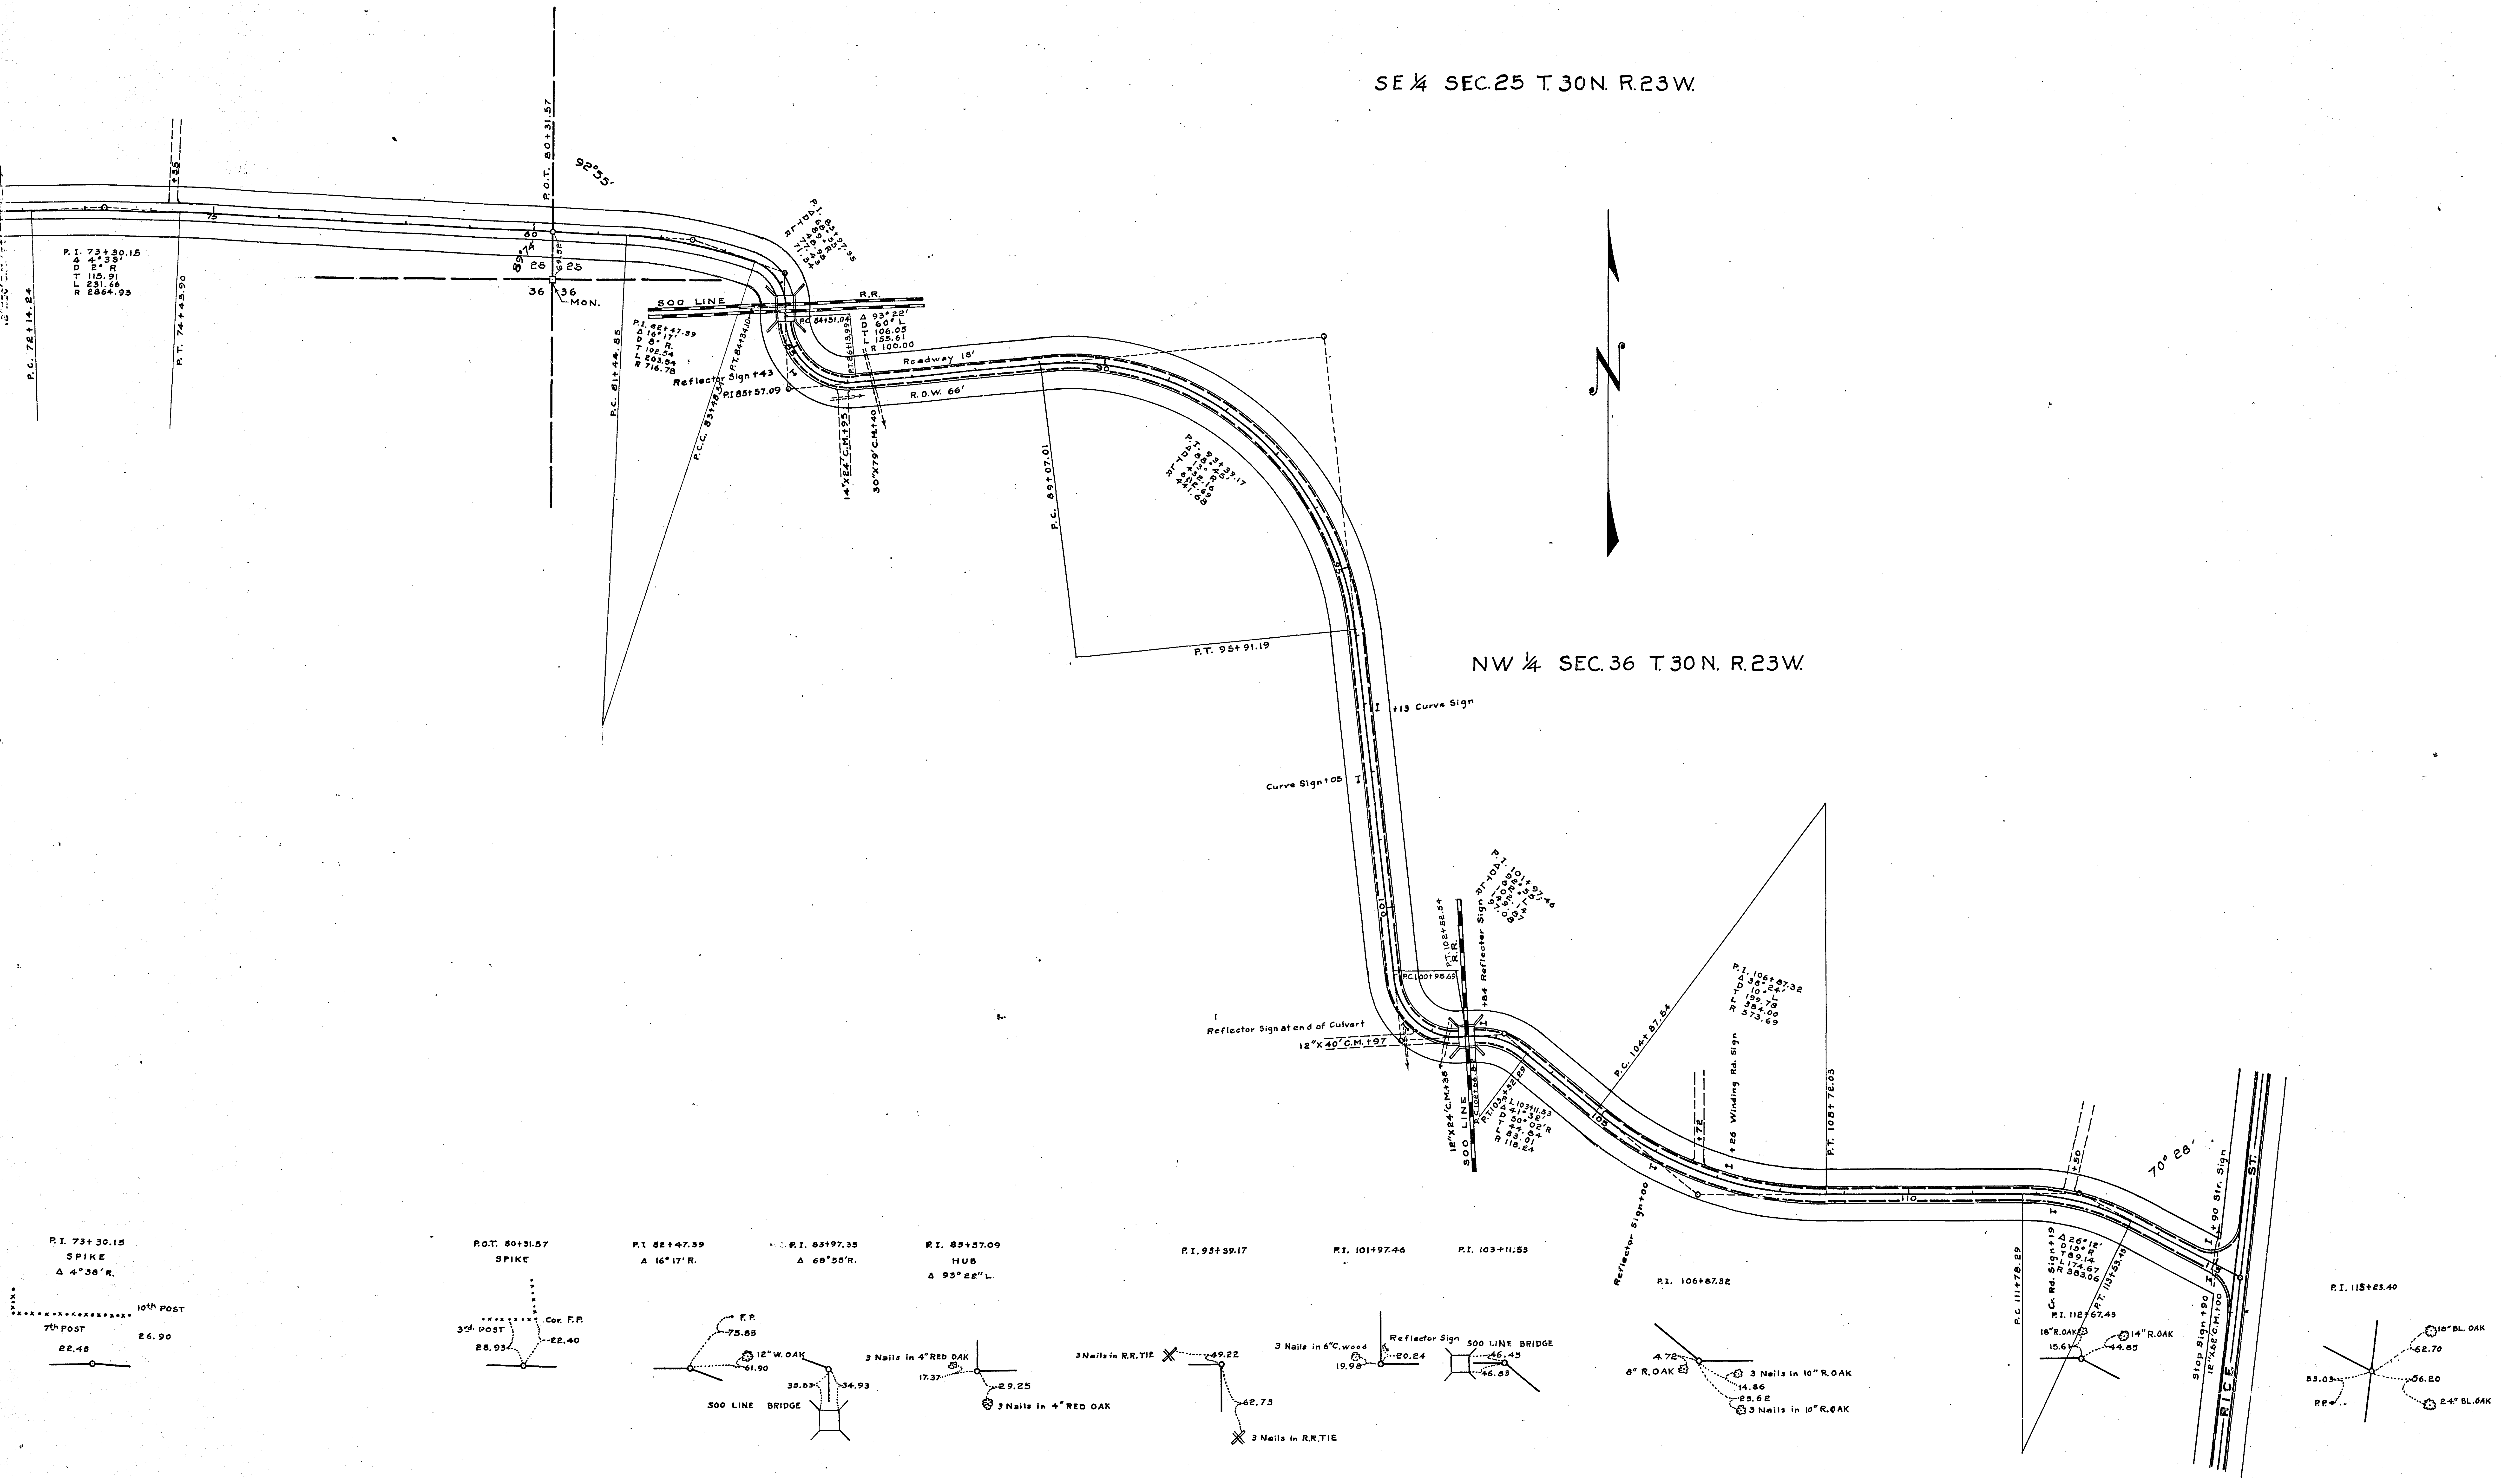

ROAD MAP
COUNTY ROAD E
FROM LEXINGTON AVE. TO RICE STREET
ROAD NO. 6

SE ¼ SEC. 27-30-23

NE ¼ SEC. 34-30-23

20+00

25+00

30+00

35+00

40+00

45+00

50+00

AVE

LEXINGTON

PI. 40+81.80
Δ: 0°57' L

PI. 49+73.75
Δ: 0°46' R

F-8 / 1.1

SE 1/4 SEC. 26 T. 30 N. R. 23 W.

SW 1/4 SEC. 25 T. 30 N. R. 23 W.

NE 1/4 SEC. 35 T. 30 N. R. 23 W.

NW 1/4 SEC. 36 T. 30 N. R. 23 W.

ROAD MAP
COUNTY ROAD E
FROM LEXINGTON AVE. TO RICE STREET
ROAD NO. 6

SW ¼ SEC. 26-30-23

SE ¼ SEC. 26



50+00

55+00

60+00

75+00

80+00

N.W. ¼ SEC. 35-30-23

N.E. ¼ SEC. 35-30

PI. 49+73.75
Δ-0°46'R

P.O.T. 57+62.15

PI. 61+13.05
Δ-7°35'R

PI. 64+45.32
Δ-5°30'R

PI. 66+64.91
Δ-29°00'L

PI. 69+45.50
Δ-16°11'R

PI. 76+66.95
Δ-75°41'L

PI. 78+17.25
Δ-74°13'R

Δ-7°35'
D-1°30'R
T-253.14
L-505.55
R-3819.83

PT. 63+65.46
PC. 63+76.51
Δ-5°30'
D-4°R
T-68.81
L-137.30
R-1432.69
PT. 65+14.01

PC. 65+16.94
Δ-29°00'
D-15°L
T-99.07
L-183.33
R-383.06
PT. 67+31.51


PC. 68+14.44
Δ-16°11'
D-0°R
T-131.06
L-259.76
R-819.02
PT. 70+74.20

S.E. ¼ SEC. 26-30-23

S.W. ¼ SEC. 25-30-23


N.E. ¼ SEC. 35-30-23

N.W. ¼ SEC. 36-30-23

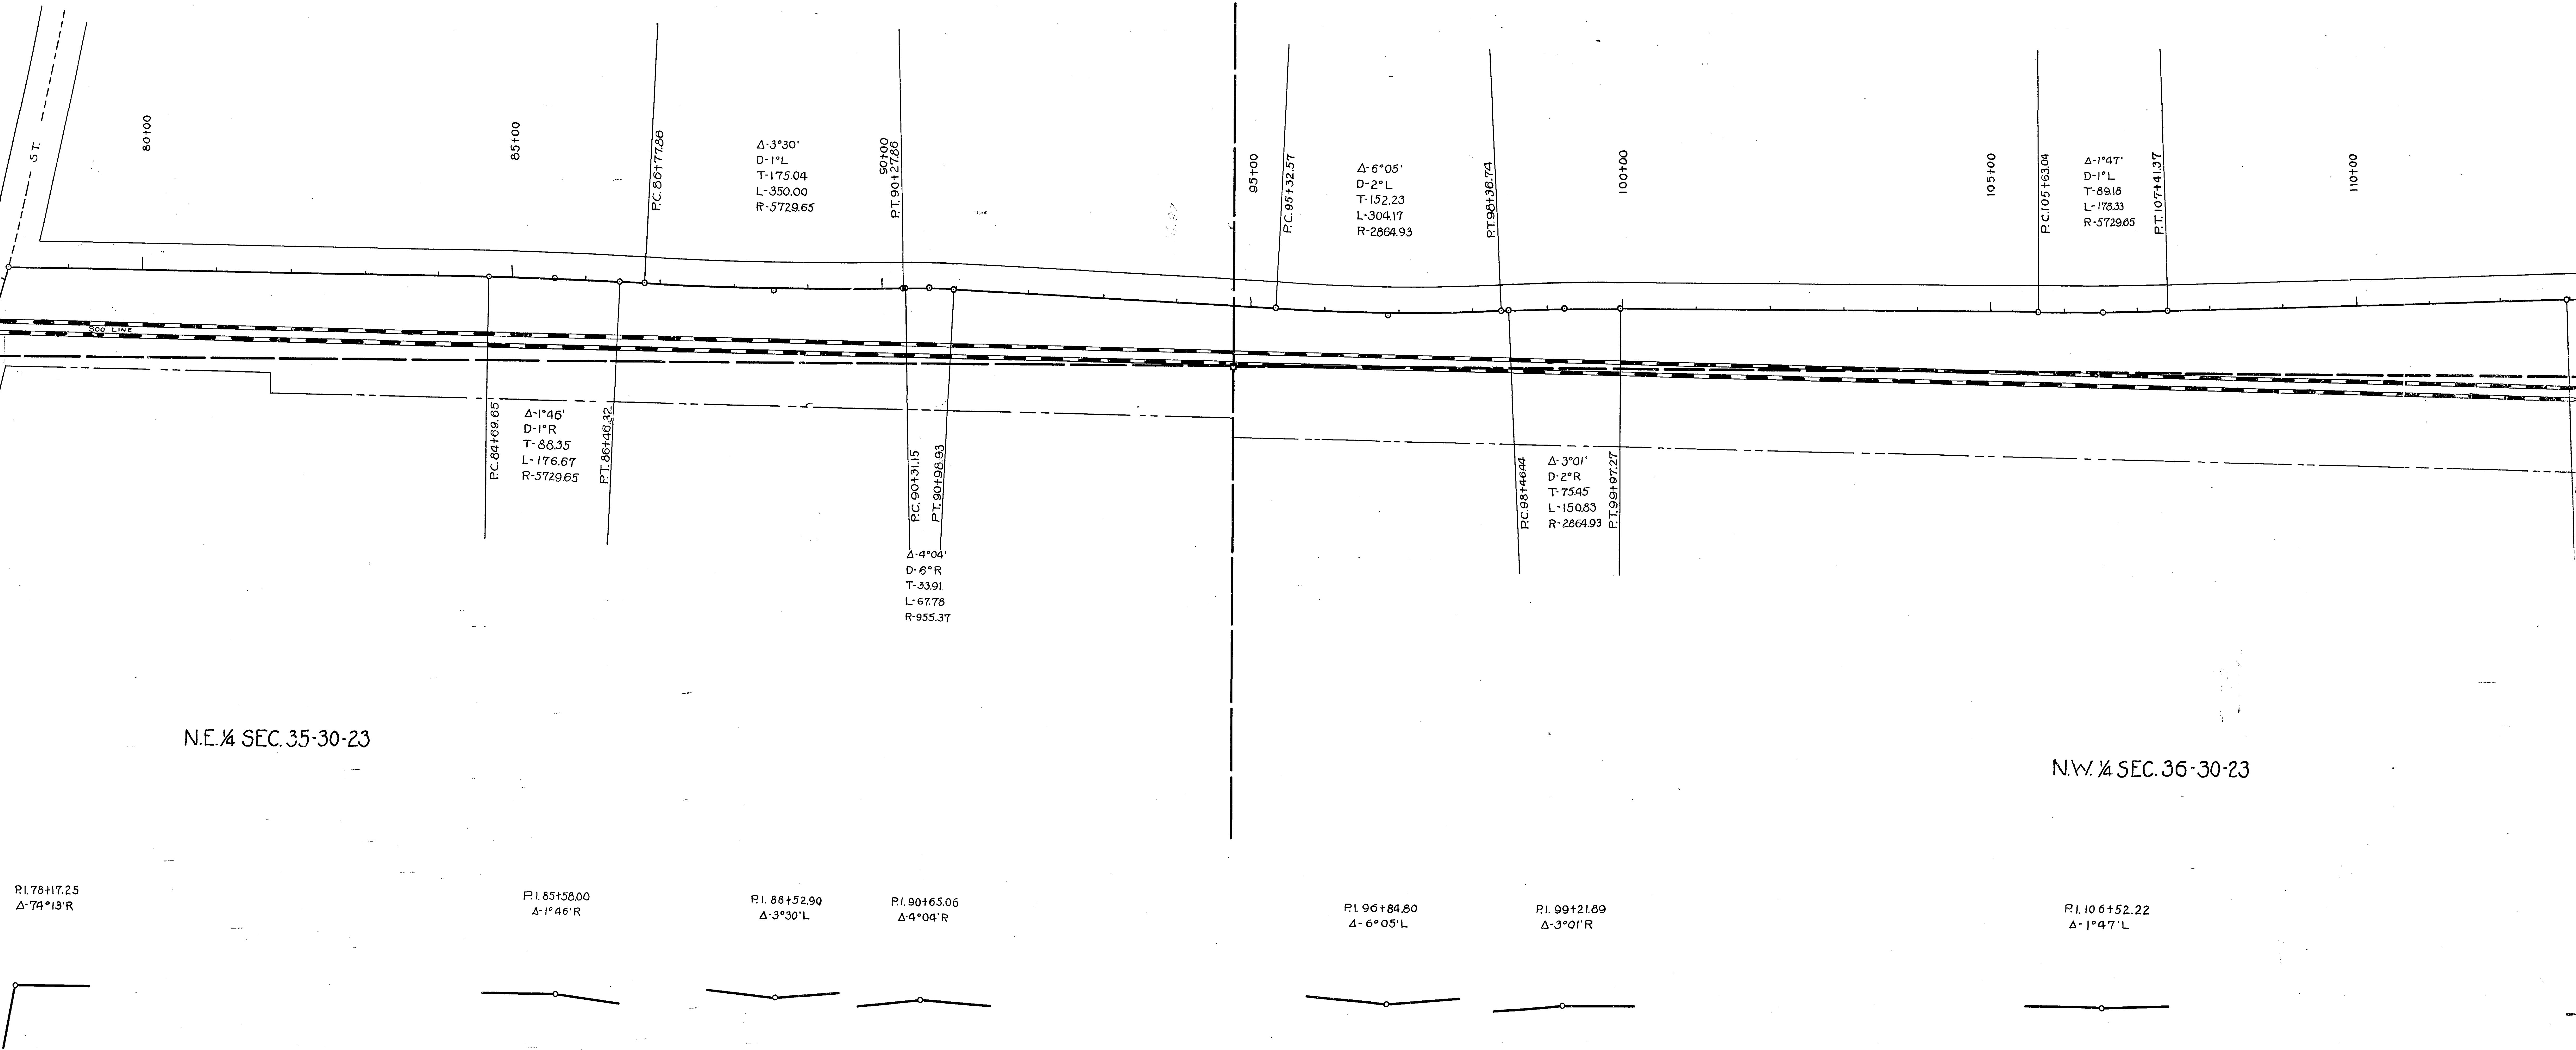


S.W. ¼ SEC. 25-30-23

S.E. ¼ SEC. 25-30-23

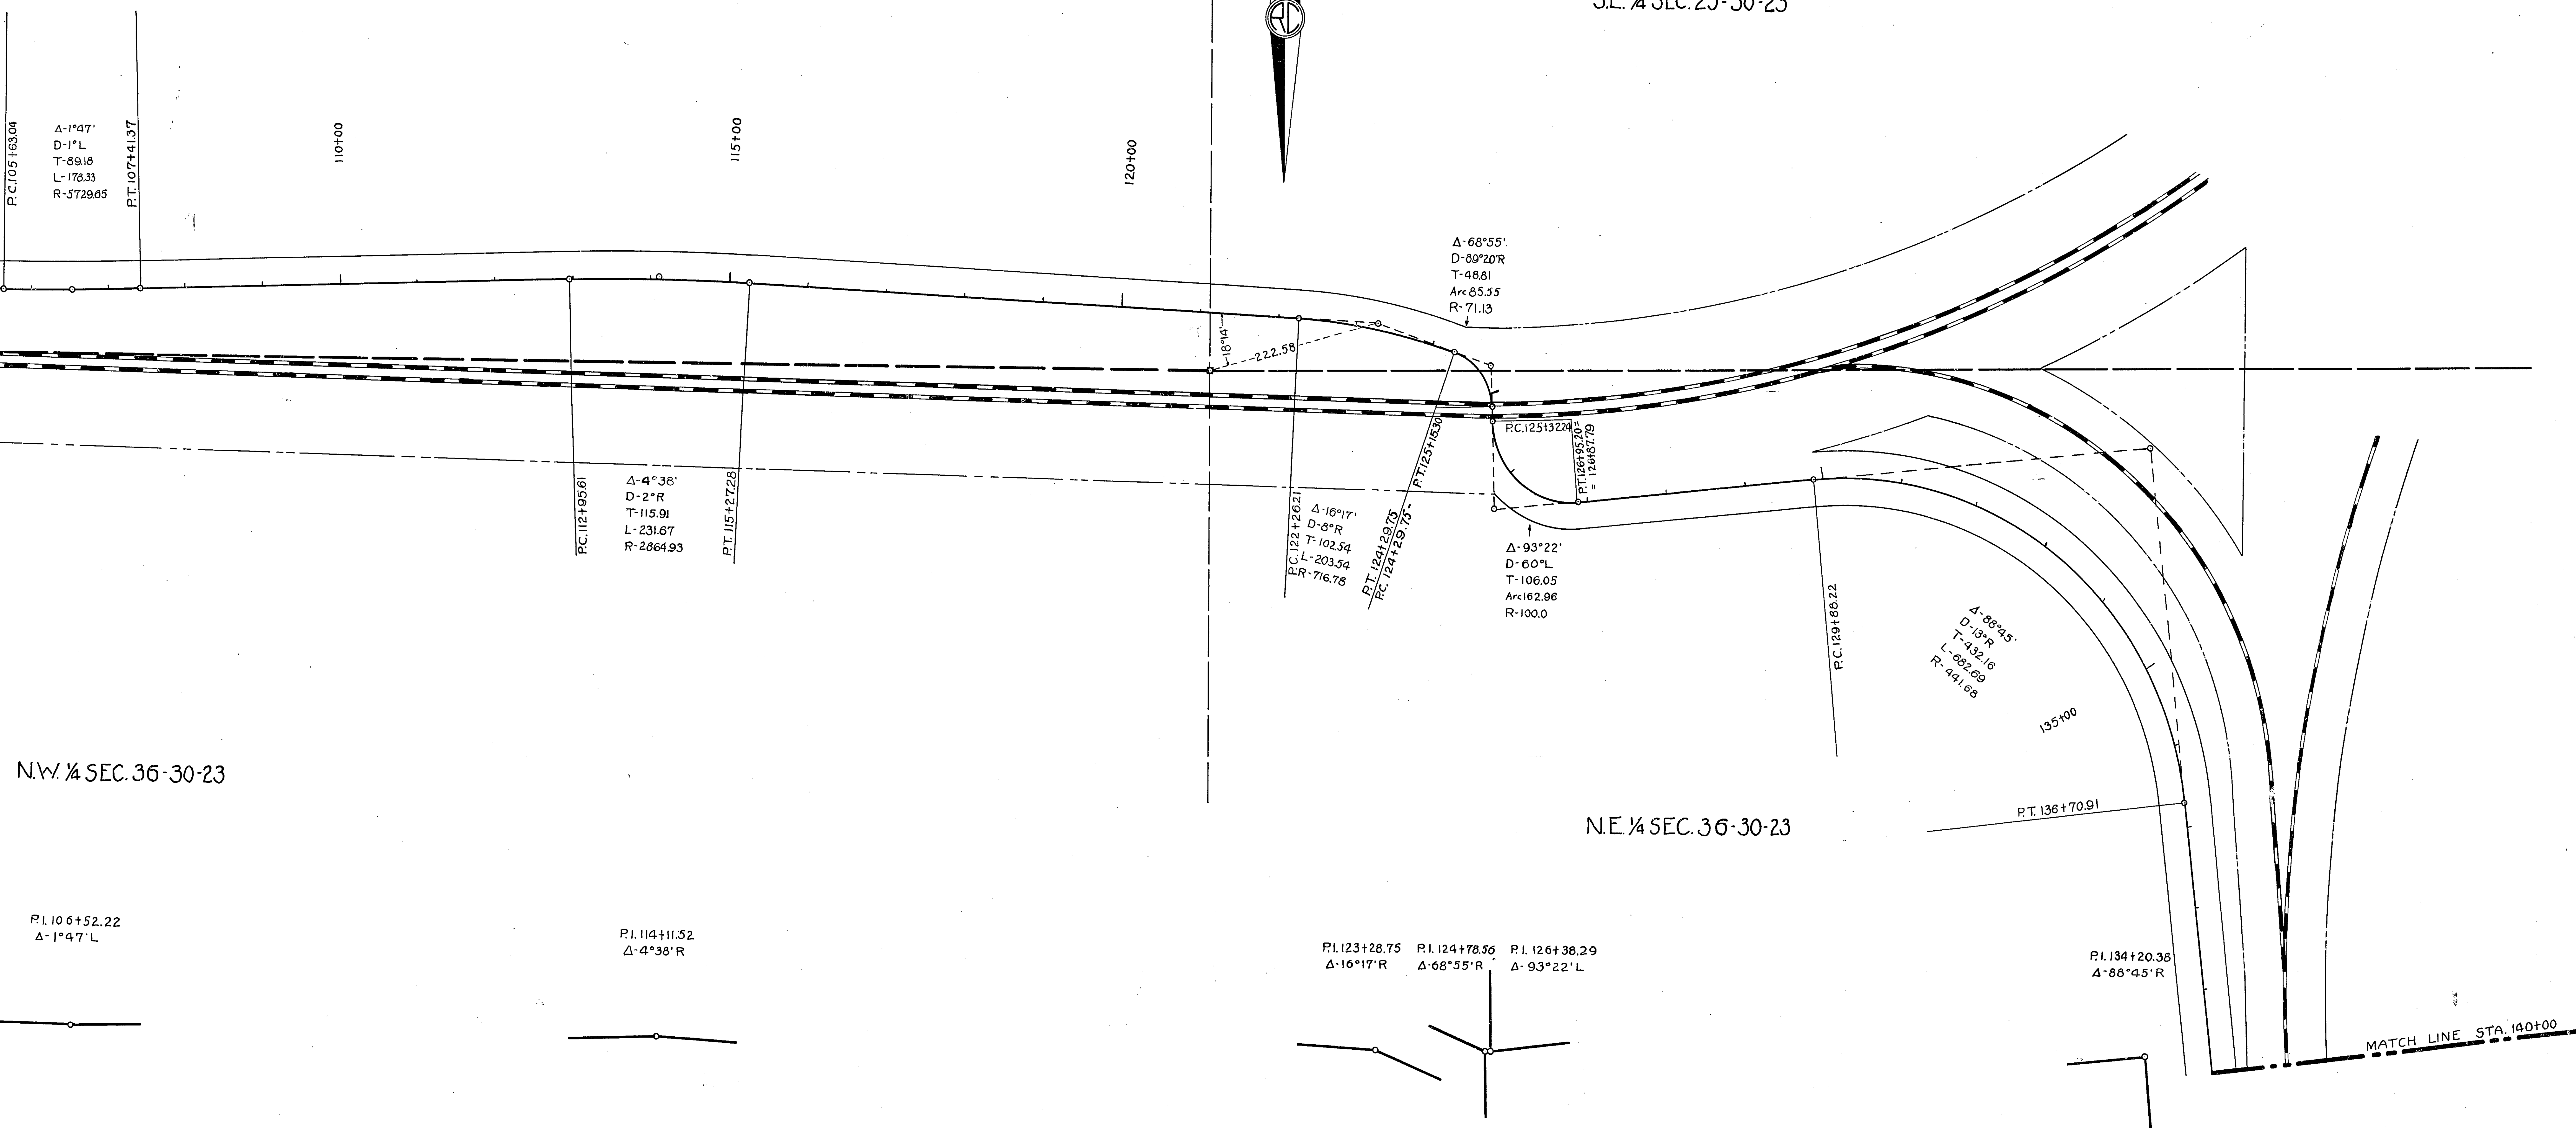

F 11 / 11

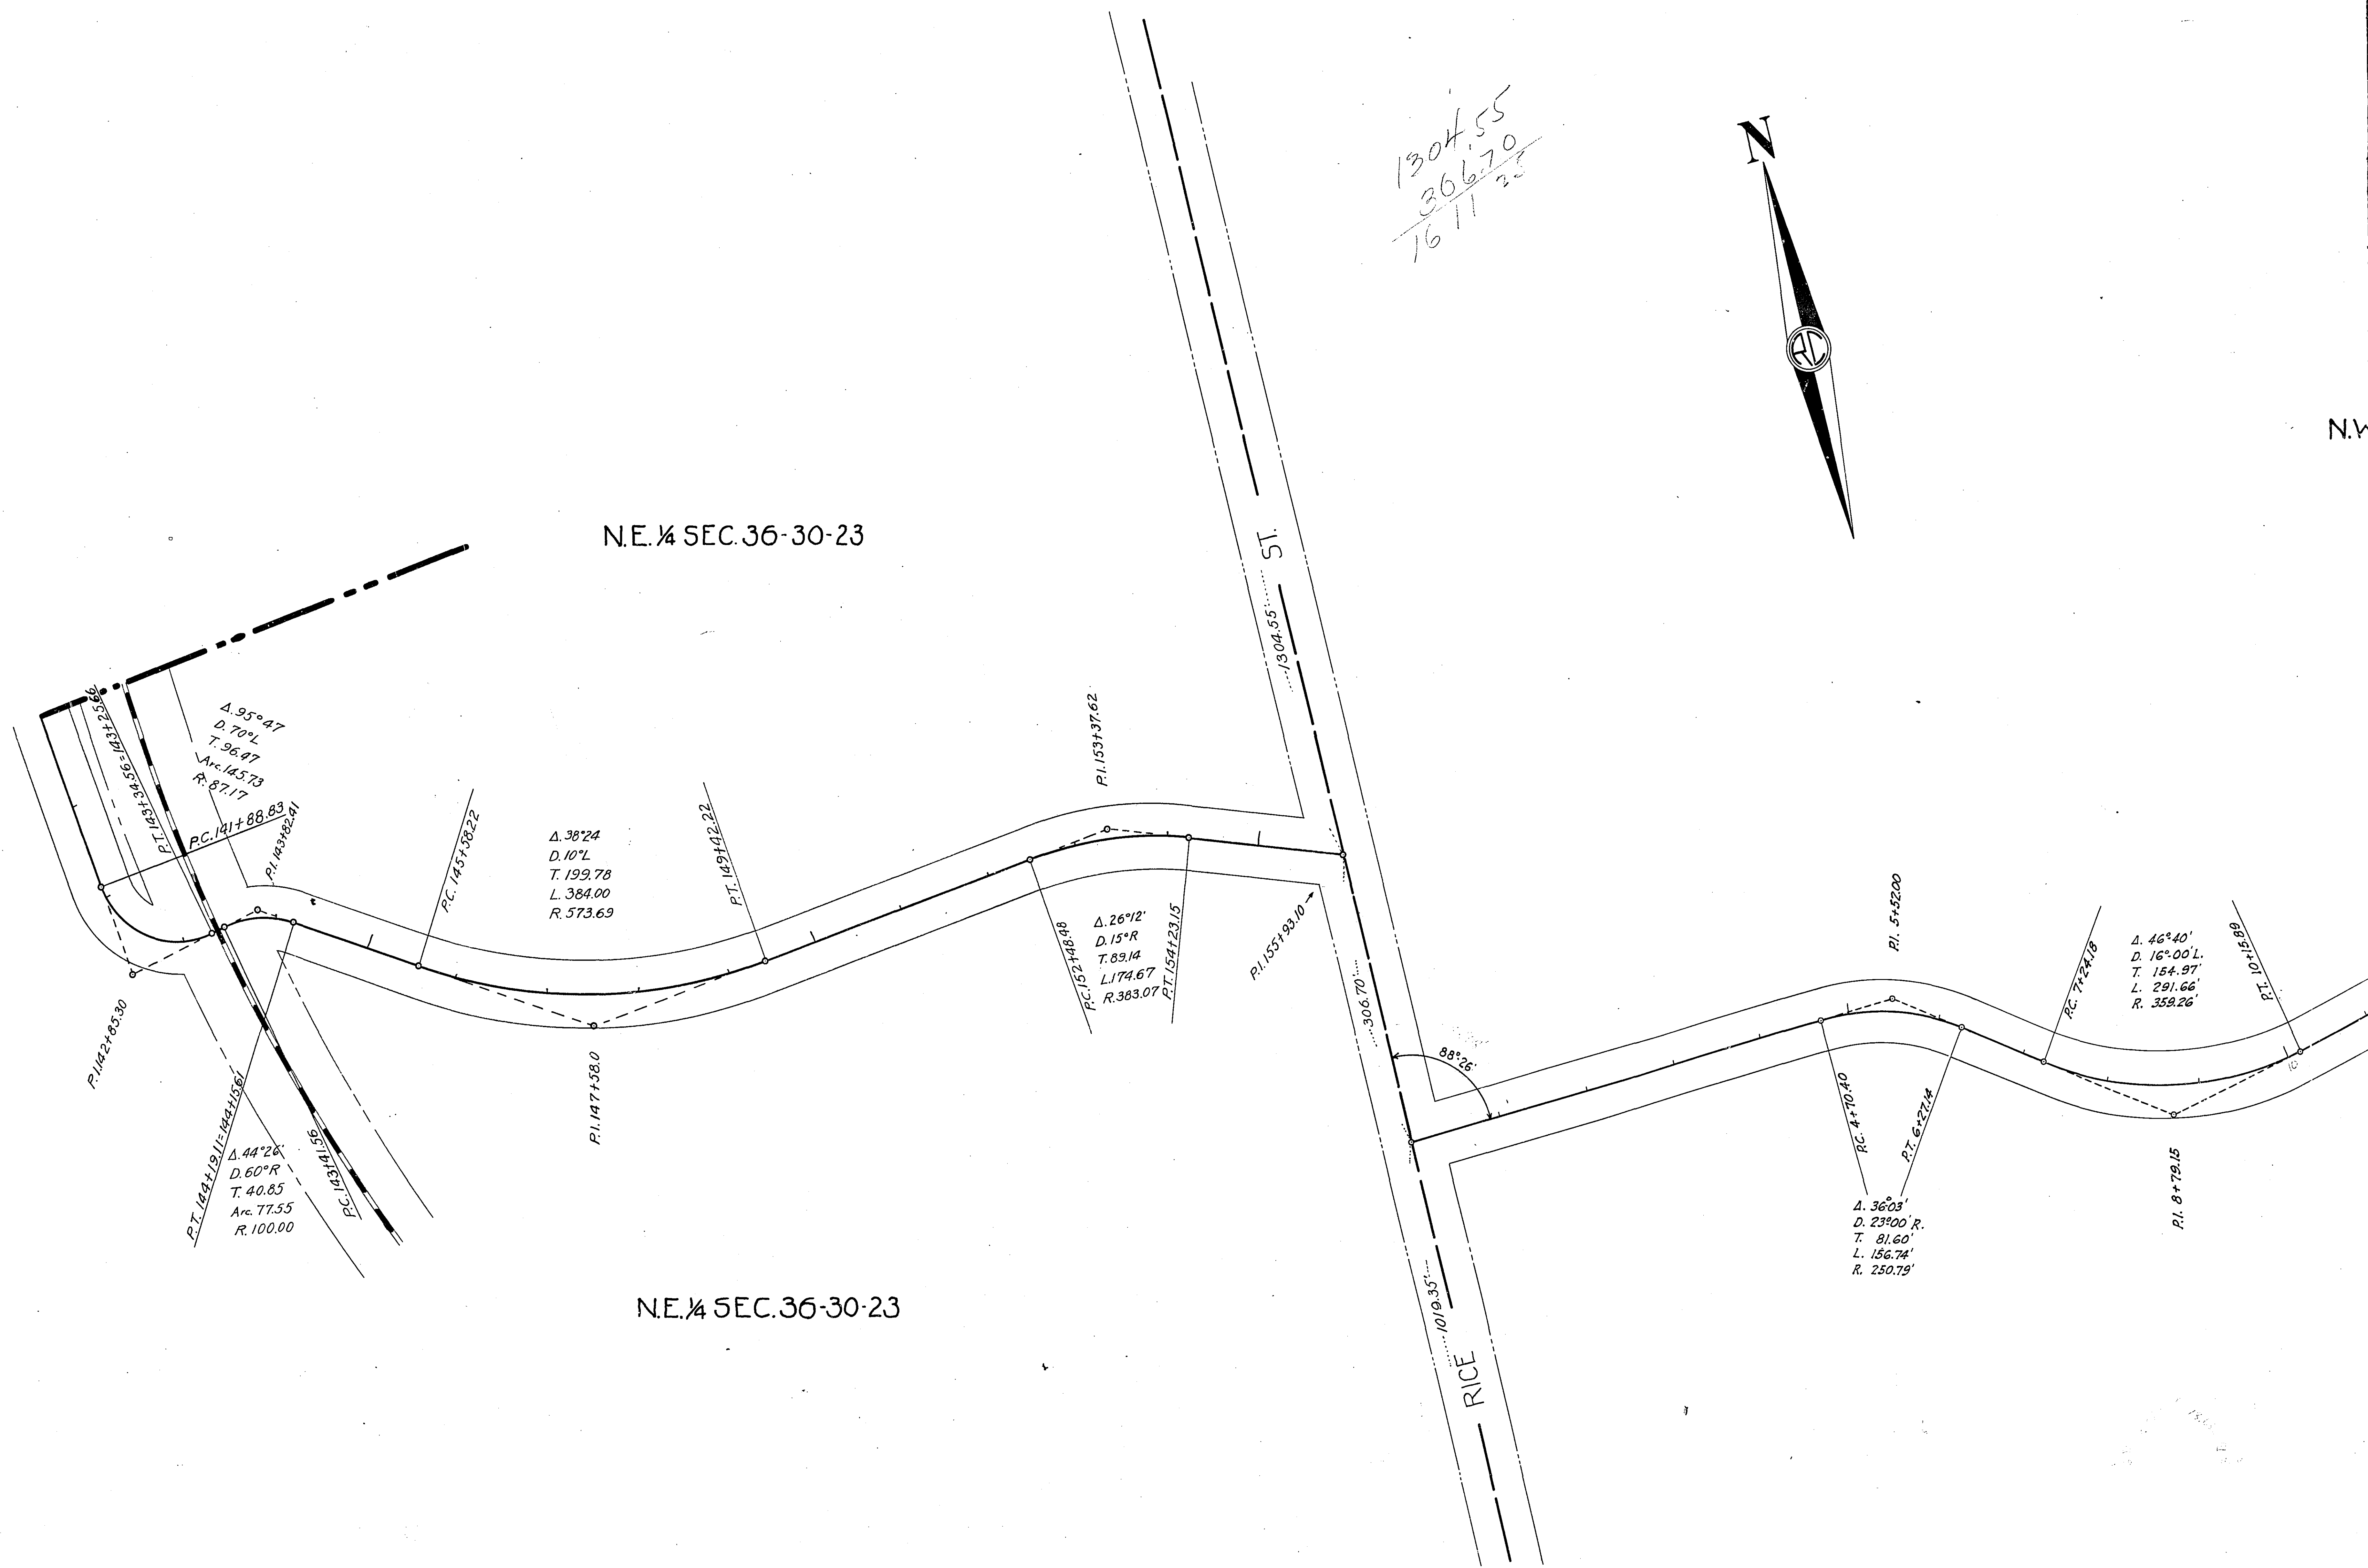


20 X F 1 / 11

N.W. ¼ SEC. 31-30-22

N.E. ¼ SEC. 31-30-22

N.W. ¼ SEC. 31-30-22


S.E. ¼ SEC. 31-30-22

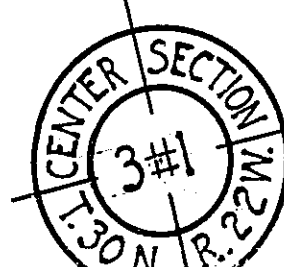

F. 2 / 11

N.E. 1/4 SEC. 31-30-22

N.W. 1/4 SEC. 32-30-22 N.W. 1/4 SEC. 32-30-22

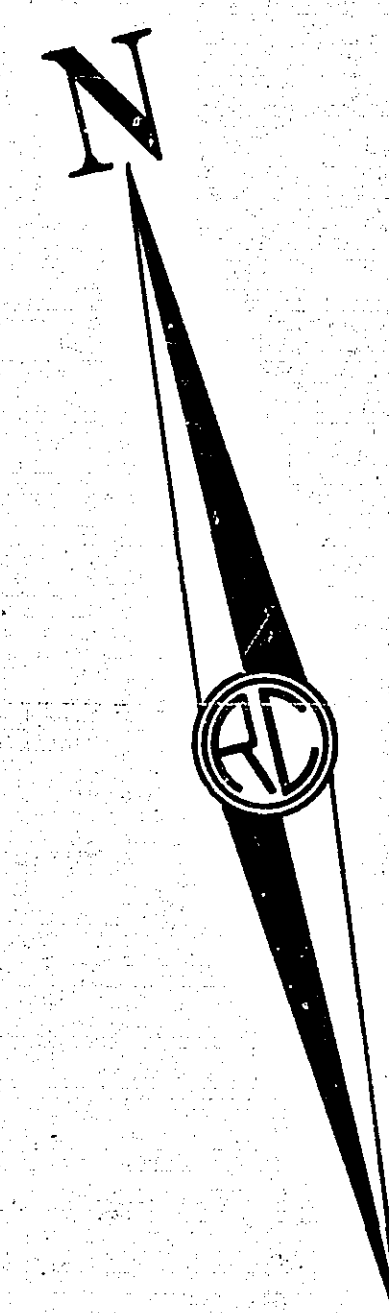

LAKE VADNAIS

S.W. 1/4 SEC. 32-30-22

S.E. 1/4 SEC. 31-30-22

F-3 / -1,1