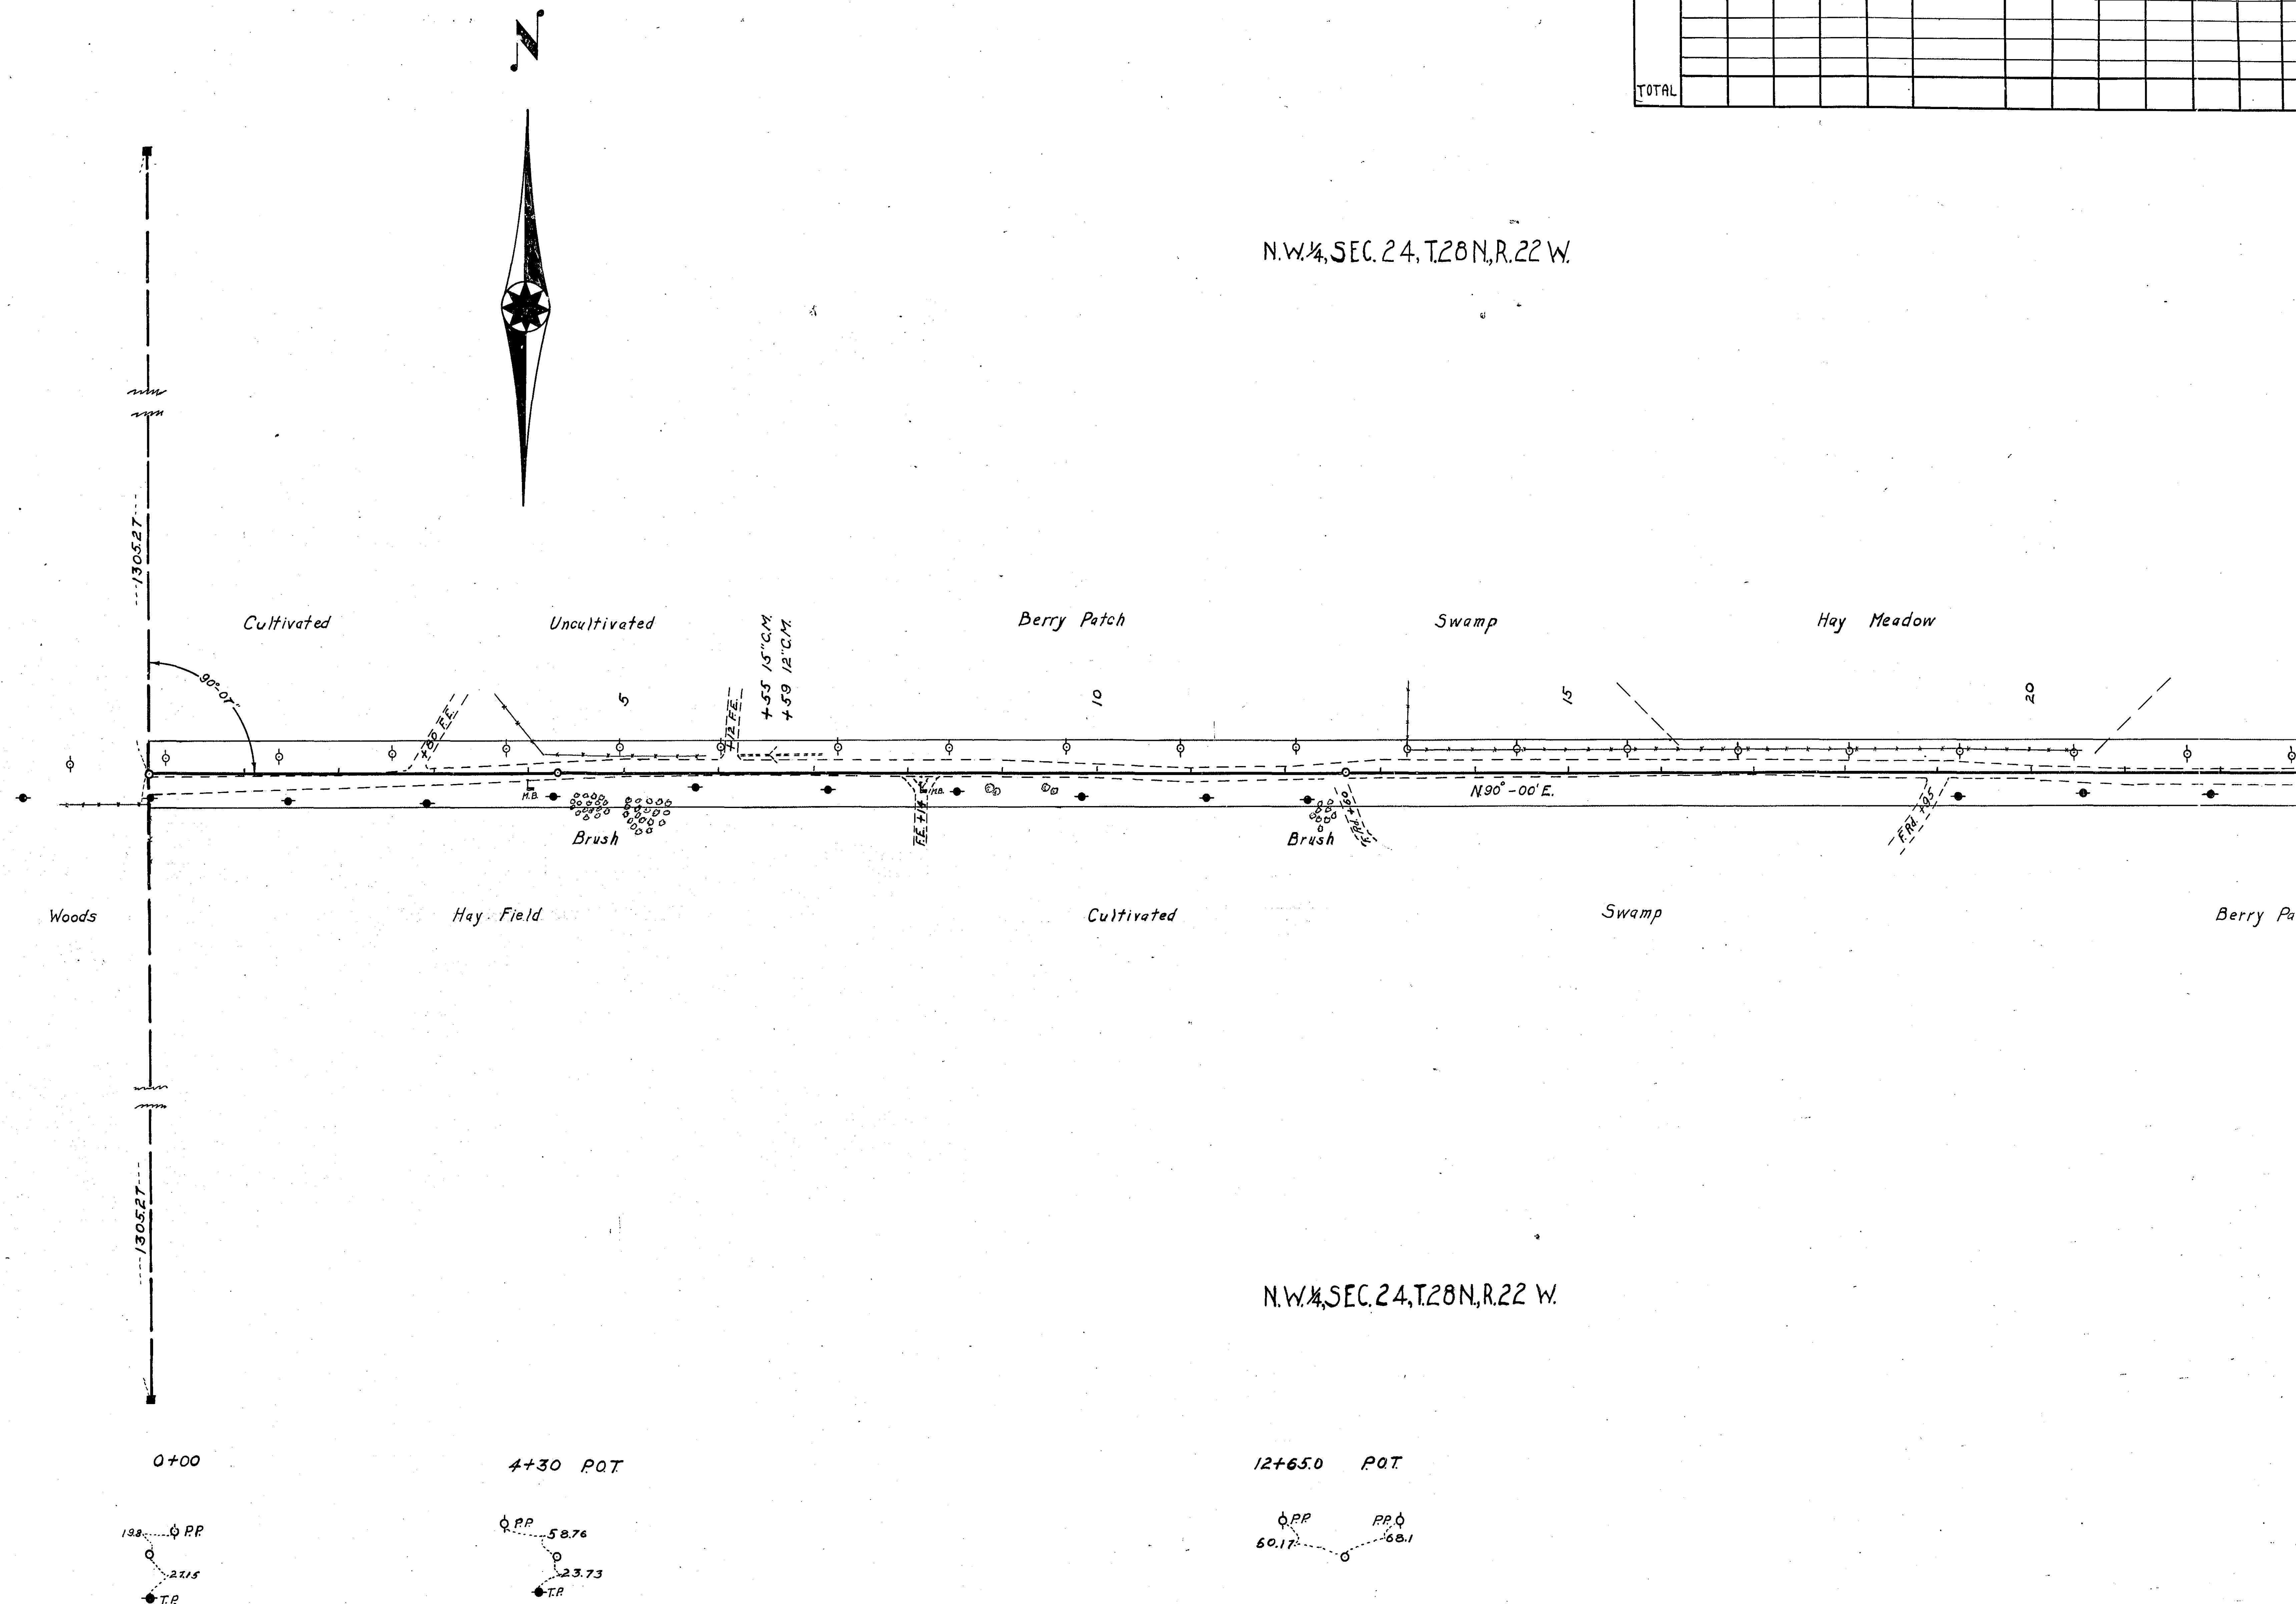
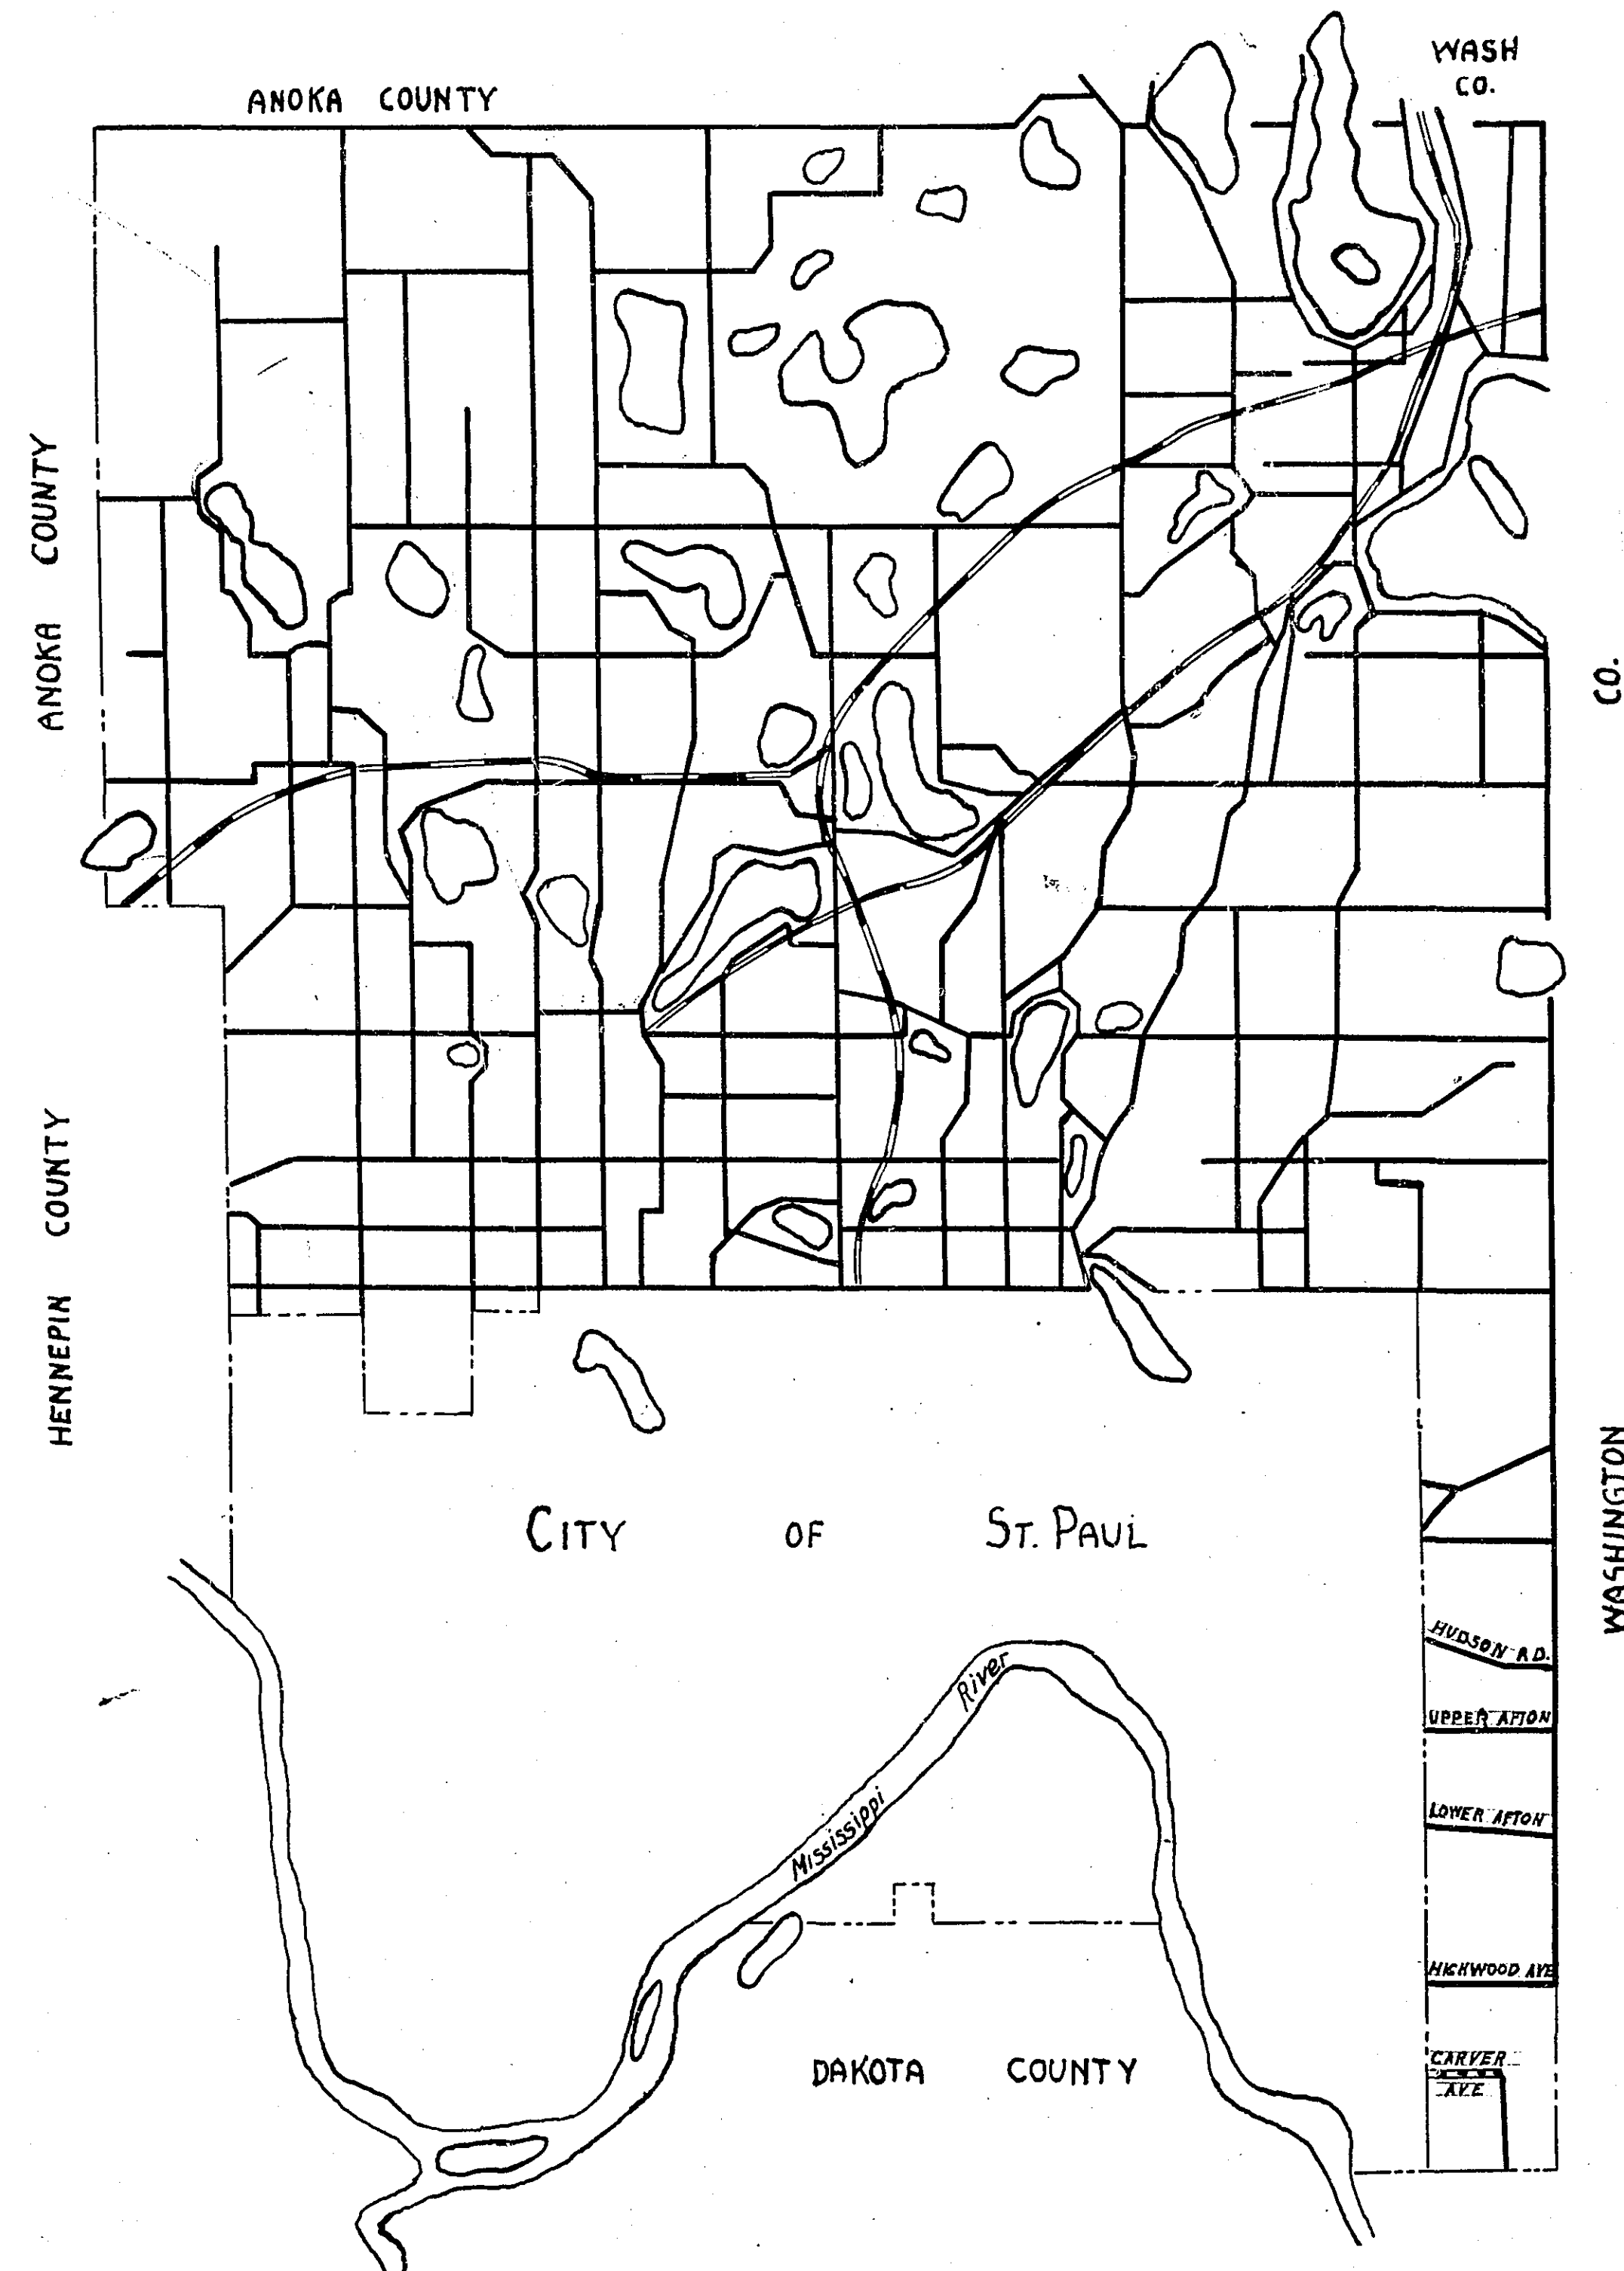
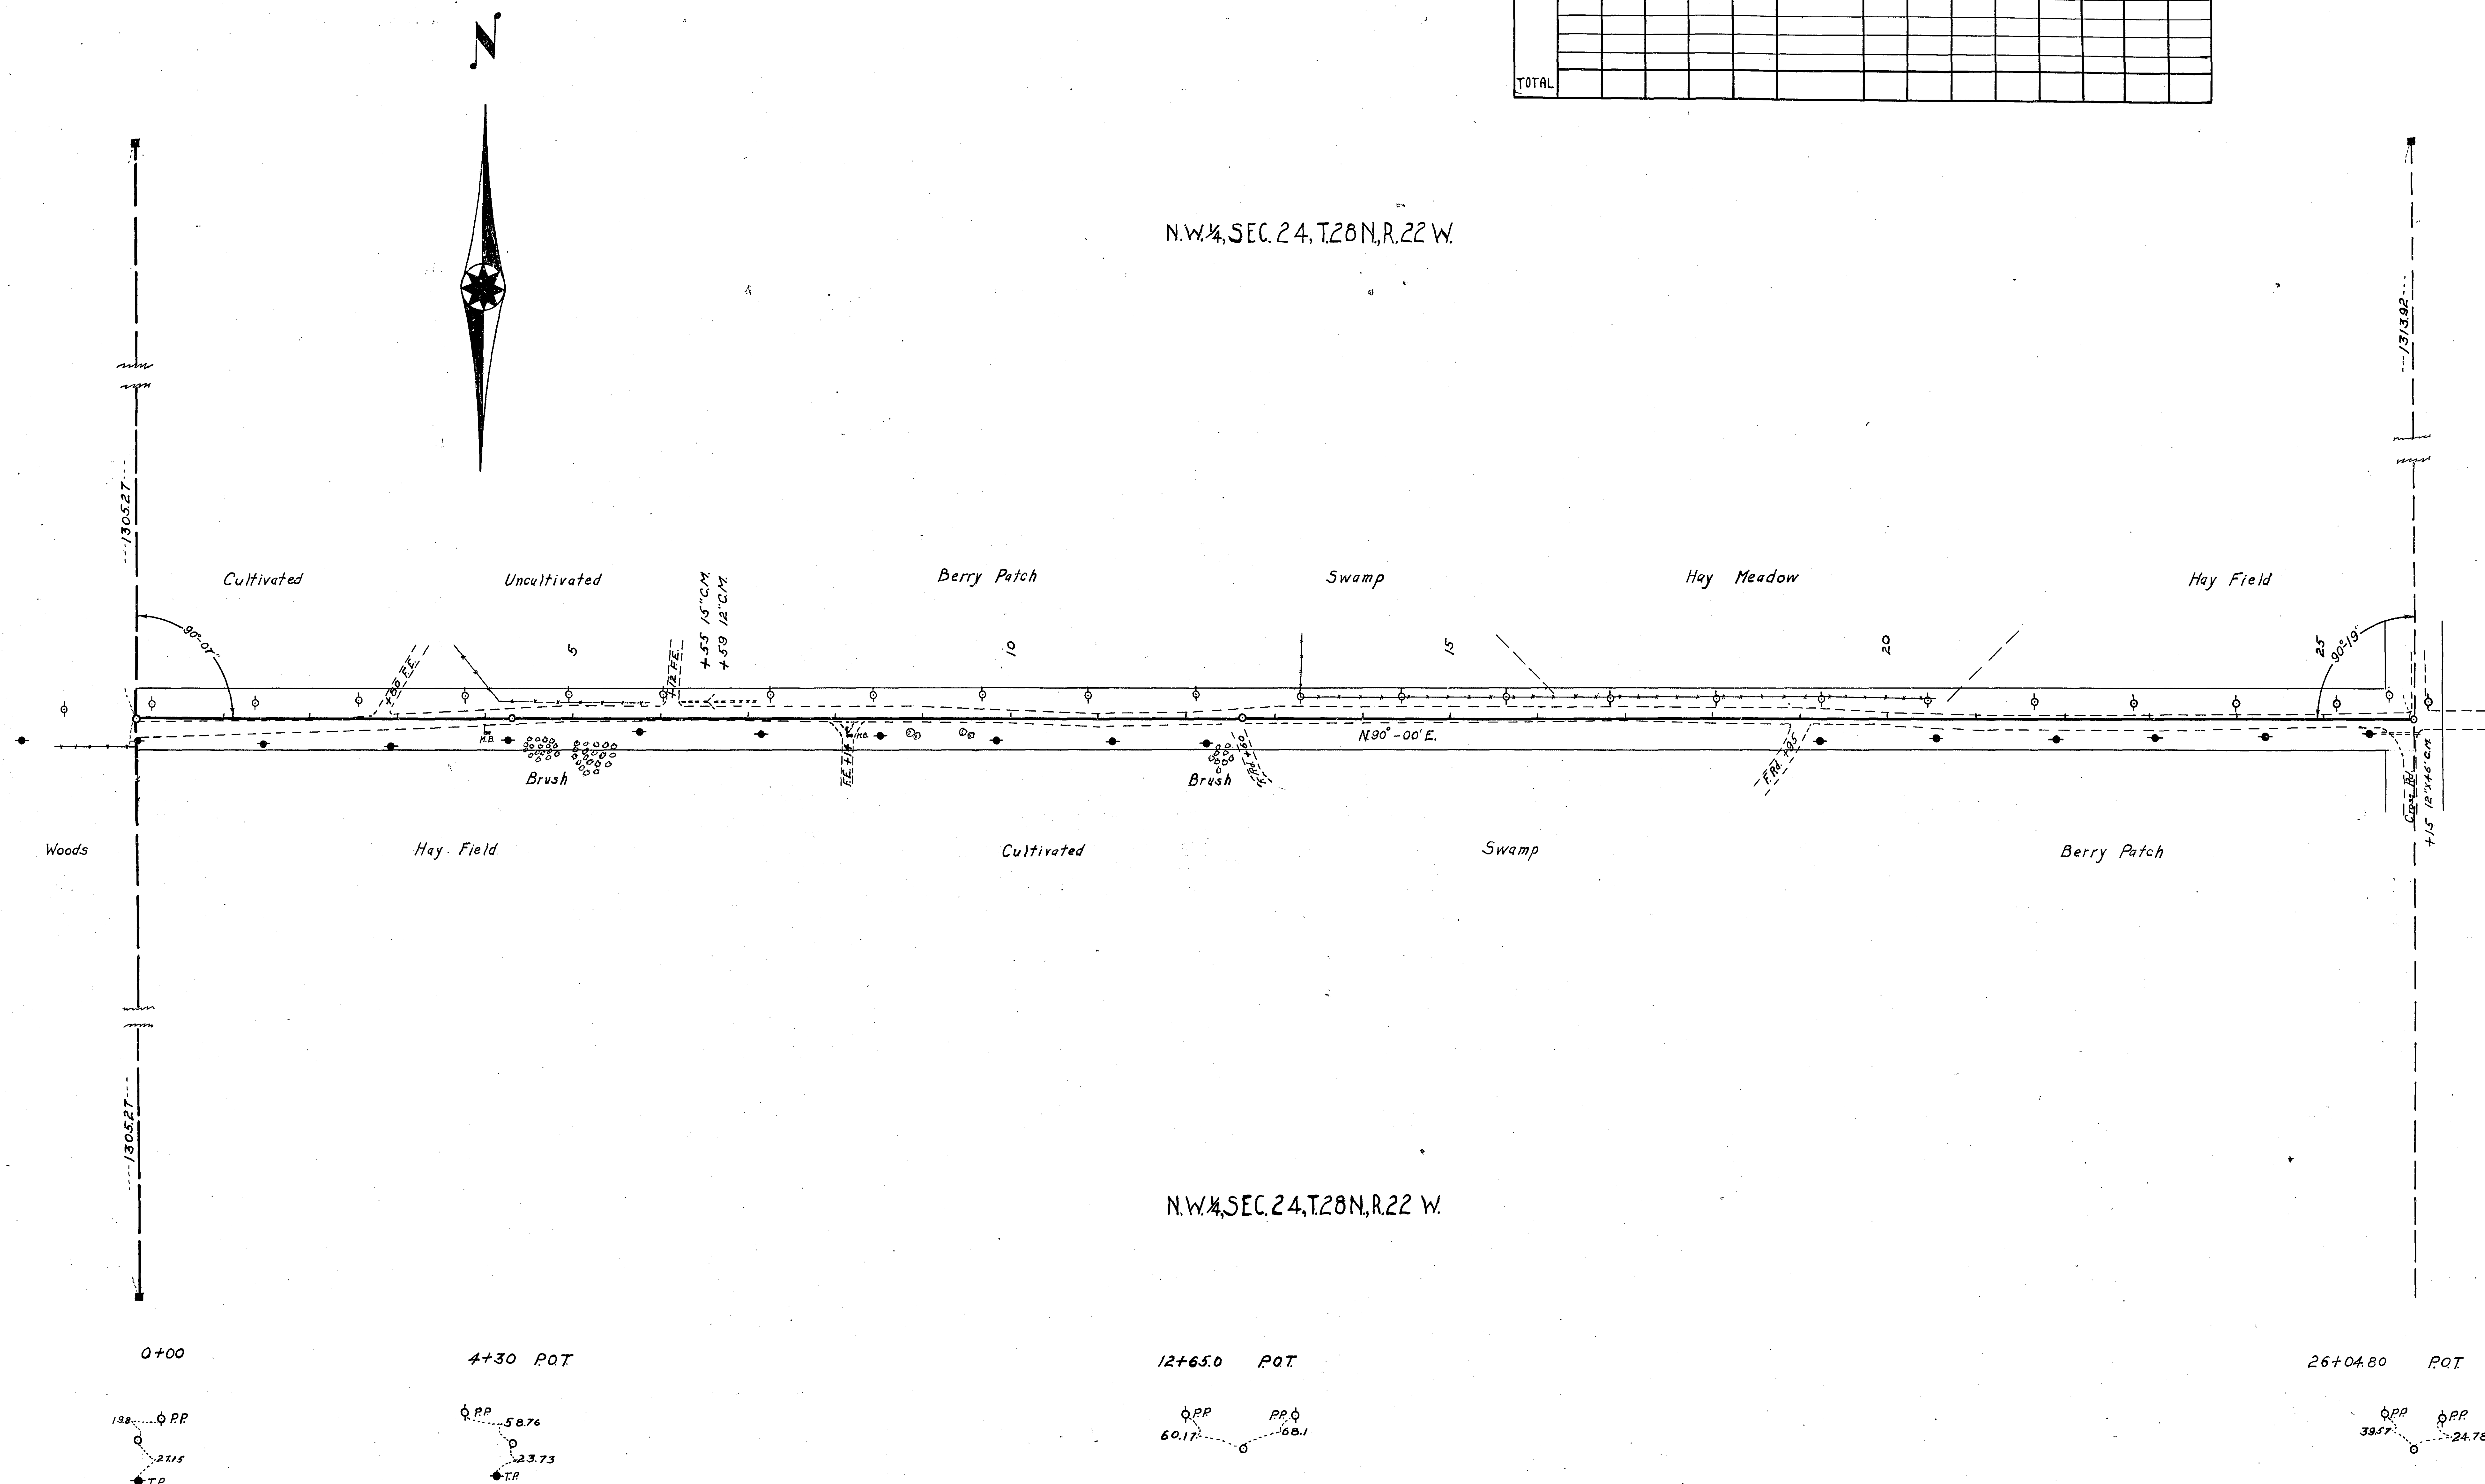


OFFICE OF COUNTY ENGINEER
RAMSEY COUNTY
PROGRESSIVE ROAD MAP
OF
CARVER AVE.
FROM EAST CITY LIMITS TO DEBACH ROAD

TOTAL LENGTH 2604.80 FT. .4933 MILES
Scale 1 in = 100 ft.

[illegible][illegible]

20X F-1/2

[illegible]

20X F2 / 2