


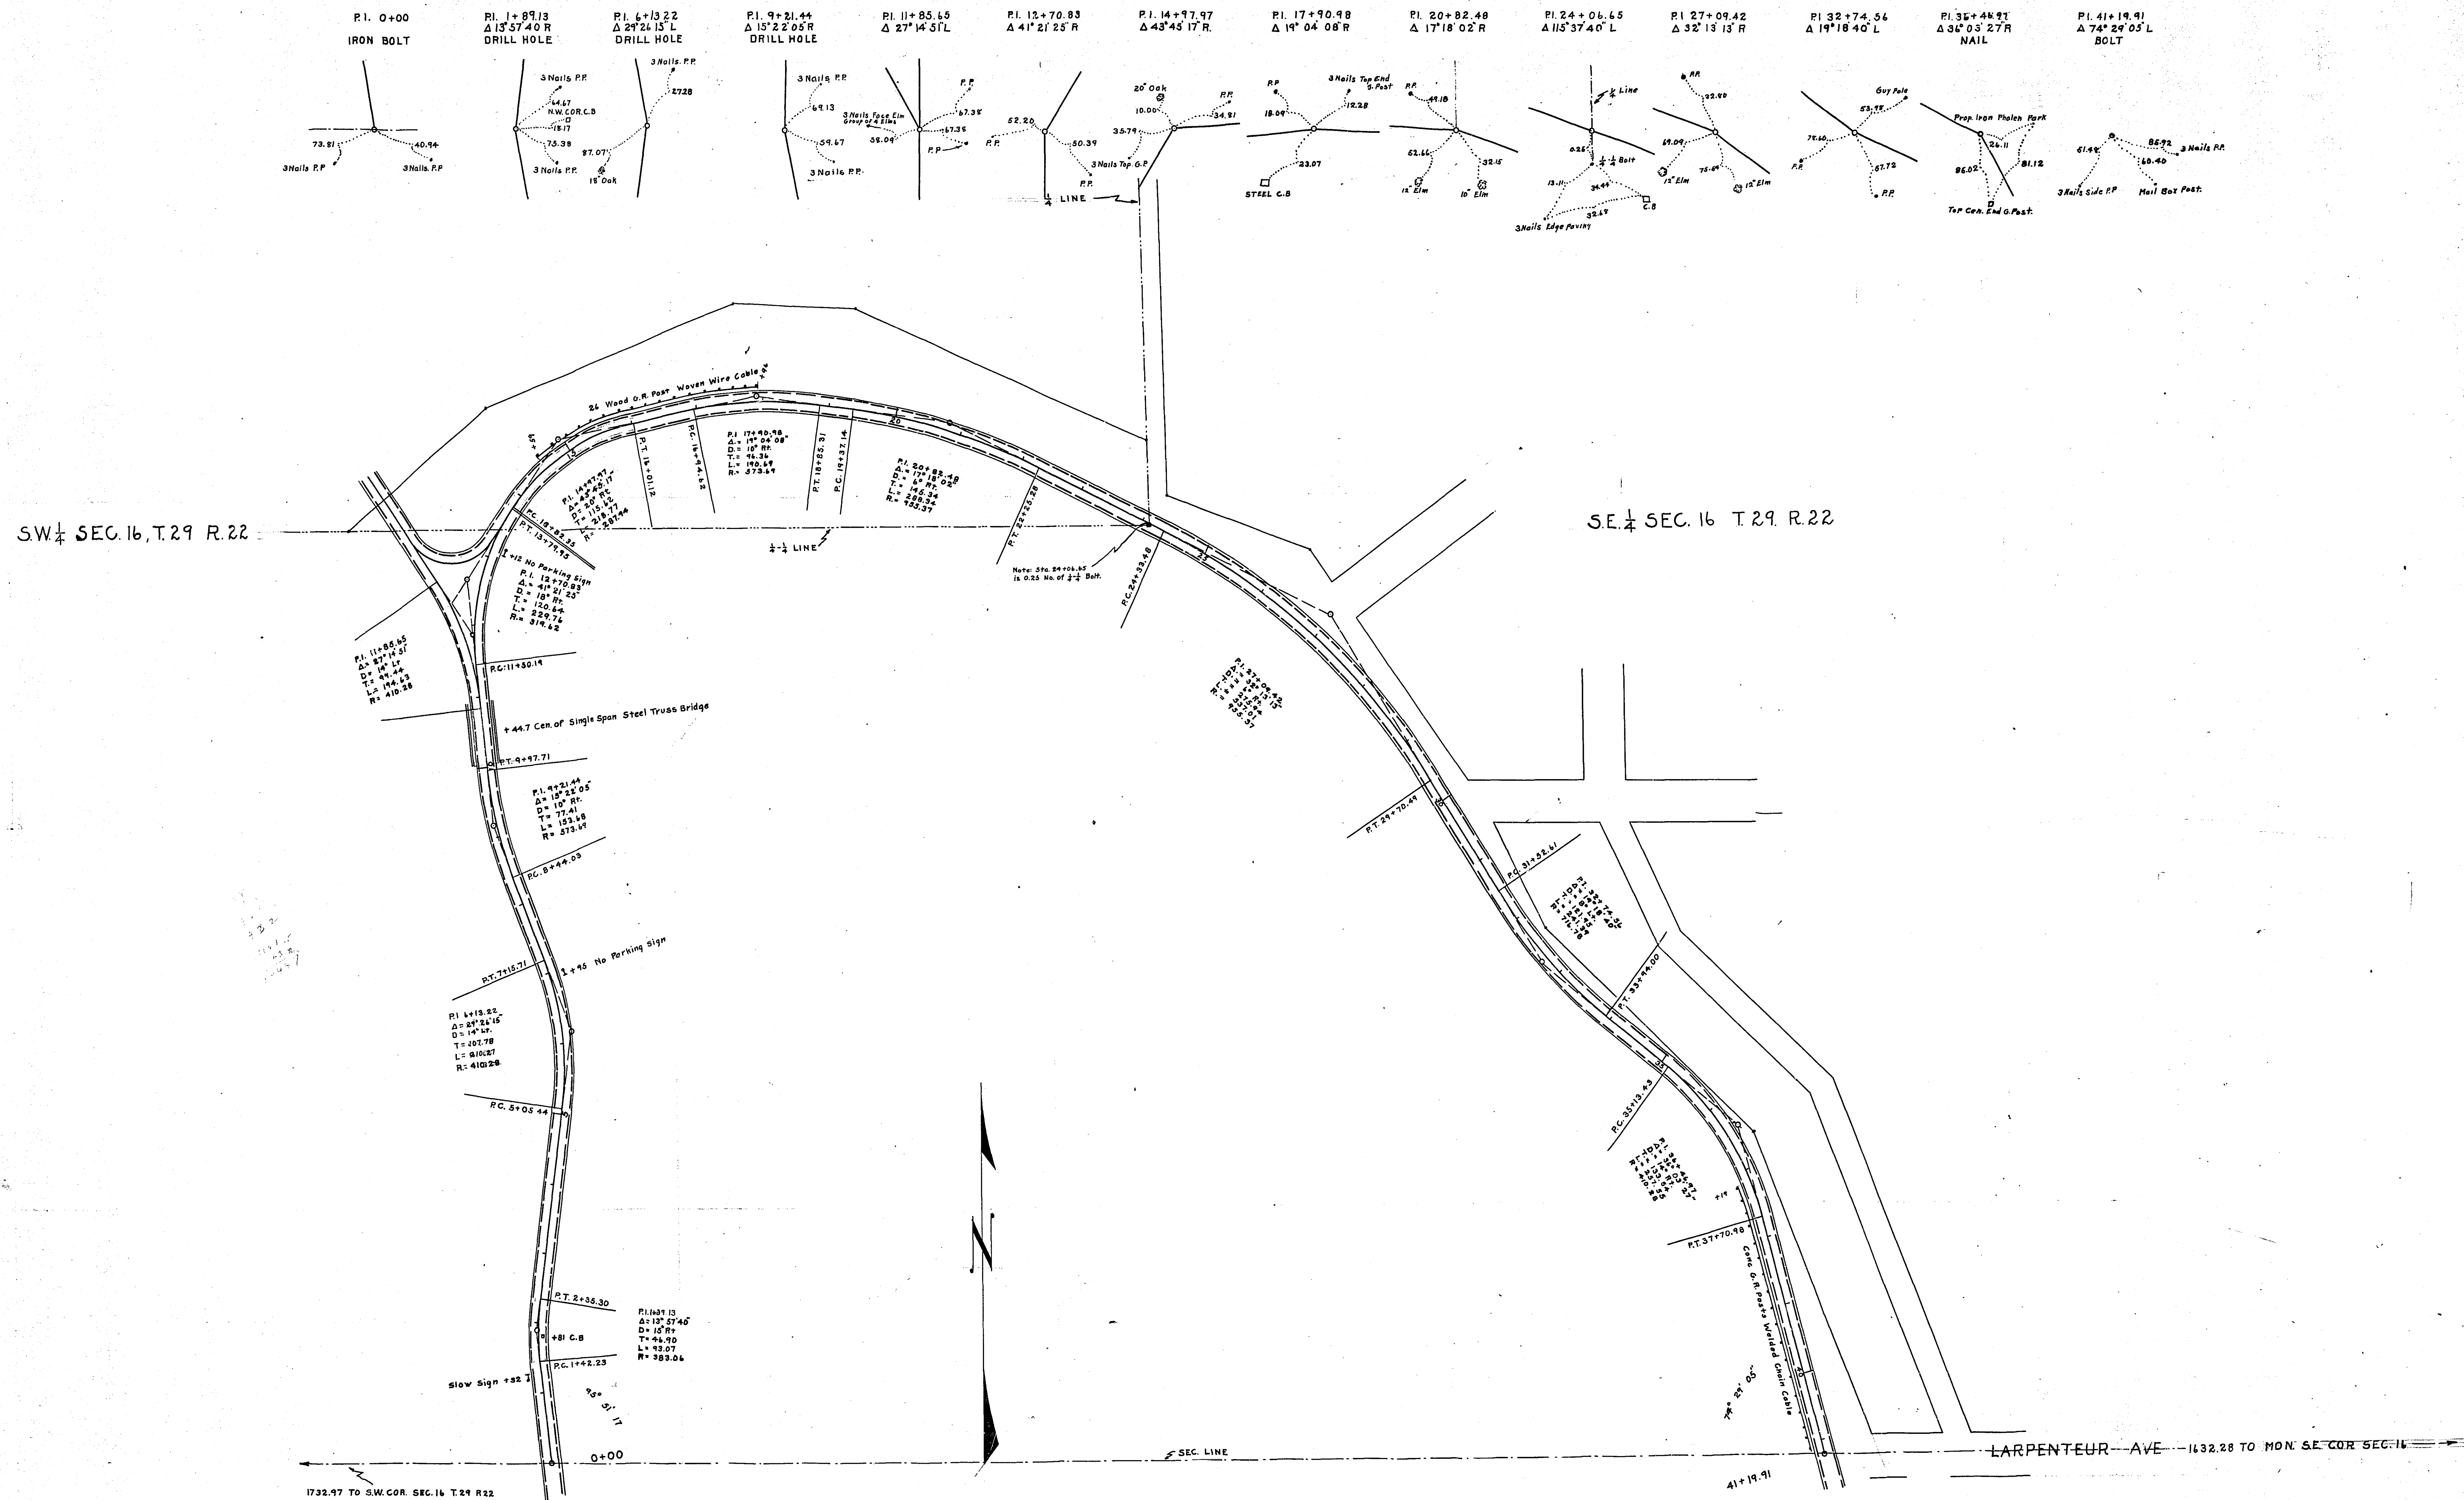

ROAD MAP
EAST SHORE DRIVE
FROM NORTH CITY LIMITS WEST SIDE LAKE PHALEN
TO LARPENTUEUR AVE. EAST SIDE LAKE PHALEN
ROAD NO. 82