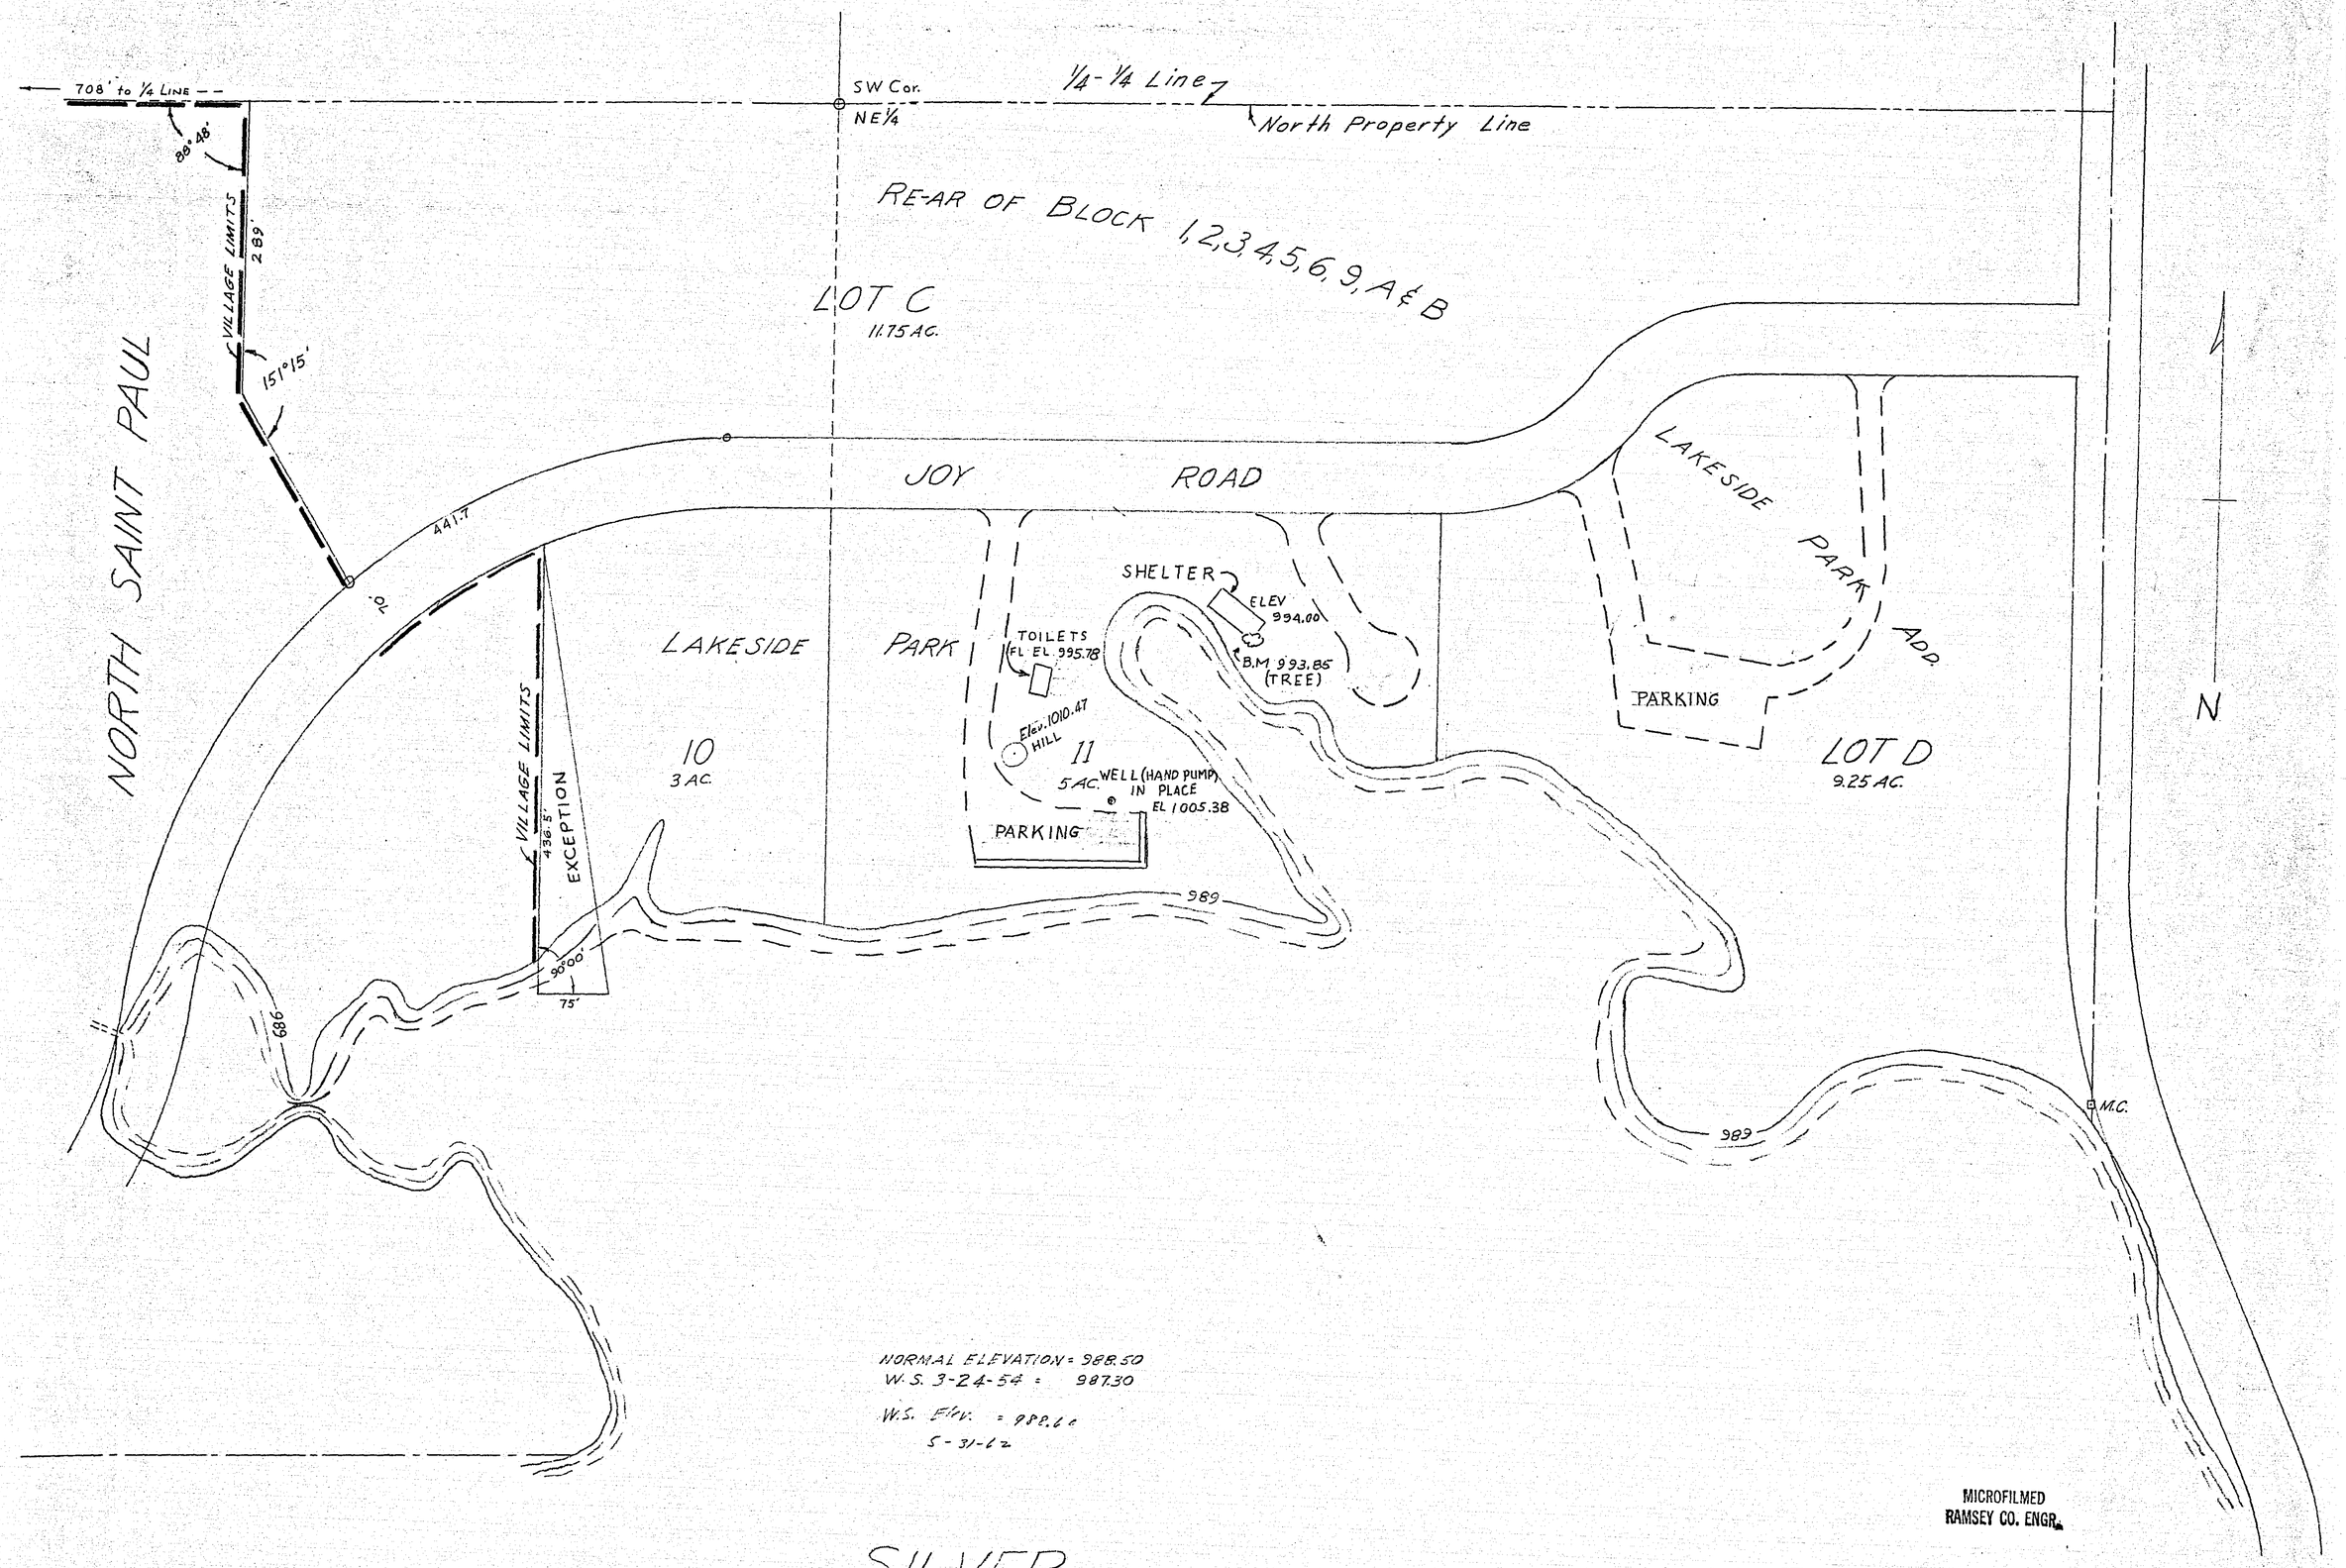

NORMAL ELEVATION = 988.50
W.S. 3-24-54 = 987.30
W.S. Elev. = 988.66
5-31-62

MICROFILMED
RAMSEY CO. ENGR.

SILVER LAKE

HAND-PUMP LOCATION
JOY PARK
SCALE 1" = 100'
RFG 2-13-62 15-105
traced from drawing R-739