

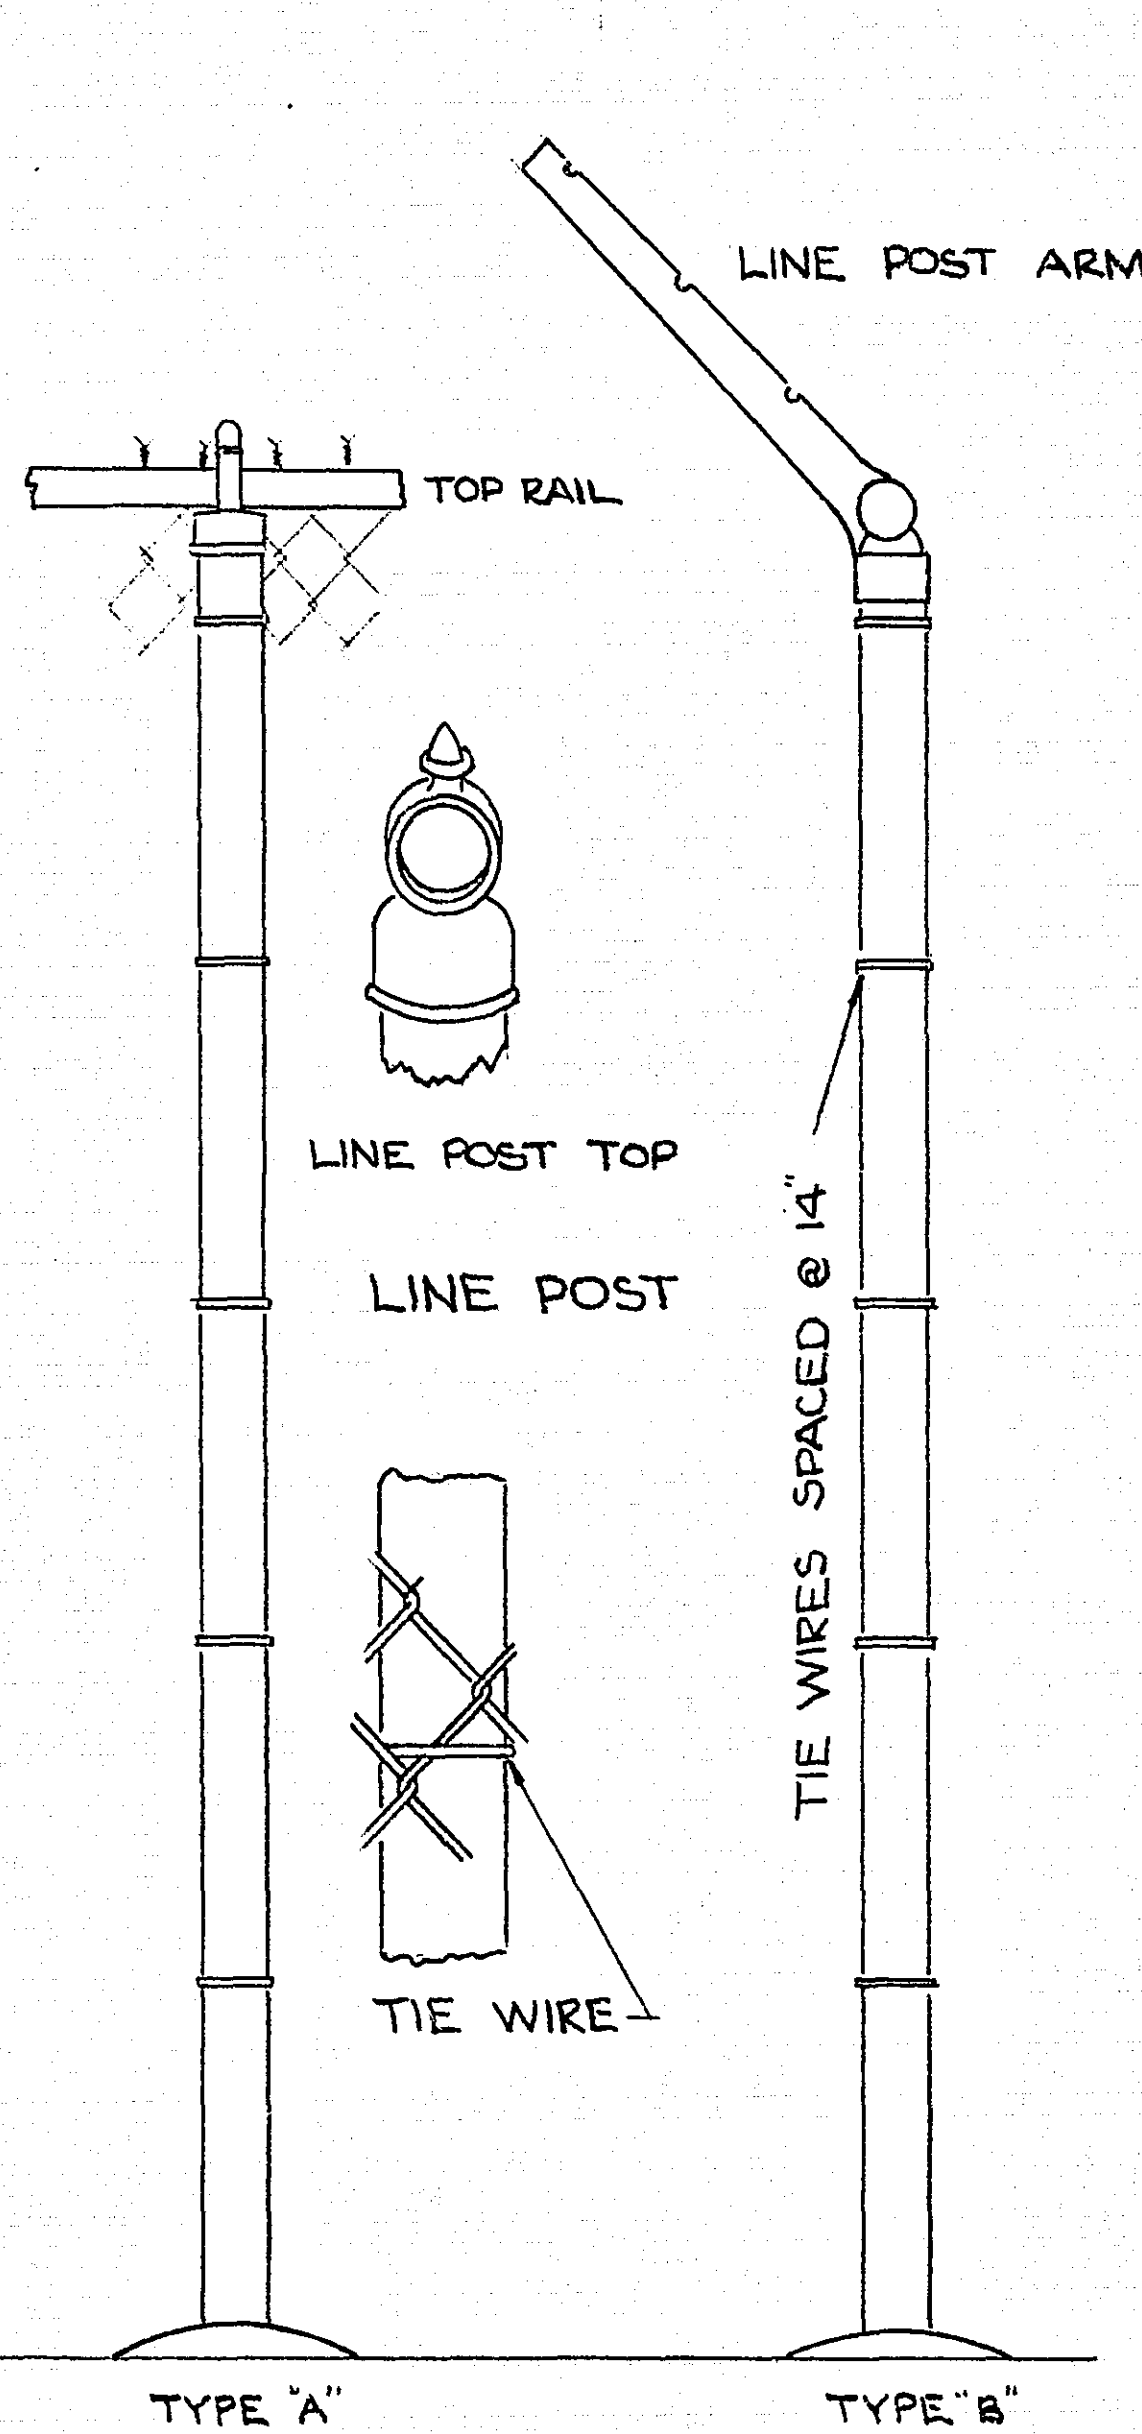
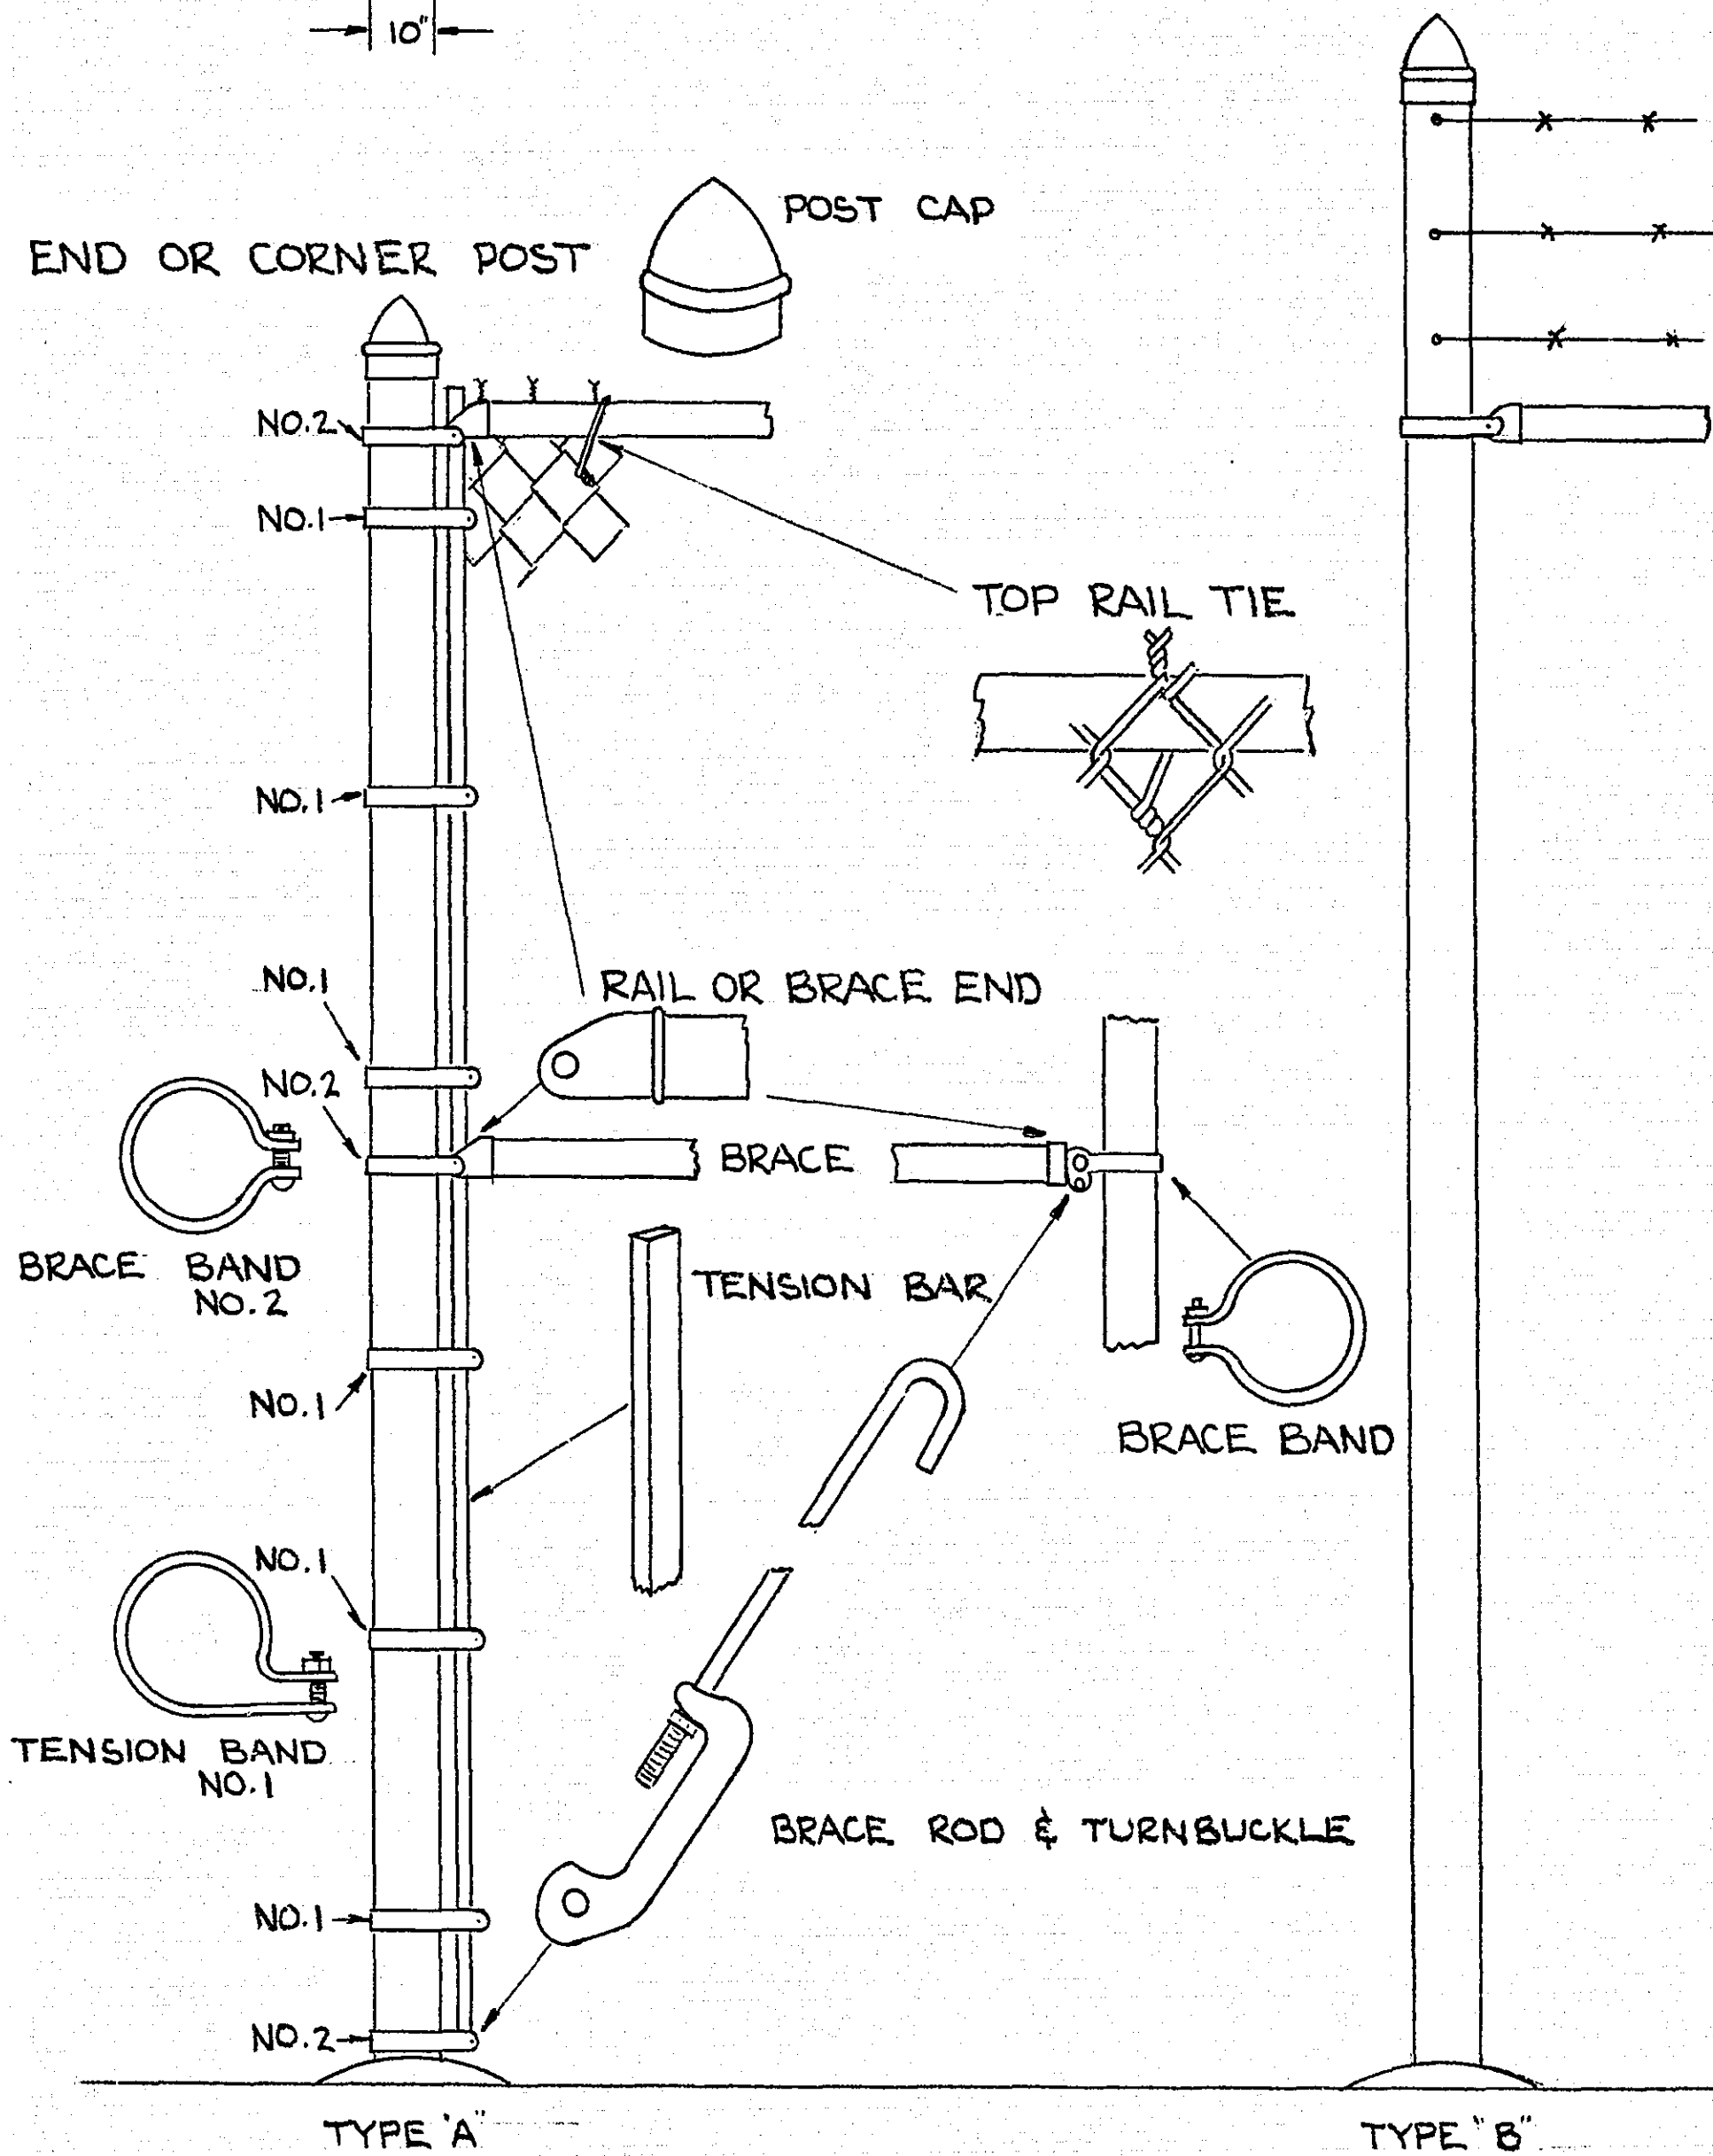
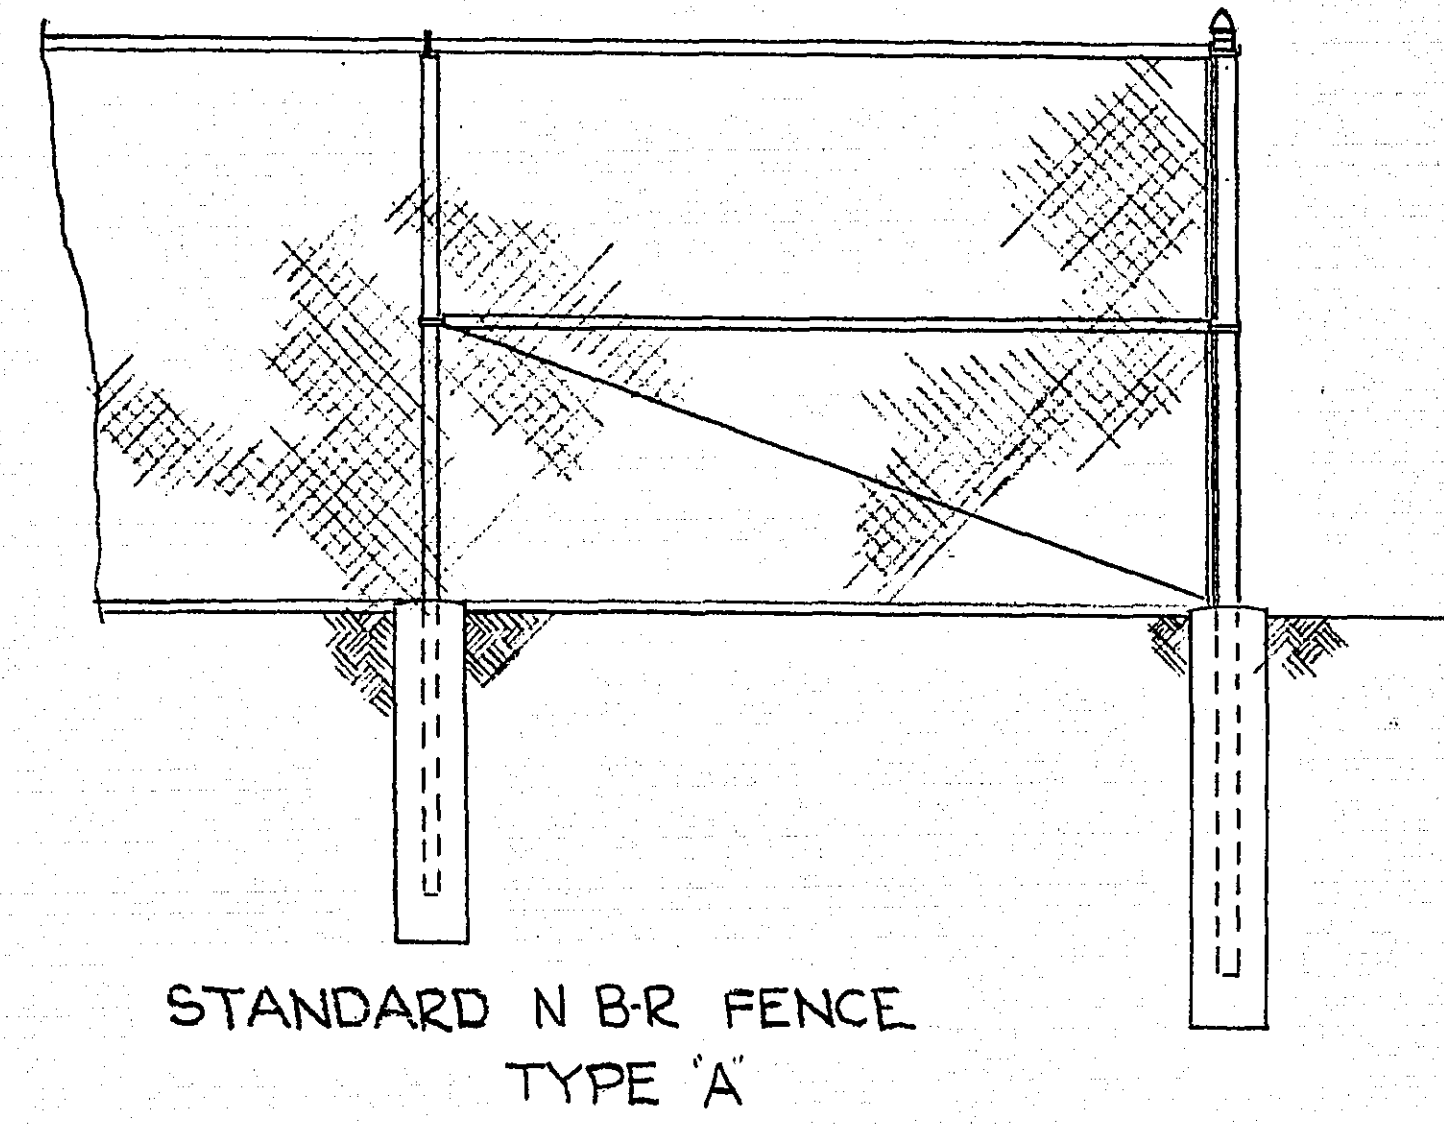


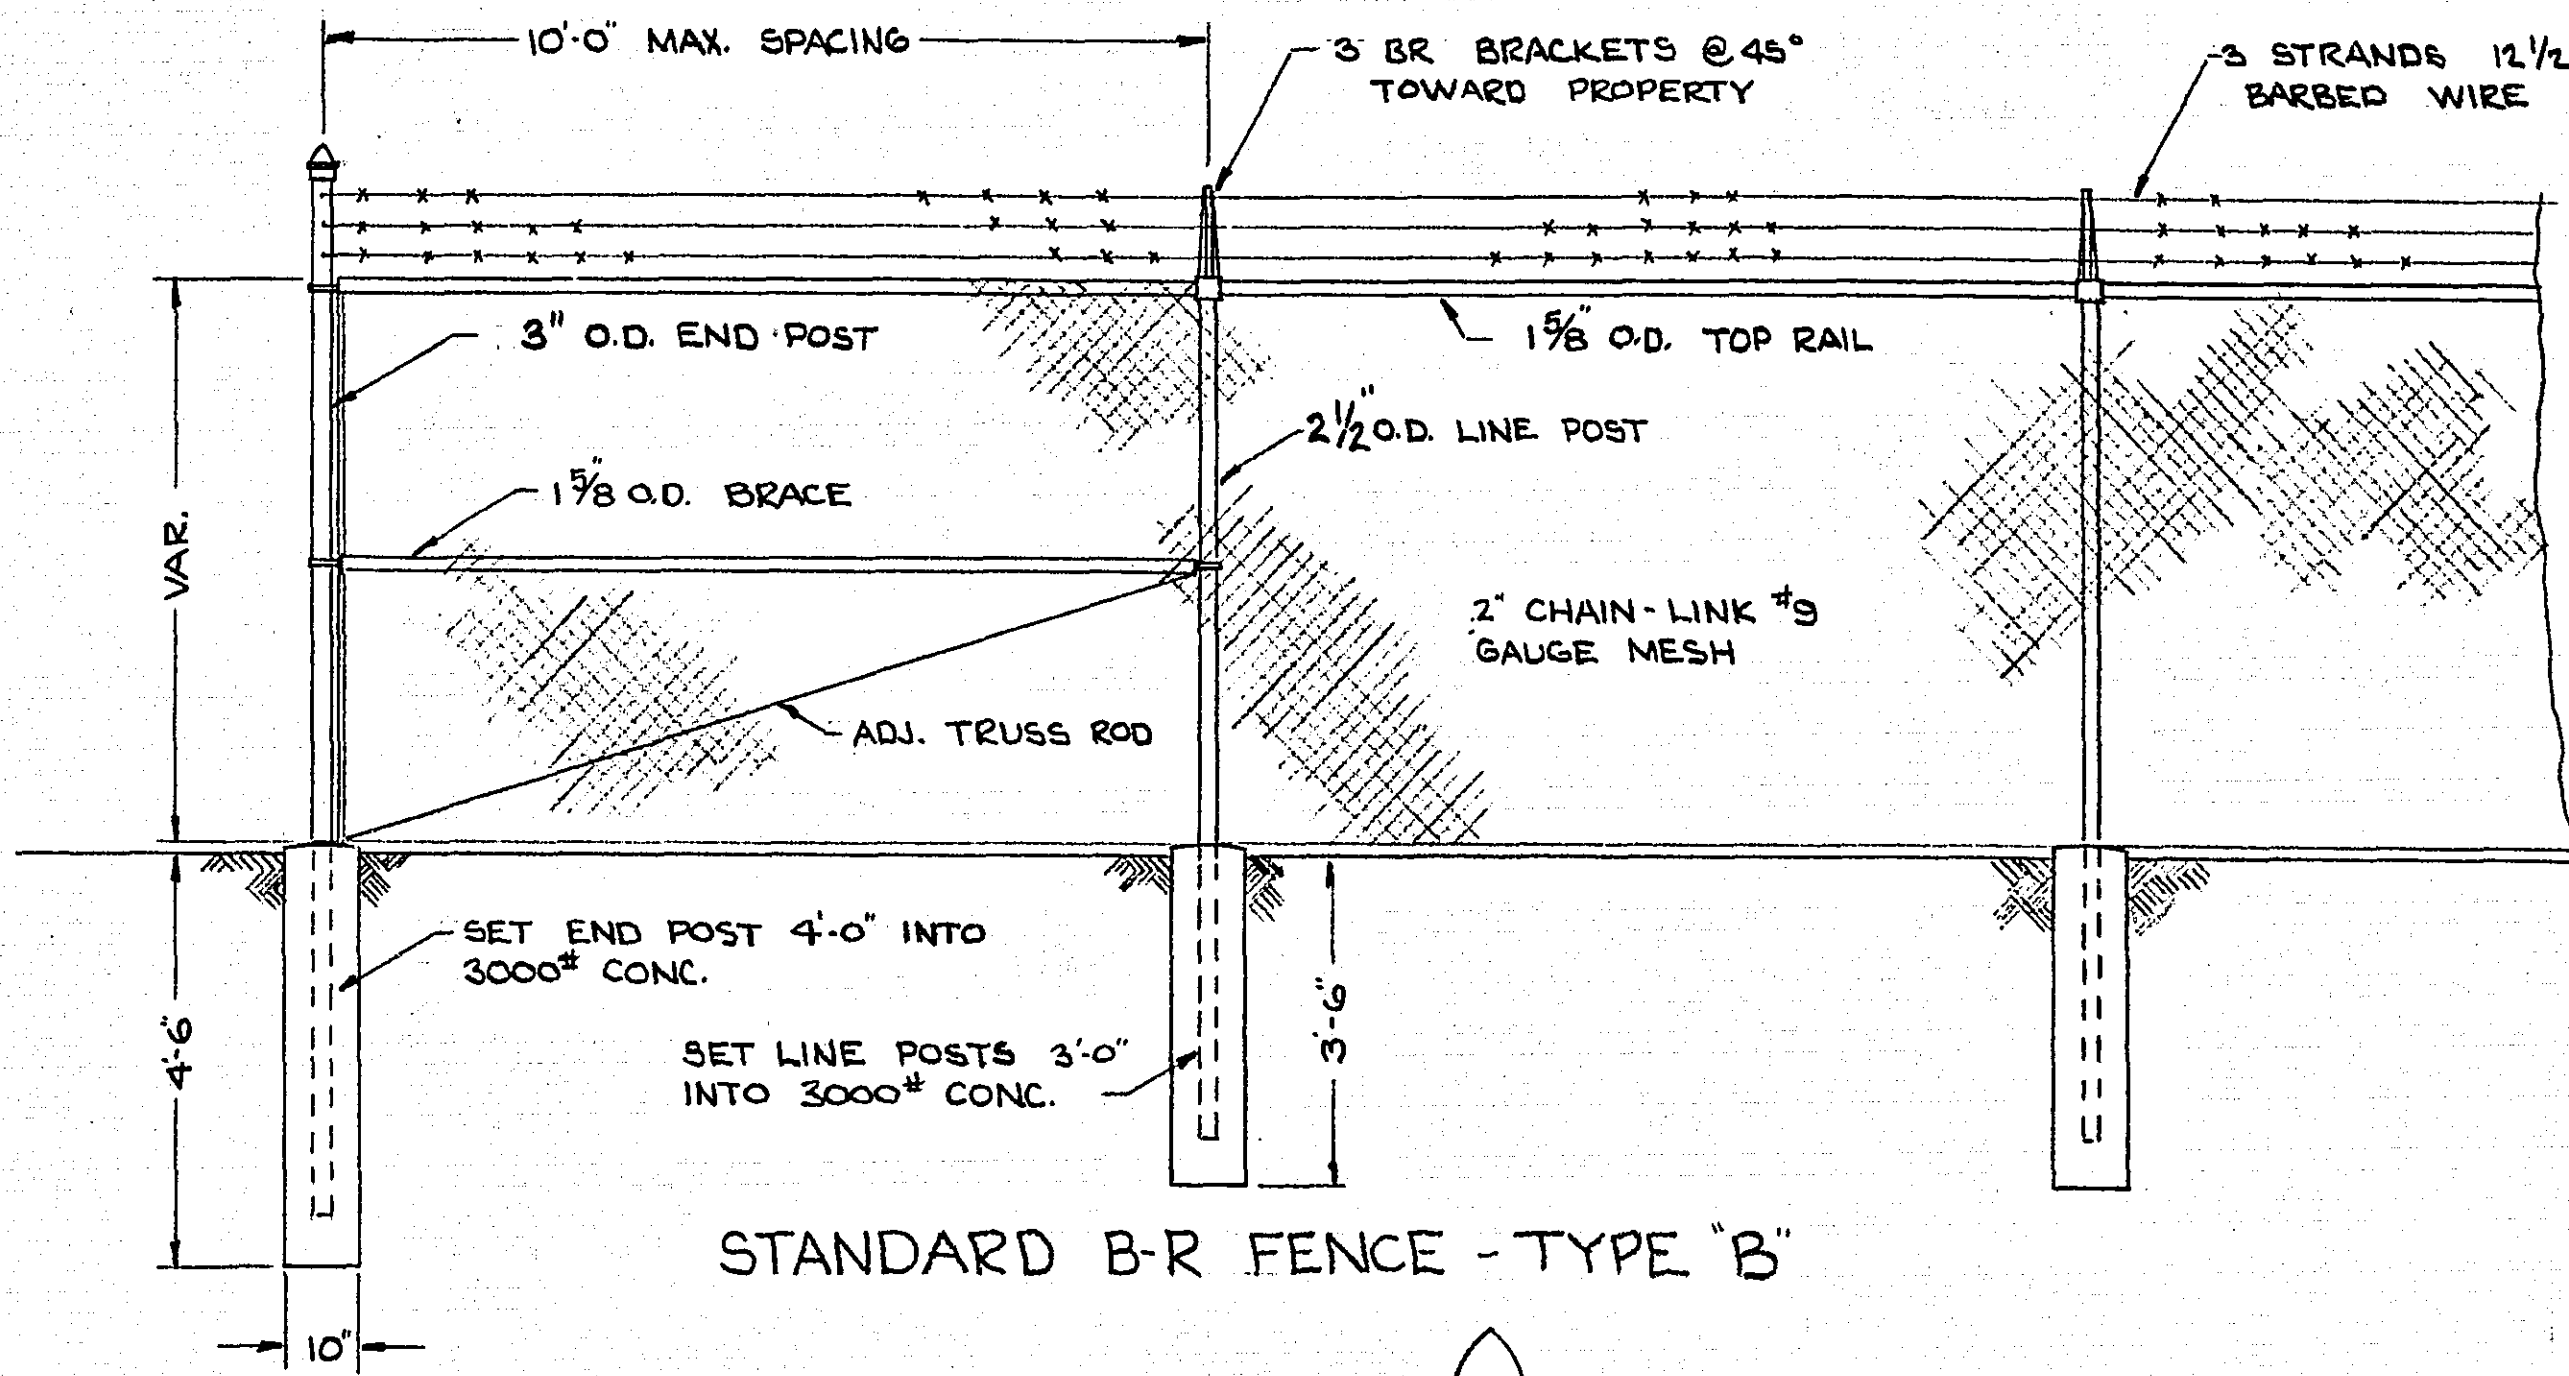

RAMSEY COUNTY ENGINEER'S DEPT.		
PARK FENCING		
STANDARD CHAIN-LINK FENCE DETAIL		
DESIGNED	DEANE R. ANKLAN	SURVEY
DRAWN R.W.W.	COUNTY ENGINEER	MICROFILMED
CHECKED KEW.	BY KENNETH E WELTZIN	RAMSEY CO. ENGR.
REVISED 3-15-67	DATE: 4-5-65	DATUM
		FILE

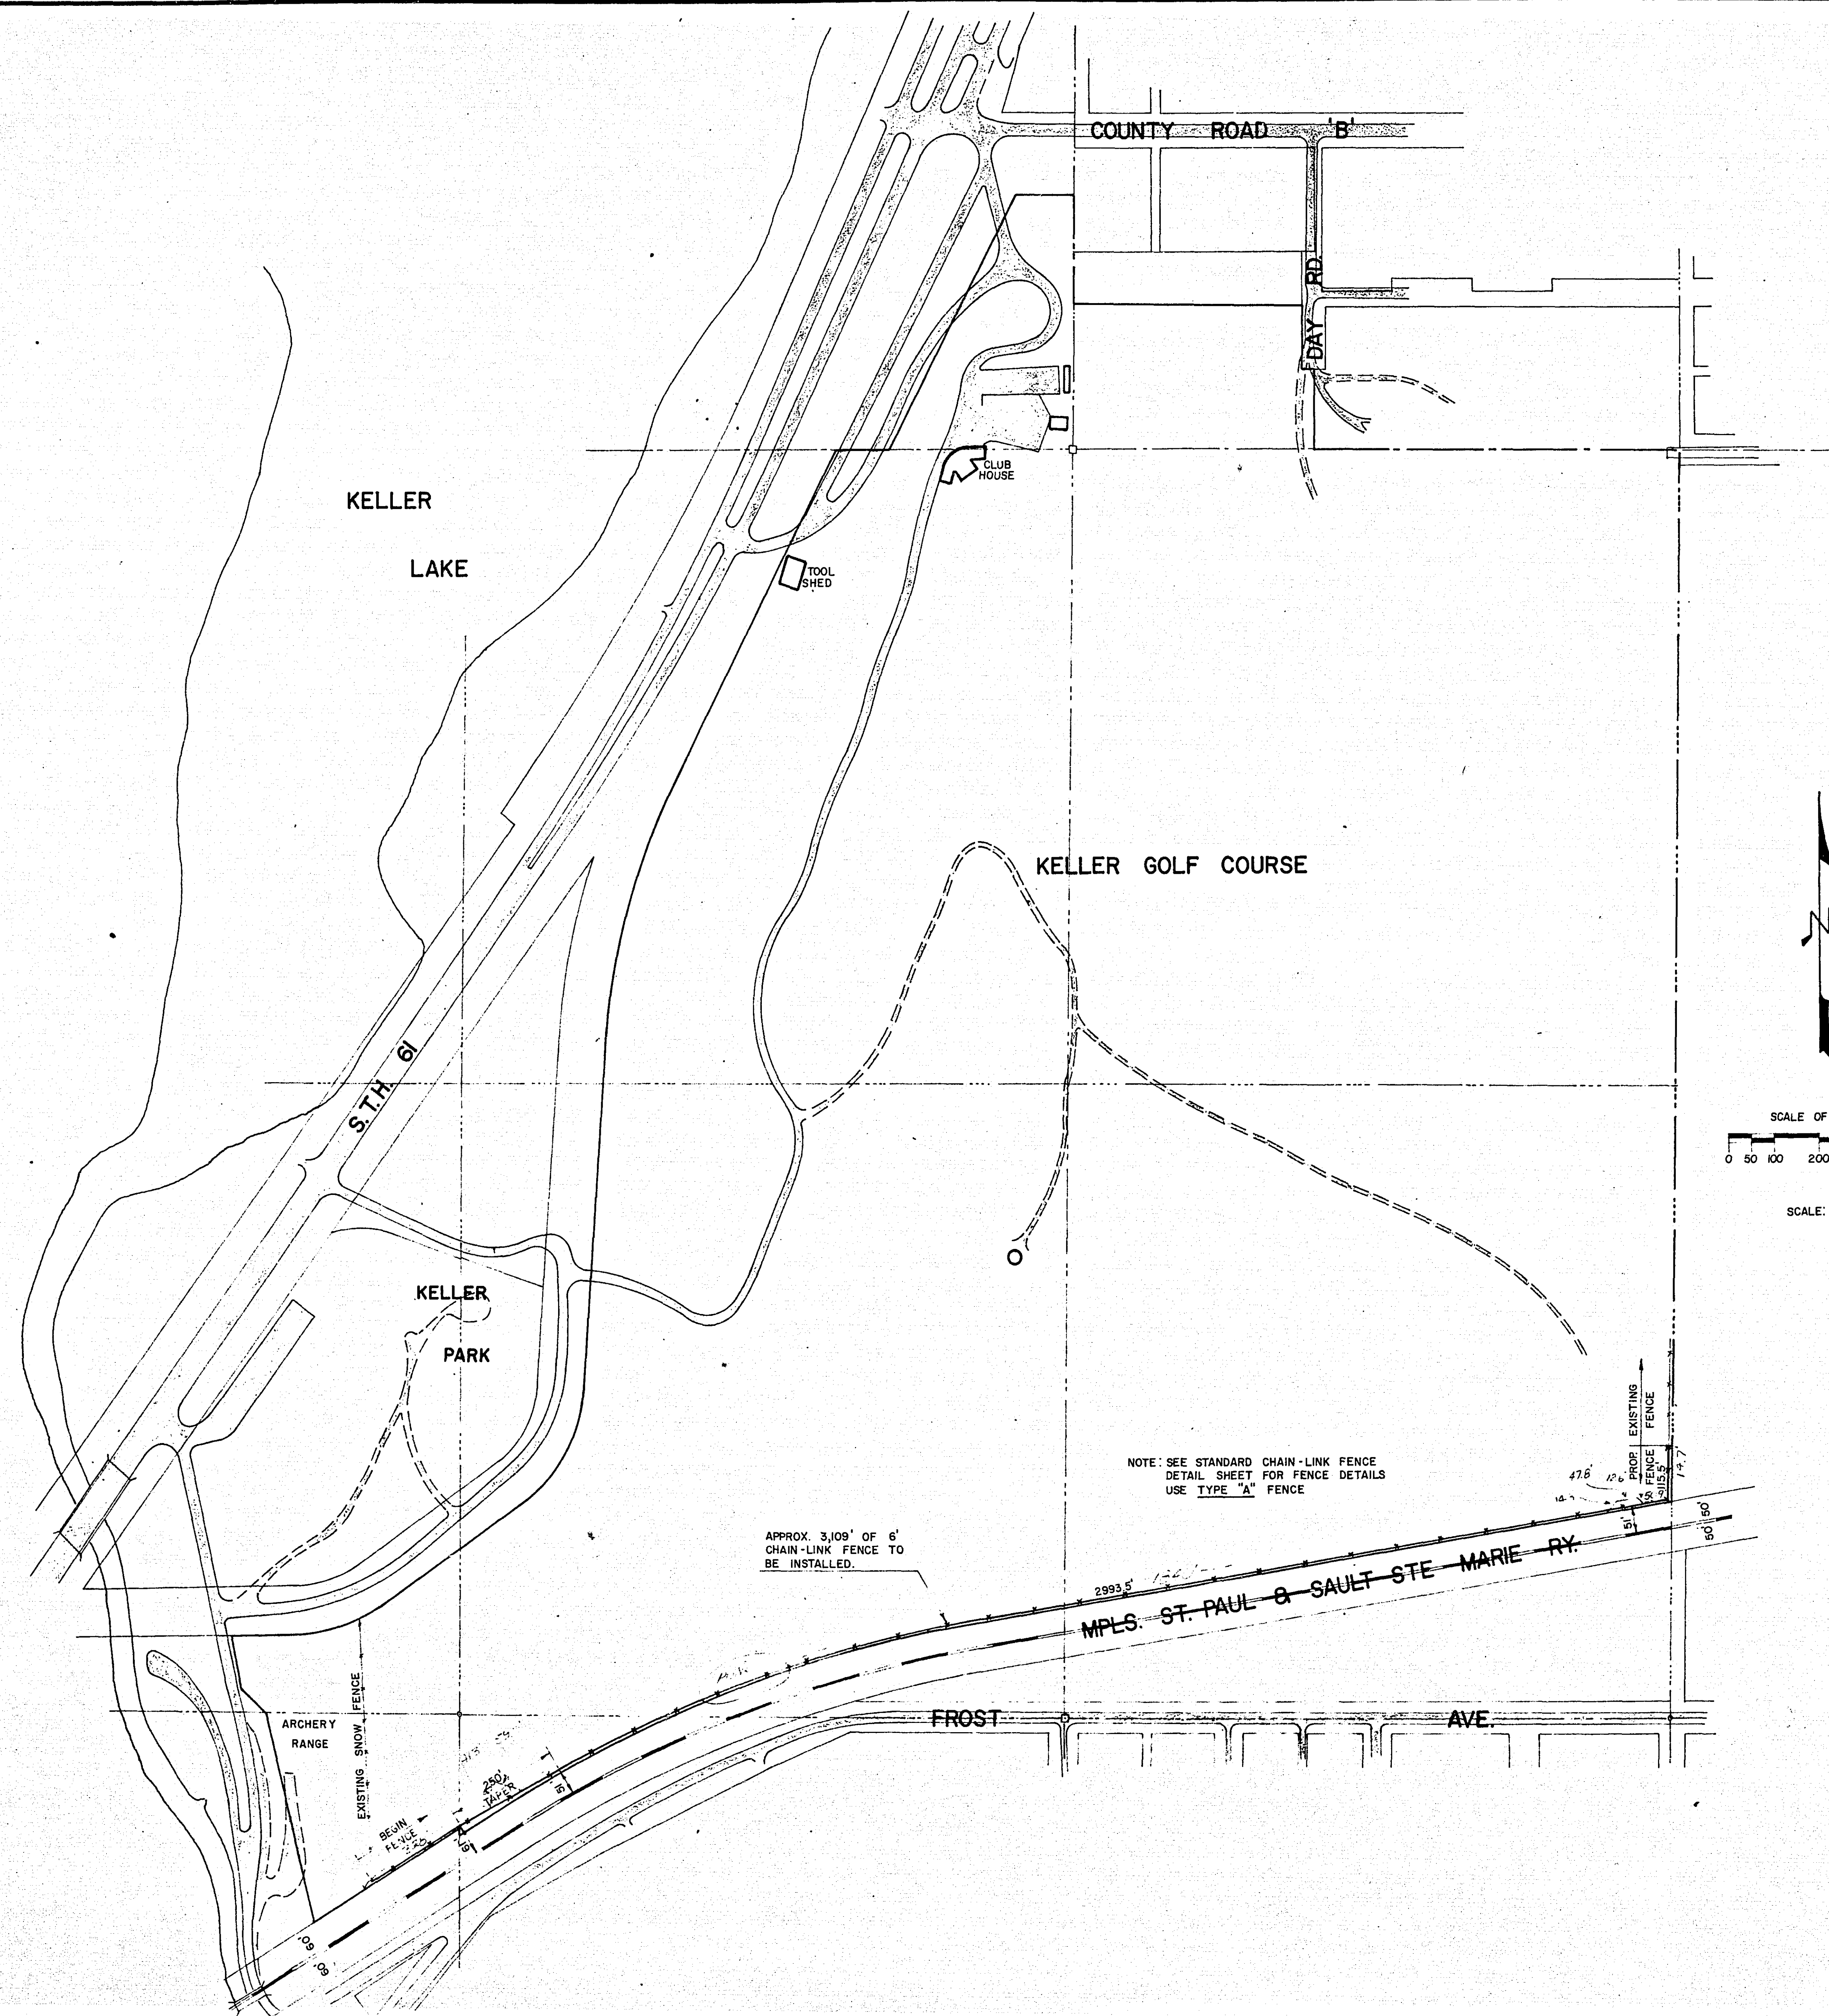

FENCE ASBUILT- 3139.5' (1968)

RAMSEY COUNTY ENGINEER'S DEPT.		
PLOT PLAN		
PROPOSED CHAIN-LINK FENCE FOR KELLER GOLF COURSE		
DESIGNED	DEANE R. ANKLAN	SURVEY K.P.
DRAWN R.W.W.	COUNTY ENGINEER	MICROFILMED RAMSEY CO. ENGR.
CHECKED	BY	DATUM
REVISED	DATE 2-16-68	FILE