

Fed. Proj. No.

VAONAS HEIGHTS


SW 1/4 SE 1/4 S29T30R22

Lot 1 Blk 1 Baier's Sub. Div.


4/7/56
Transfer No. 8016689 Jacob J. & Evelyn J. Baier Lot 1, 2
801670

Parcel # 89-16000-010-01

-020-01
-030-01

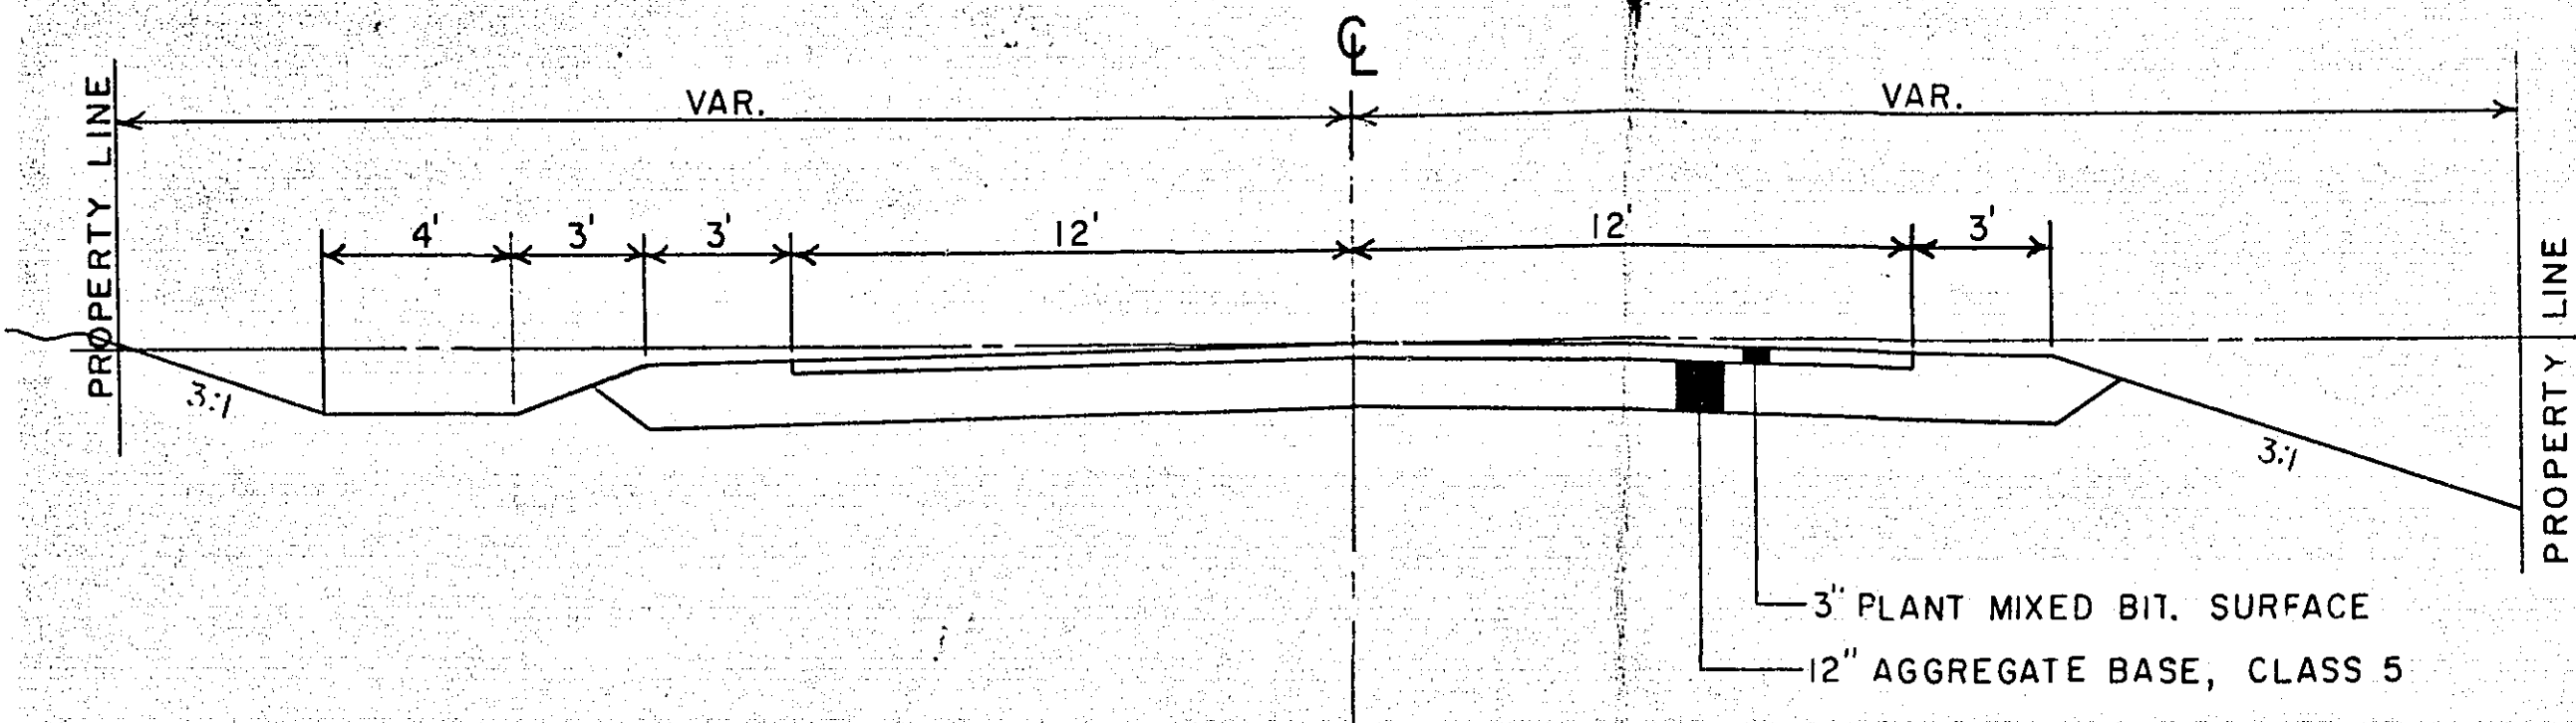


TYPICAL SECTION

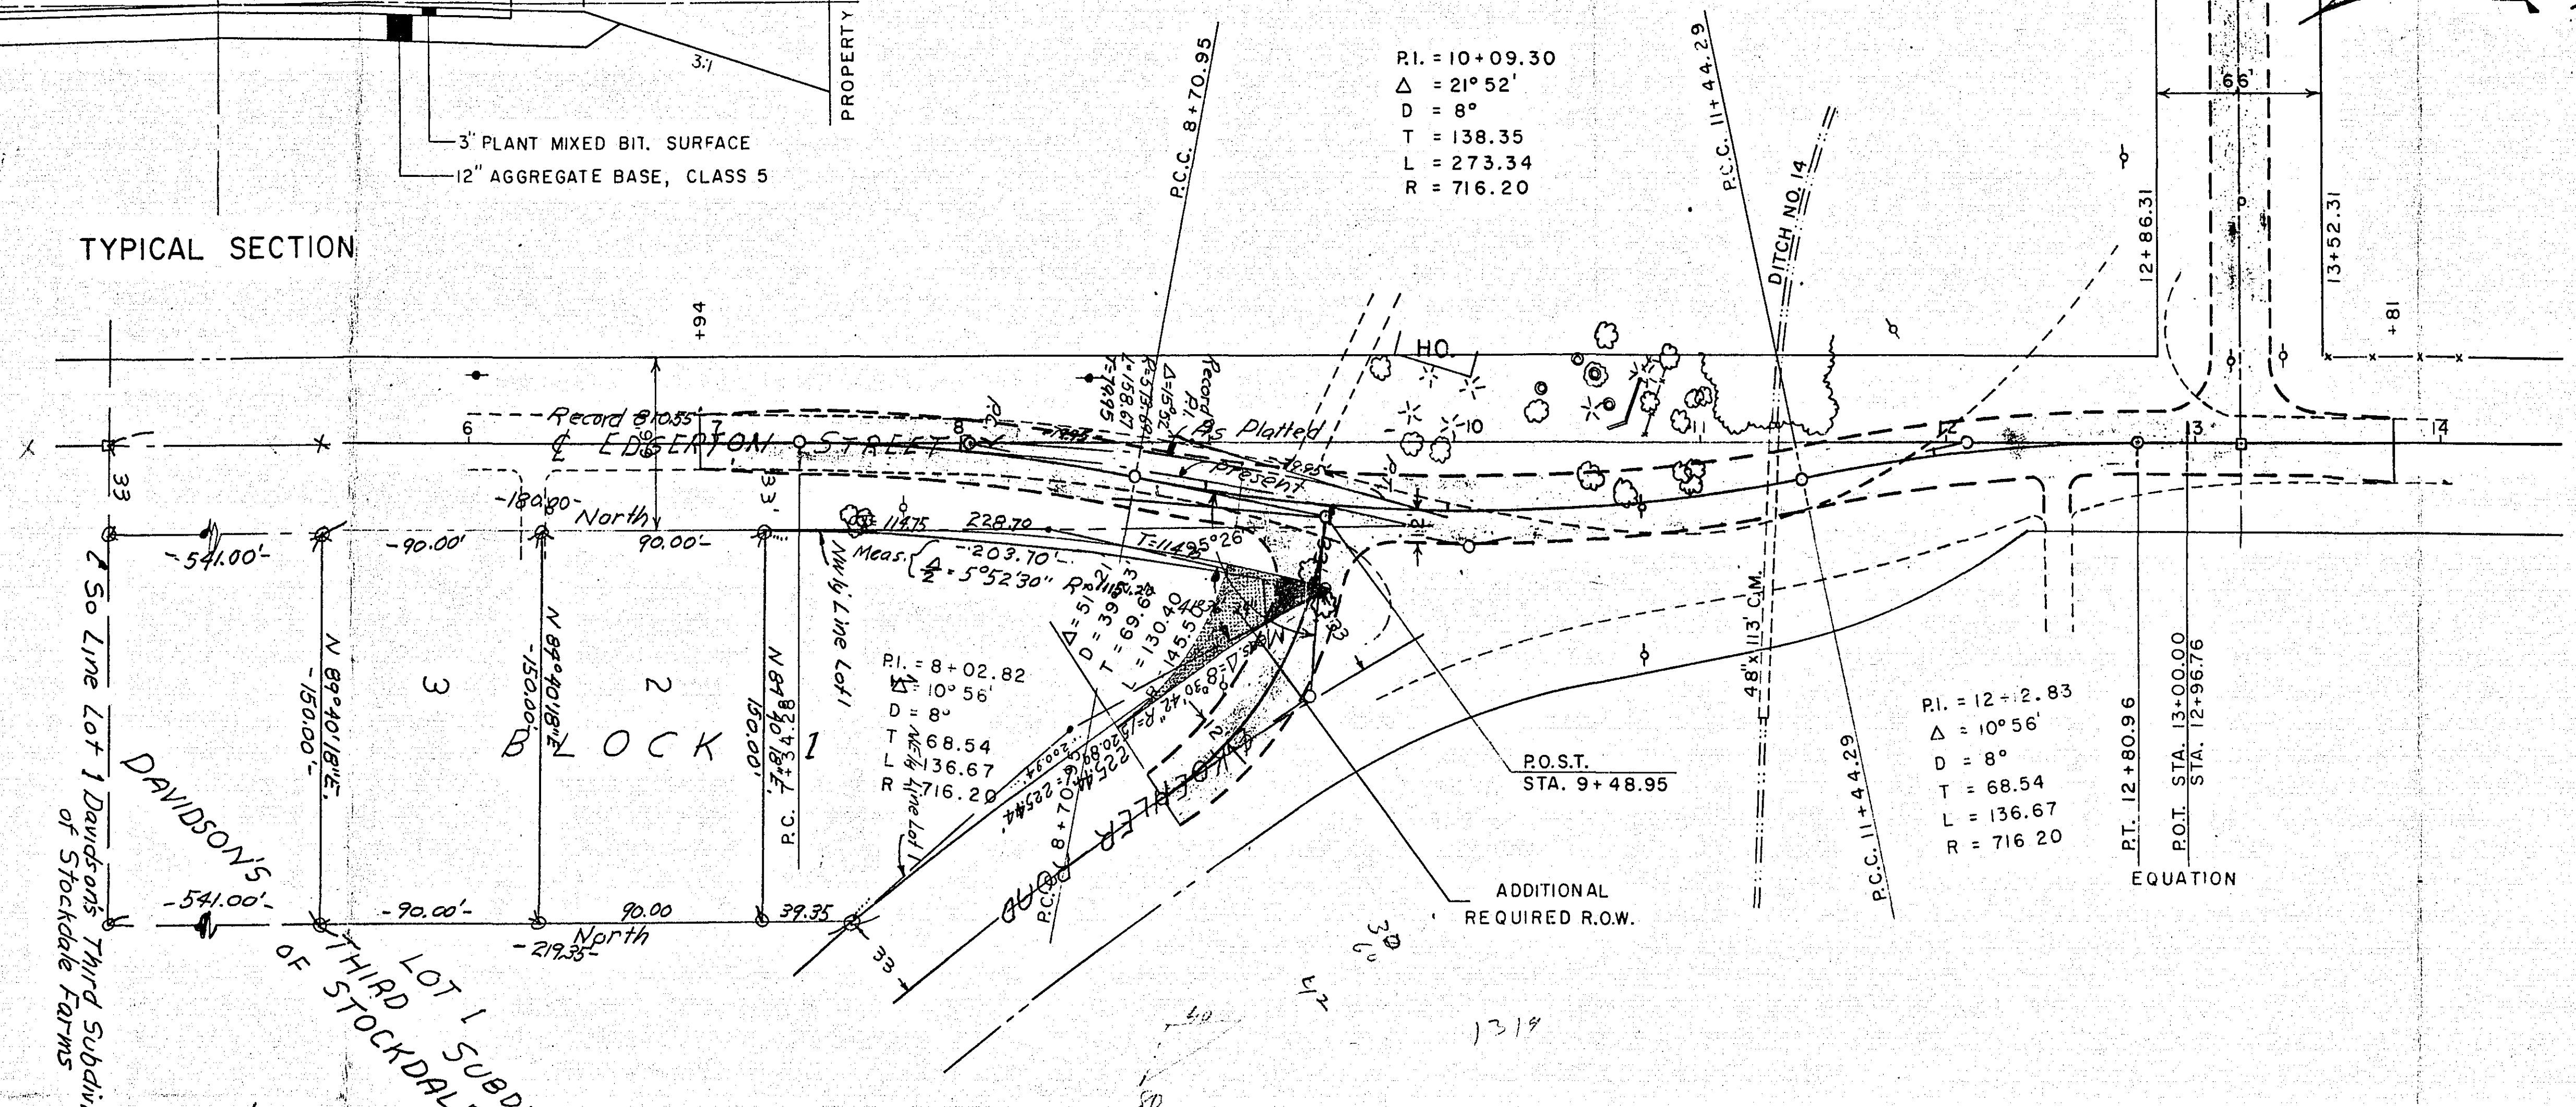

B.M. 916.06
TOP MONUMENT STATION
3419.51 SECTION LINE
ALIGNMENT

SCALE 1 INCH = 50 FEET

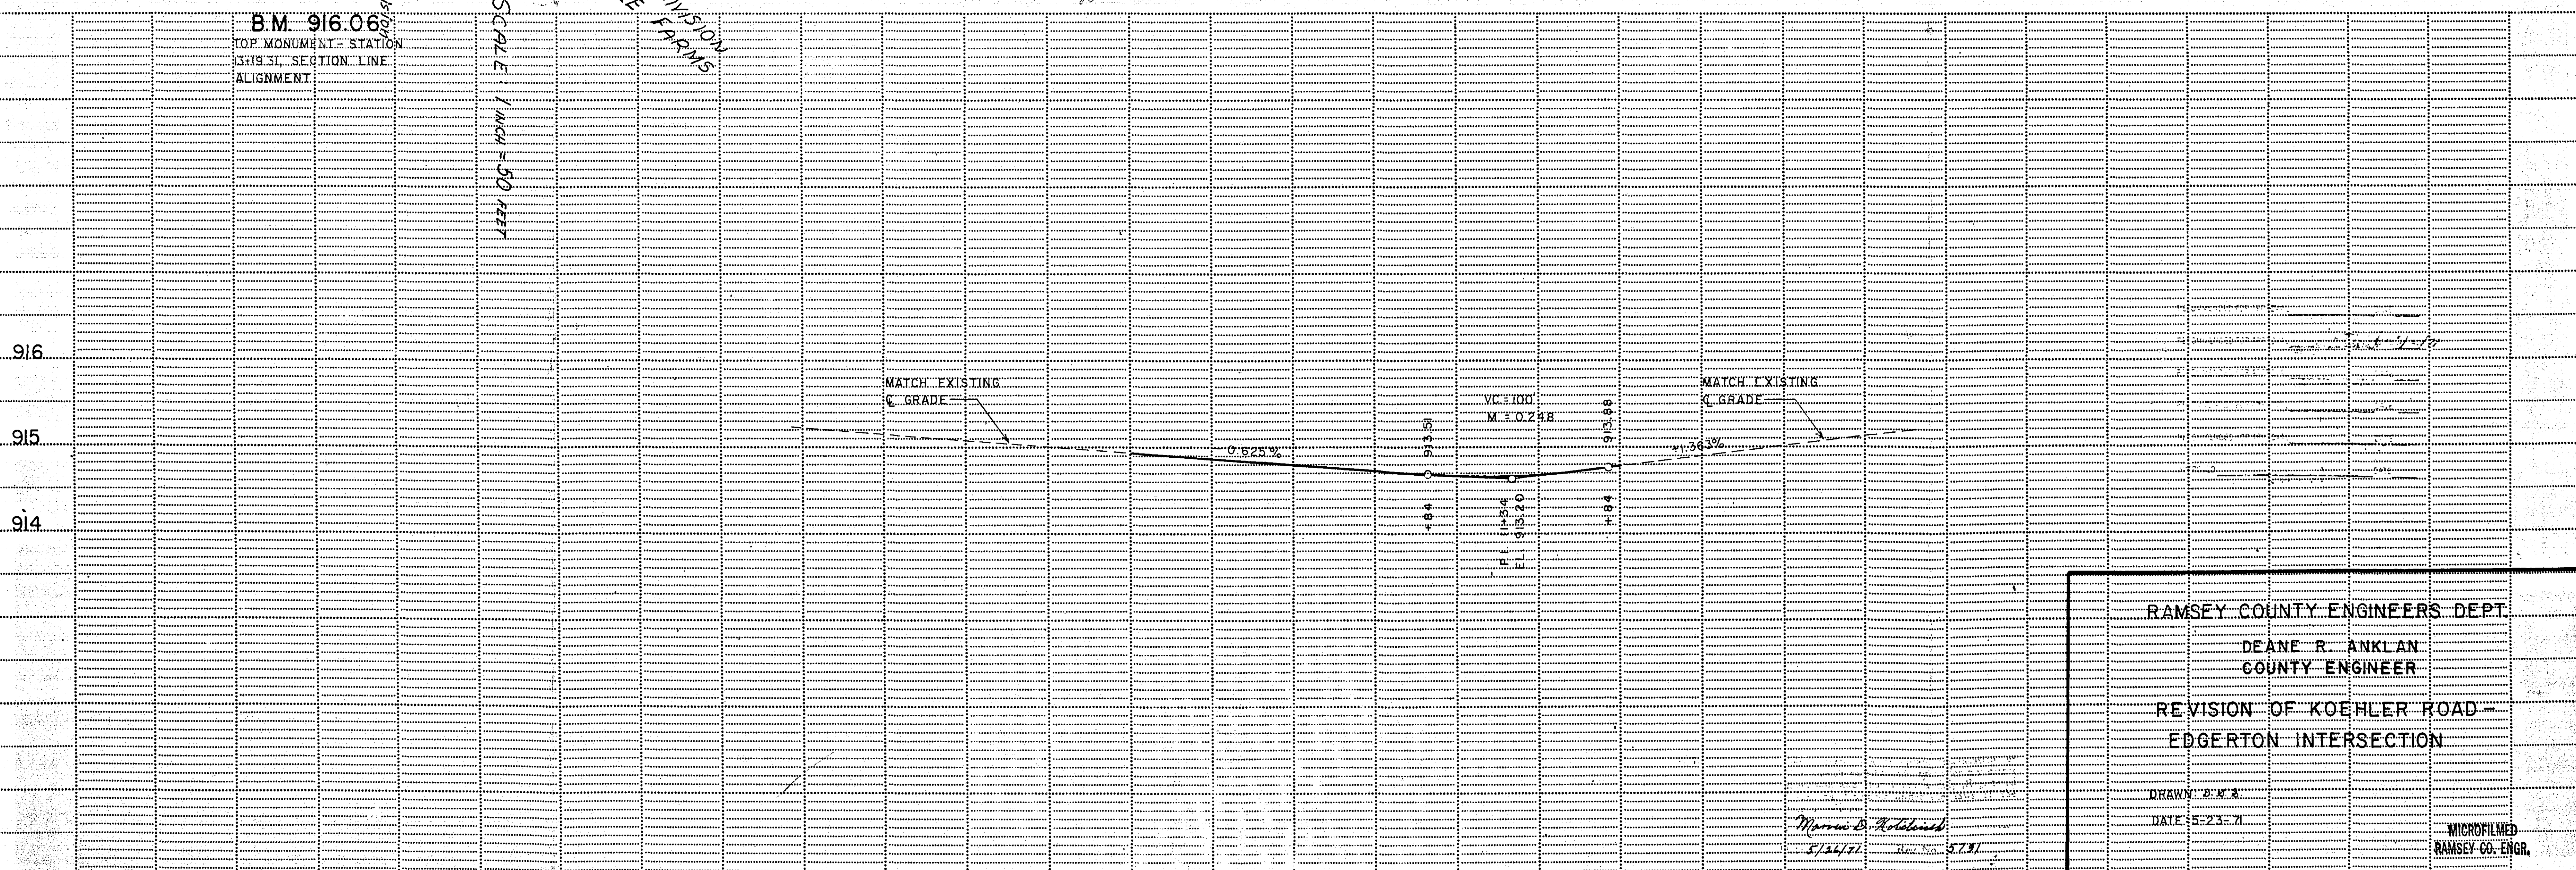

RAMSEY COUNTY ENGINEERS DEPT.
DEANE R. ANKLAN
COUNTY ENGINEER

REVISION OF KOEHLER ROAD -
EDGERTON INTERSECTION

DRAWN BY M.S.
DATE 5-23-71

MICROFILMED
RAMSEY CO. ENGR.

State Proj. No.

Sheet No. of 2 Sheets

COUNTY PROJ. NO. 71-58

16-138