
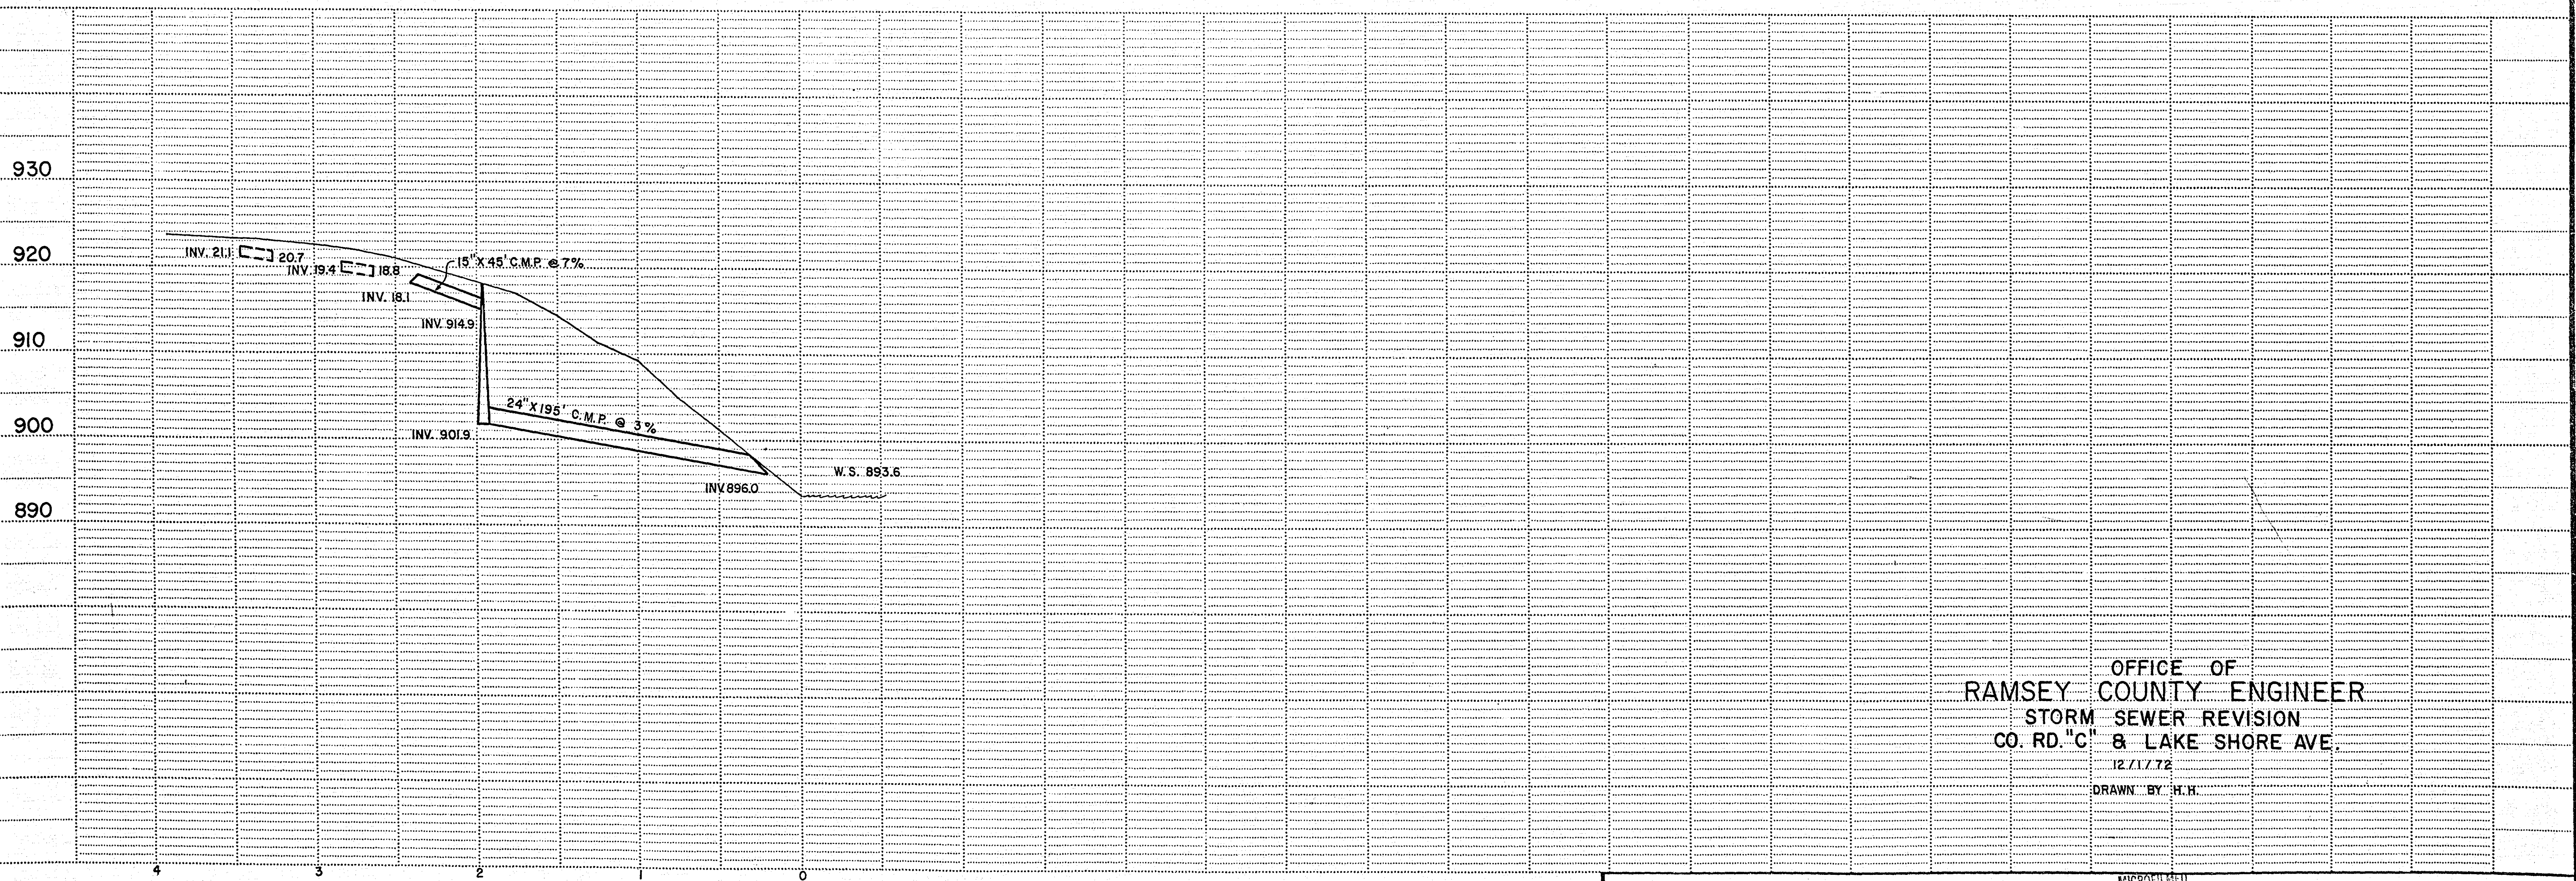


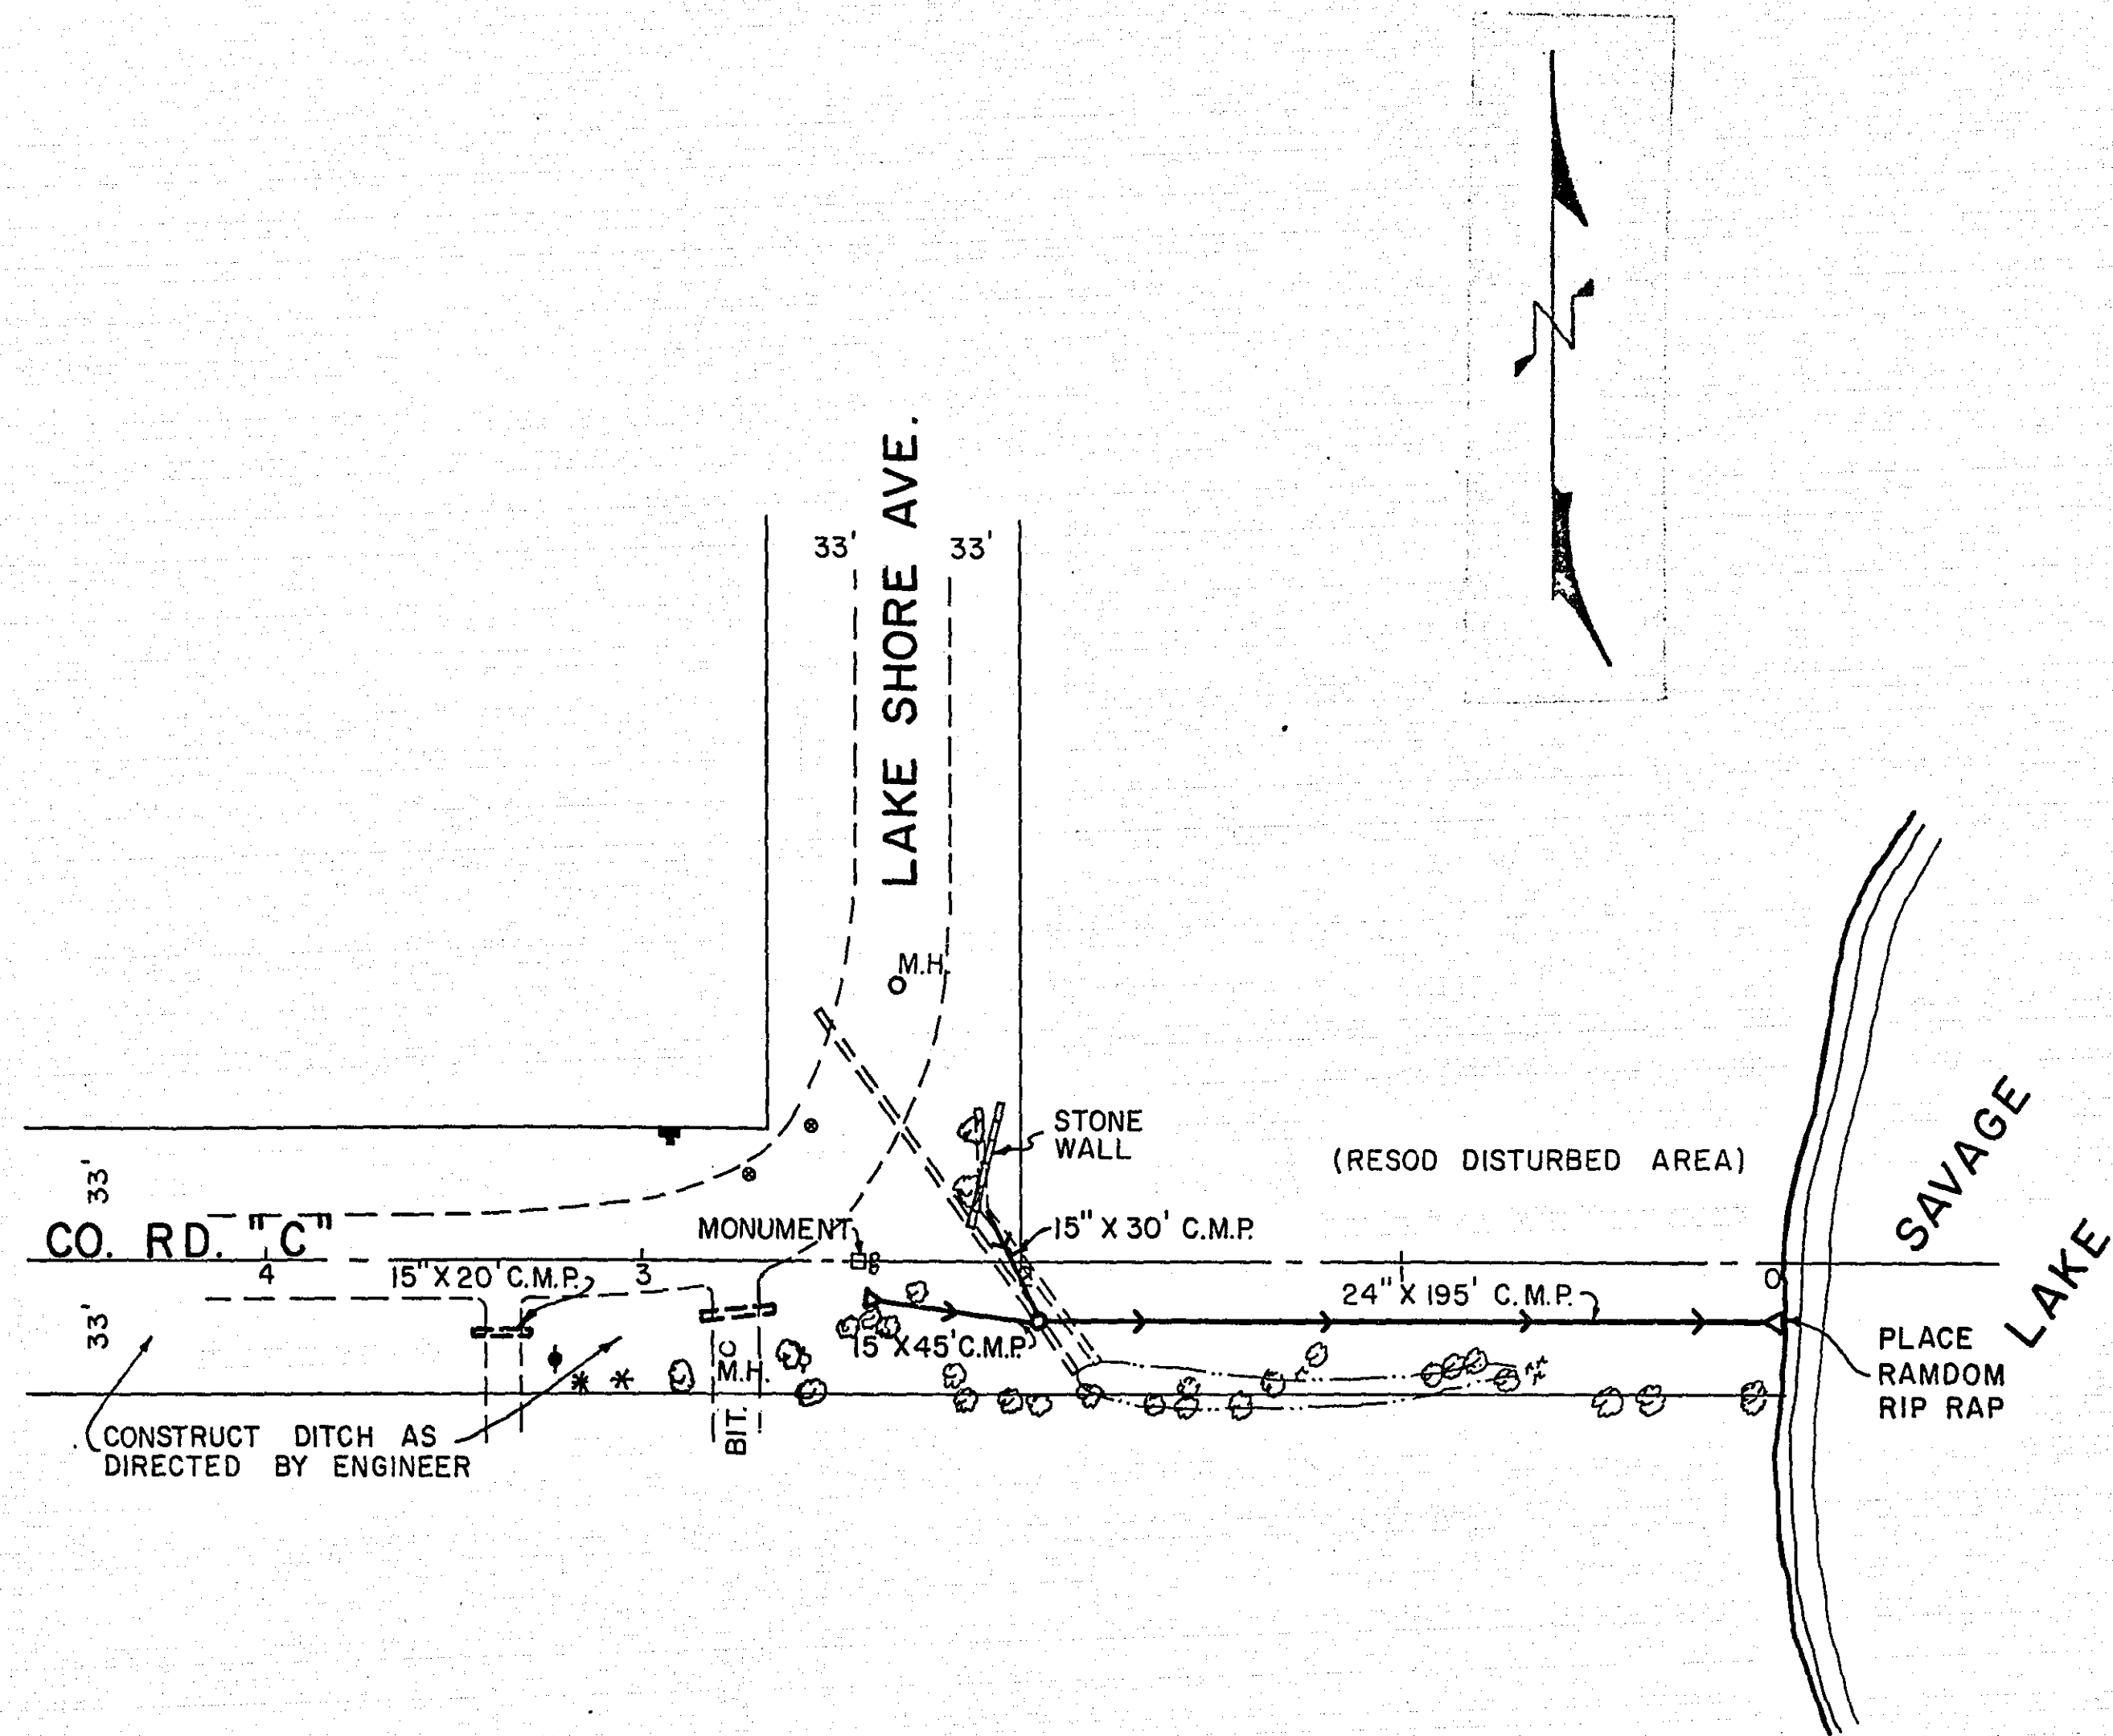

OFFICE OF  
 RAMSEY COUNTY ENGINEER  
 STORM SEWER REVISION  
 CO. RD. "C" & LAKE SHORE AVE.  
 12/1/72  
 DRAWN BY H.H.