

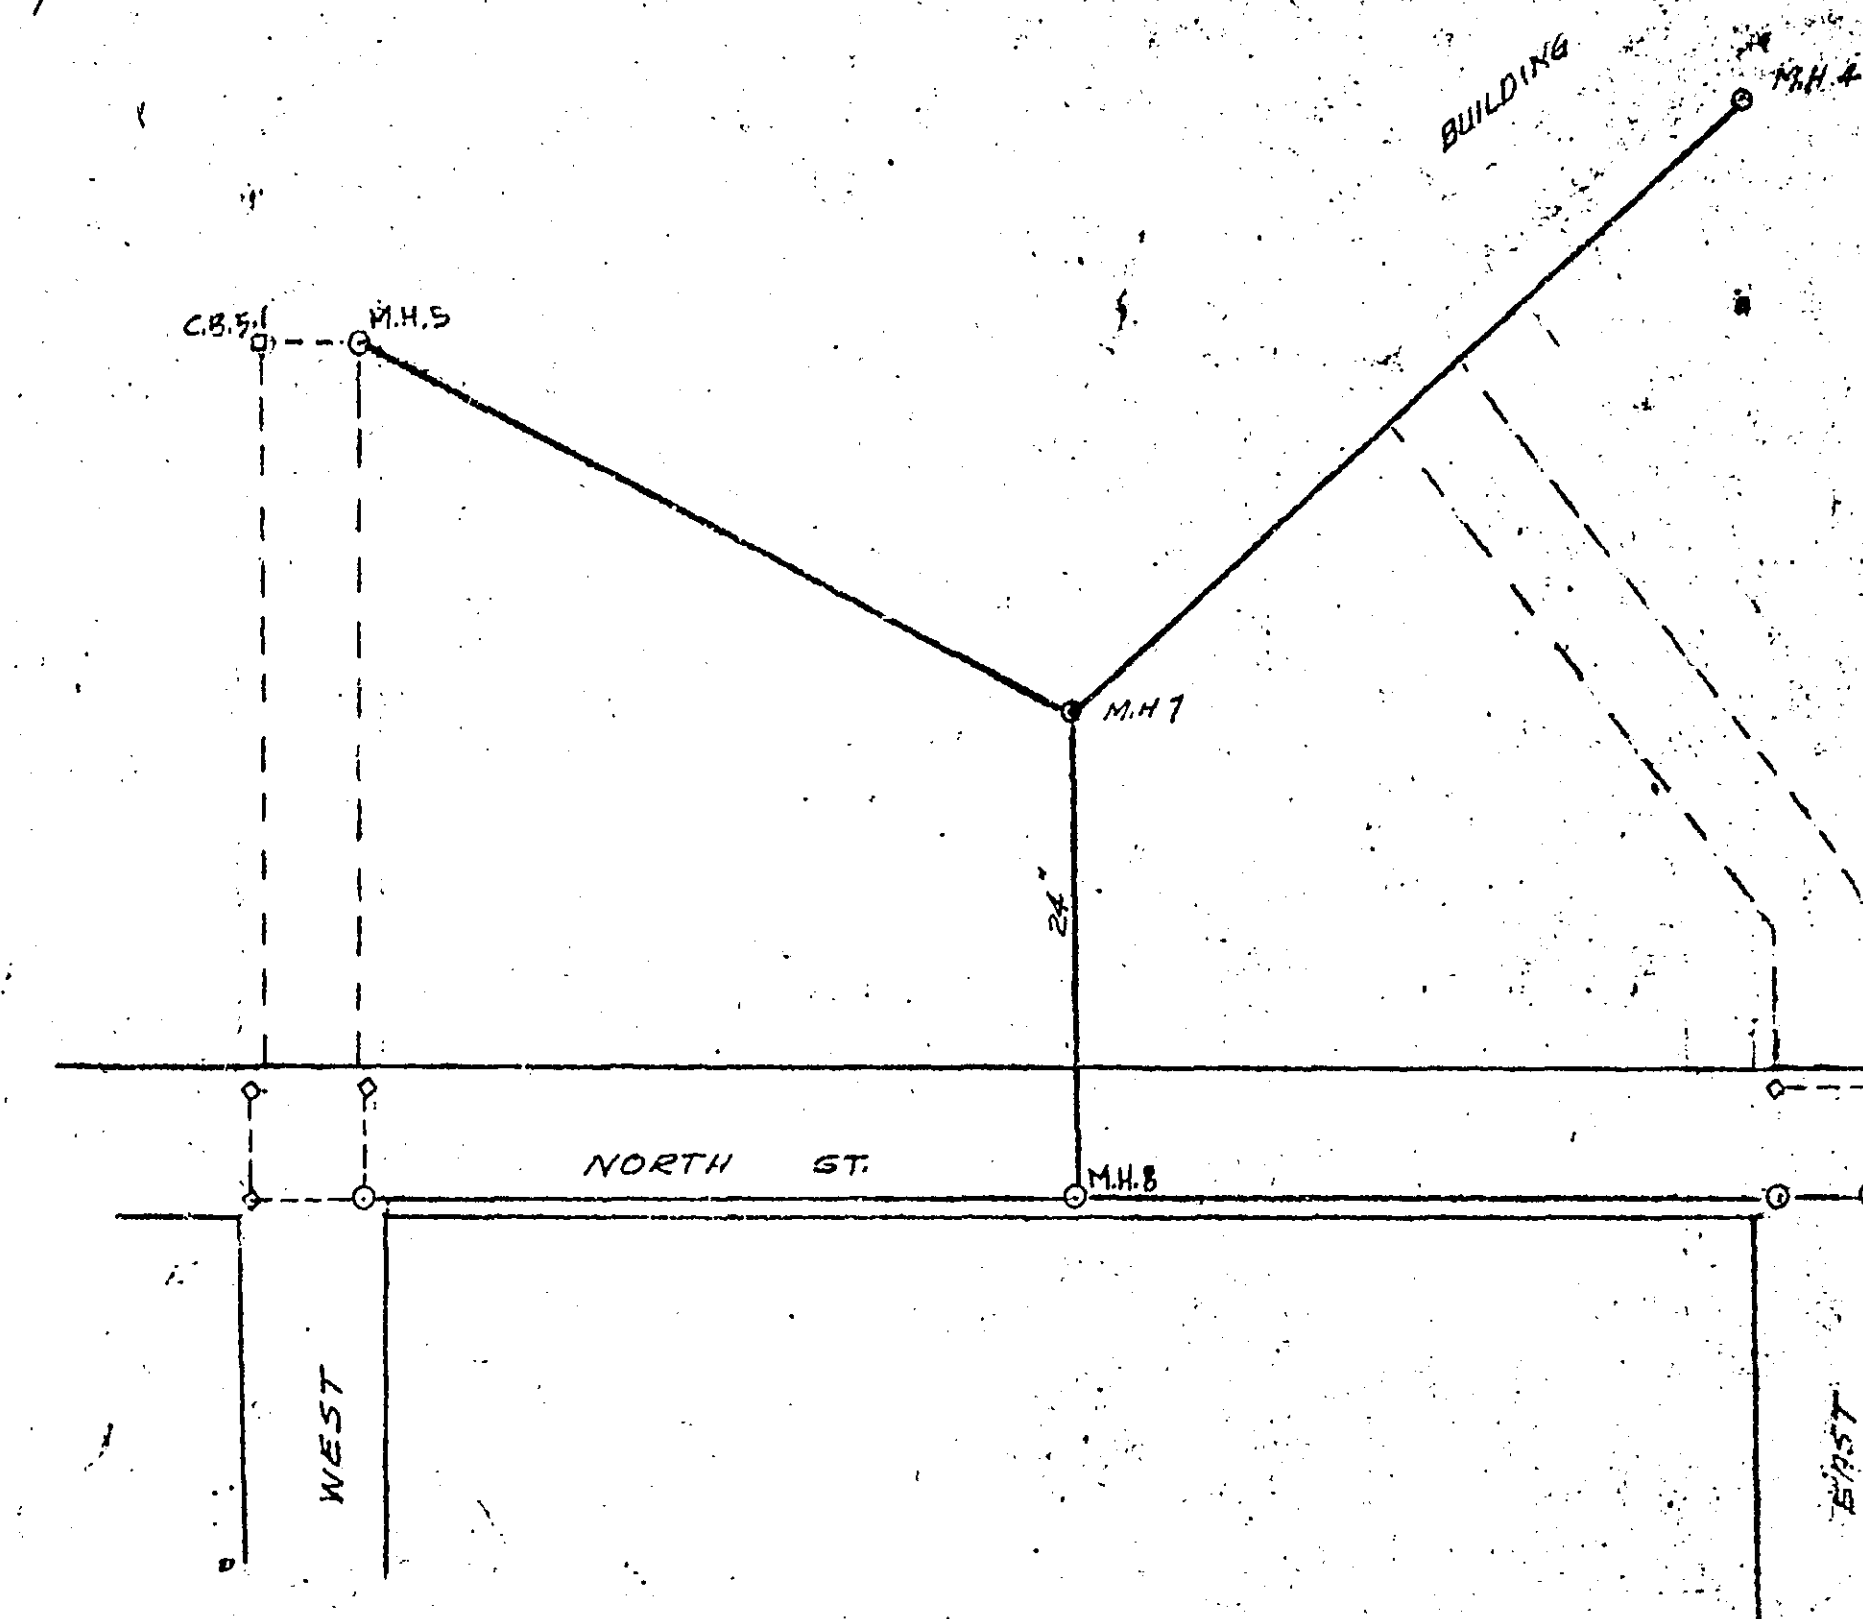
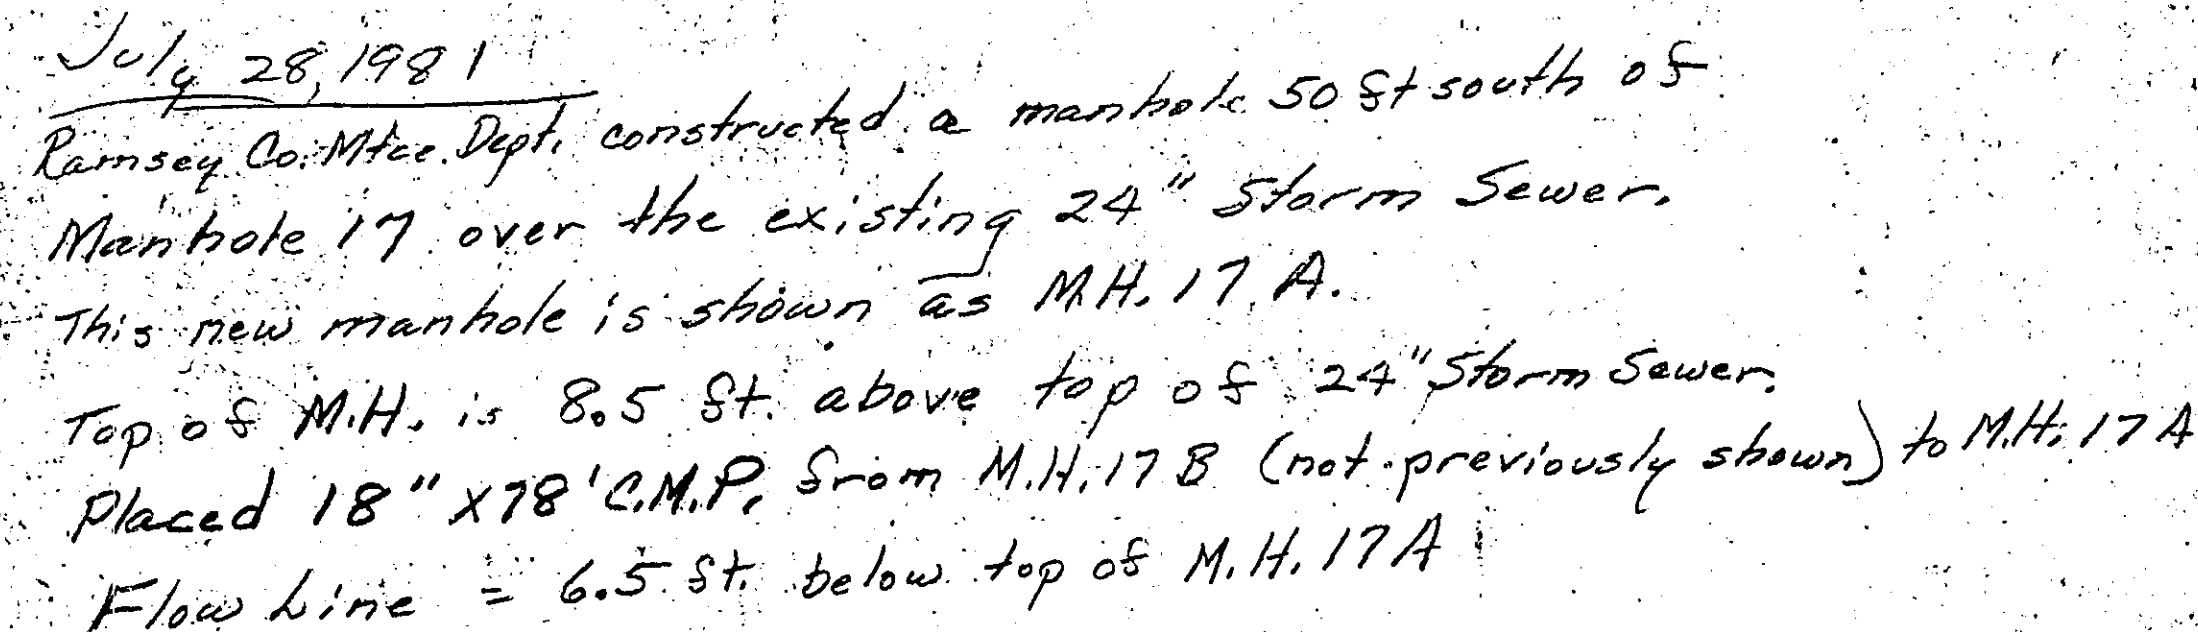


PROFILE	BY	DATE
SUPPLIED		
PLOTTED		
GRADES CHECKED		
REMARKS		

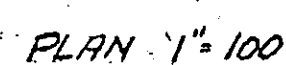

NOTE: this drawing based on design
plan as amended by Blunsdell
Engineering


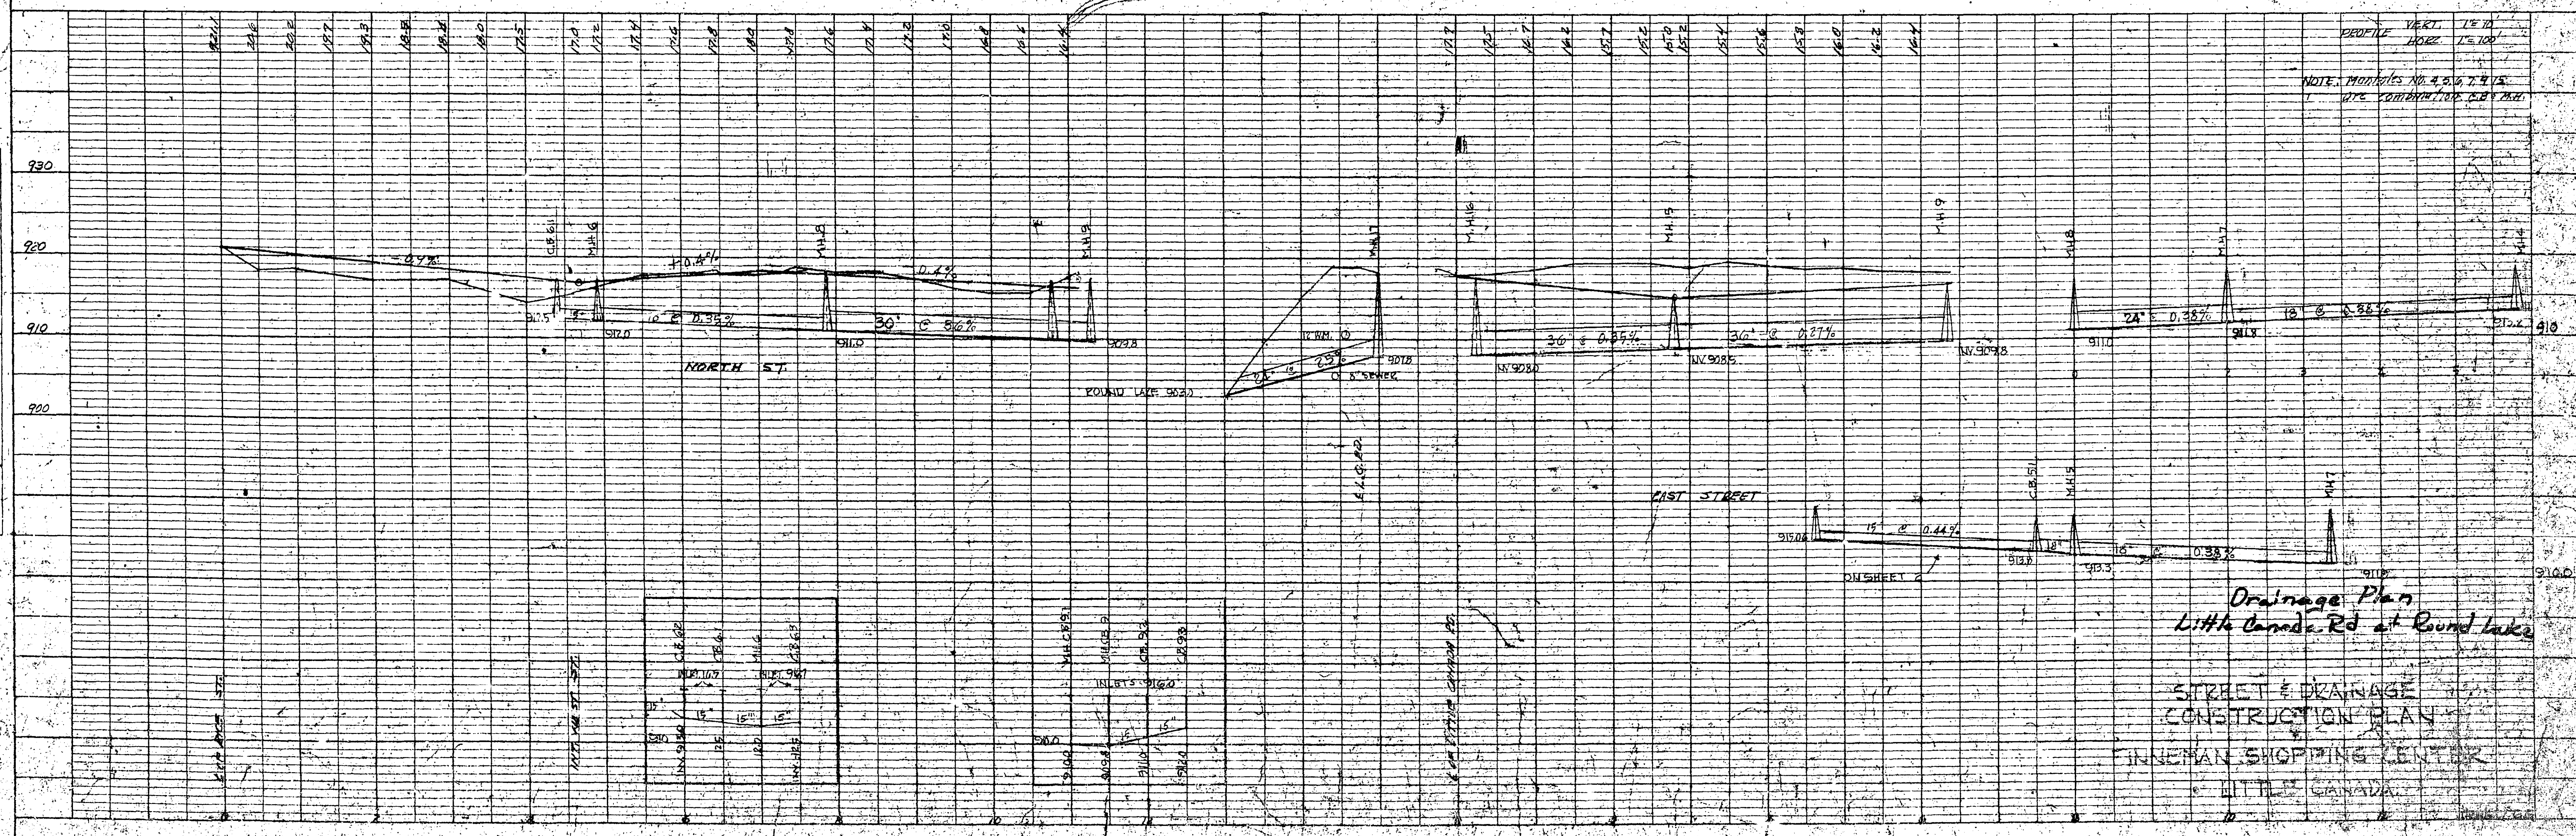


Drainage Plan
Little Canada Rd at Round Lake

STREET & DRAINAGE
CONSTRUCTION PLAN
FINCHMAN SHOPPING CENTER
MILL CANADA

PLAN	DATE	BY
SURVEYED		
DESIGNED		
CHECKED		
NOTED		
BY		

July 28, 1981
 Ramsey Co. Meter Dept. constructed a manhole 50 ft south of
 Manhole 17 over the existing 24" Storm Sewer.
 This new manhole is shown as M.H. 17A.
 Top of M.H. is 8.5 ft. above top of 24" Storm Sewer.
 Flow Line = 6.5 ft. below top of M.H. 17A.

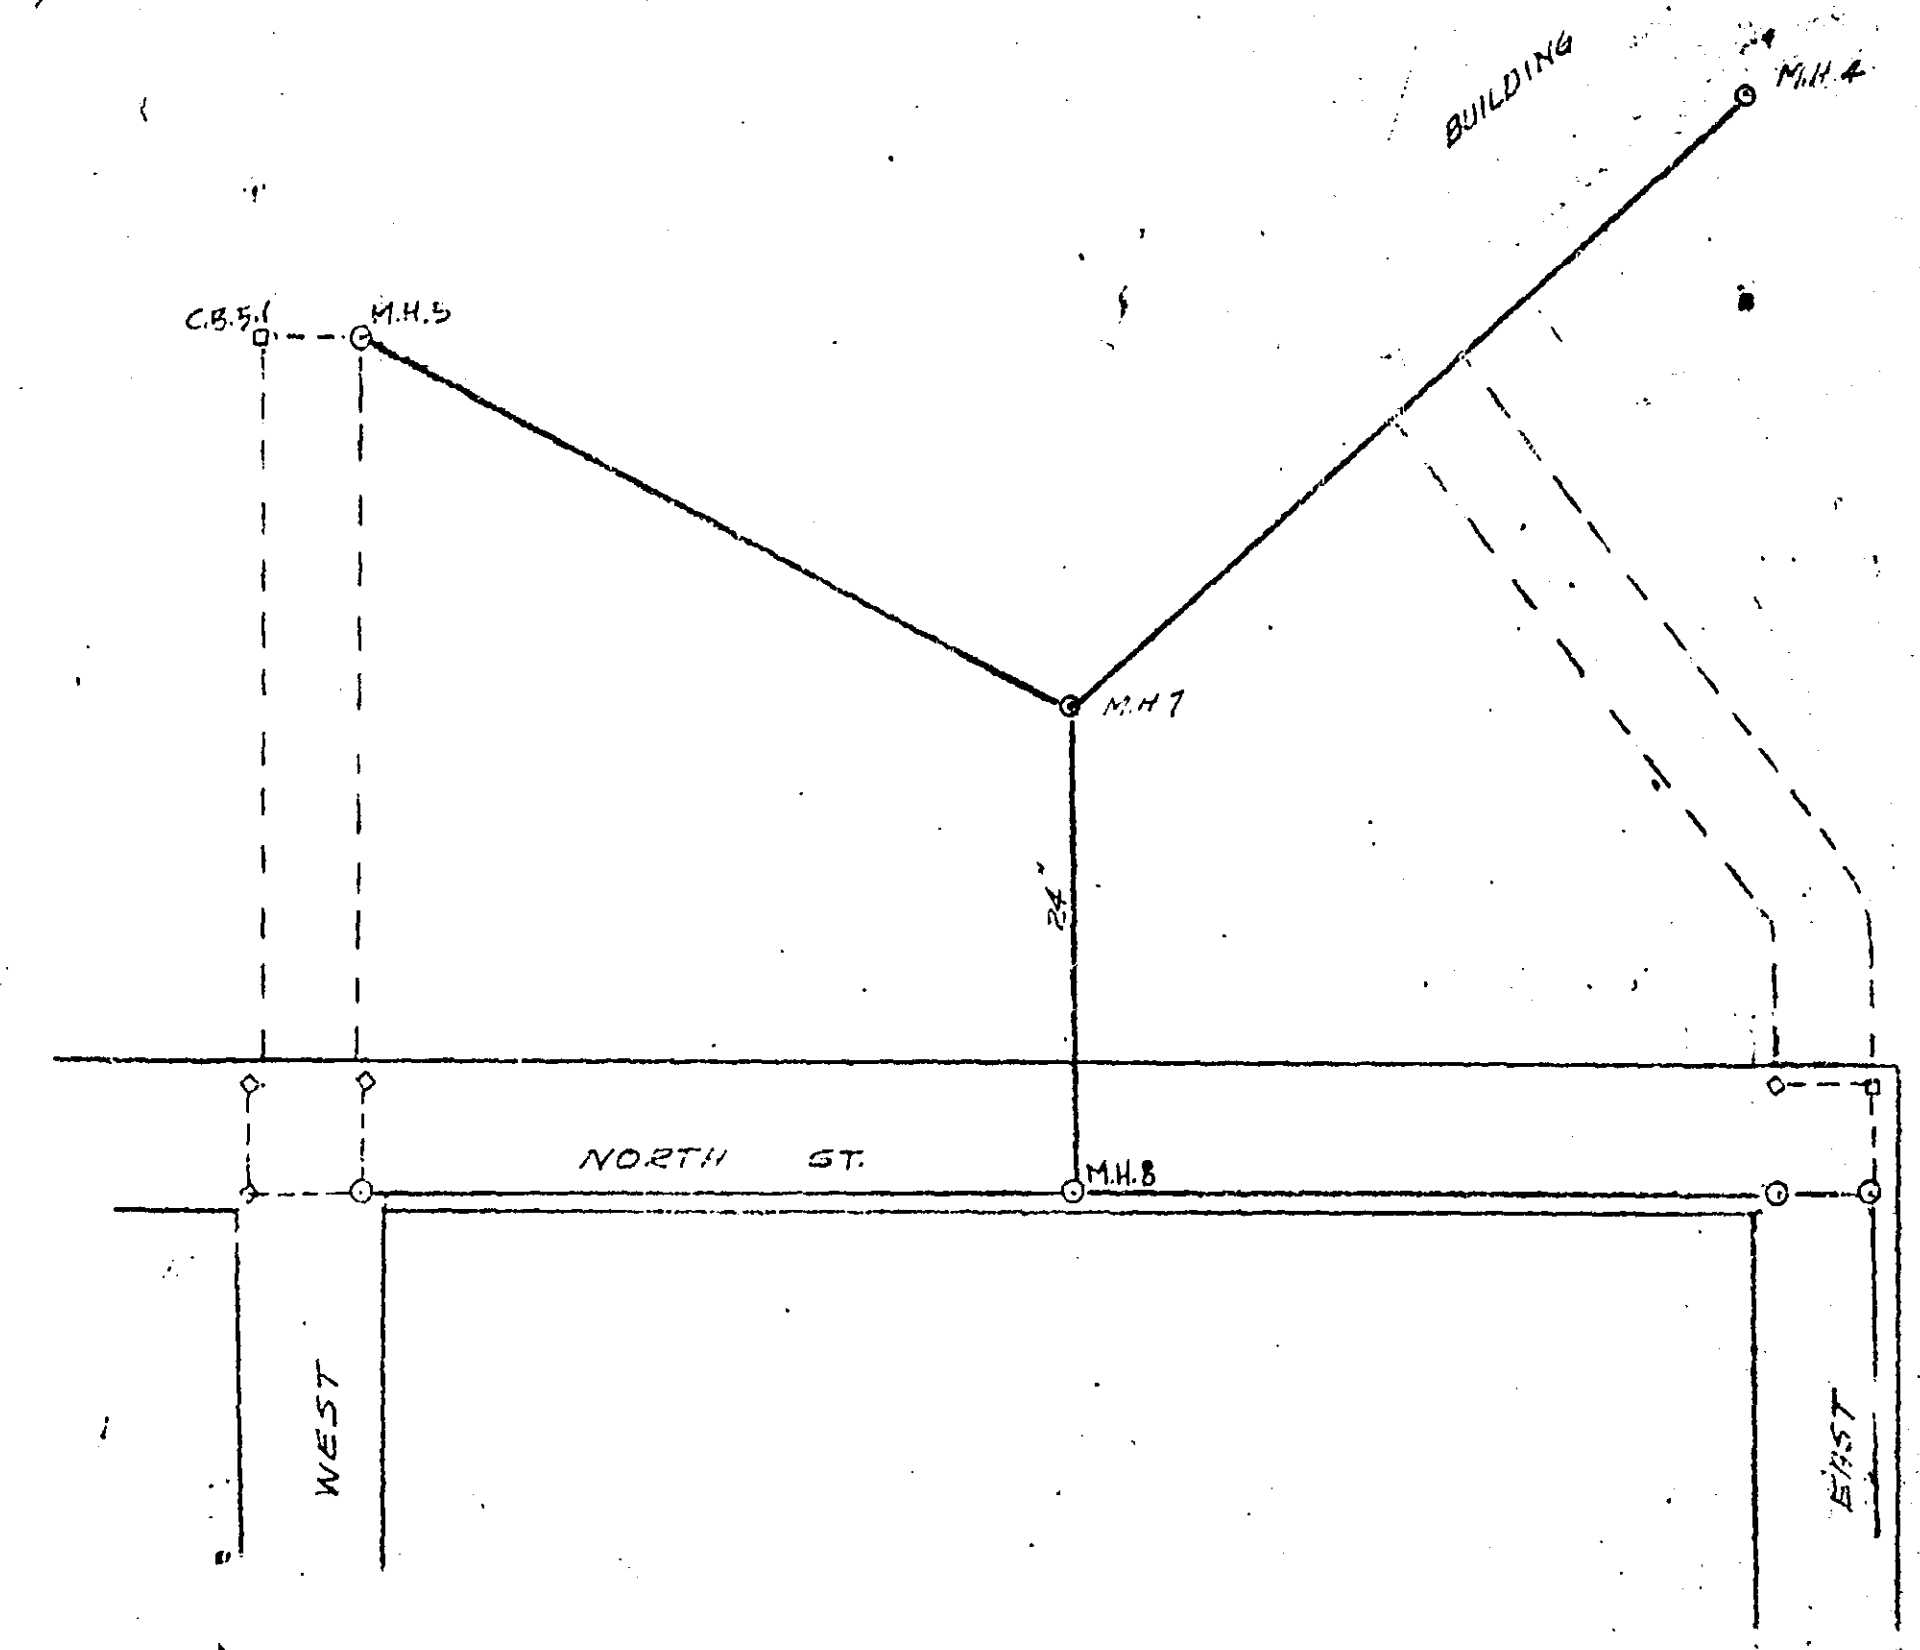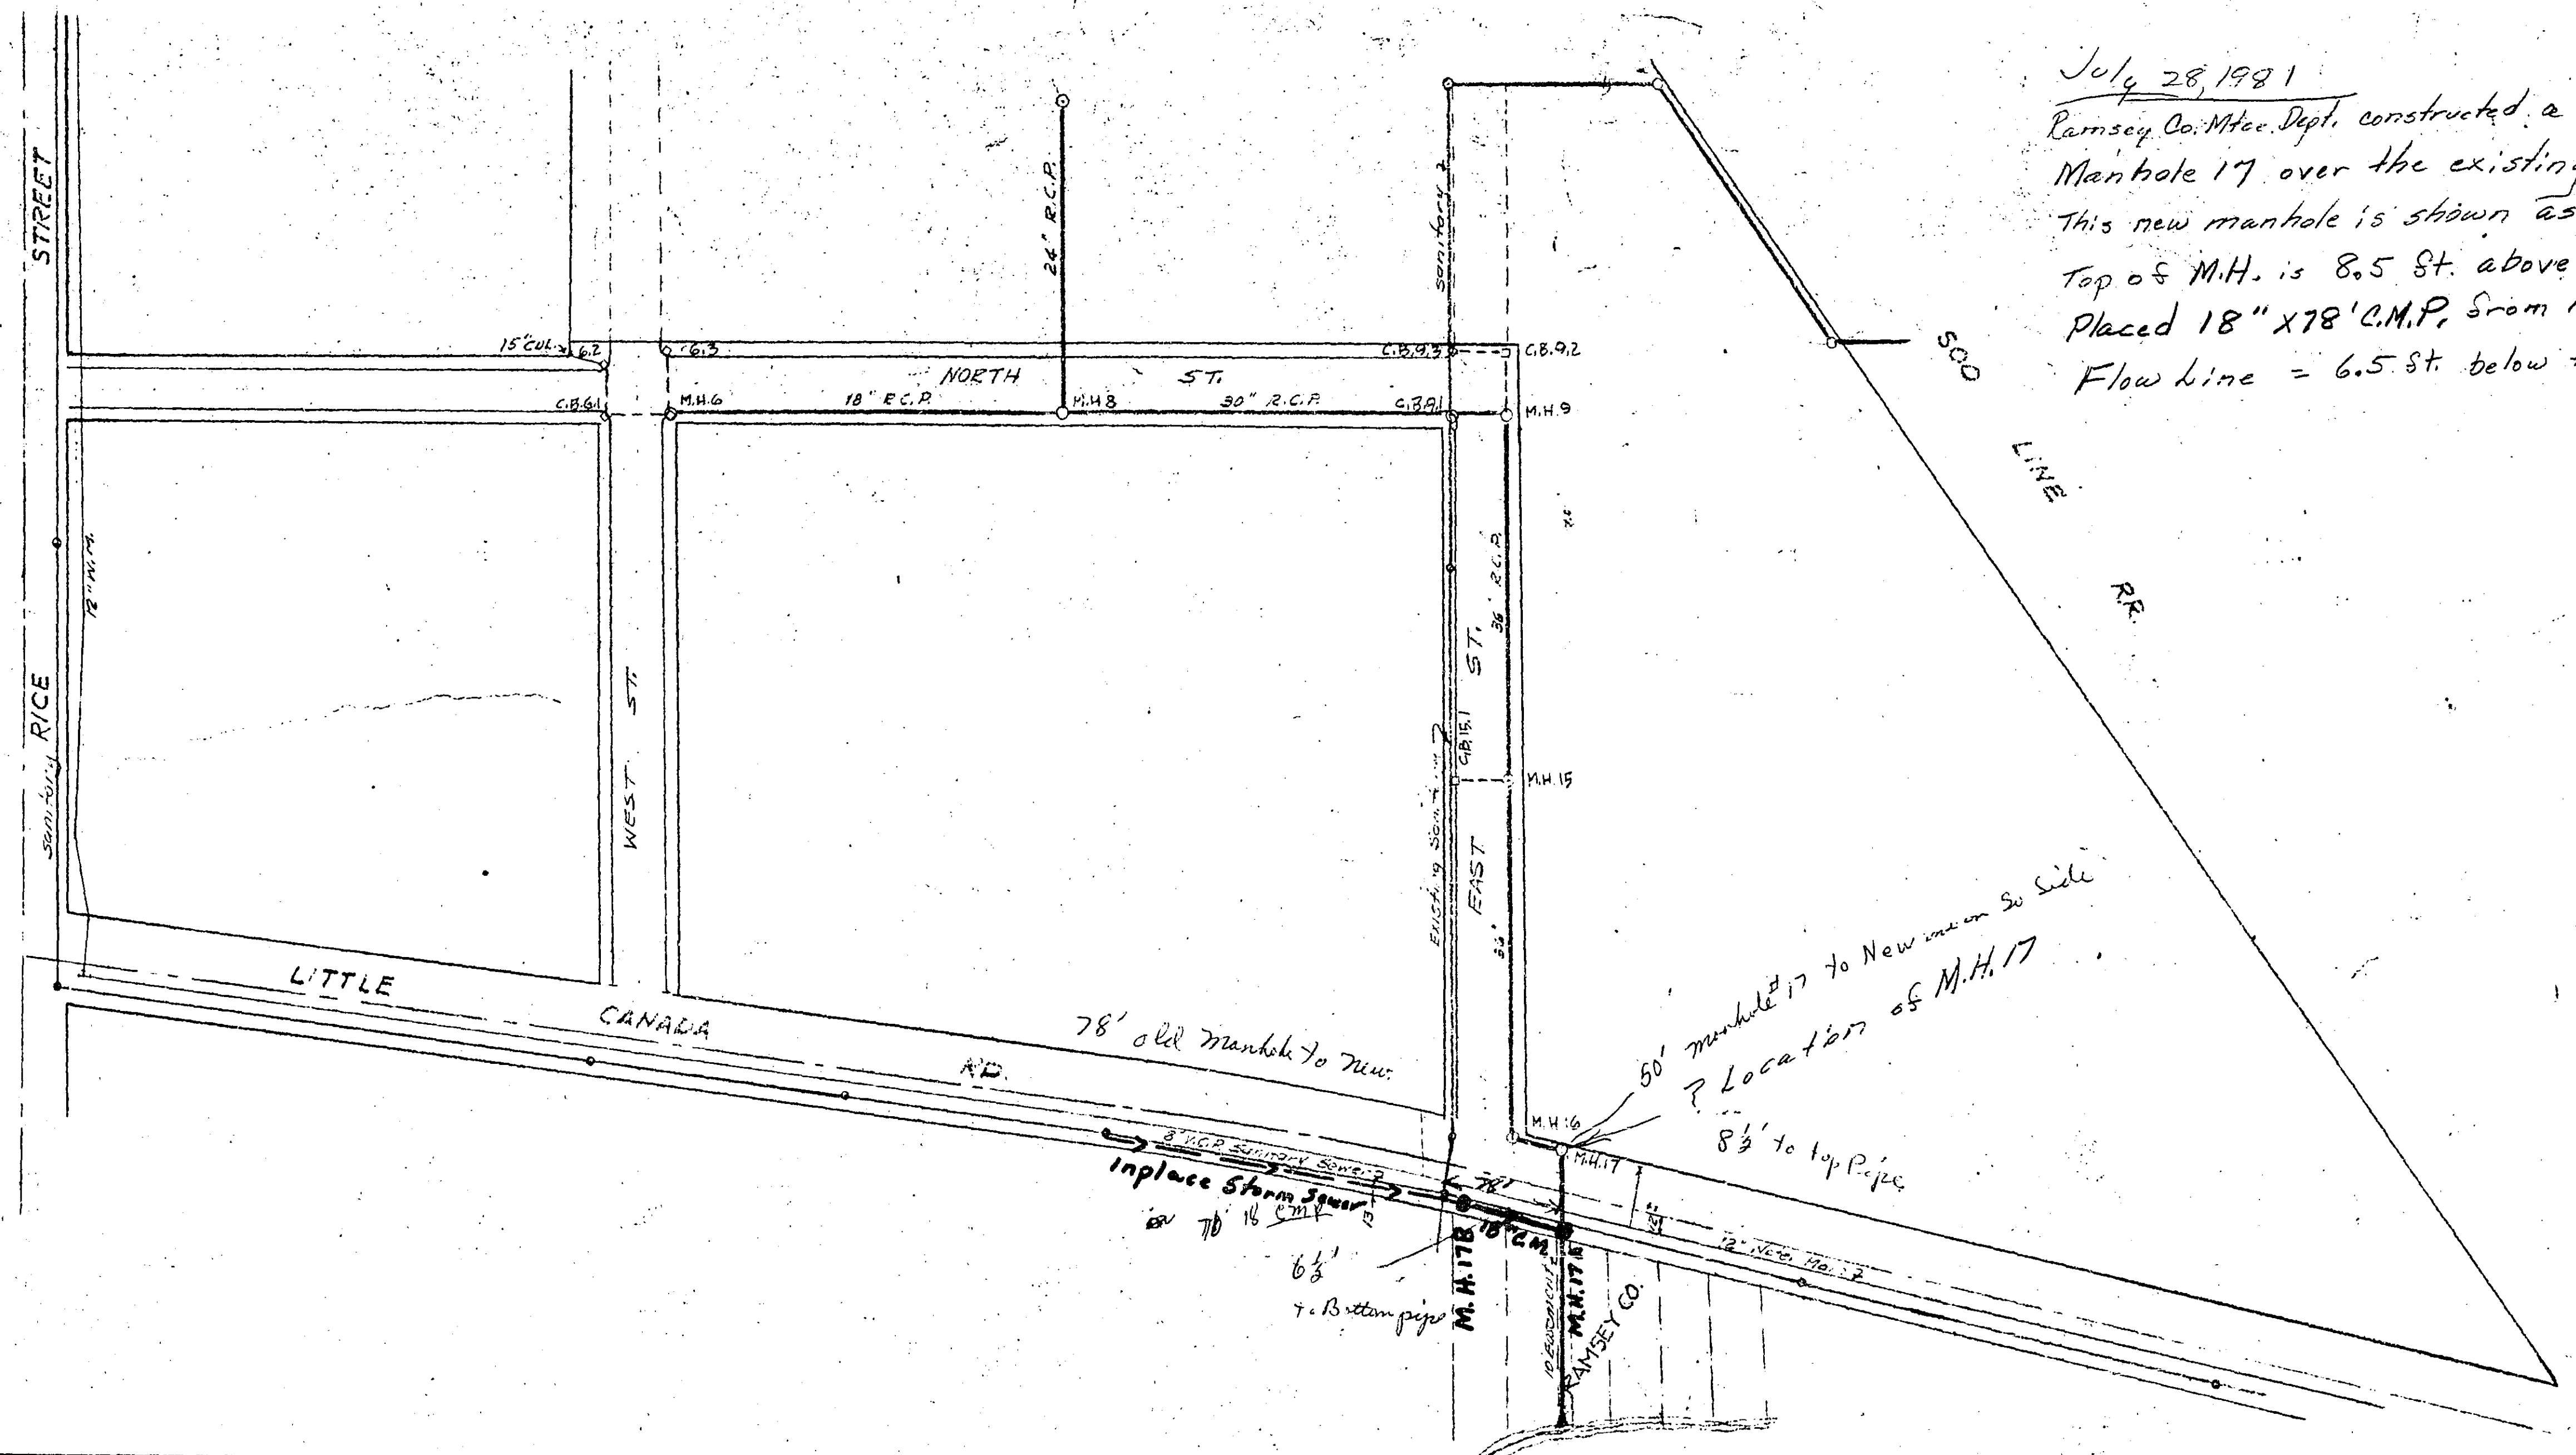

NOTE: This drawing based on design plan as amended by Blaisdell Engineering

PROFILE	DATE	BY
SURVEYED		
DESIGNED		
CHECKED		
NOTED		
BY		

