


PAVEMENT LOCATION

NORTH OWASSO BLVD.

OCTOBER, 1978

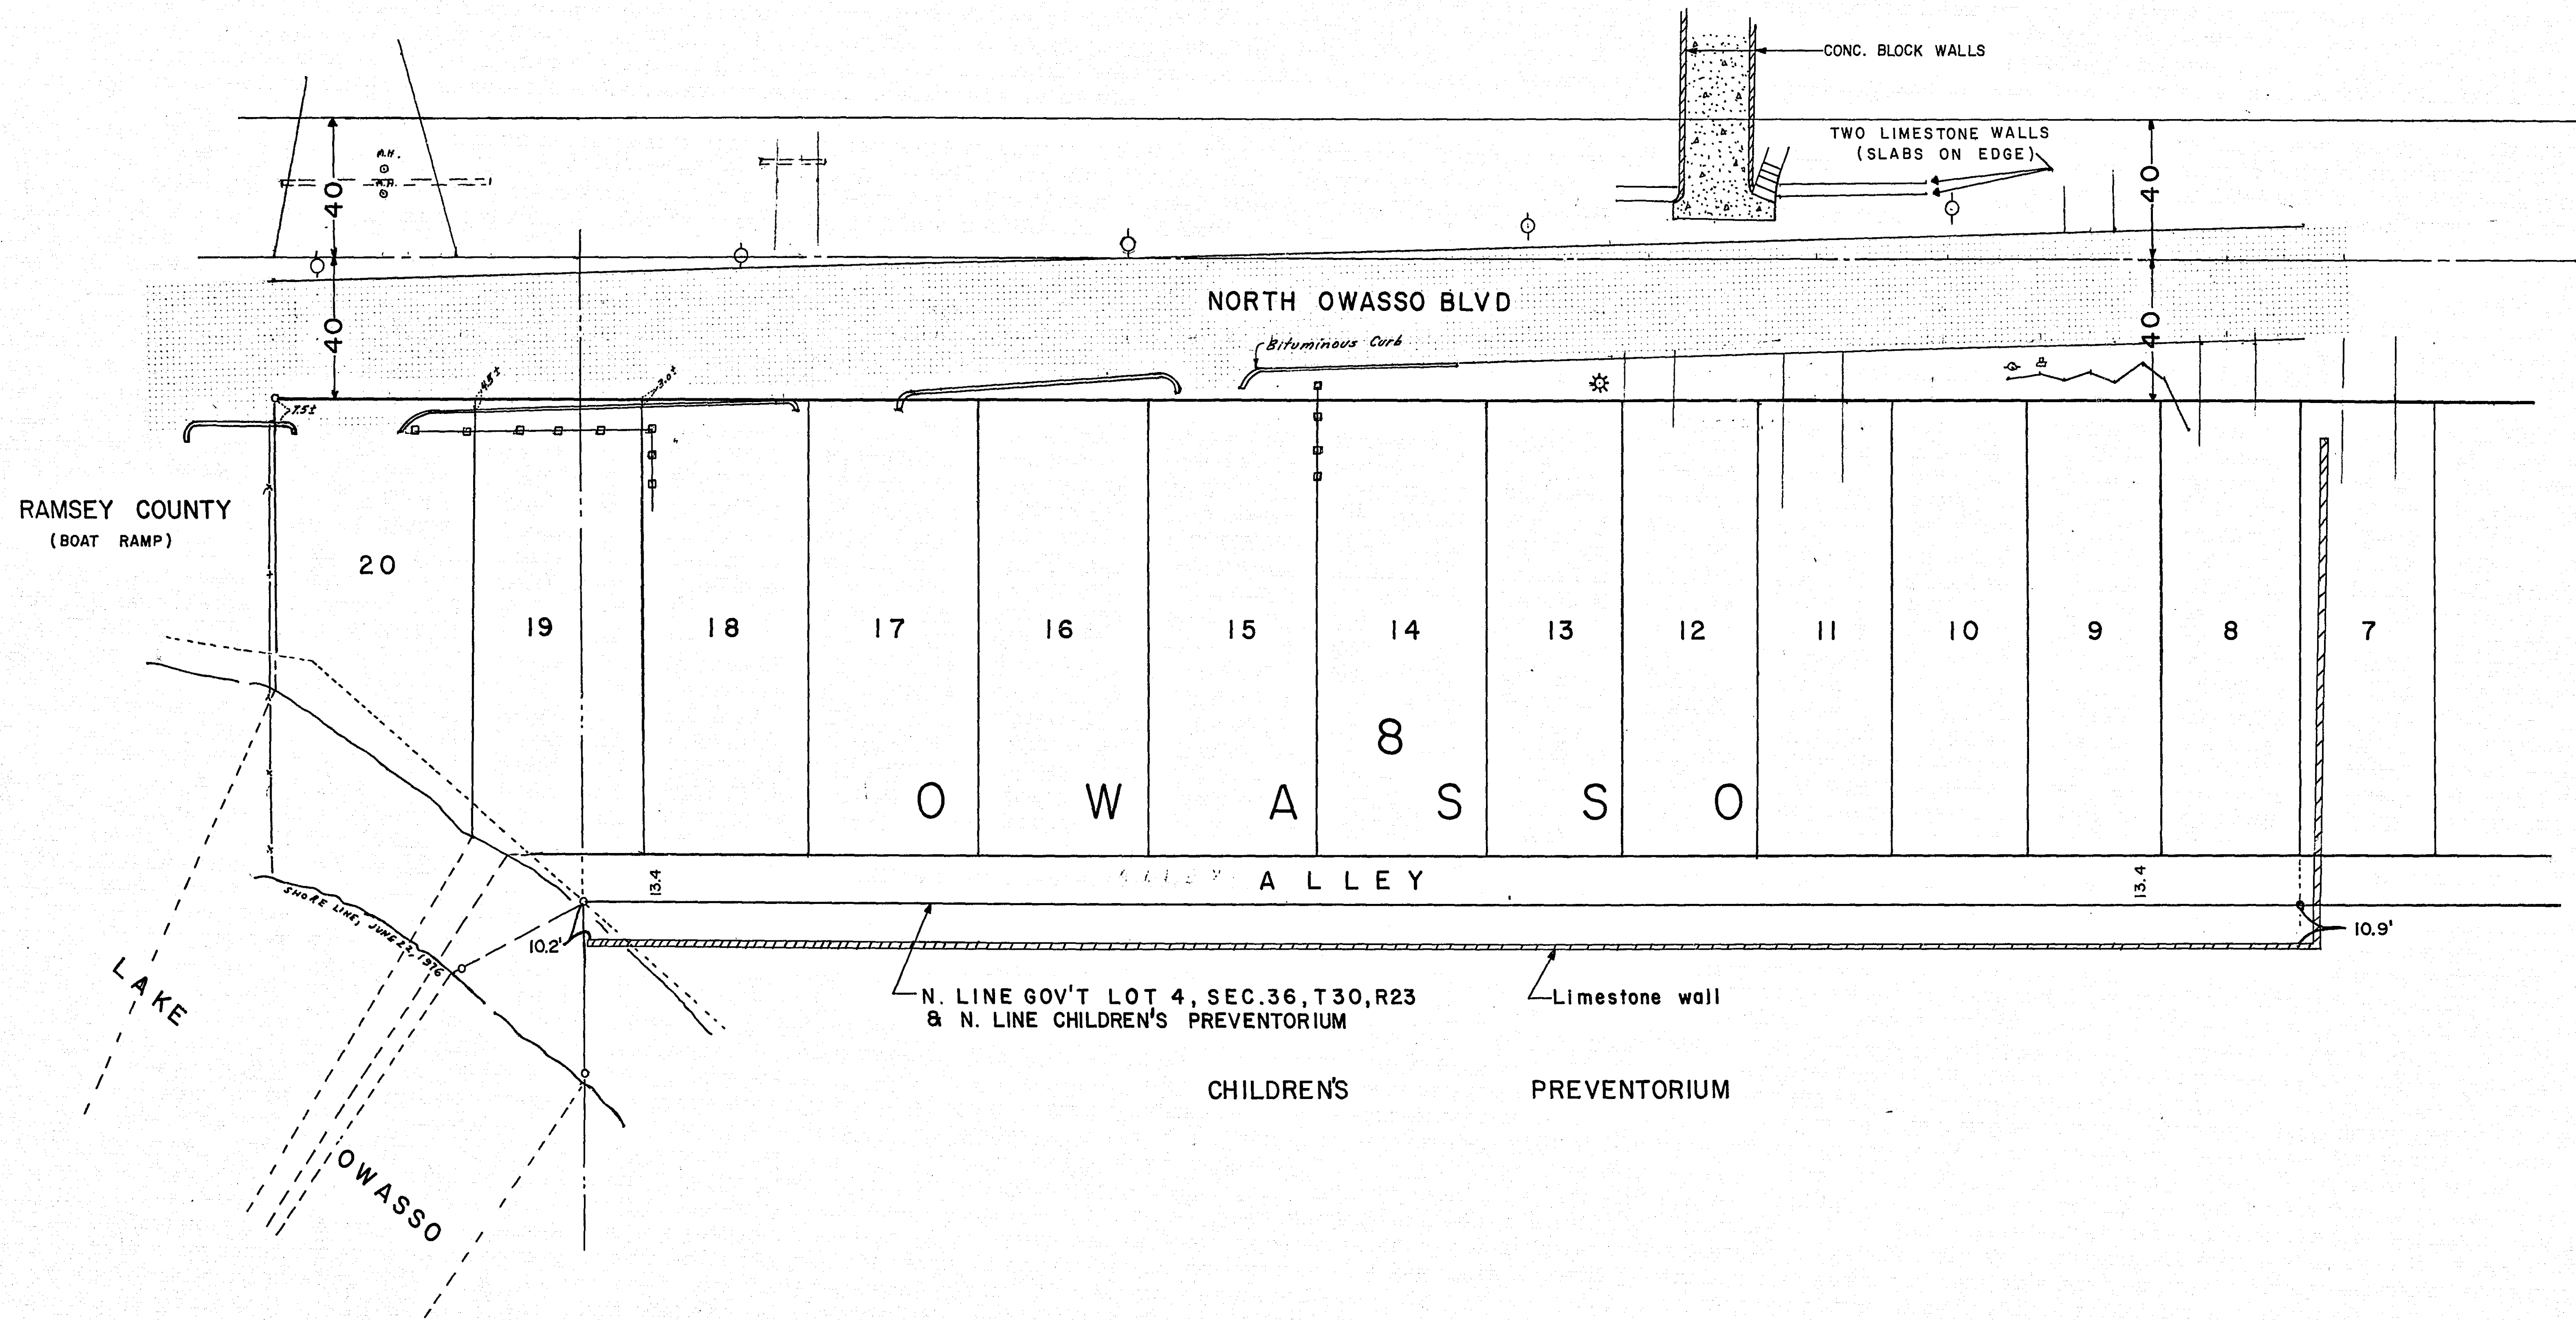

Scale 1" = 30'

MICROFILMED
RAMSEY CO. ENGR.

21-112