


Scale: 1"=200'

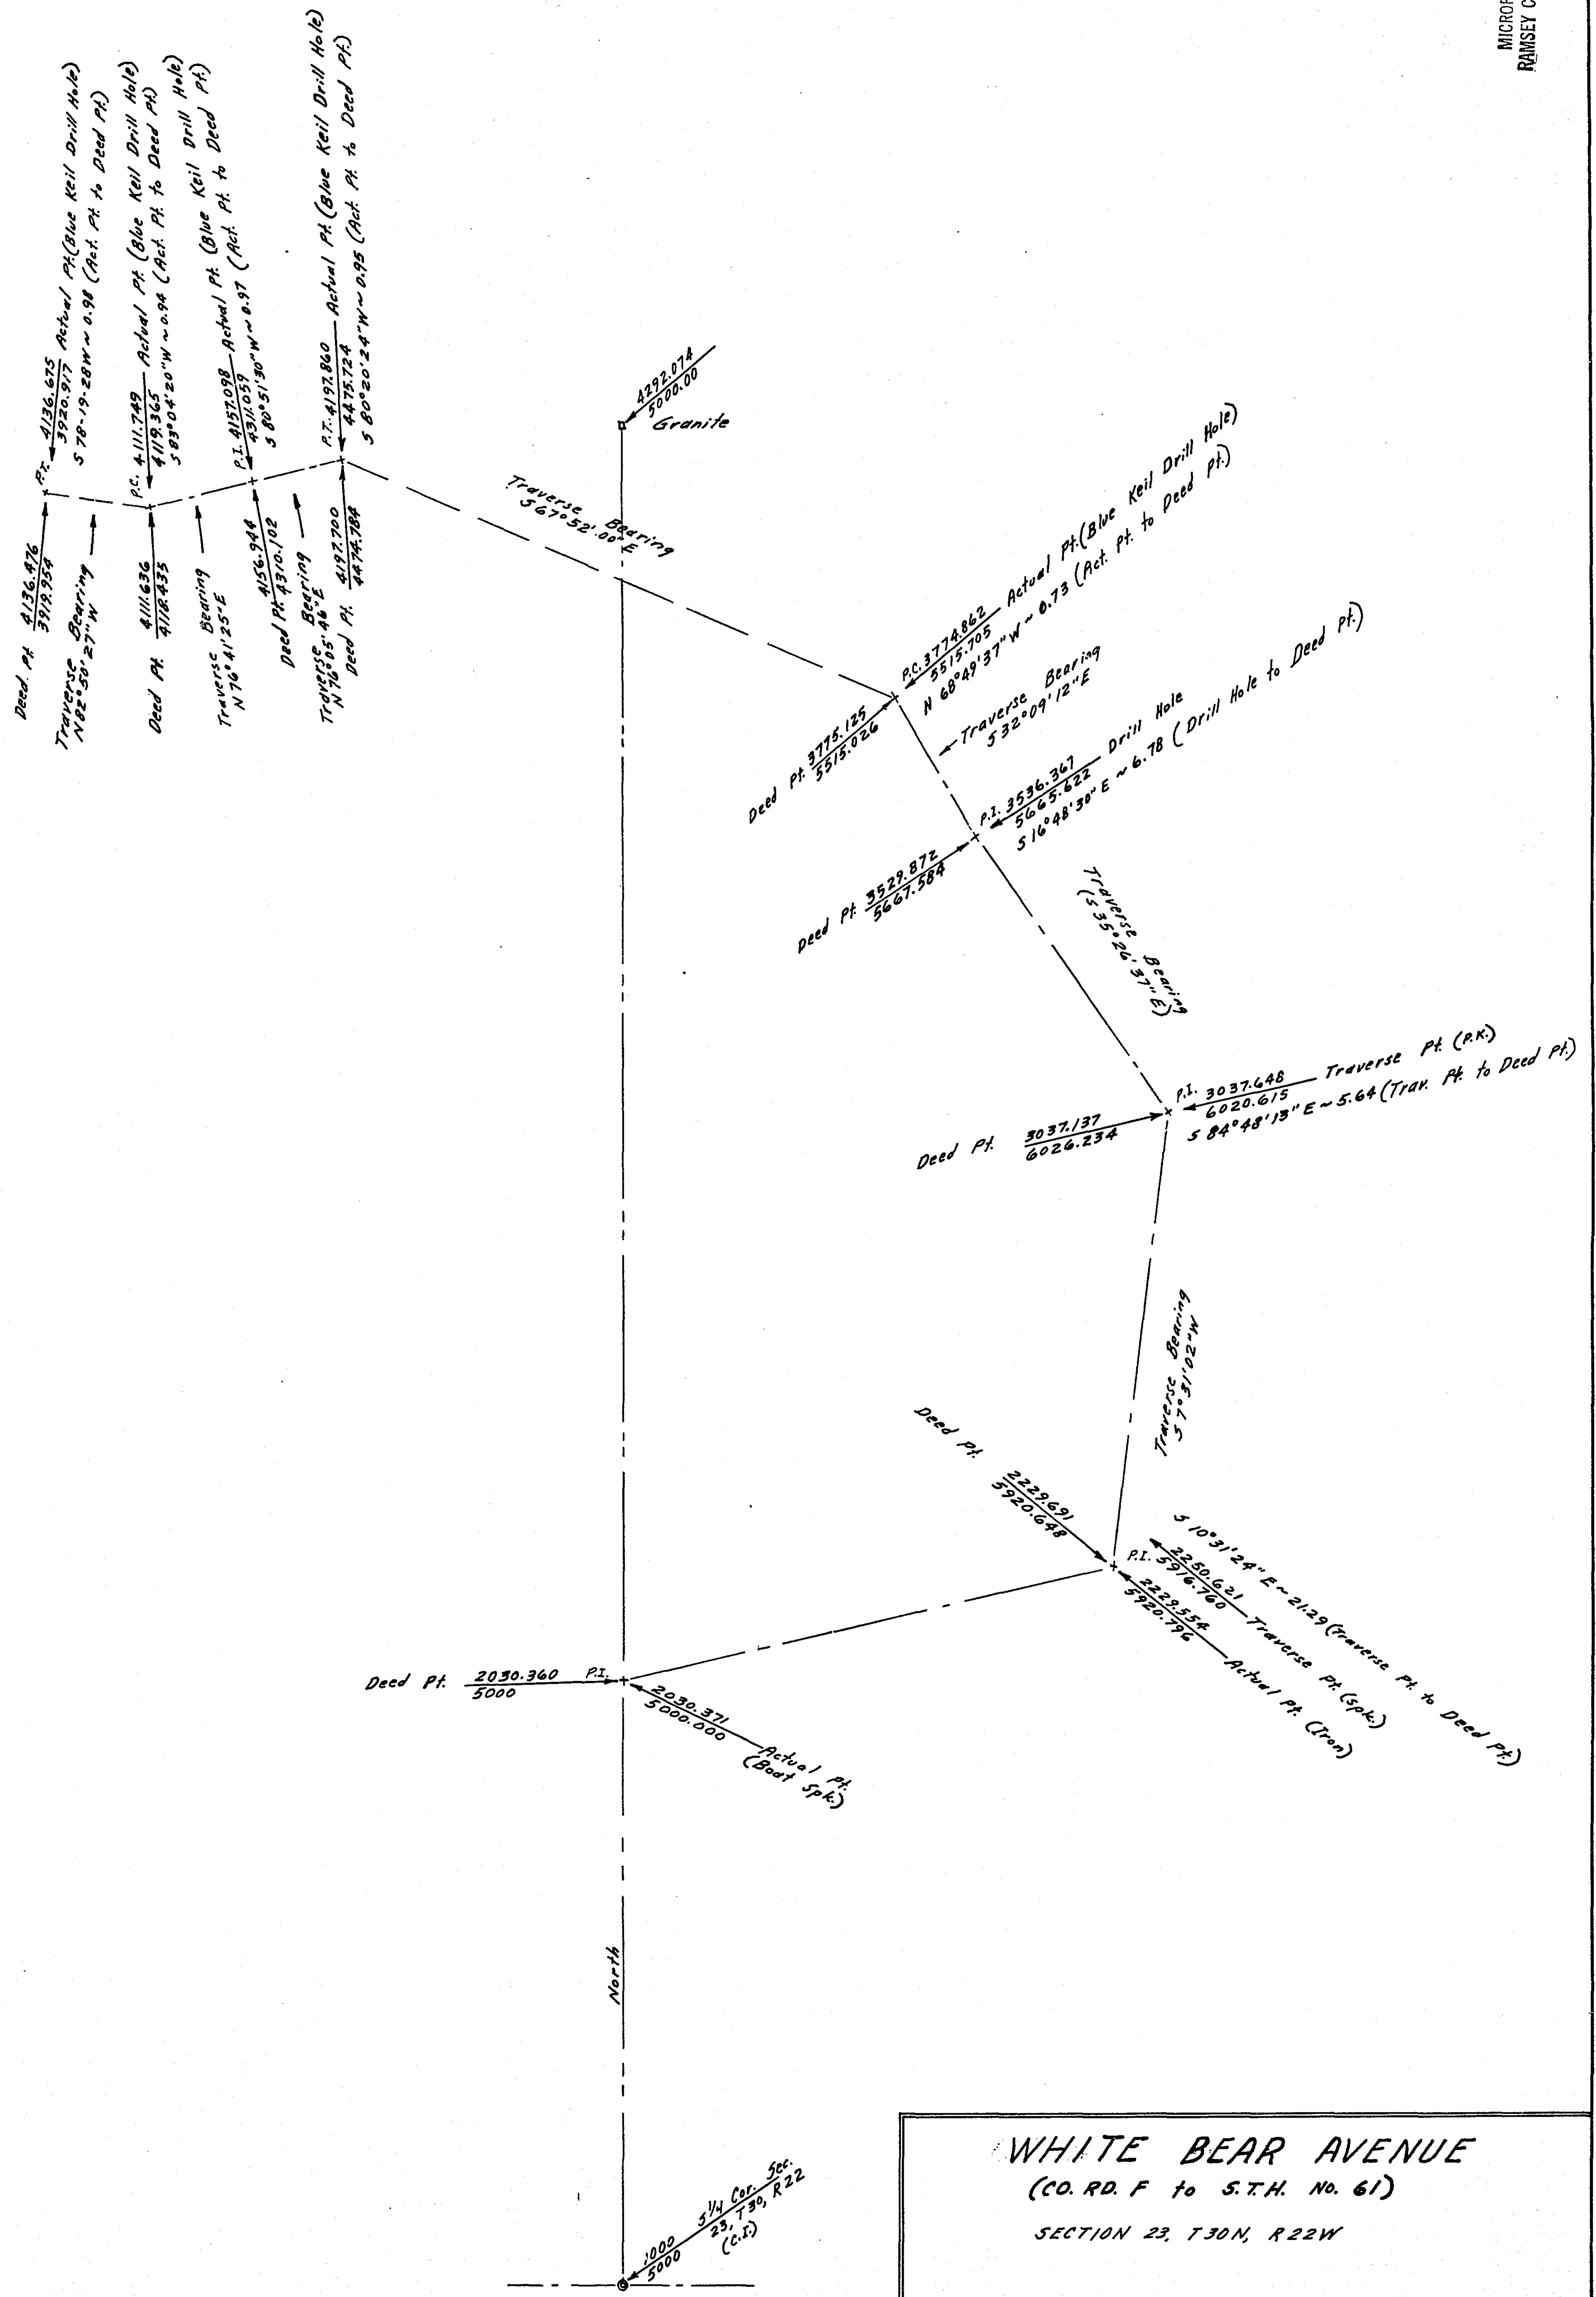

**WHITE BEAR AVENUE**  
(CO. RD. F to S.T.H. No. 61)  
SECTION 23, T30N, R22W

Field Crew: Ron Meyer  
Mike Fiebigler  
Paul Kinsella  
Bret Wieman  
Feb. & March, 1978

21-114

21-114