



RAMSEY COUNTY SURVEYOR'S OFFICE
CONSTRUCTION PROFILE

RAMSEY COUNTY
COUNTY PROJECT NO 23-51
DODD ROAD ~ So. WABASHA TO T.H. No 1
Sta 7+22 to Sta. 38+28.68

MICROFILMED
BY CO. ENGR.
23-51

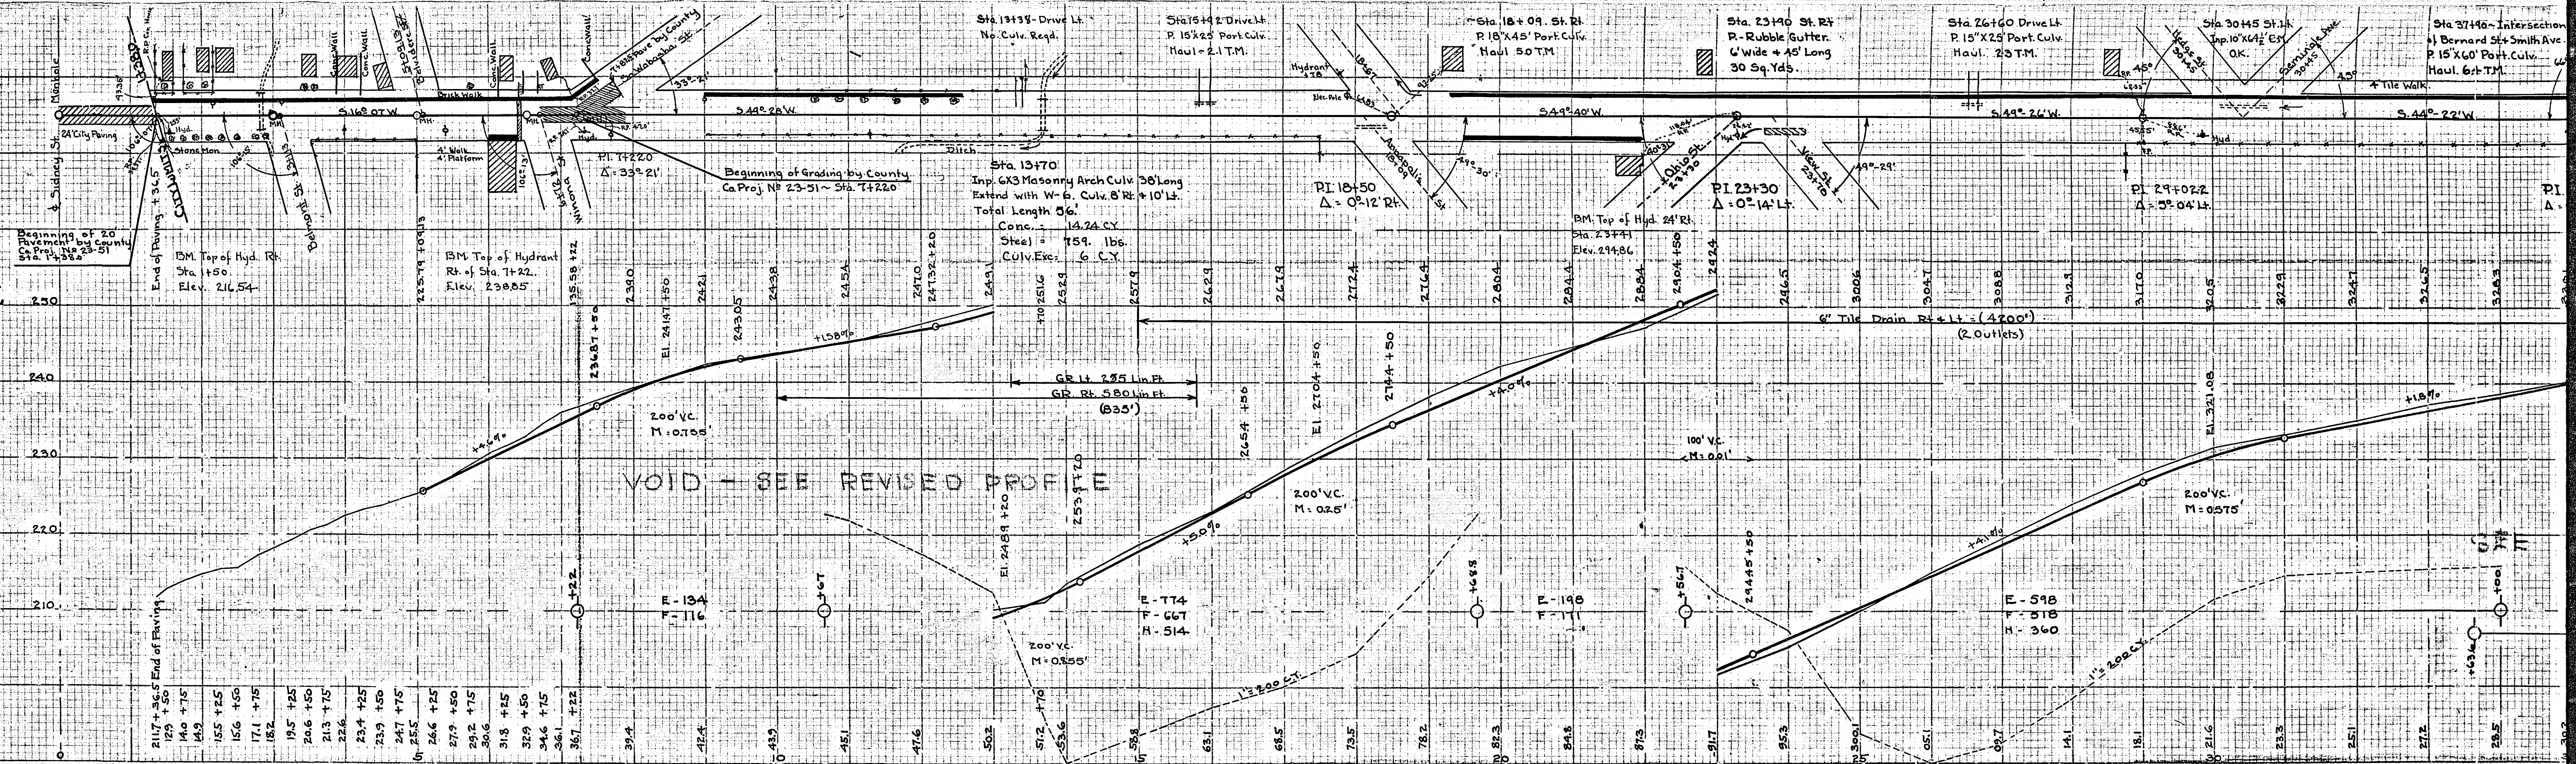

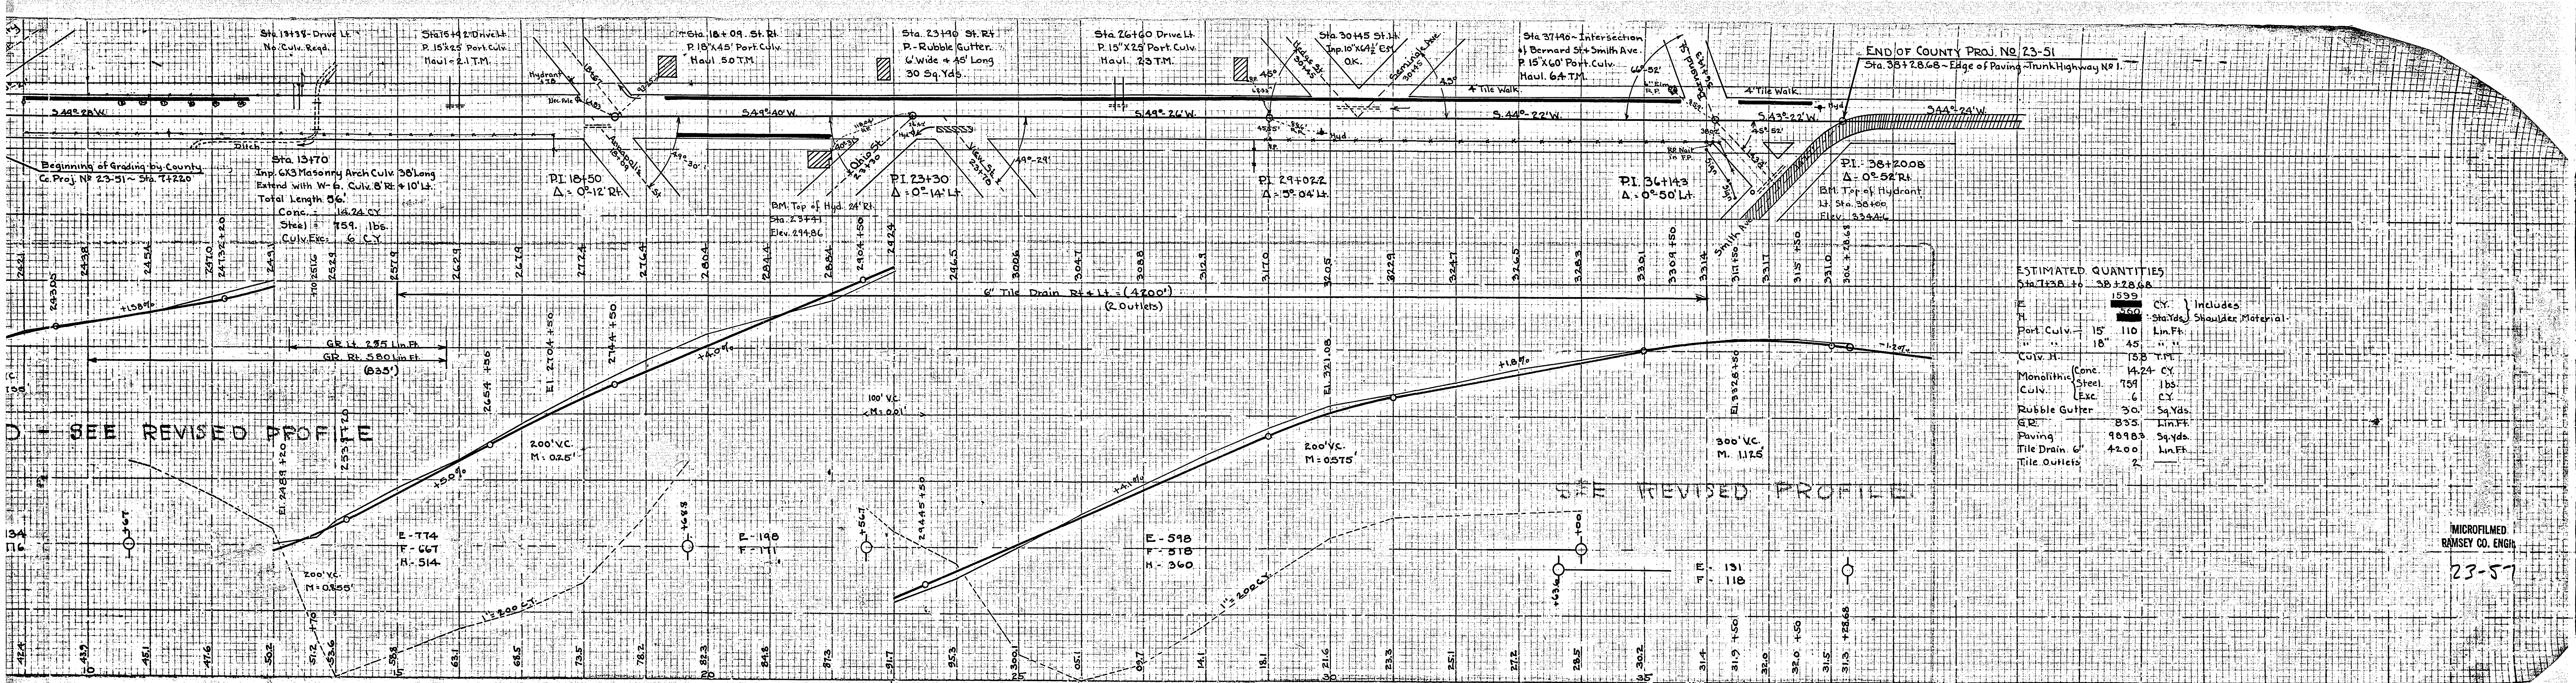


MICROFILMED
RAMSEY CO. ENGR.
23-57


REVISED PROFILE COUNTY PROJECT 23-51

MICROFILMED
RAMSEY CO. ENGR.


STANDARD CROSS SECTION 10' X 10'
REINFORCED CONCRETE

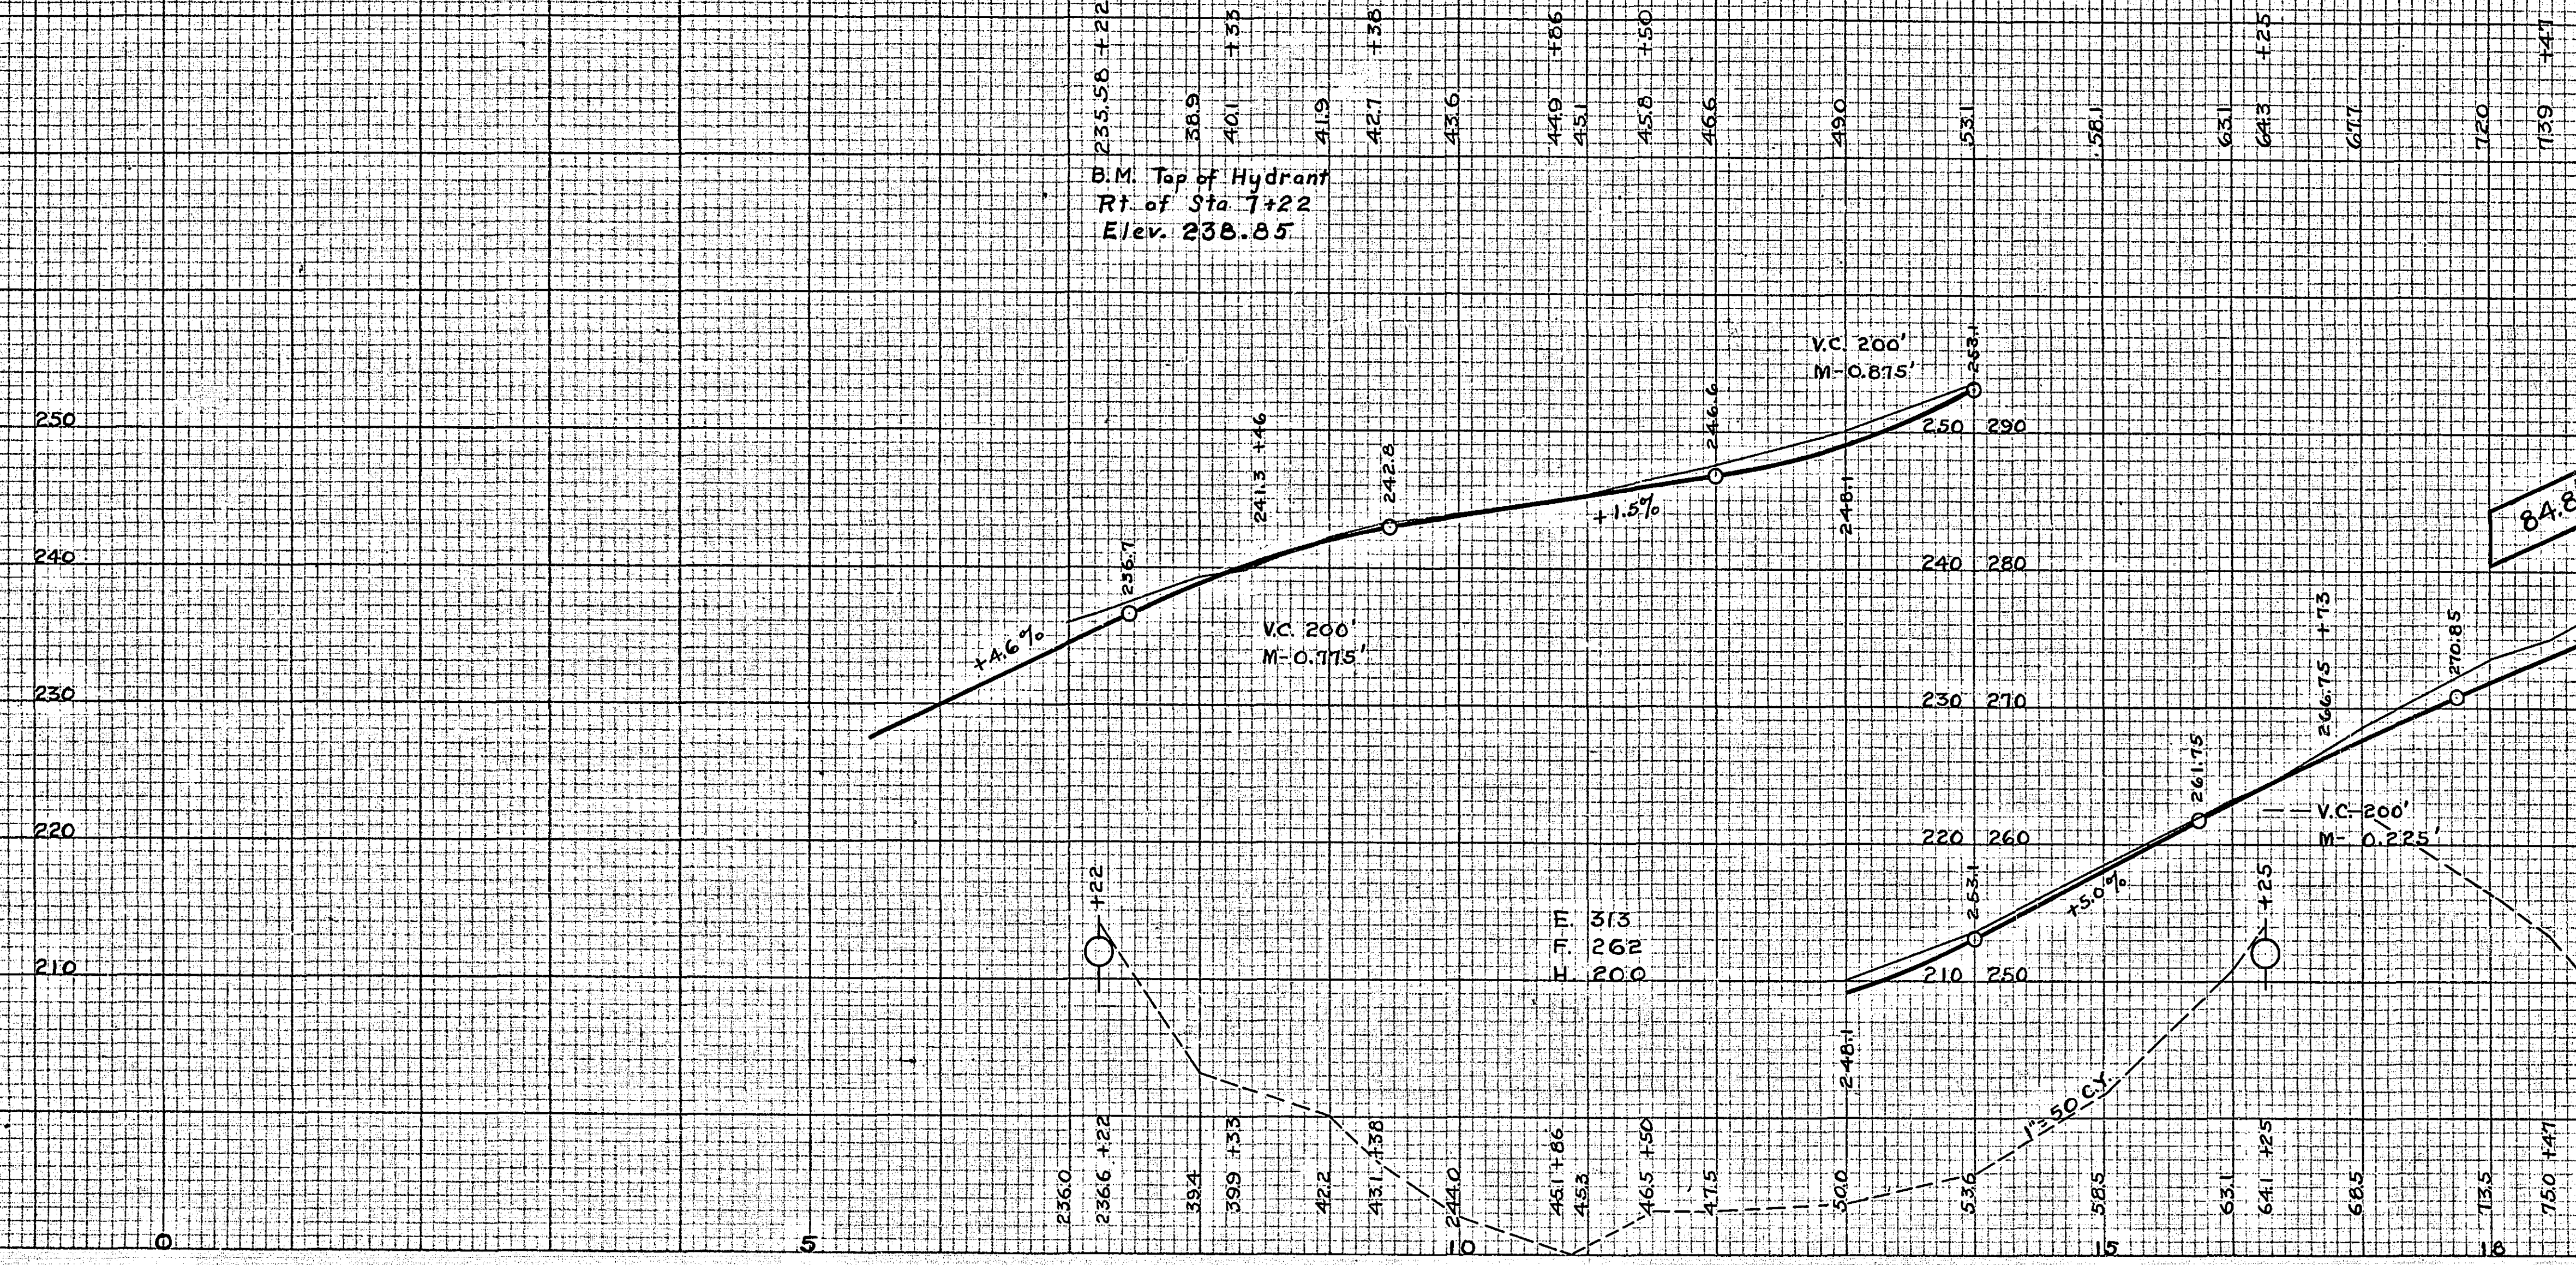


EQUATION - 18+84.8 = 18+50.0

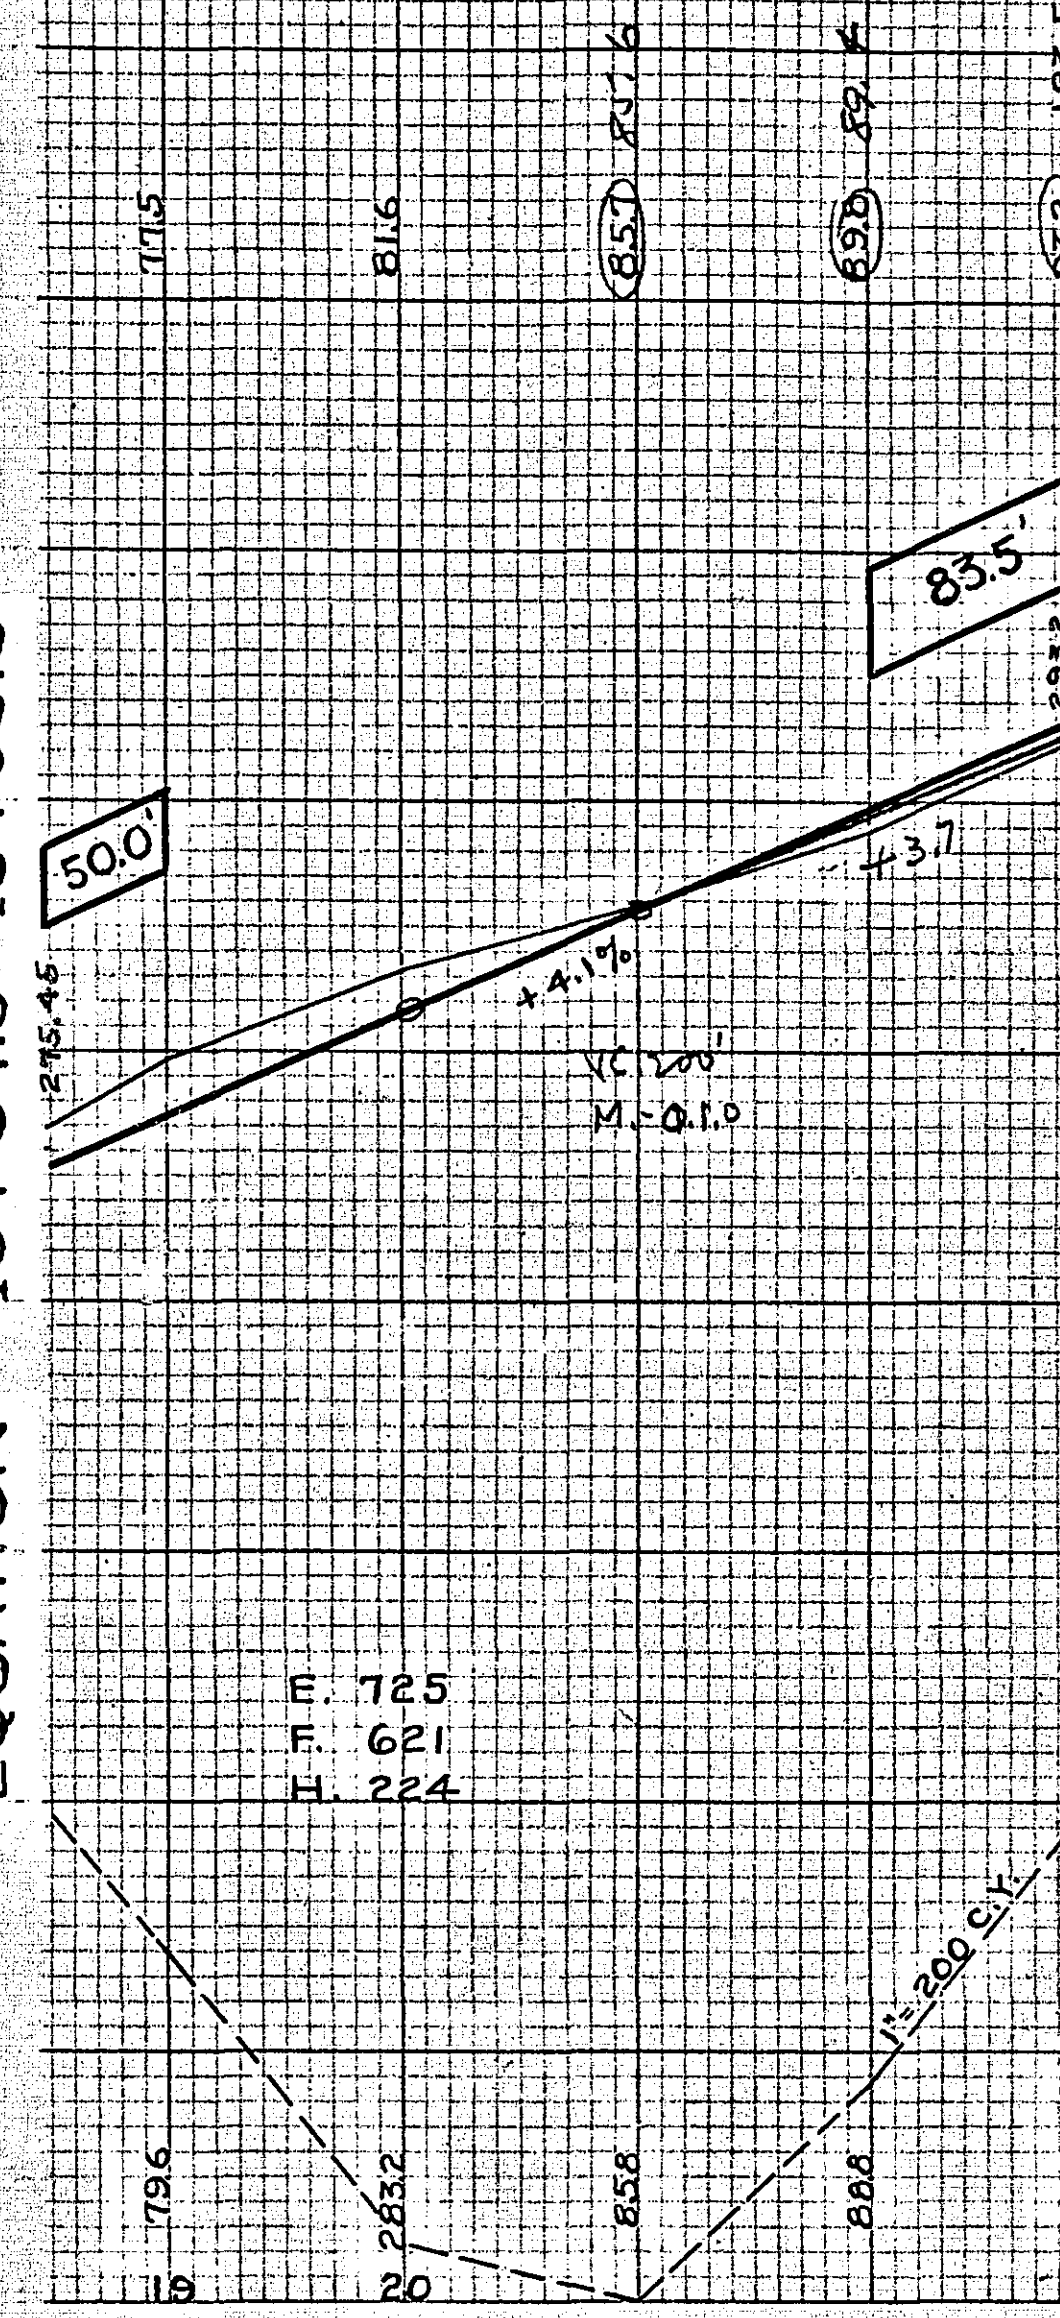


EQUATION - 22+83.5 = 23+30.0

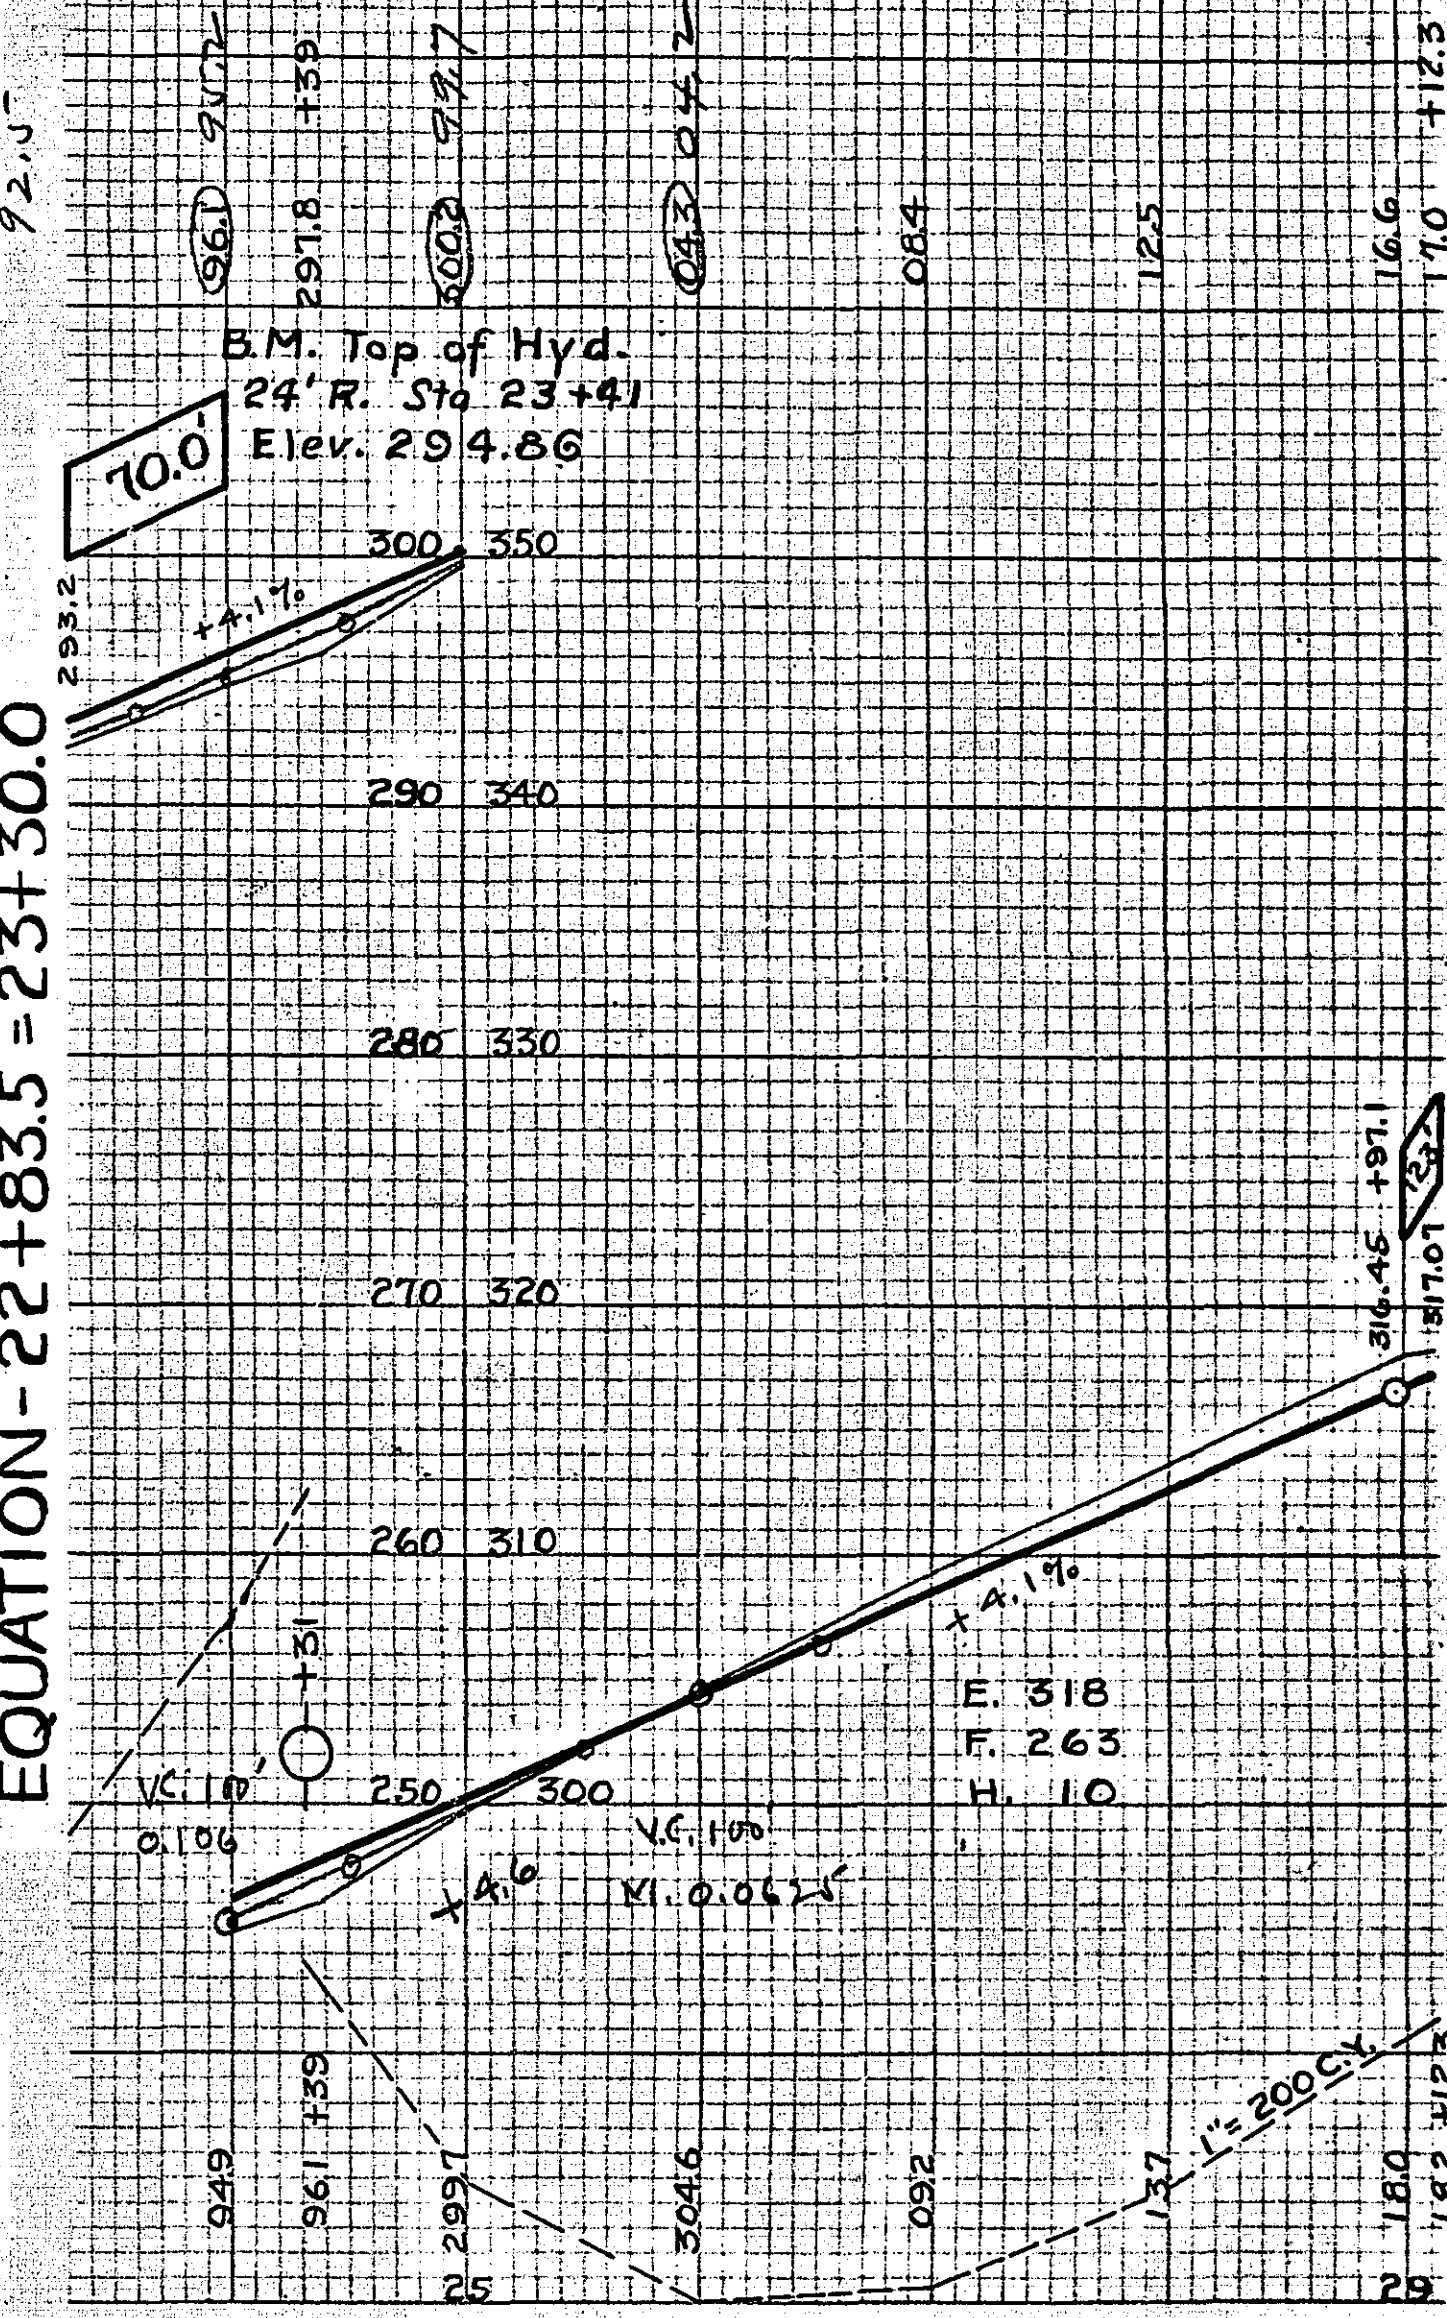


EQUATION - 29+12.3 = 29+02.2

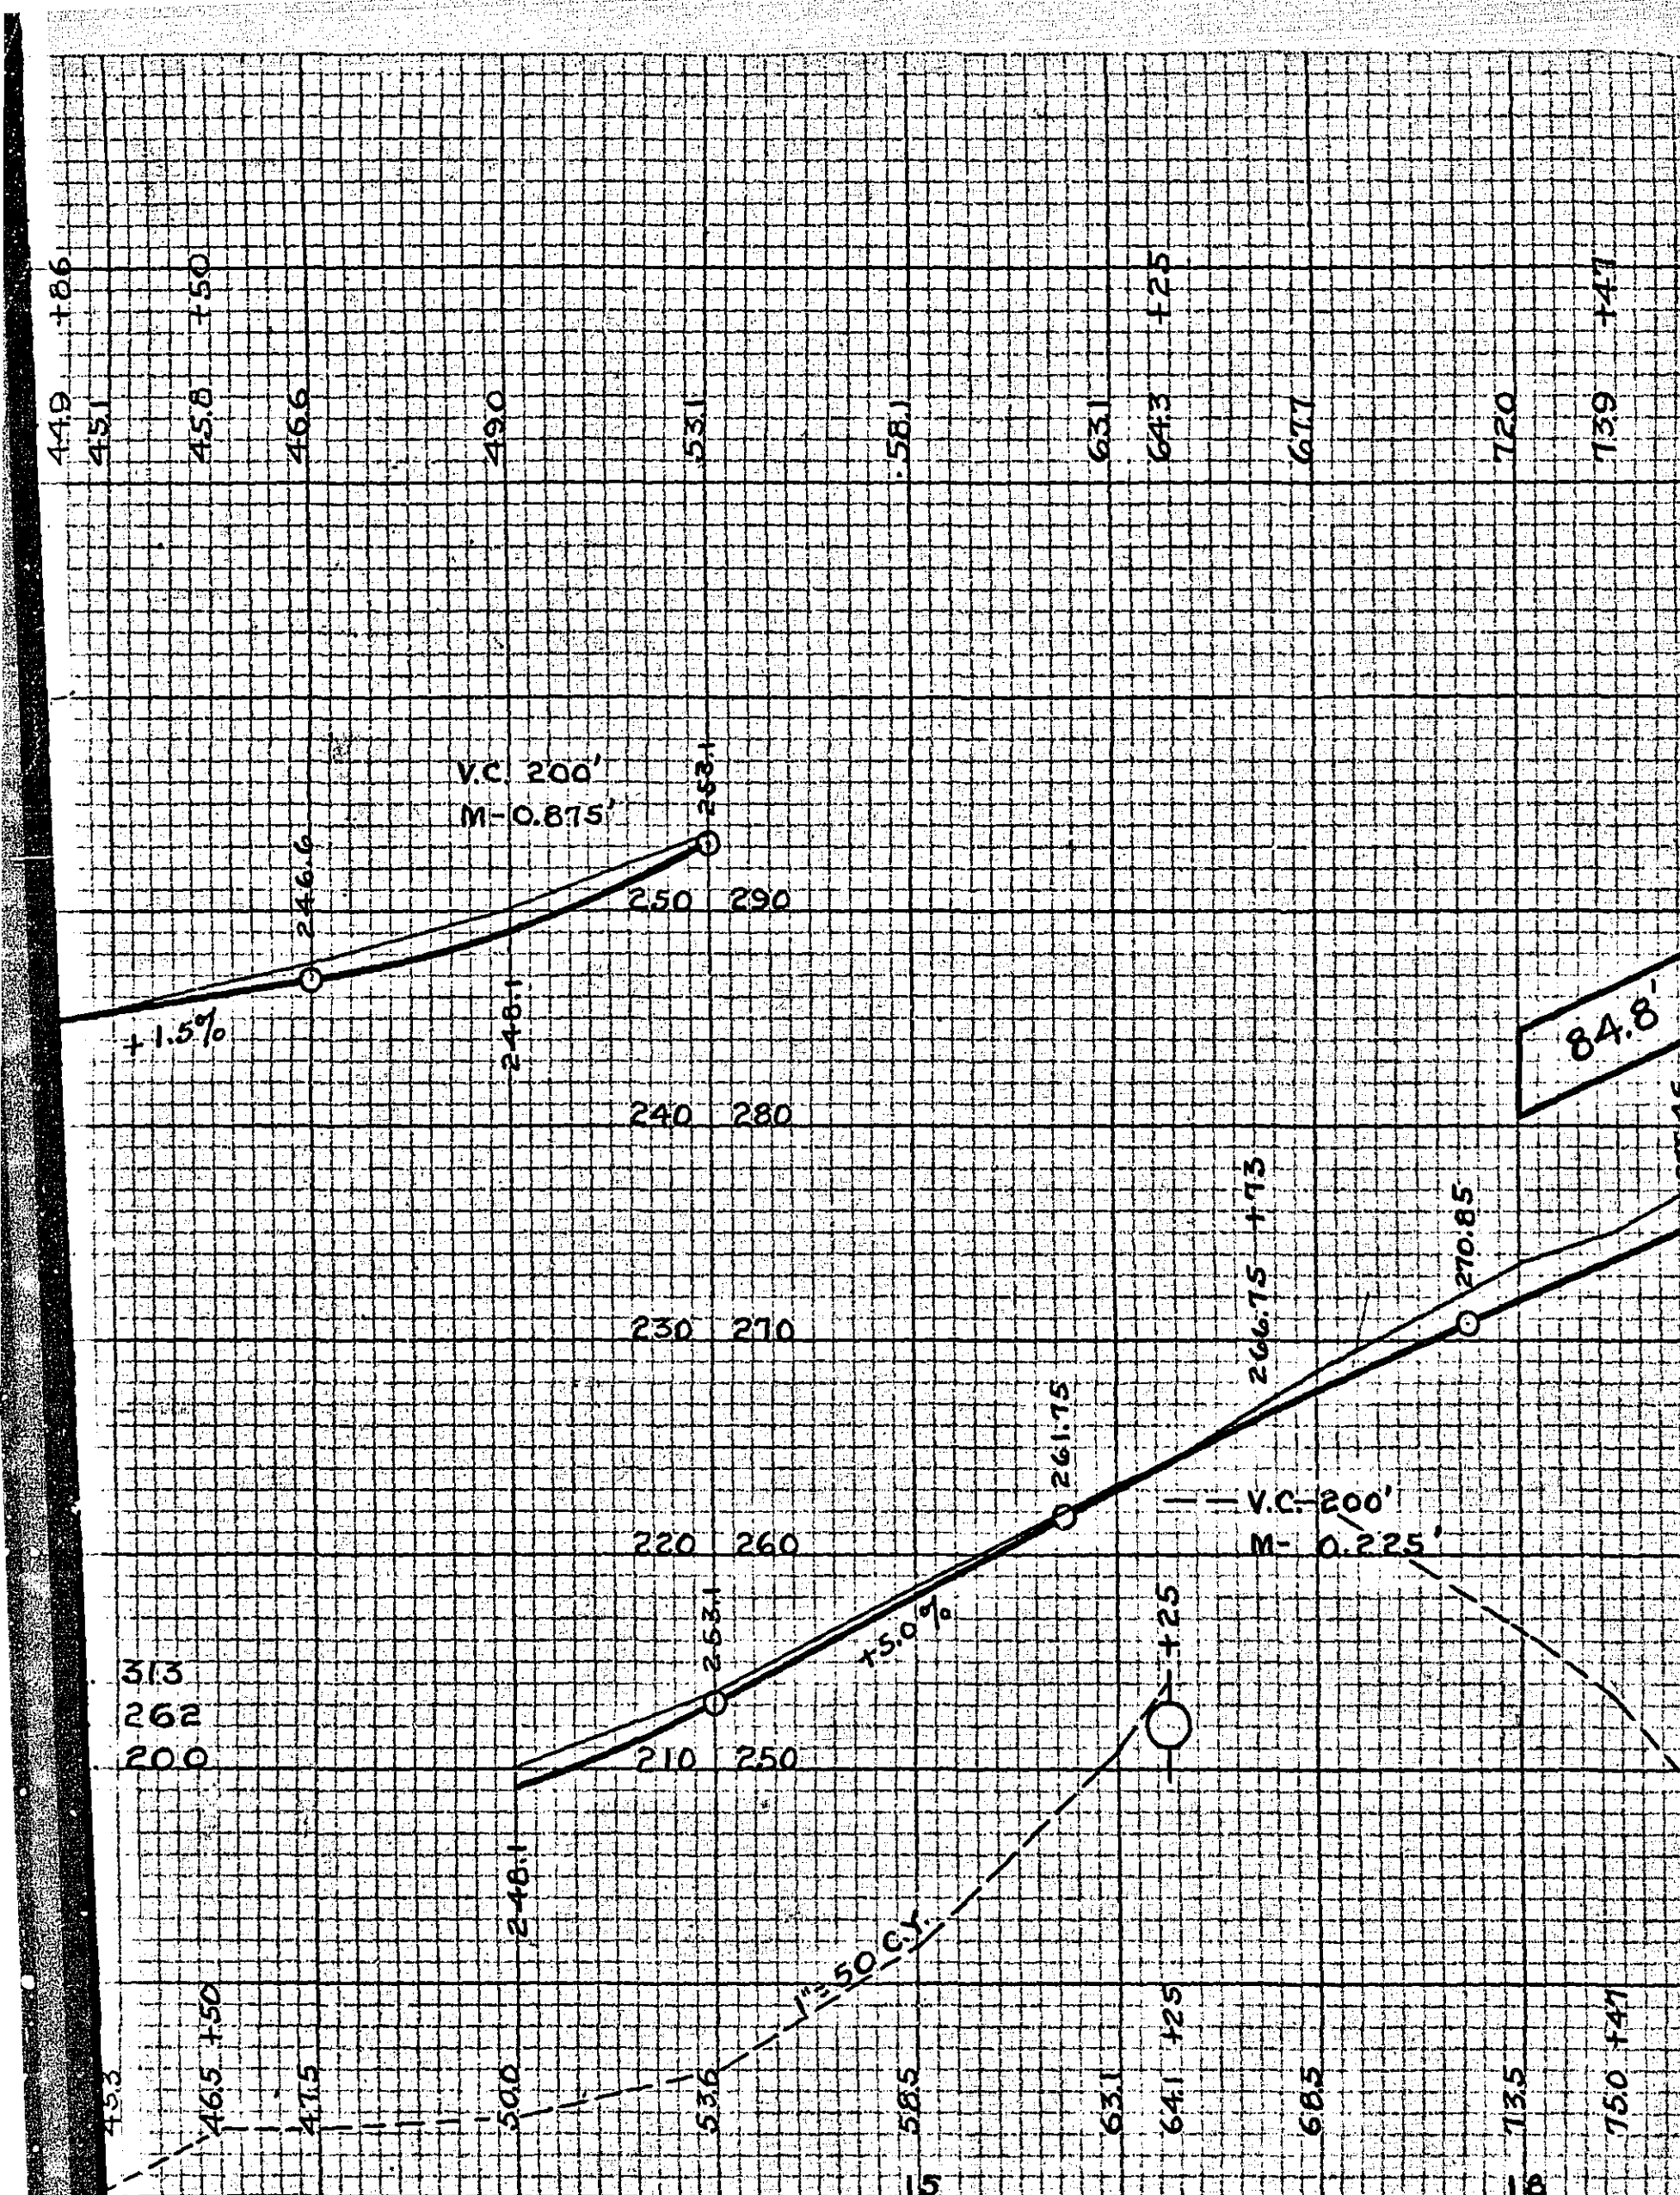


EQUATION - 18 + 84.8 = 18 + 50.0

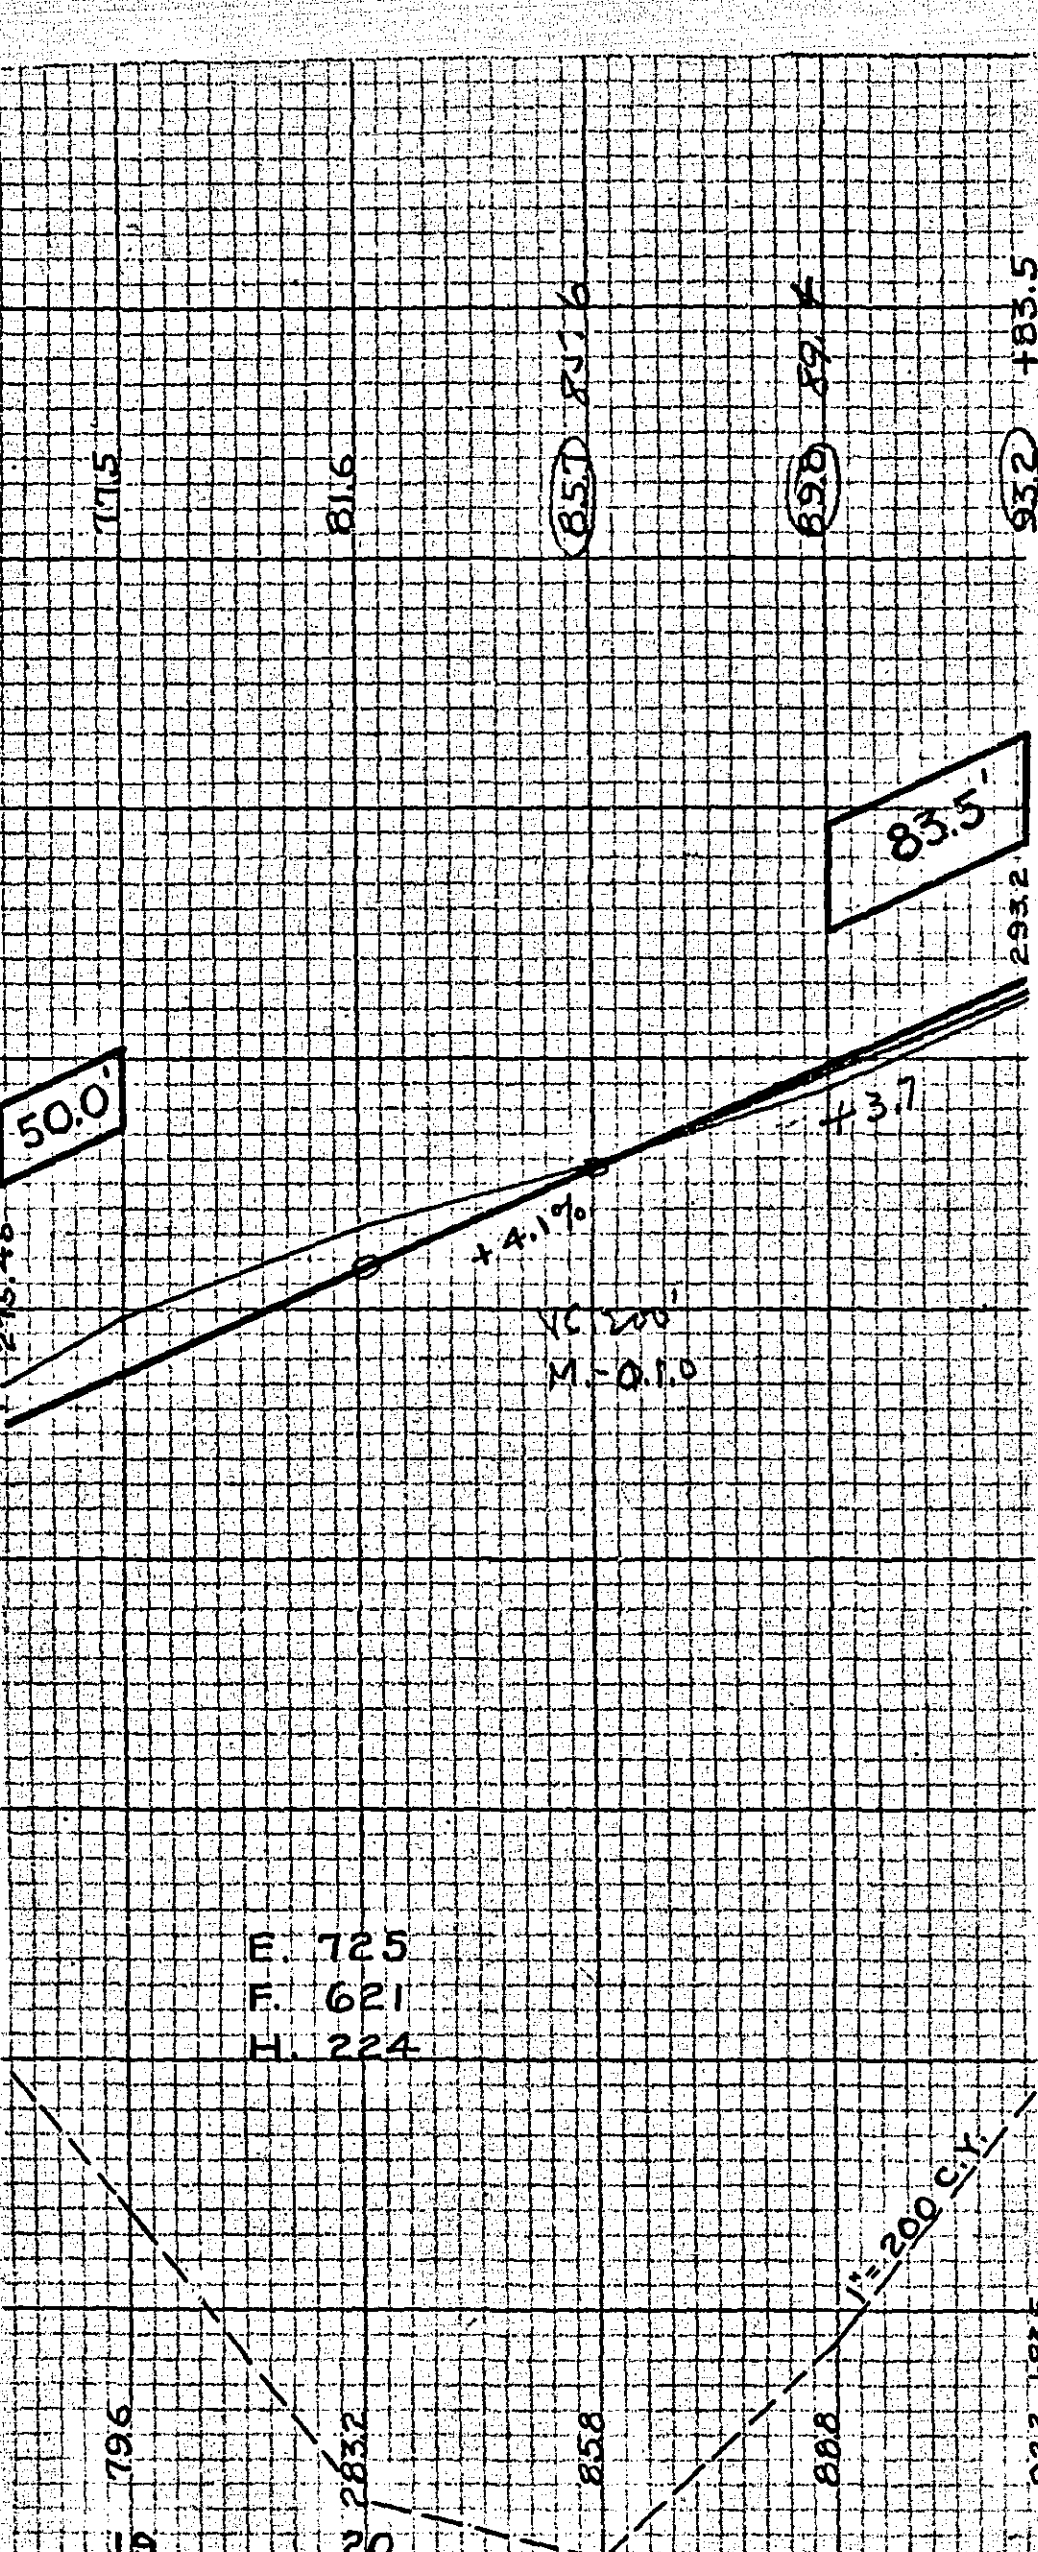

EQUATION - 22 + 83.5 = 23 + 30.0

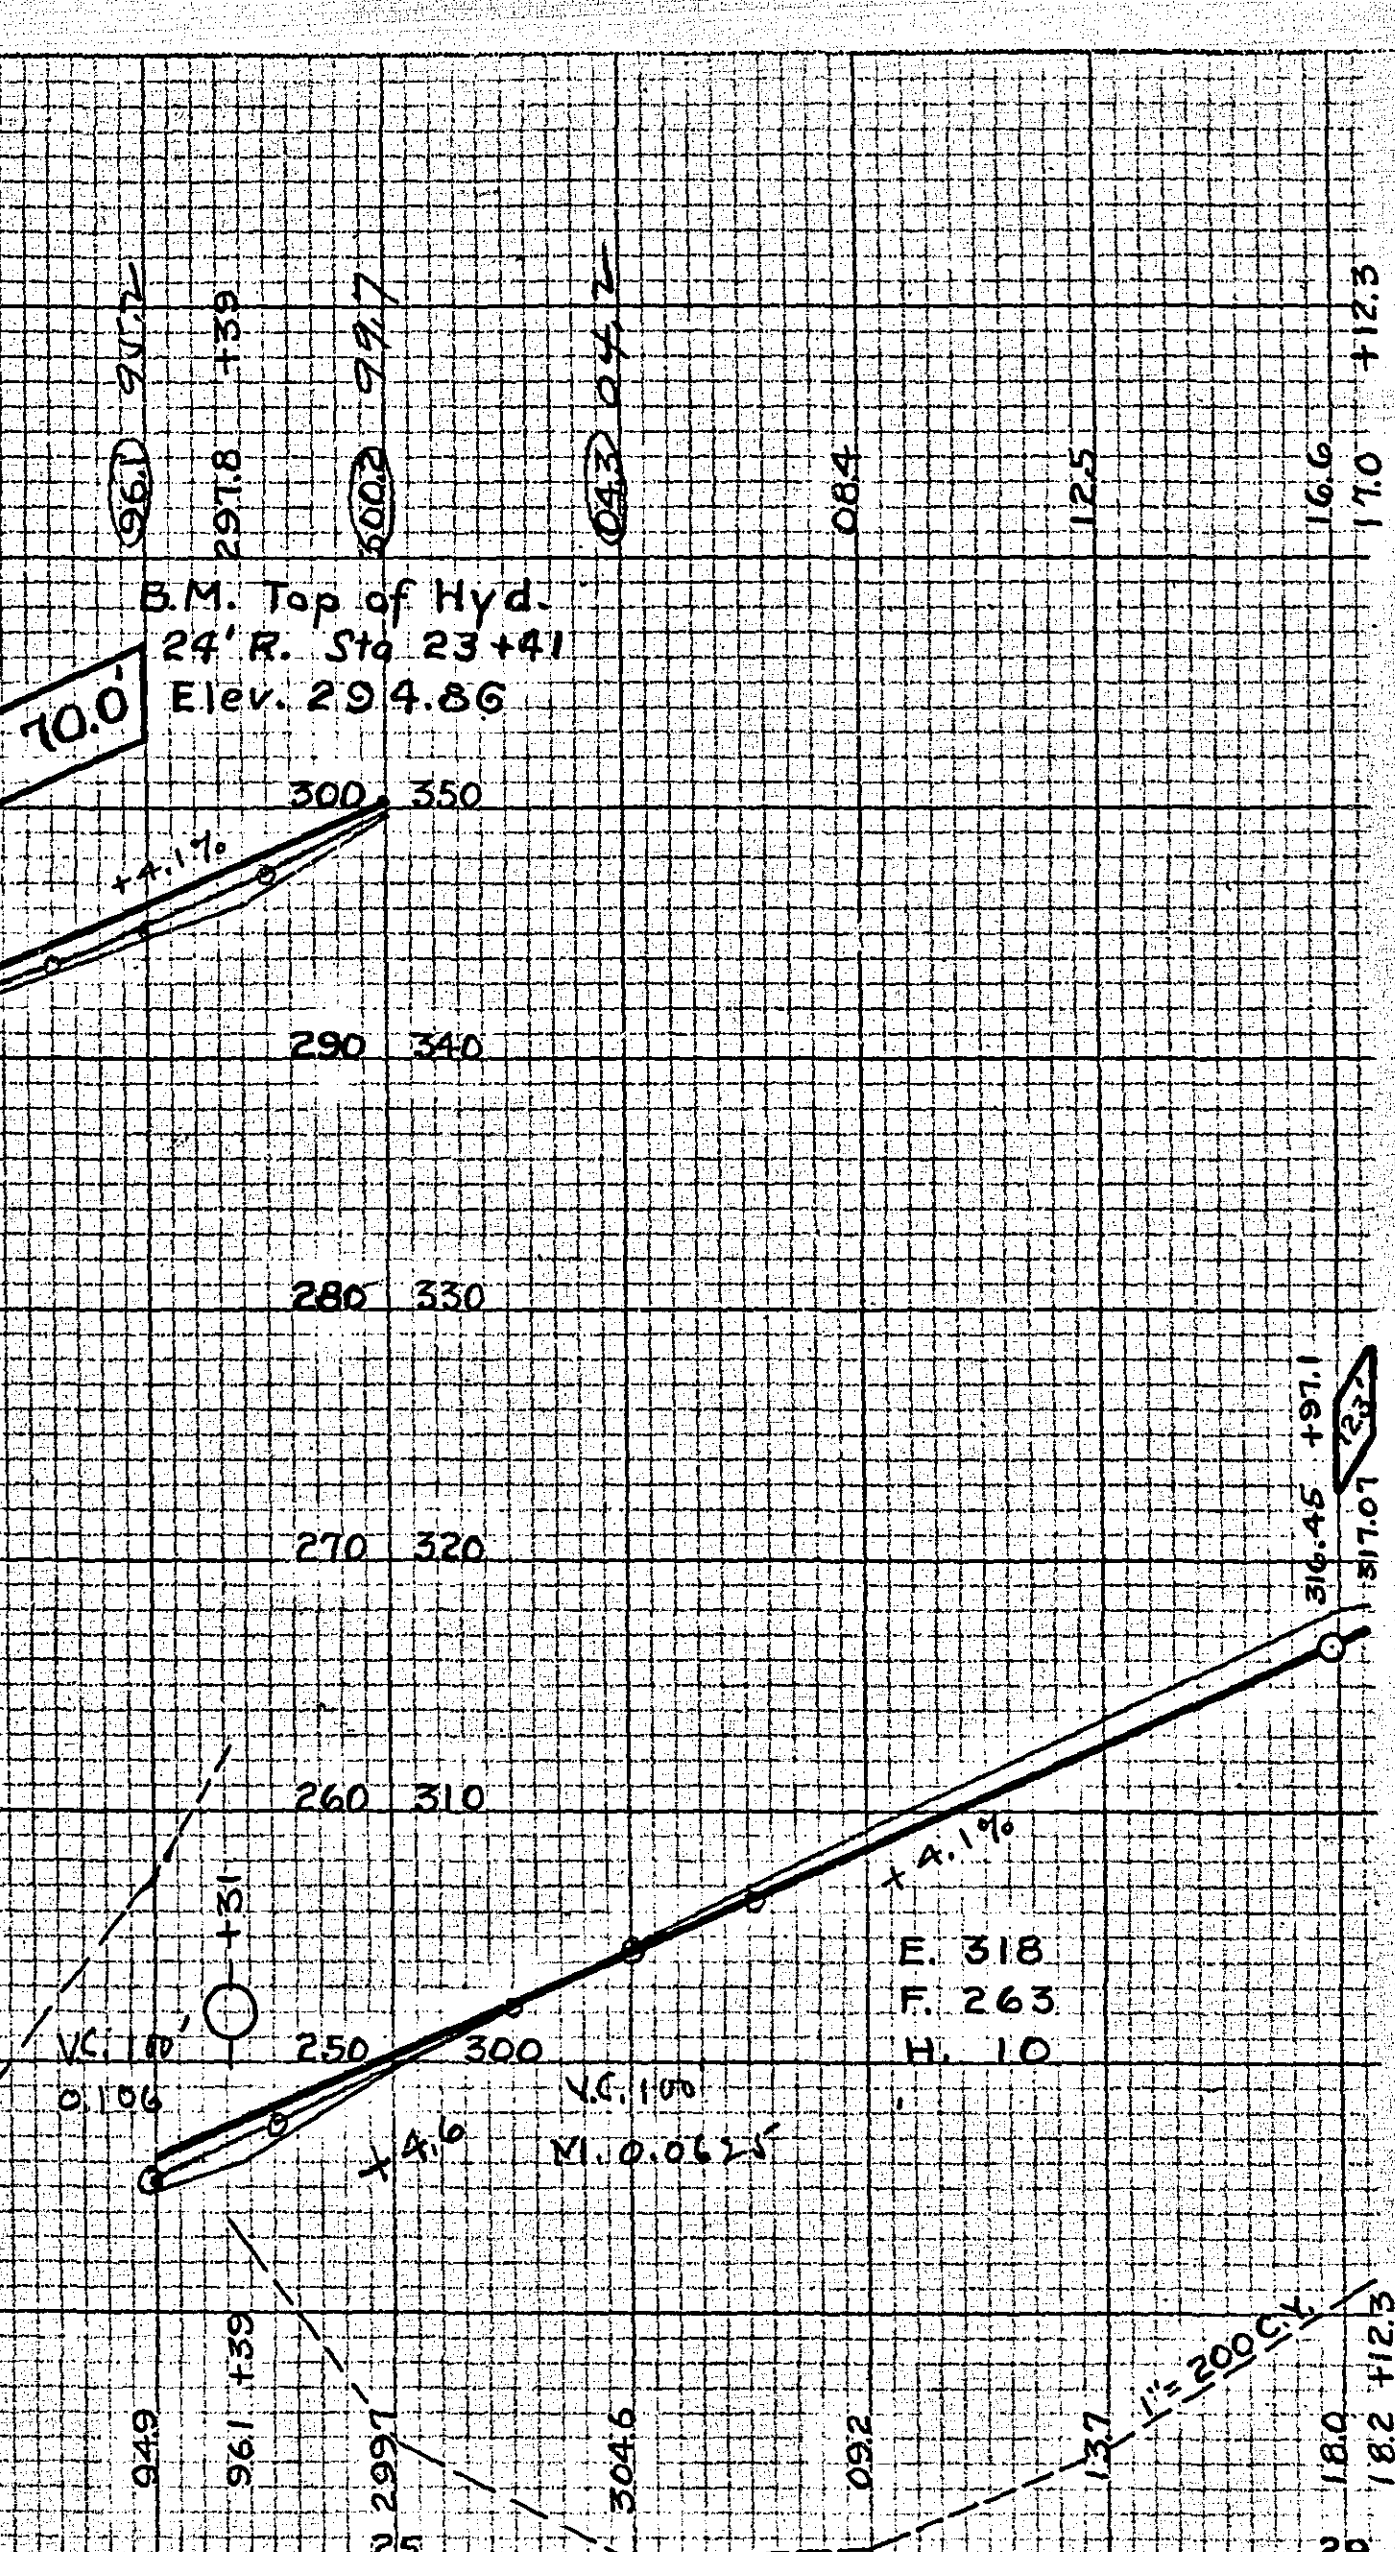

EQUATION - 29 + 12.3 = 29 + 12.2

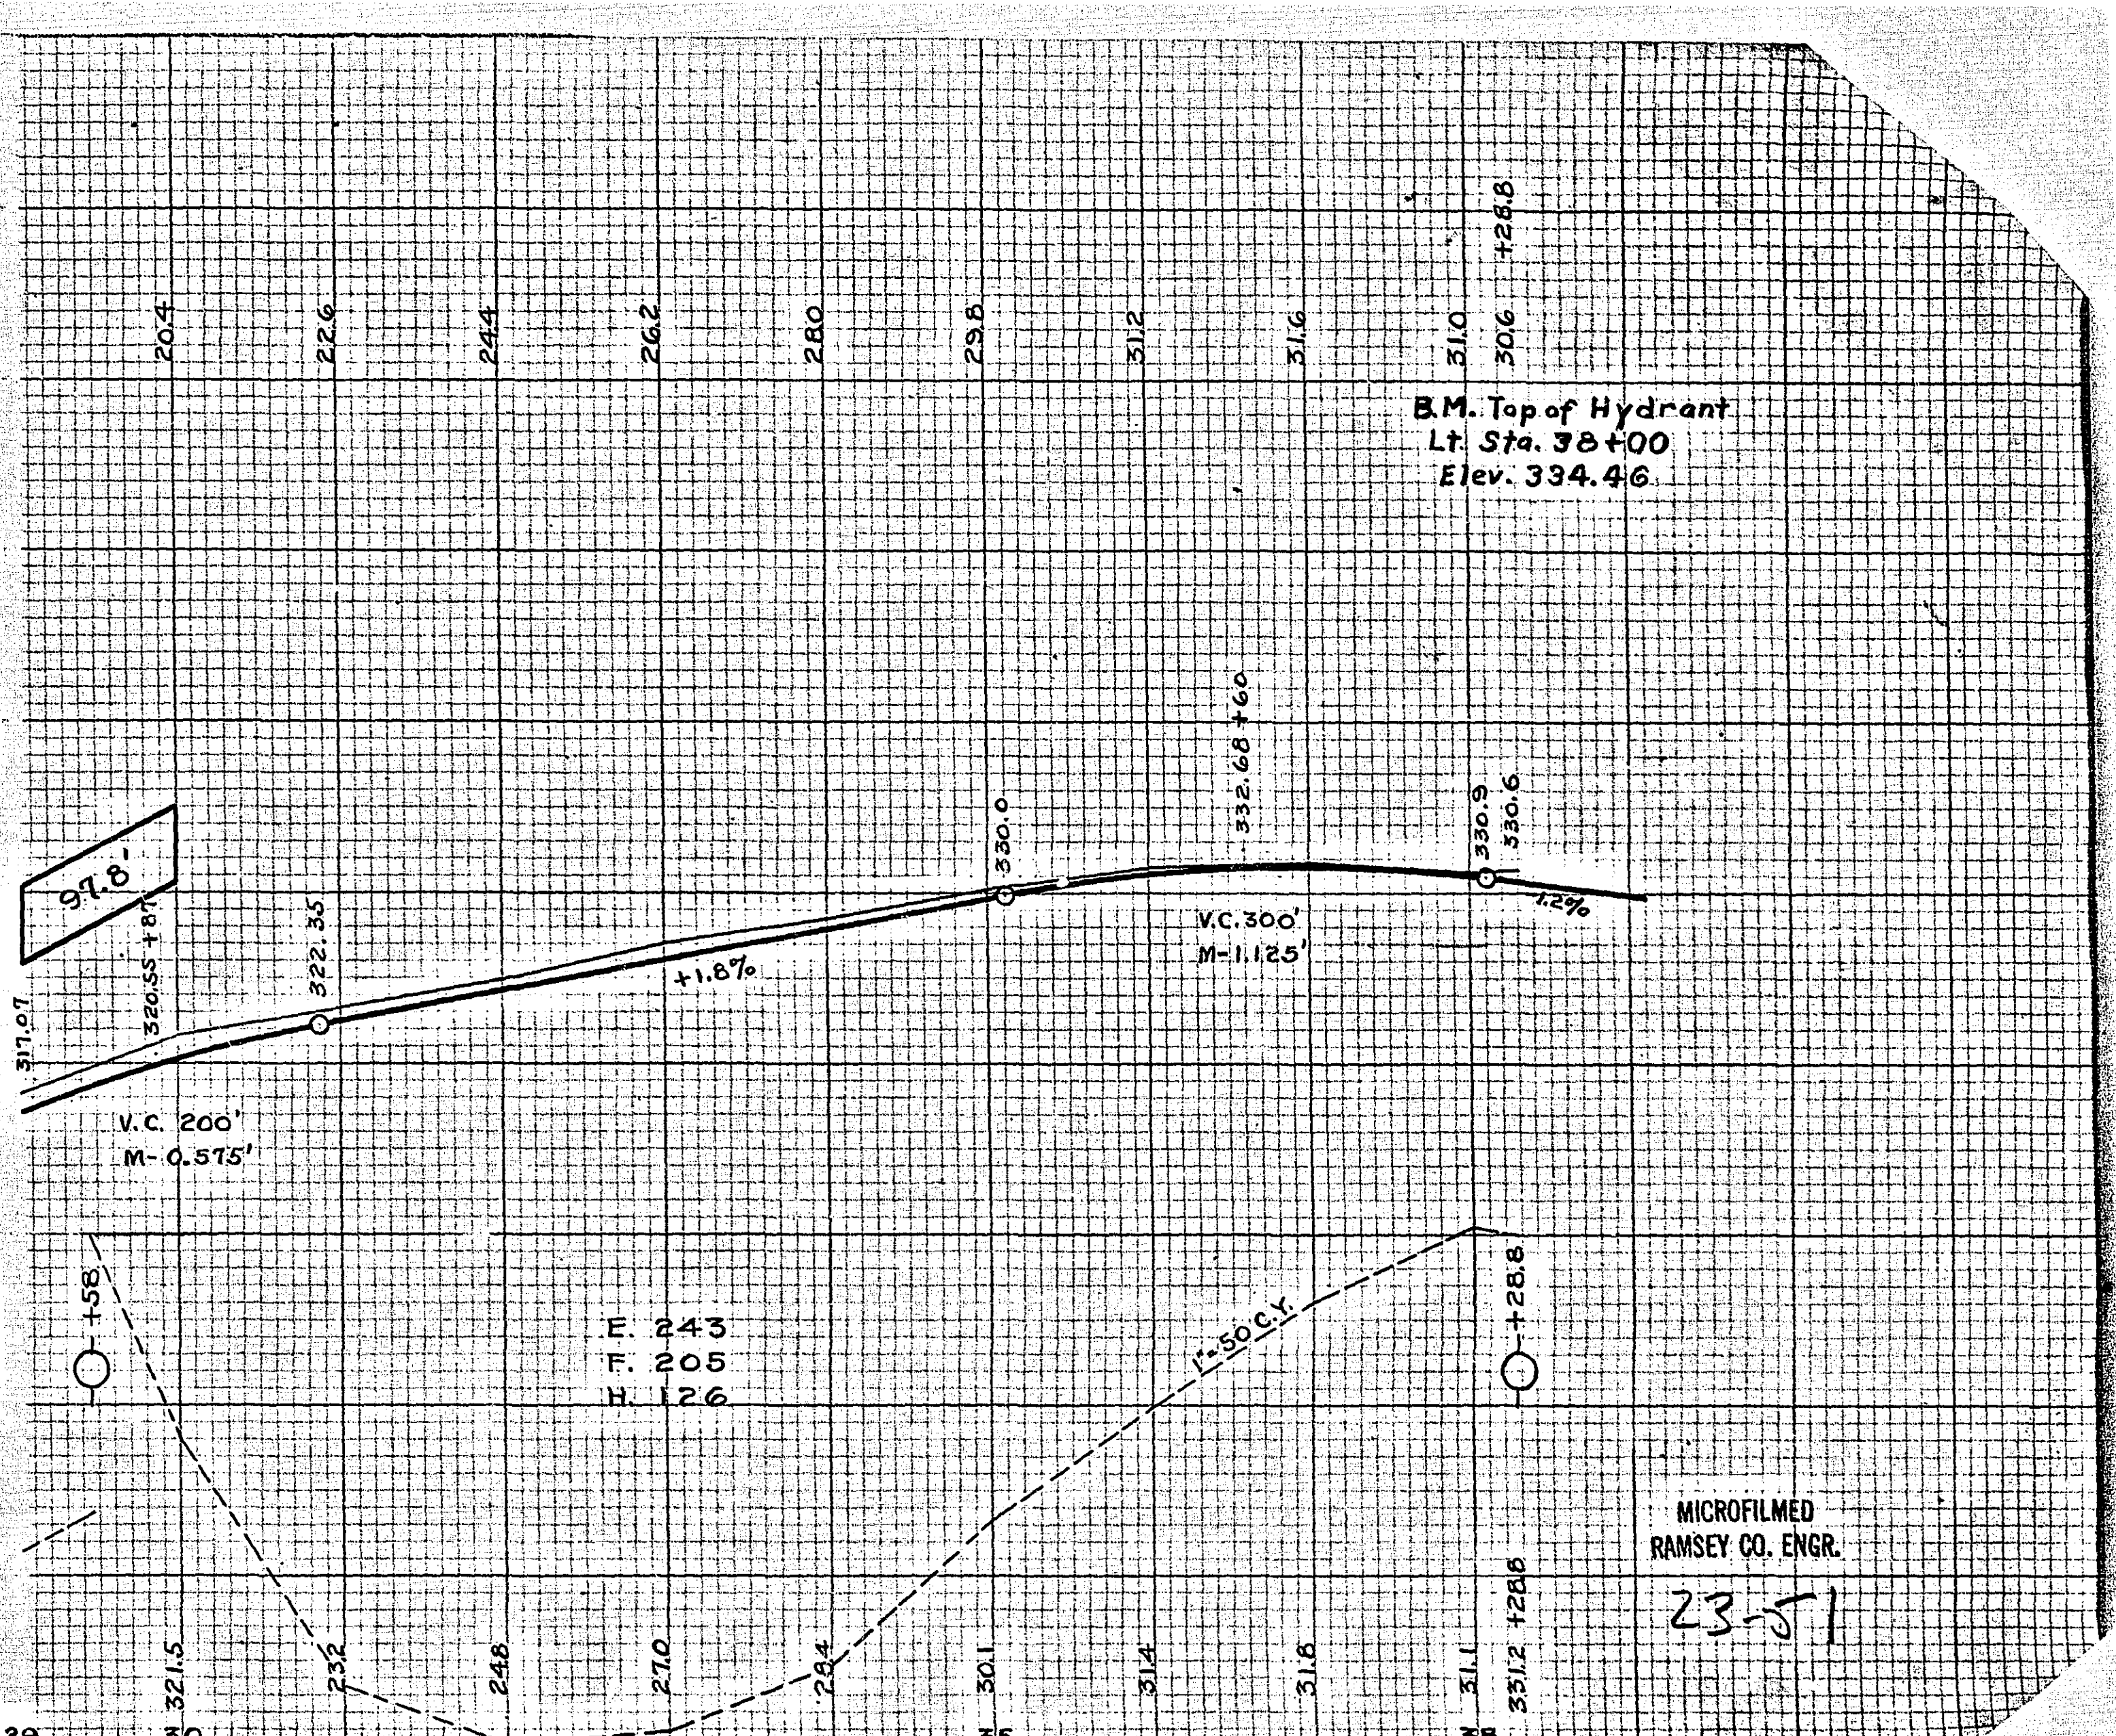

MICROFILMED
RAMSEY CO. ENGR.

23-51