



PROJ. 24-51


6-16-24


MICROFILMED
RAMSEY CO. ENGR

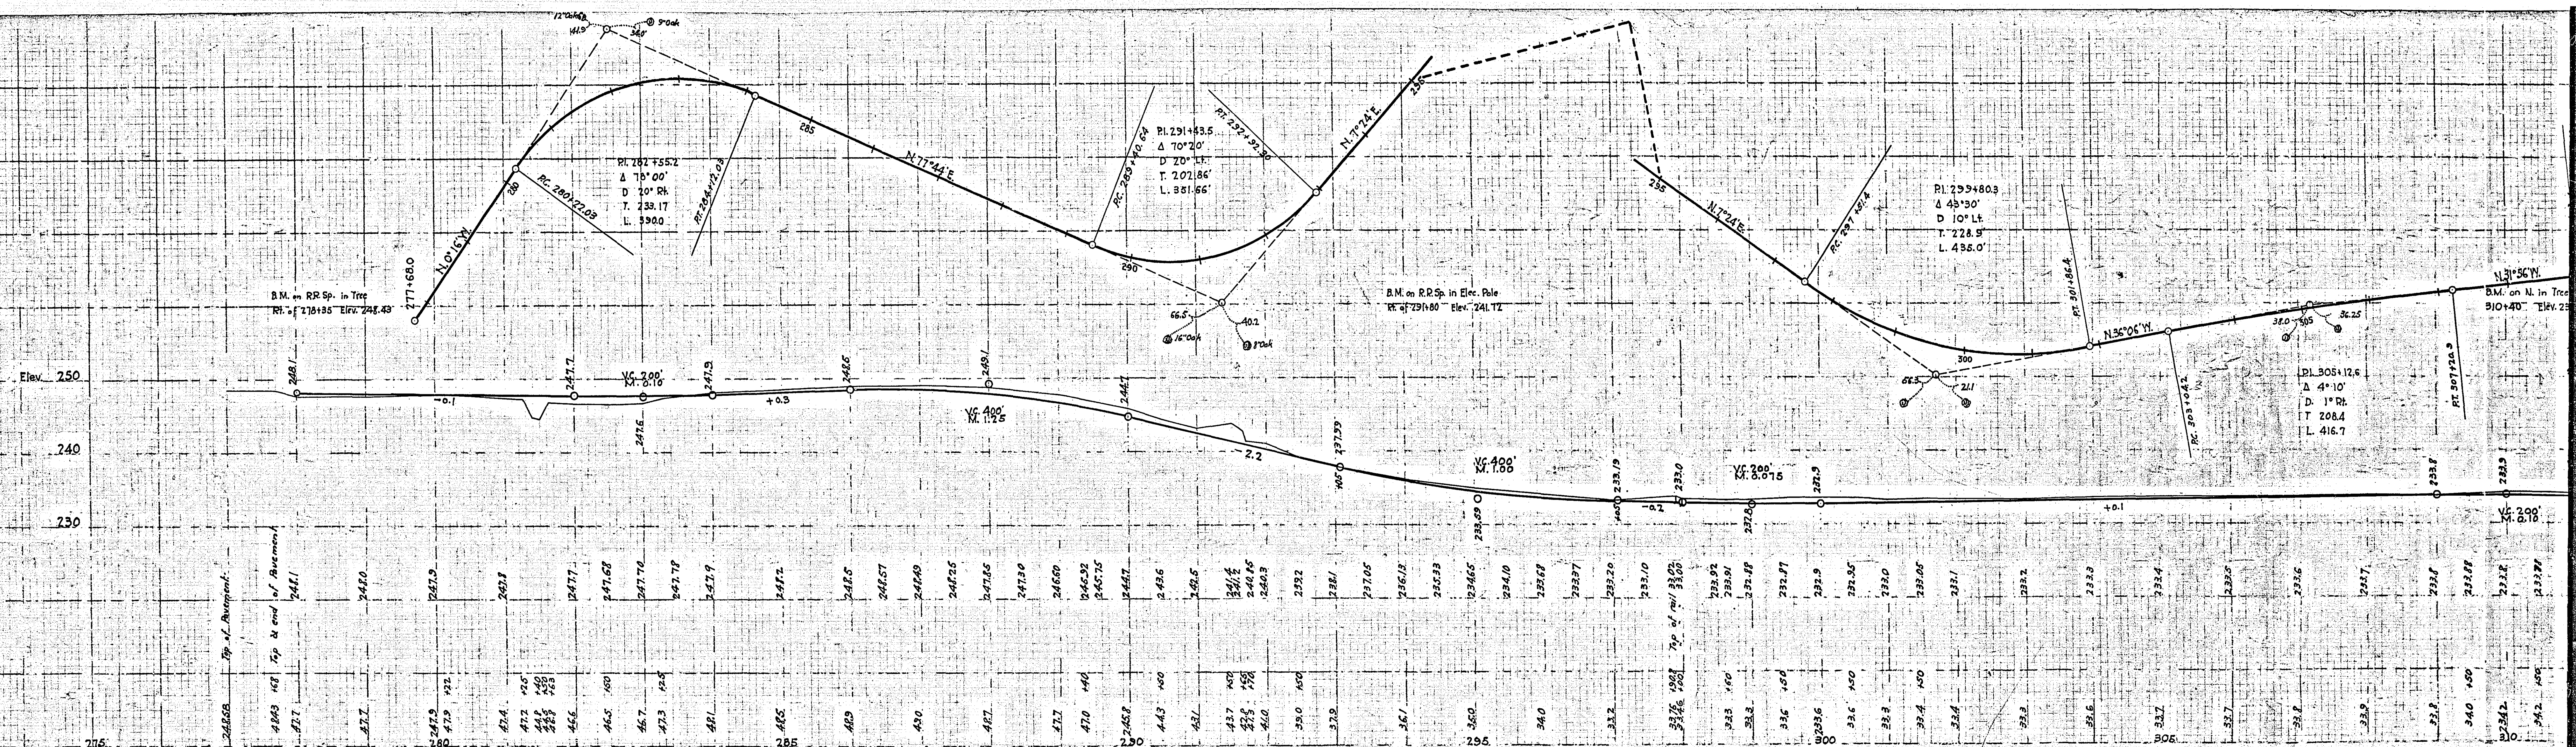


**RAMSEY COUNTY ENGINEER'S OFFICE
CONSTRUCTION PROFILE
COUNTY PROJECT NO 24-51
WHITE BEAR ROAD, BALD EAGLE AVE.
AND PARK AVE.**

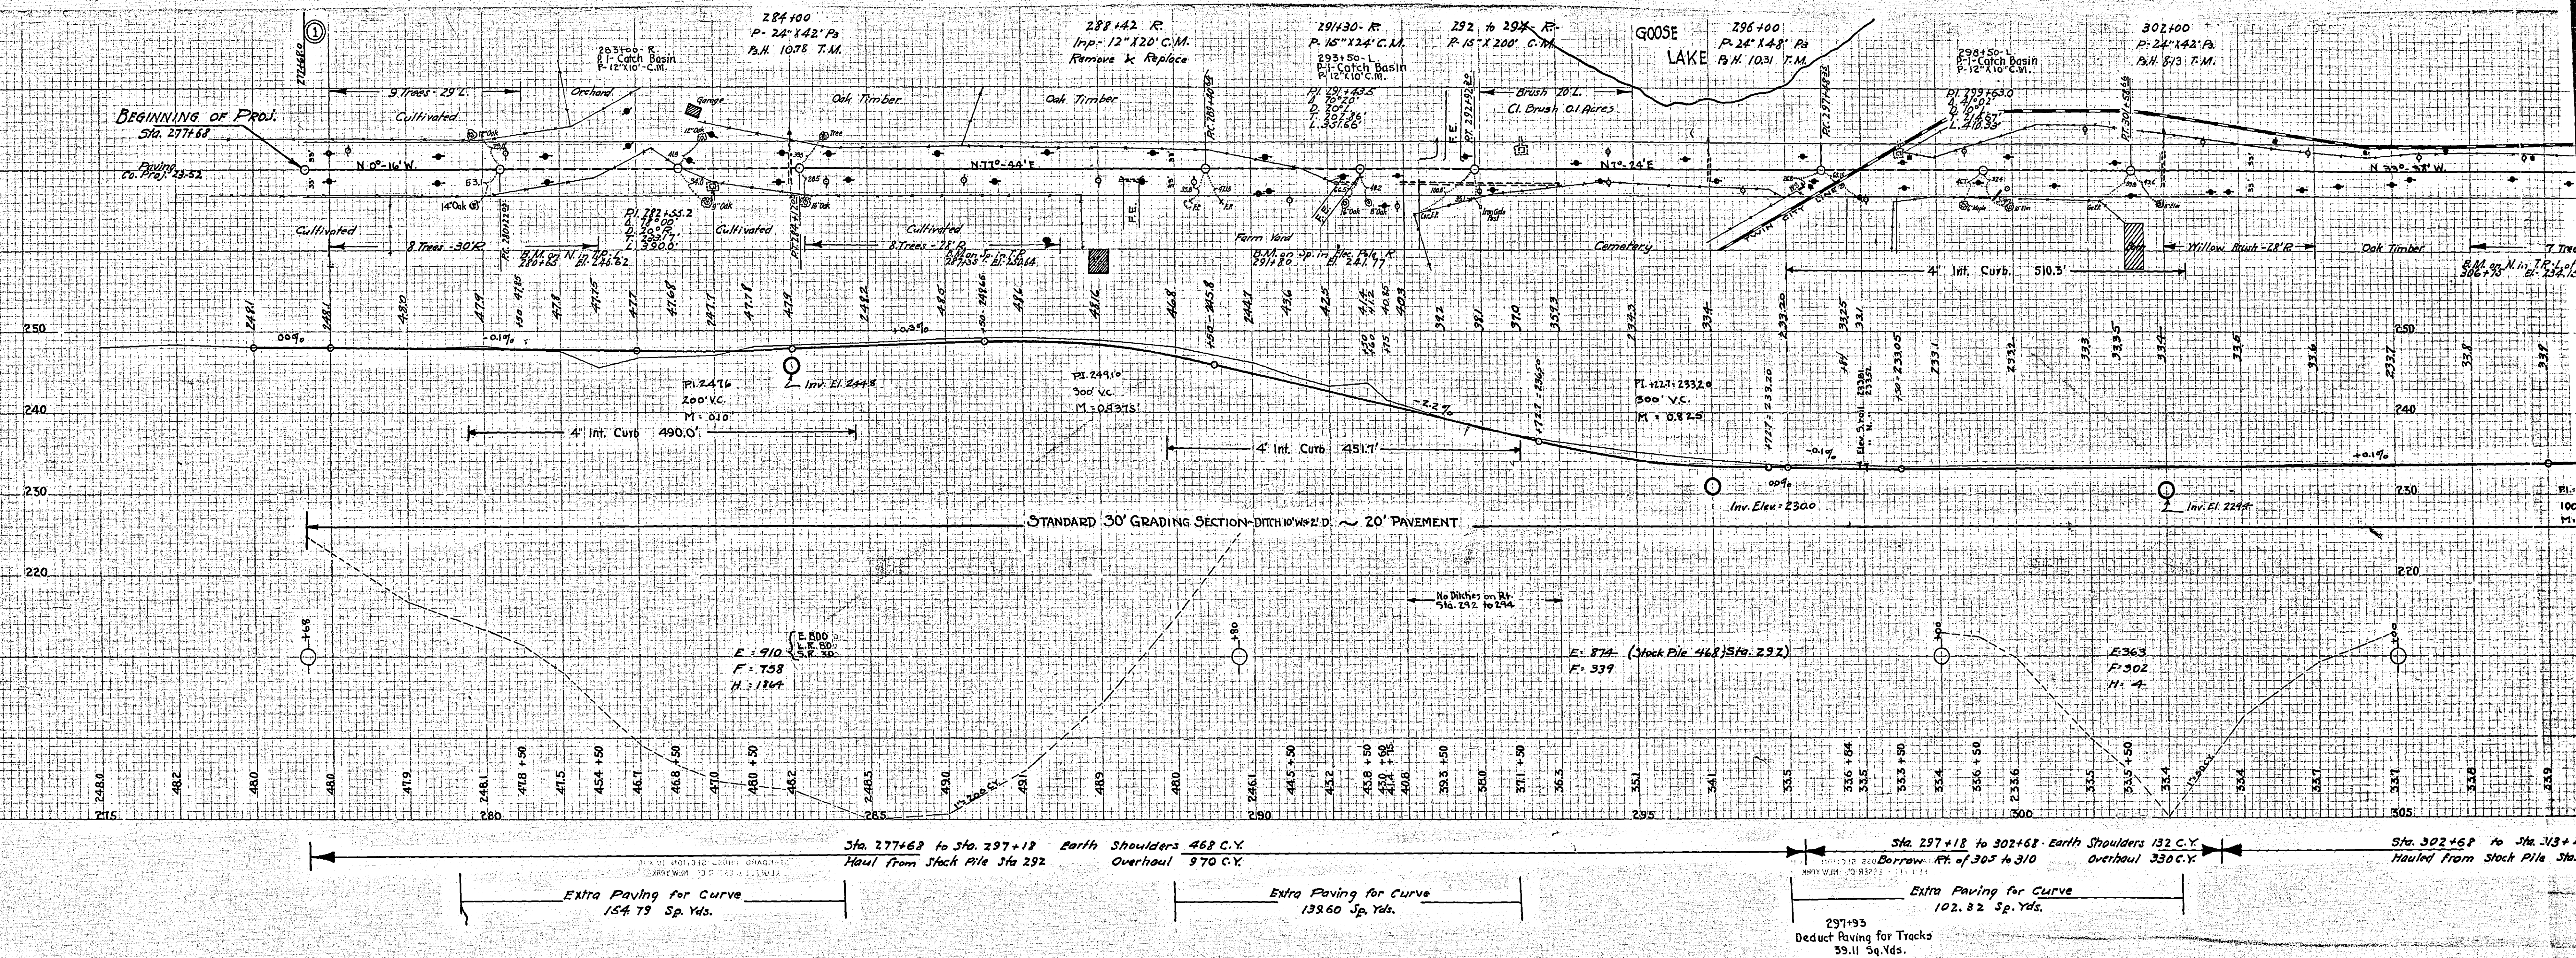

 

 

 


LINE REVISION

PROJ. 24-51

5-17-24

MICROFILMED
RAMSEY CO. ENGR.

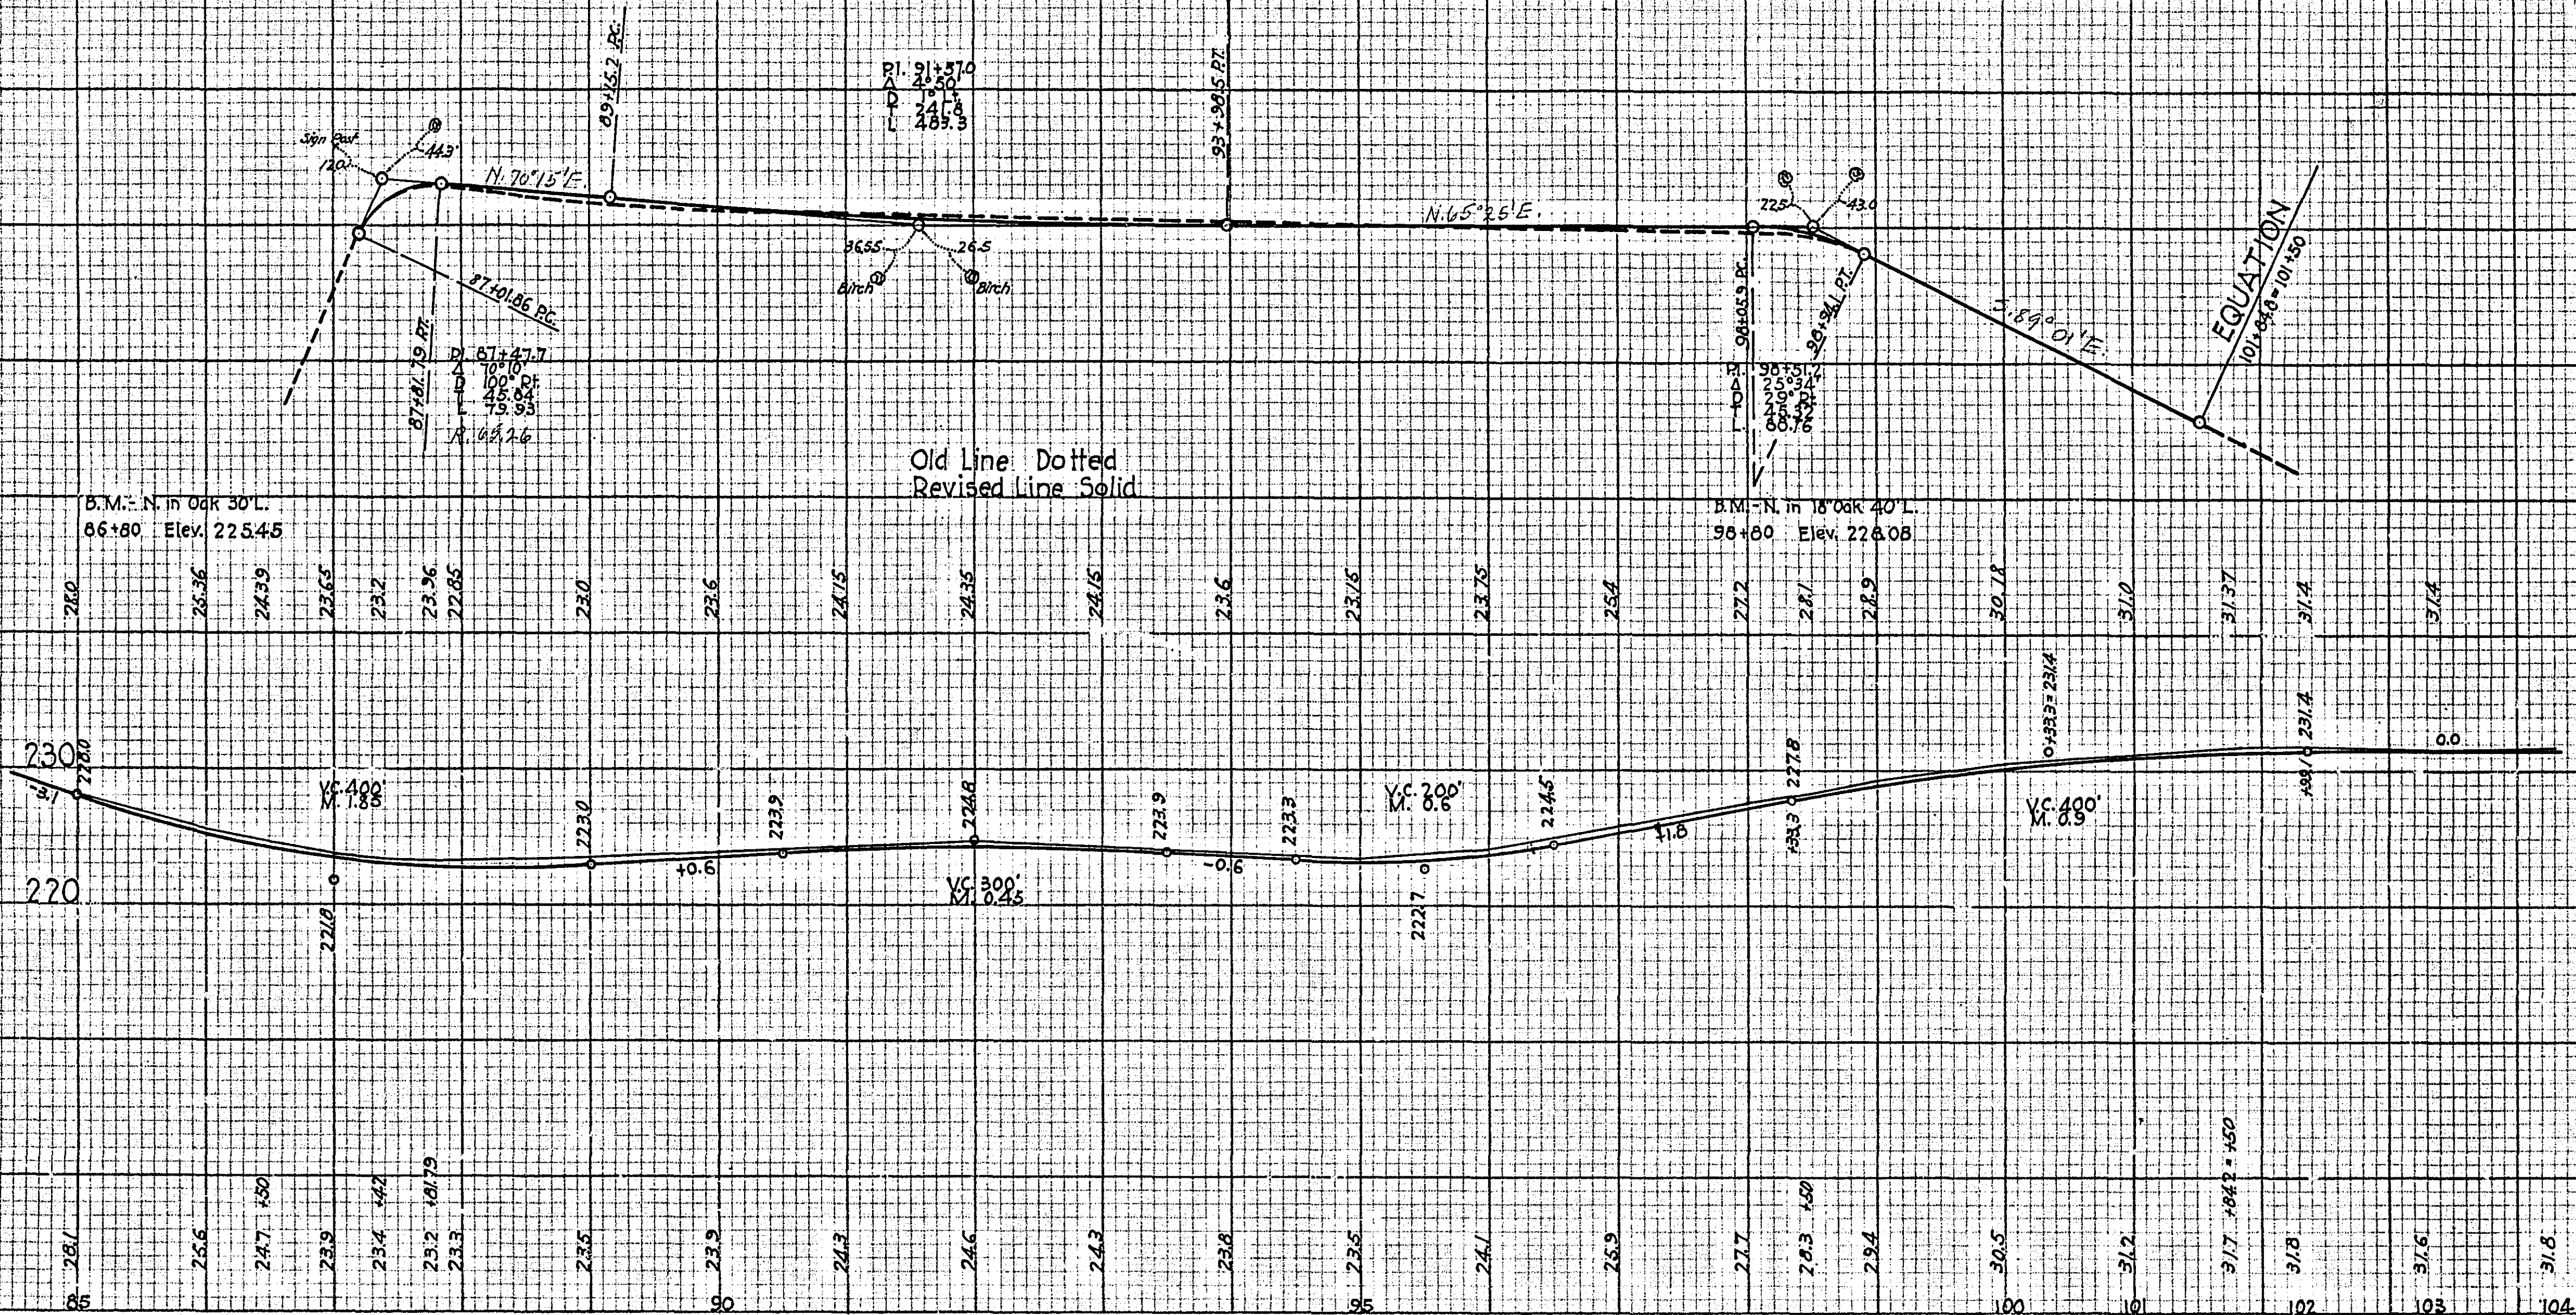

MICROFILMED
RAMSEY CO. ENGR.
24-51

