



ALTERNATE TYPES FOR SIDEWALK CONSTRUCTION

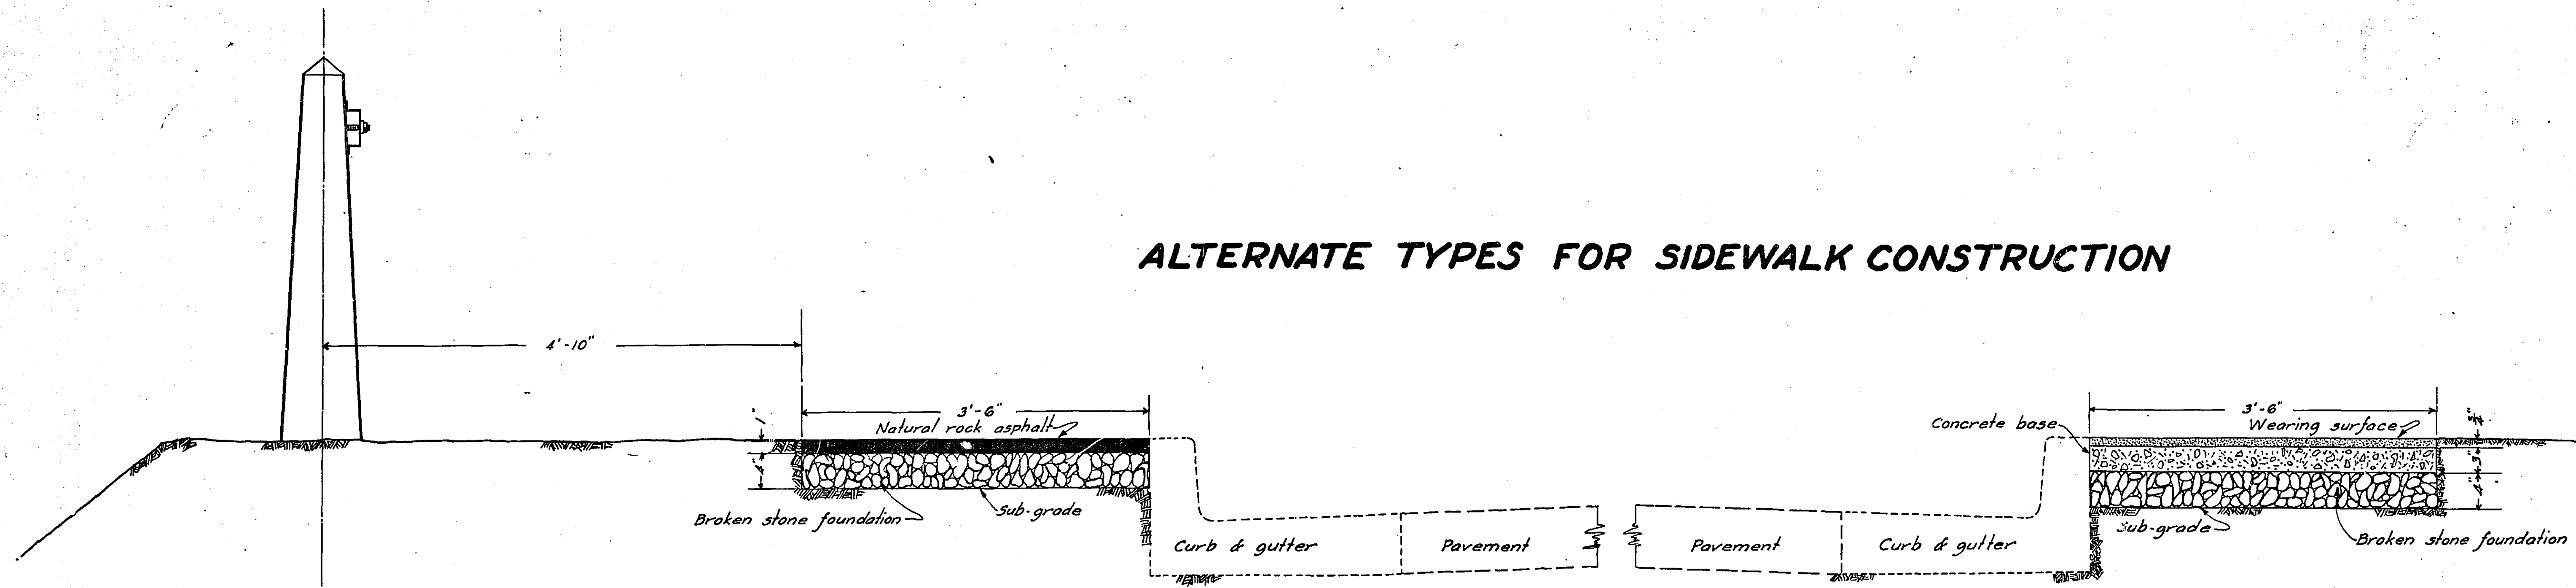


NATURAL ROCK ASPHALT SIDEWALK

TWO COURSE MONOLITHIC CONCRETE SIDEWALK

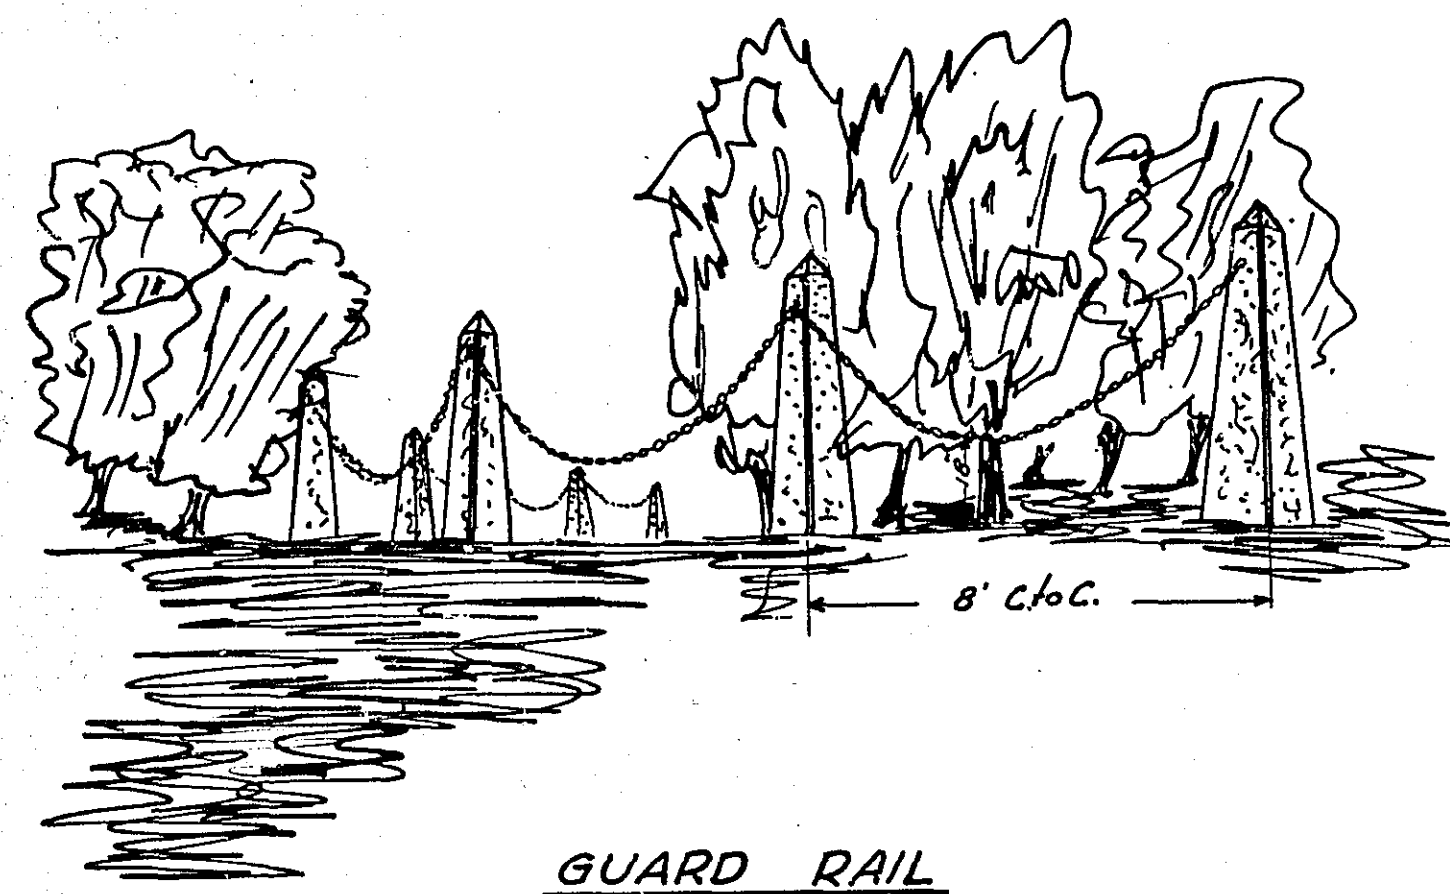

GUARD RAIL

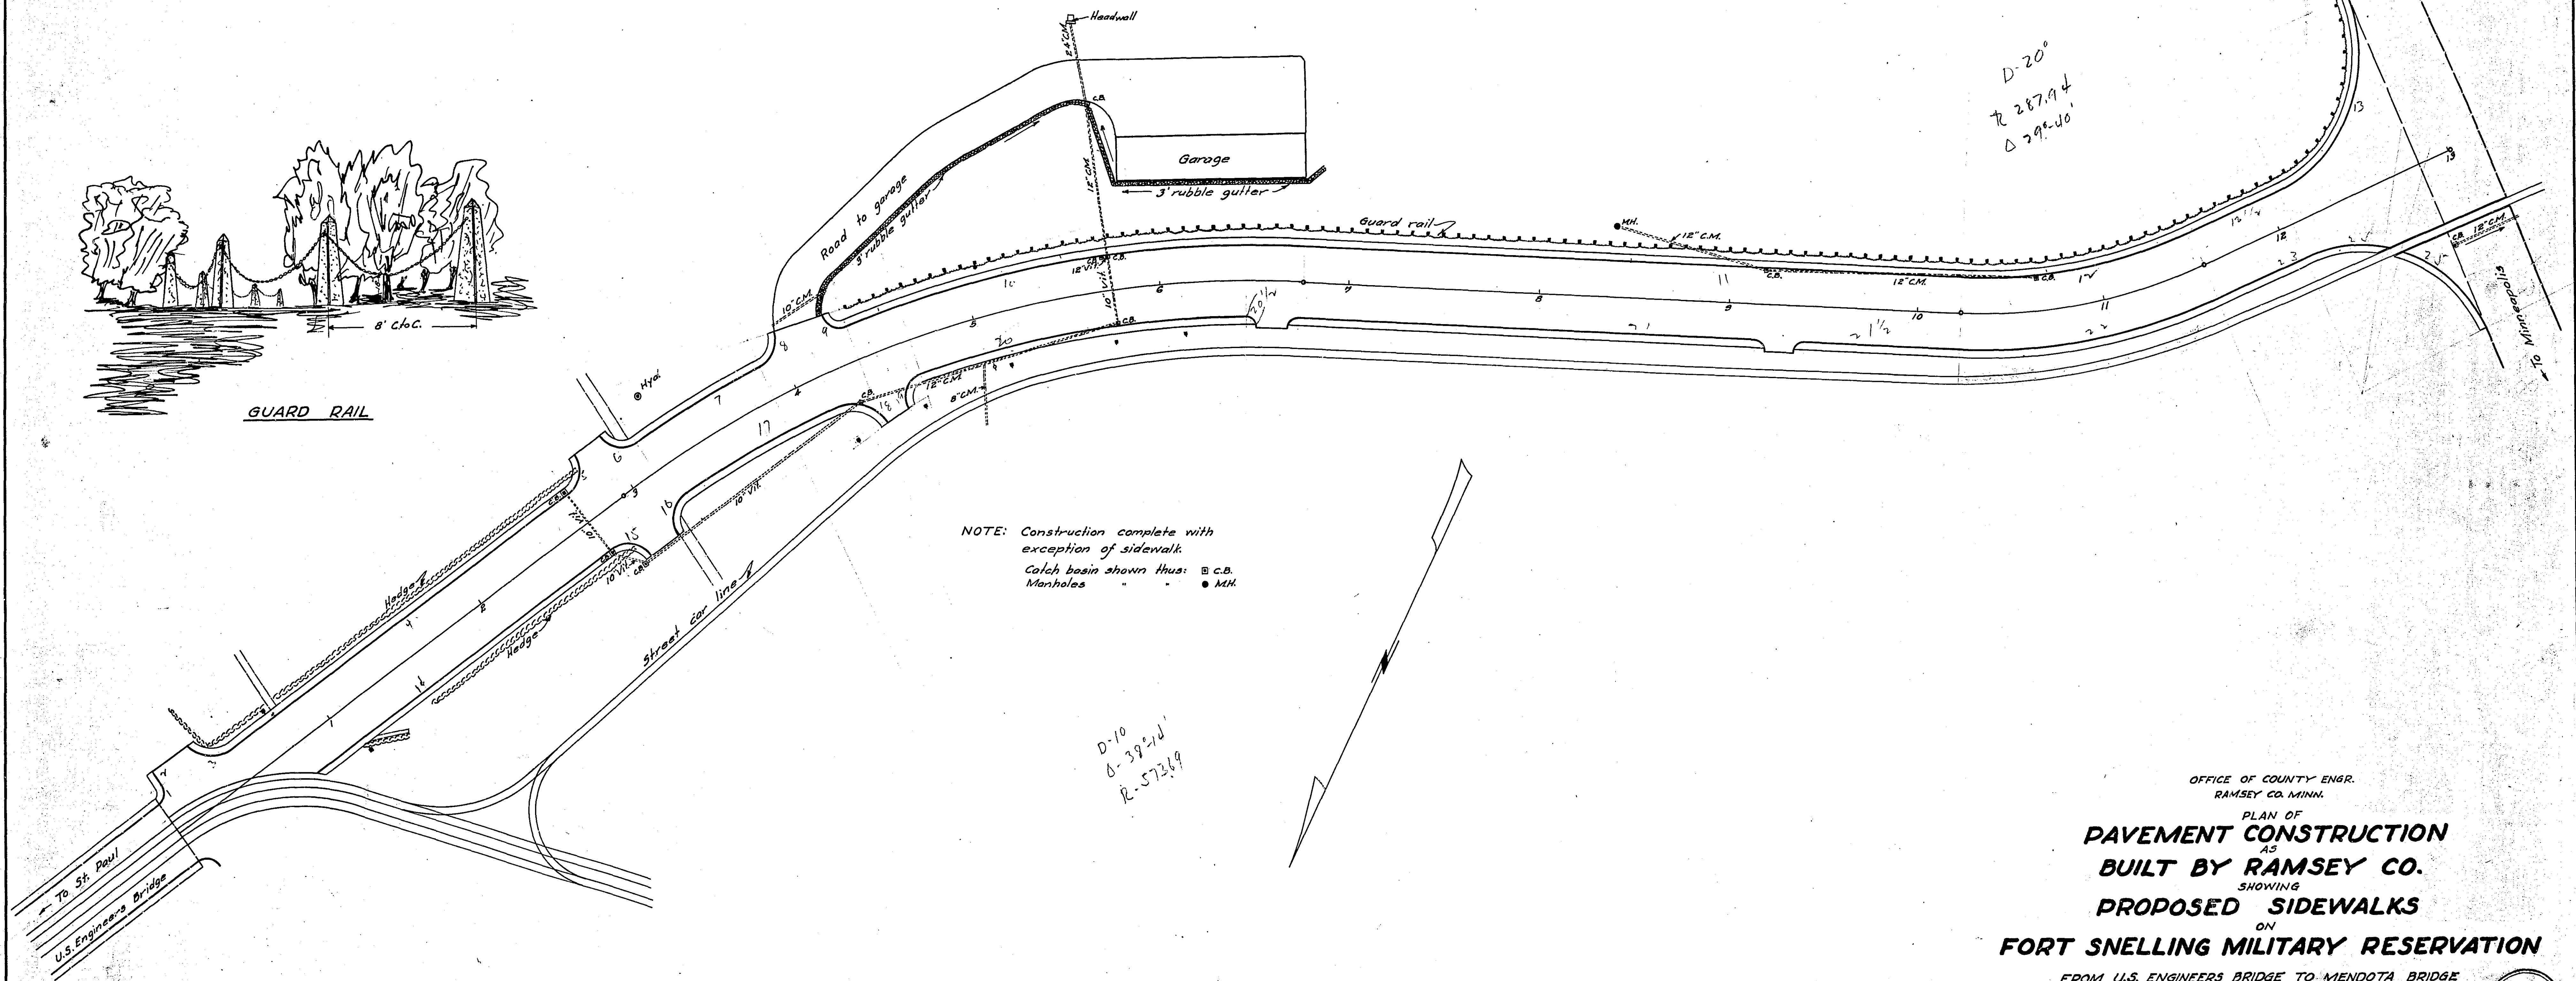

NOTE: Construction complete with exception of sidewalk.
Catch basin shown thus: C.B.
Manholes " " M.H.

OFFICE OF COUNTY ENGR.
RAMSEY CO. MINN.

PLAN OF
PAVEMENT CONSTRUCTION
AS
BUILT BY RAMSEY CO.
SHOWING
PROPOSED SIDEWALKS
ON
FORT SNELLING MILITARY RESERVATION

FROM U.S. ENGINEERS BRIDGE TO MENDOTA BRIDGE
(RAMSEY COUNTY PROJ. 25-58)

Scale 10 feet



SUBMITTED BY: ASSISTANT ENGINEER

APPROVED 8-1 1927 COUNTY ENGINEER
RAMSEY COUNTY

MICROFILMED
RAMSEY CO. ENGR.

APPROVED 8/1 1927 CHAIRMAN OF COUNTY BOARD
RAMSEY COUNTY