


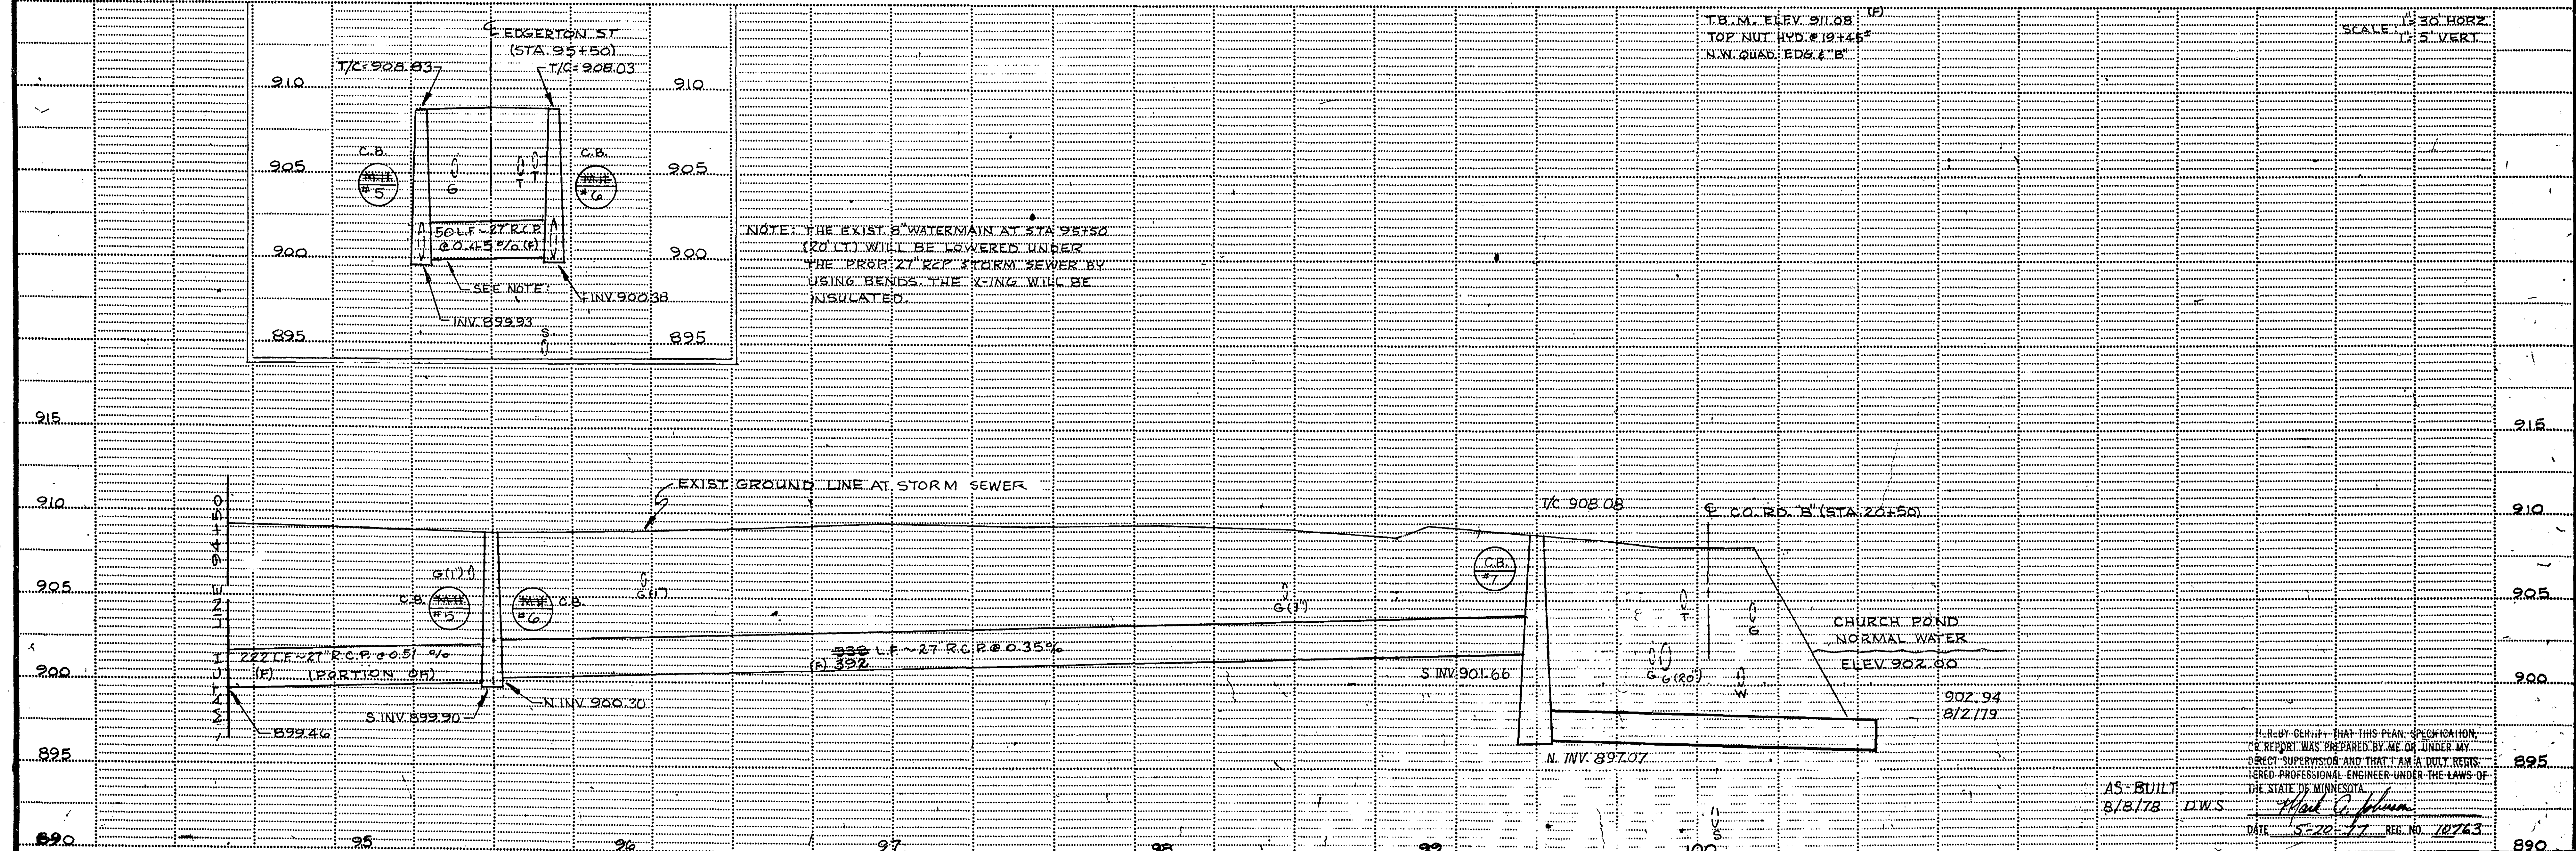
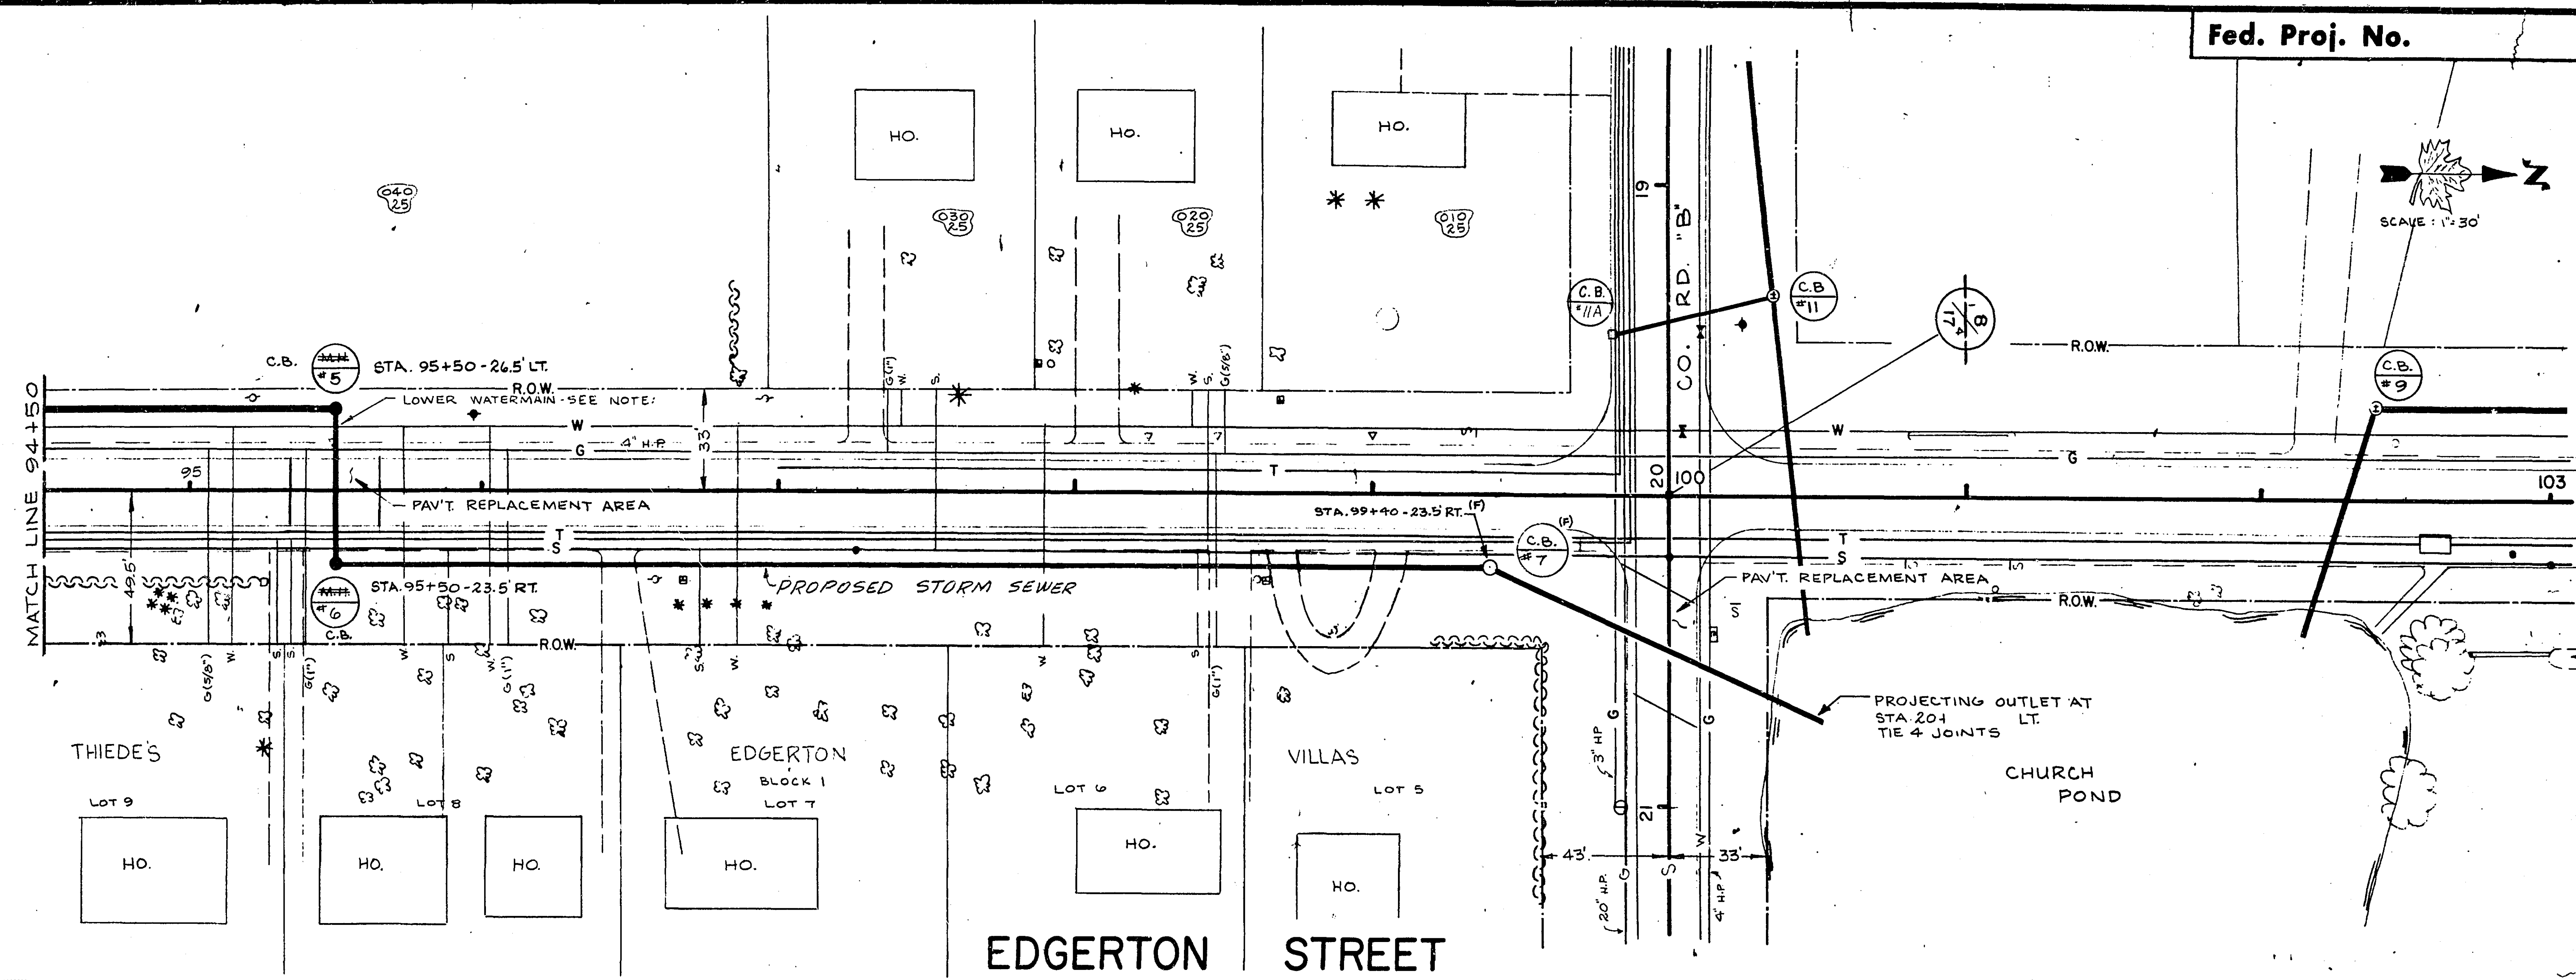
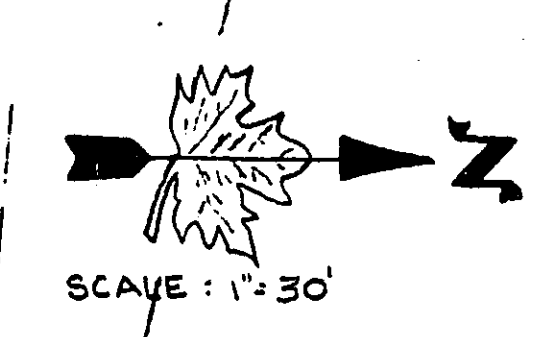


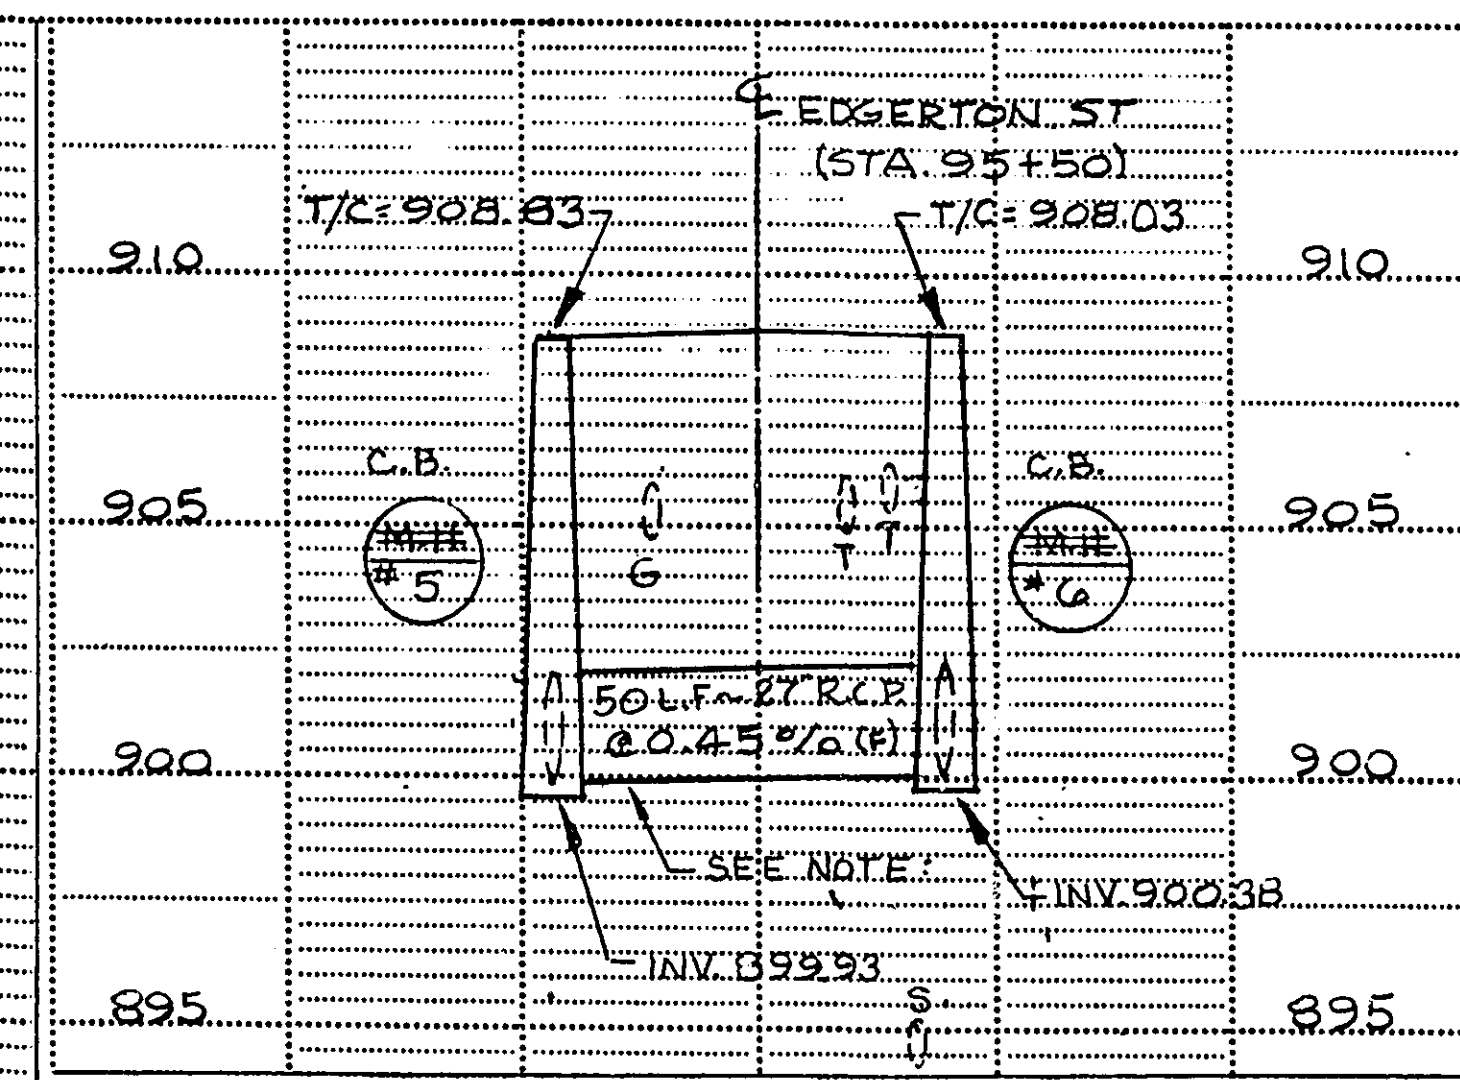

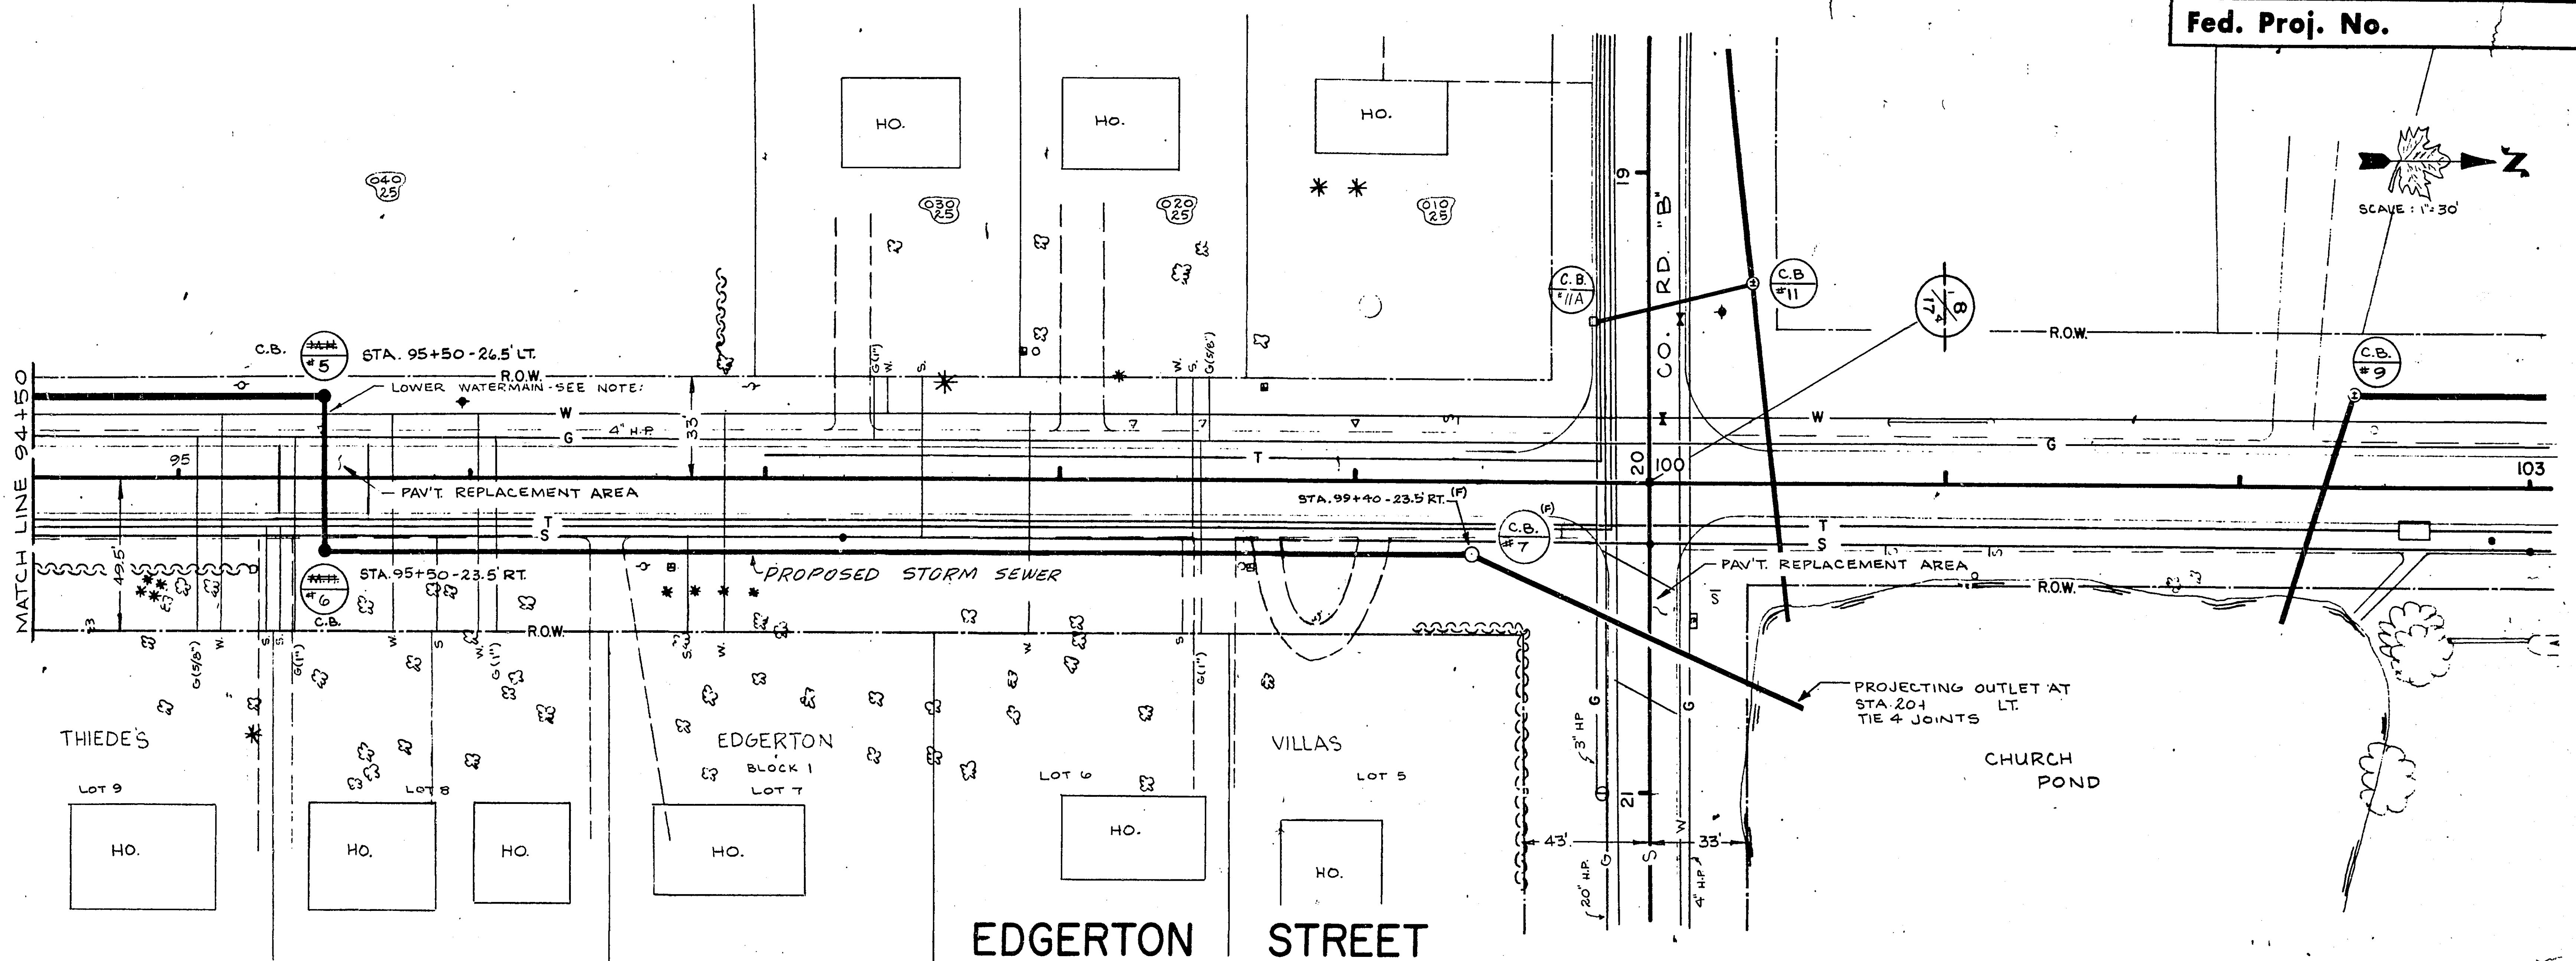

NOTE: THE EXIST. WATERMAIN AT STA. 95+50 (20' LT.) WILL BE LOWERED UNDER THE PROPOSED STORM SEWER BY USING BENDS. THE KING WILL BE INSULATED.

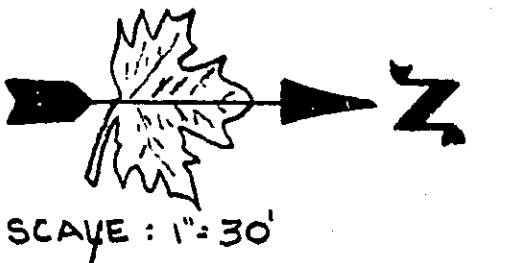