



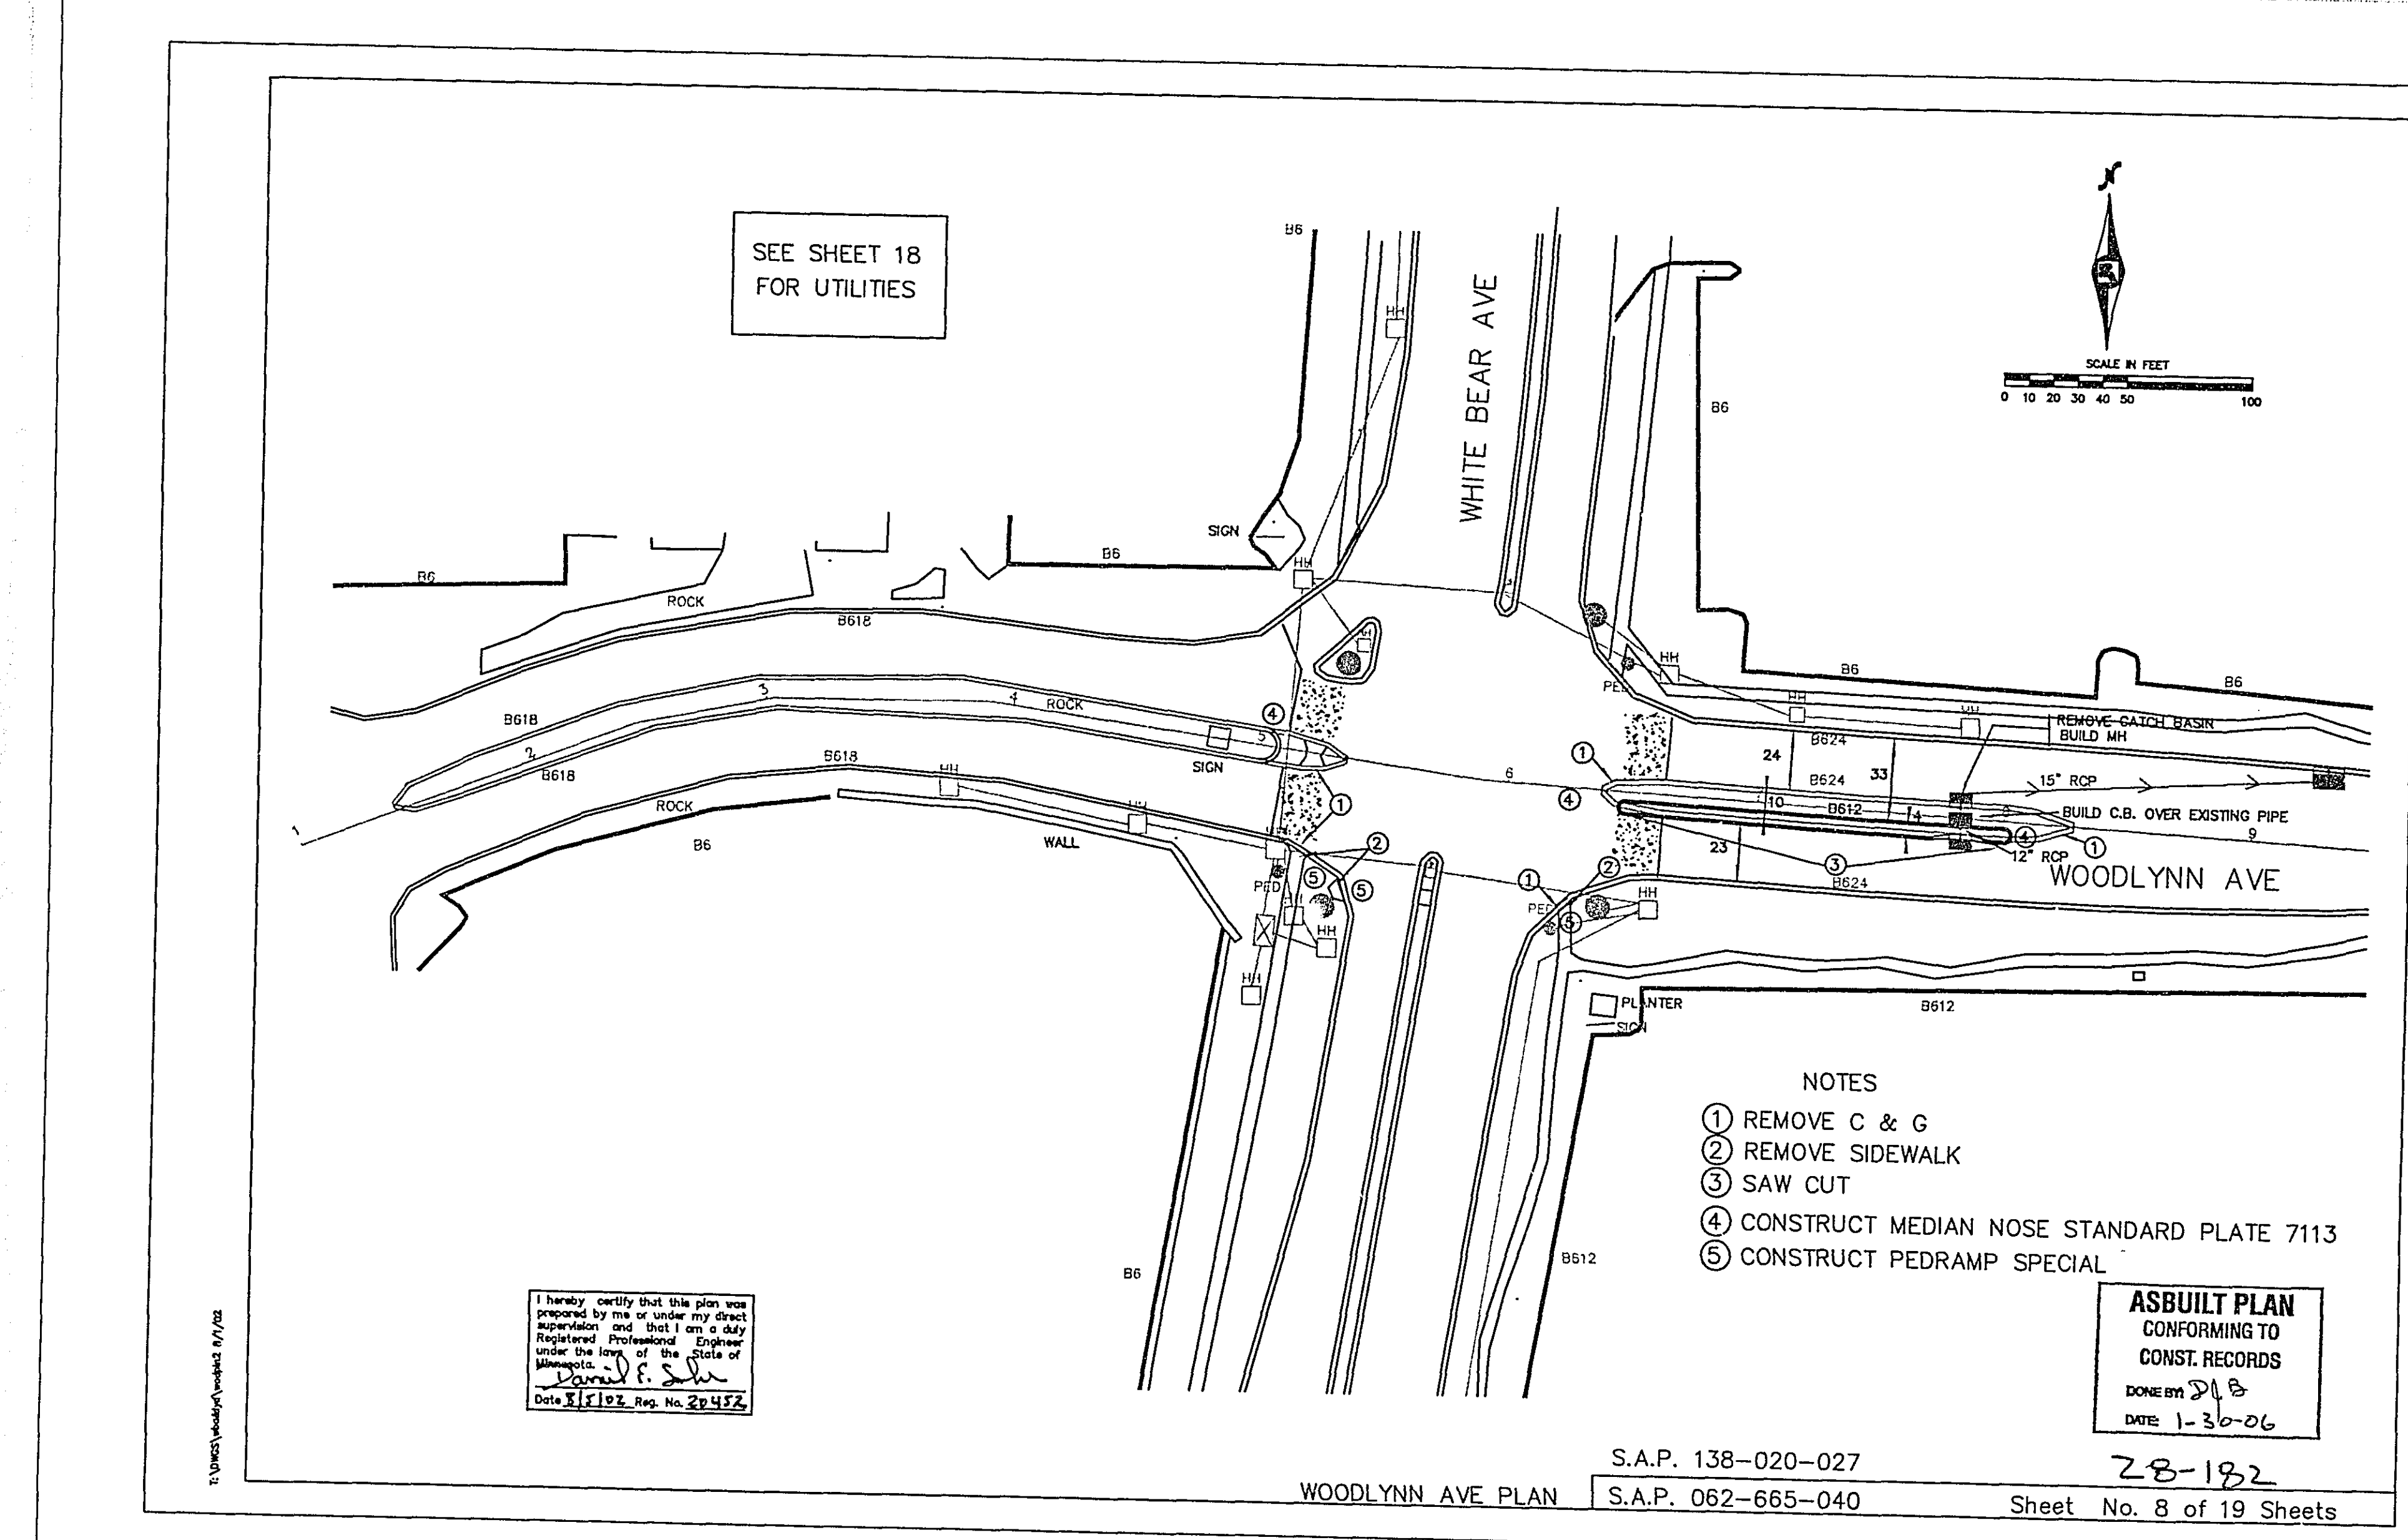
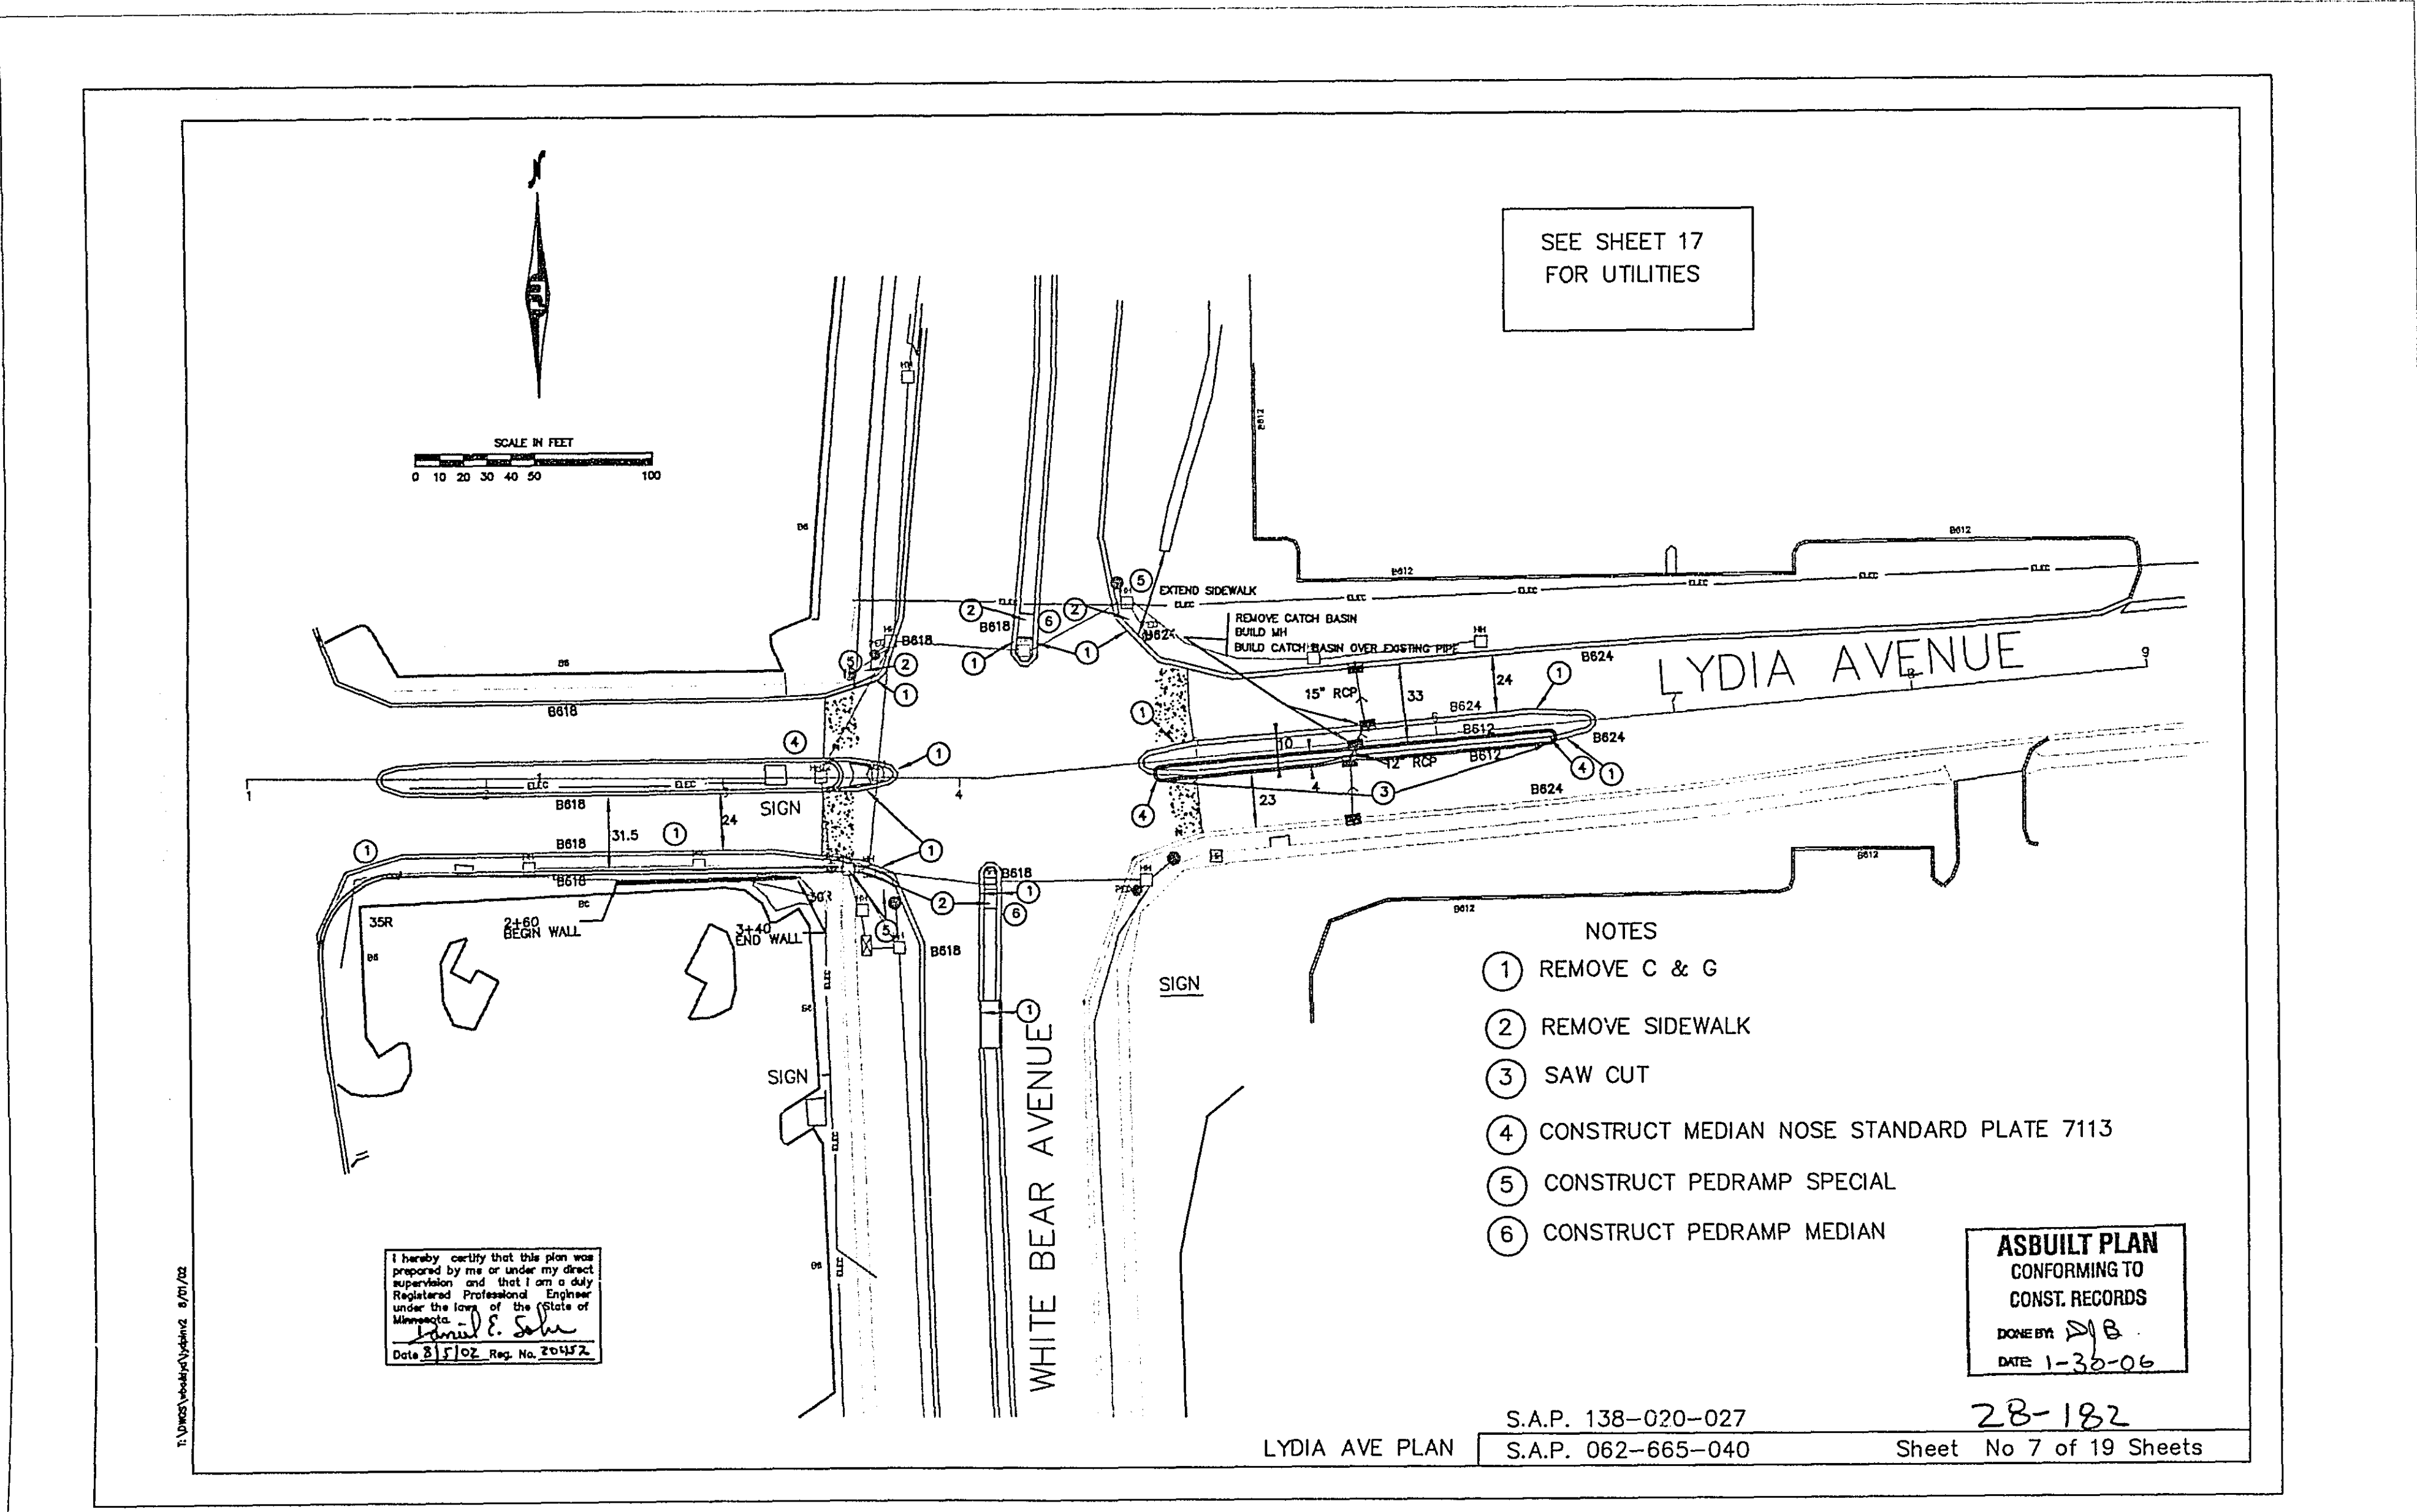
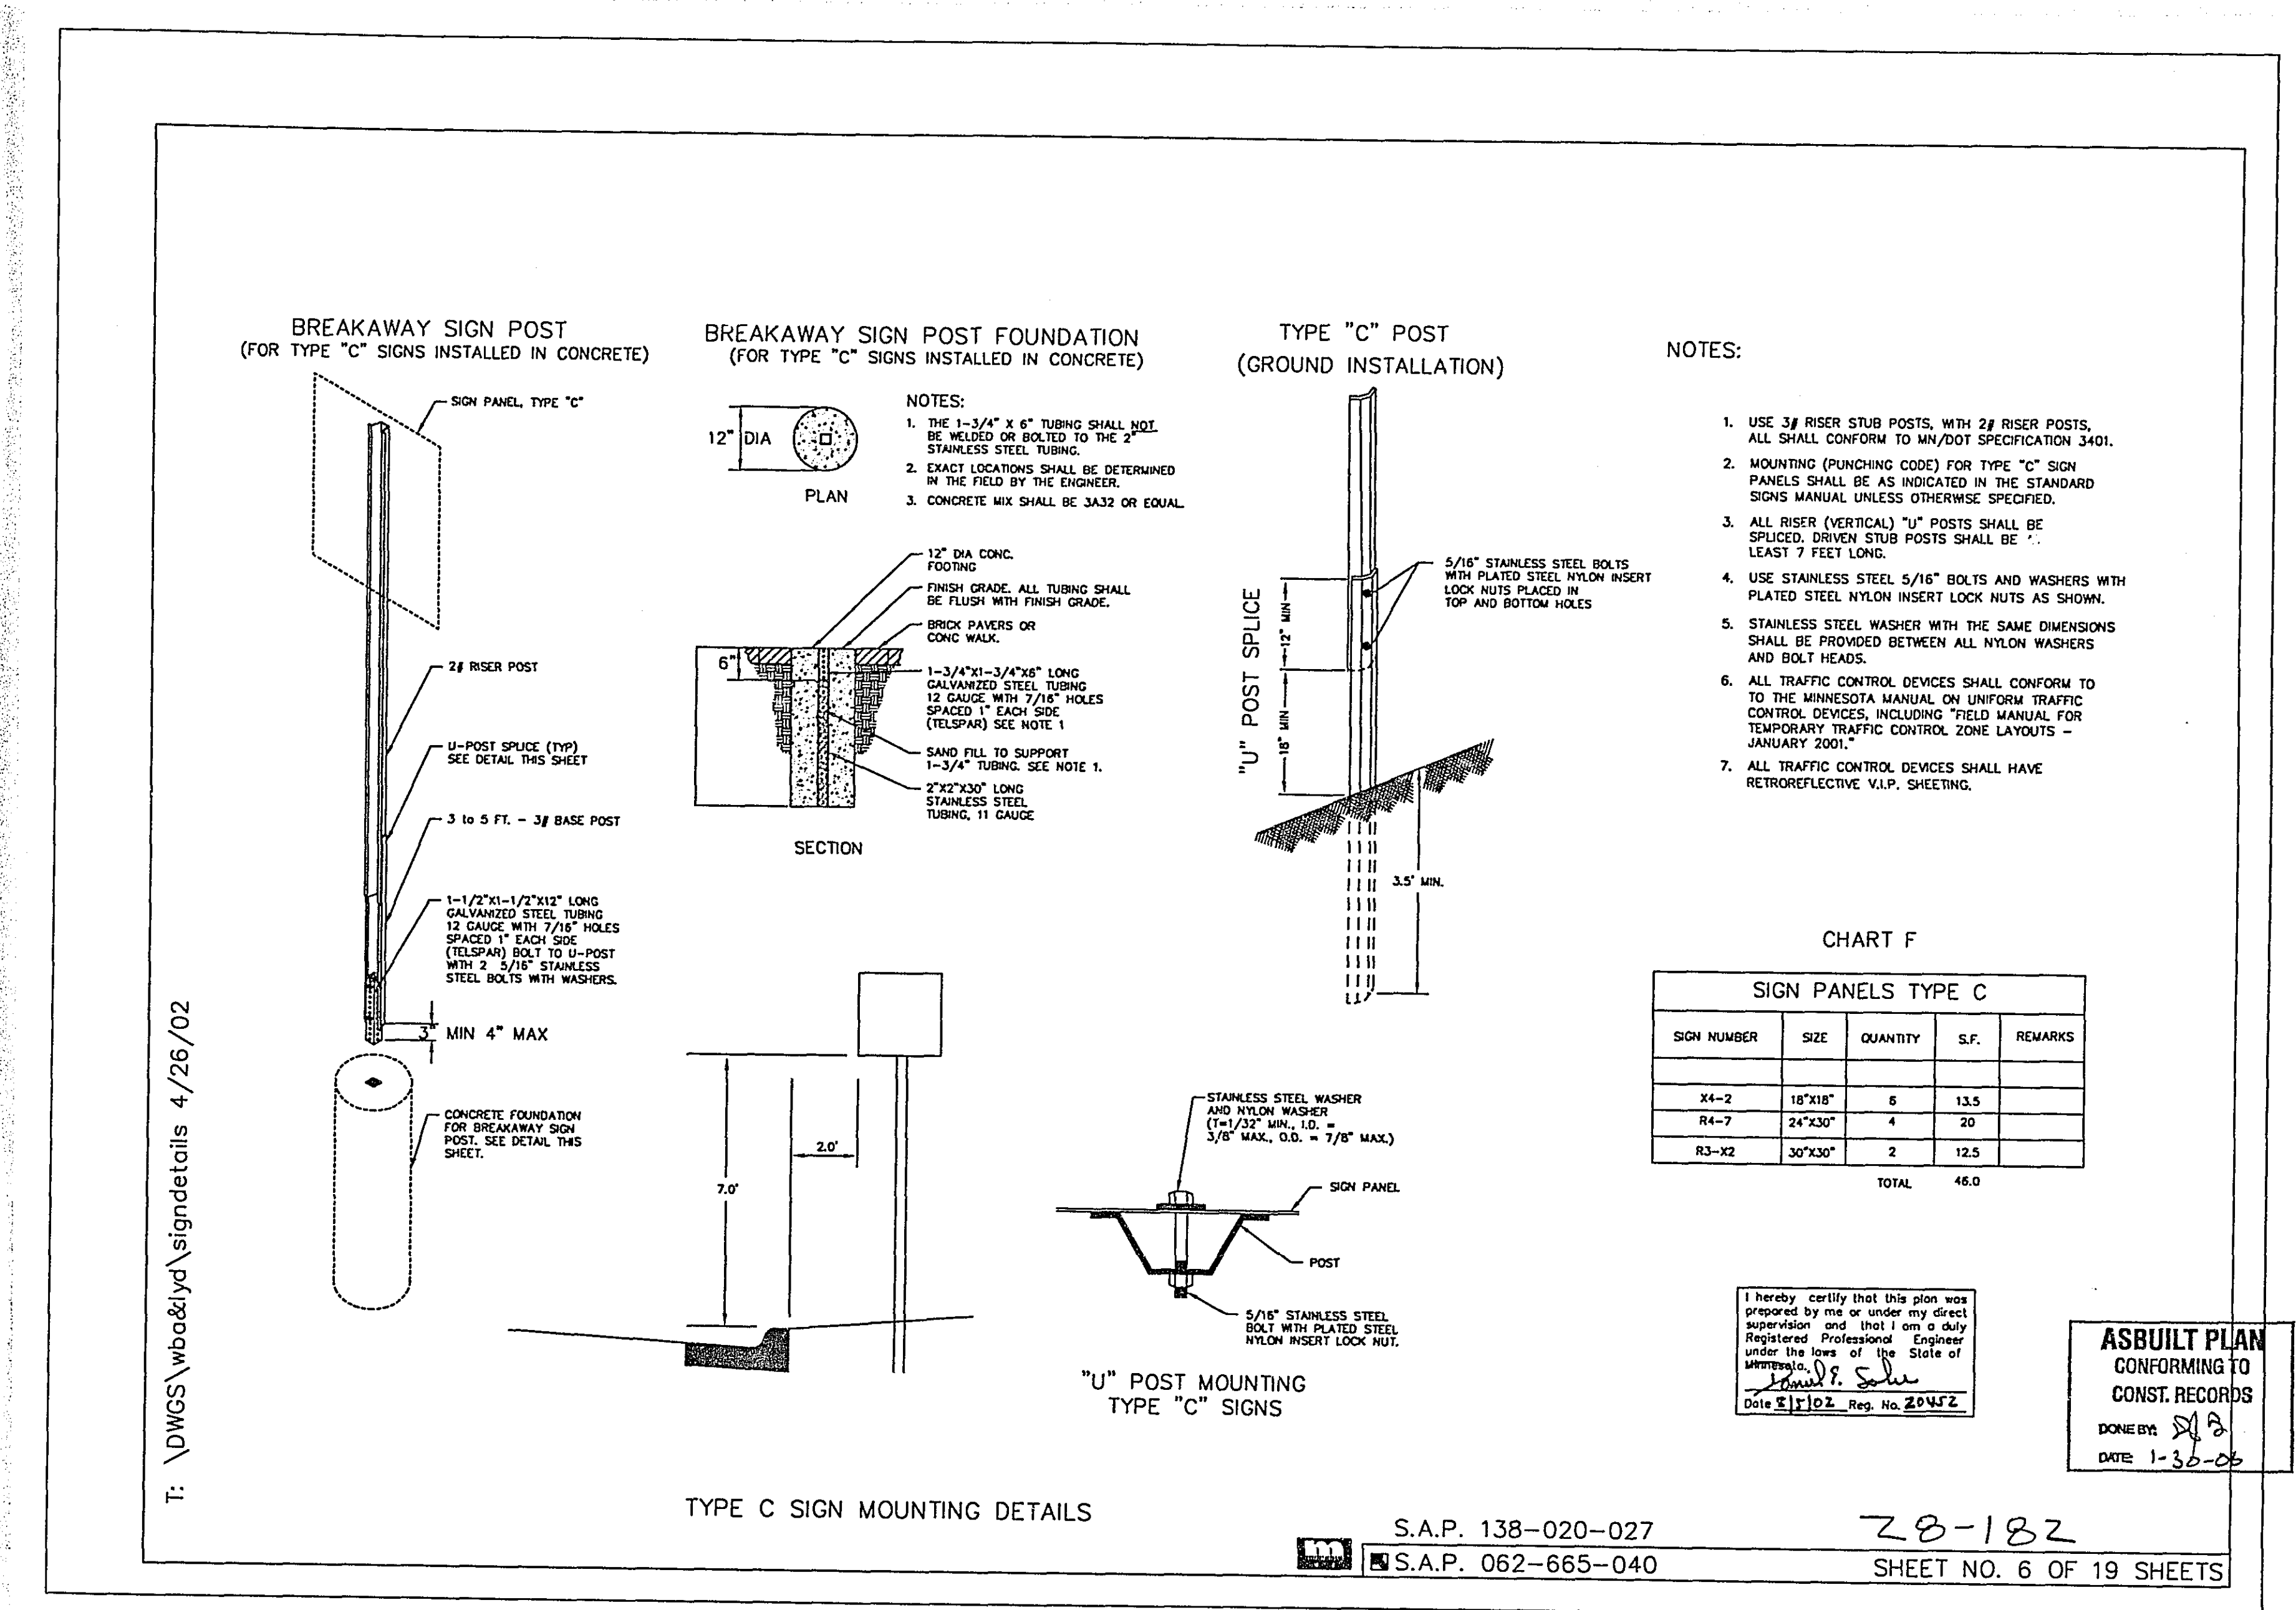
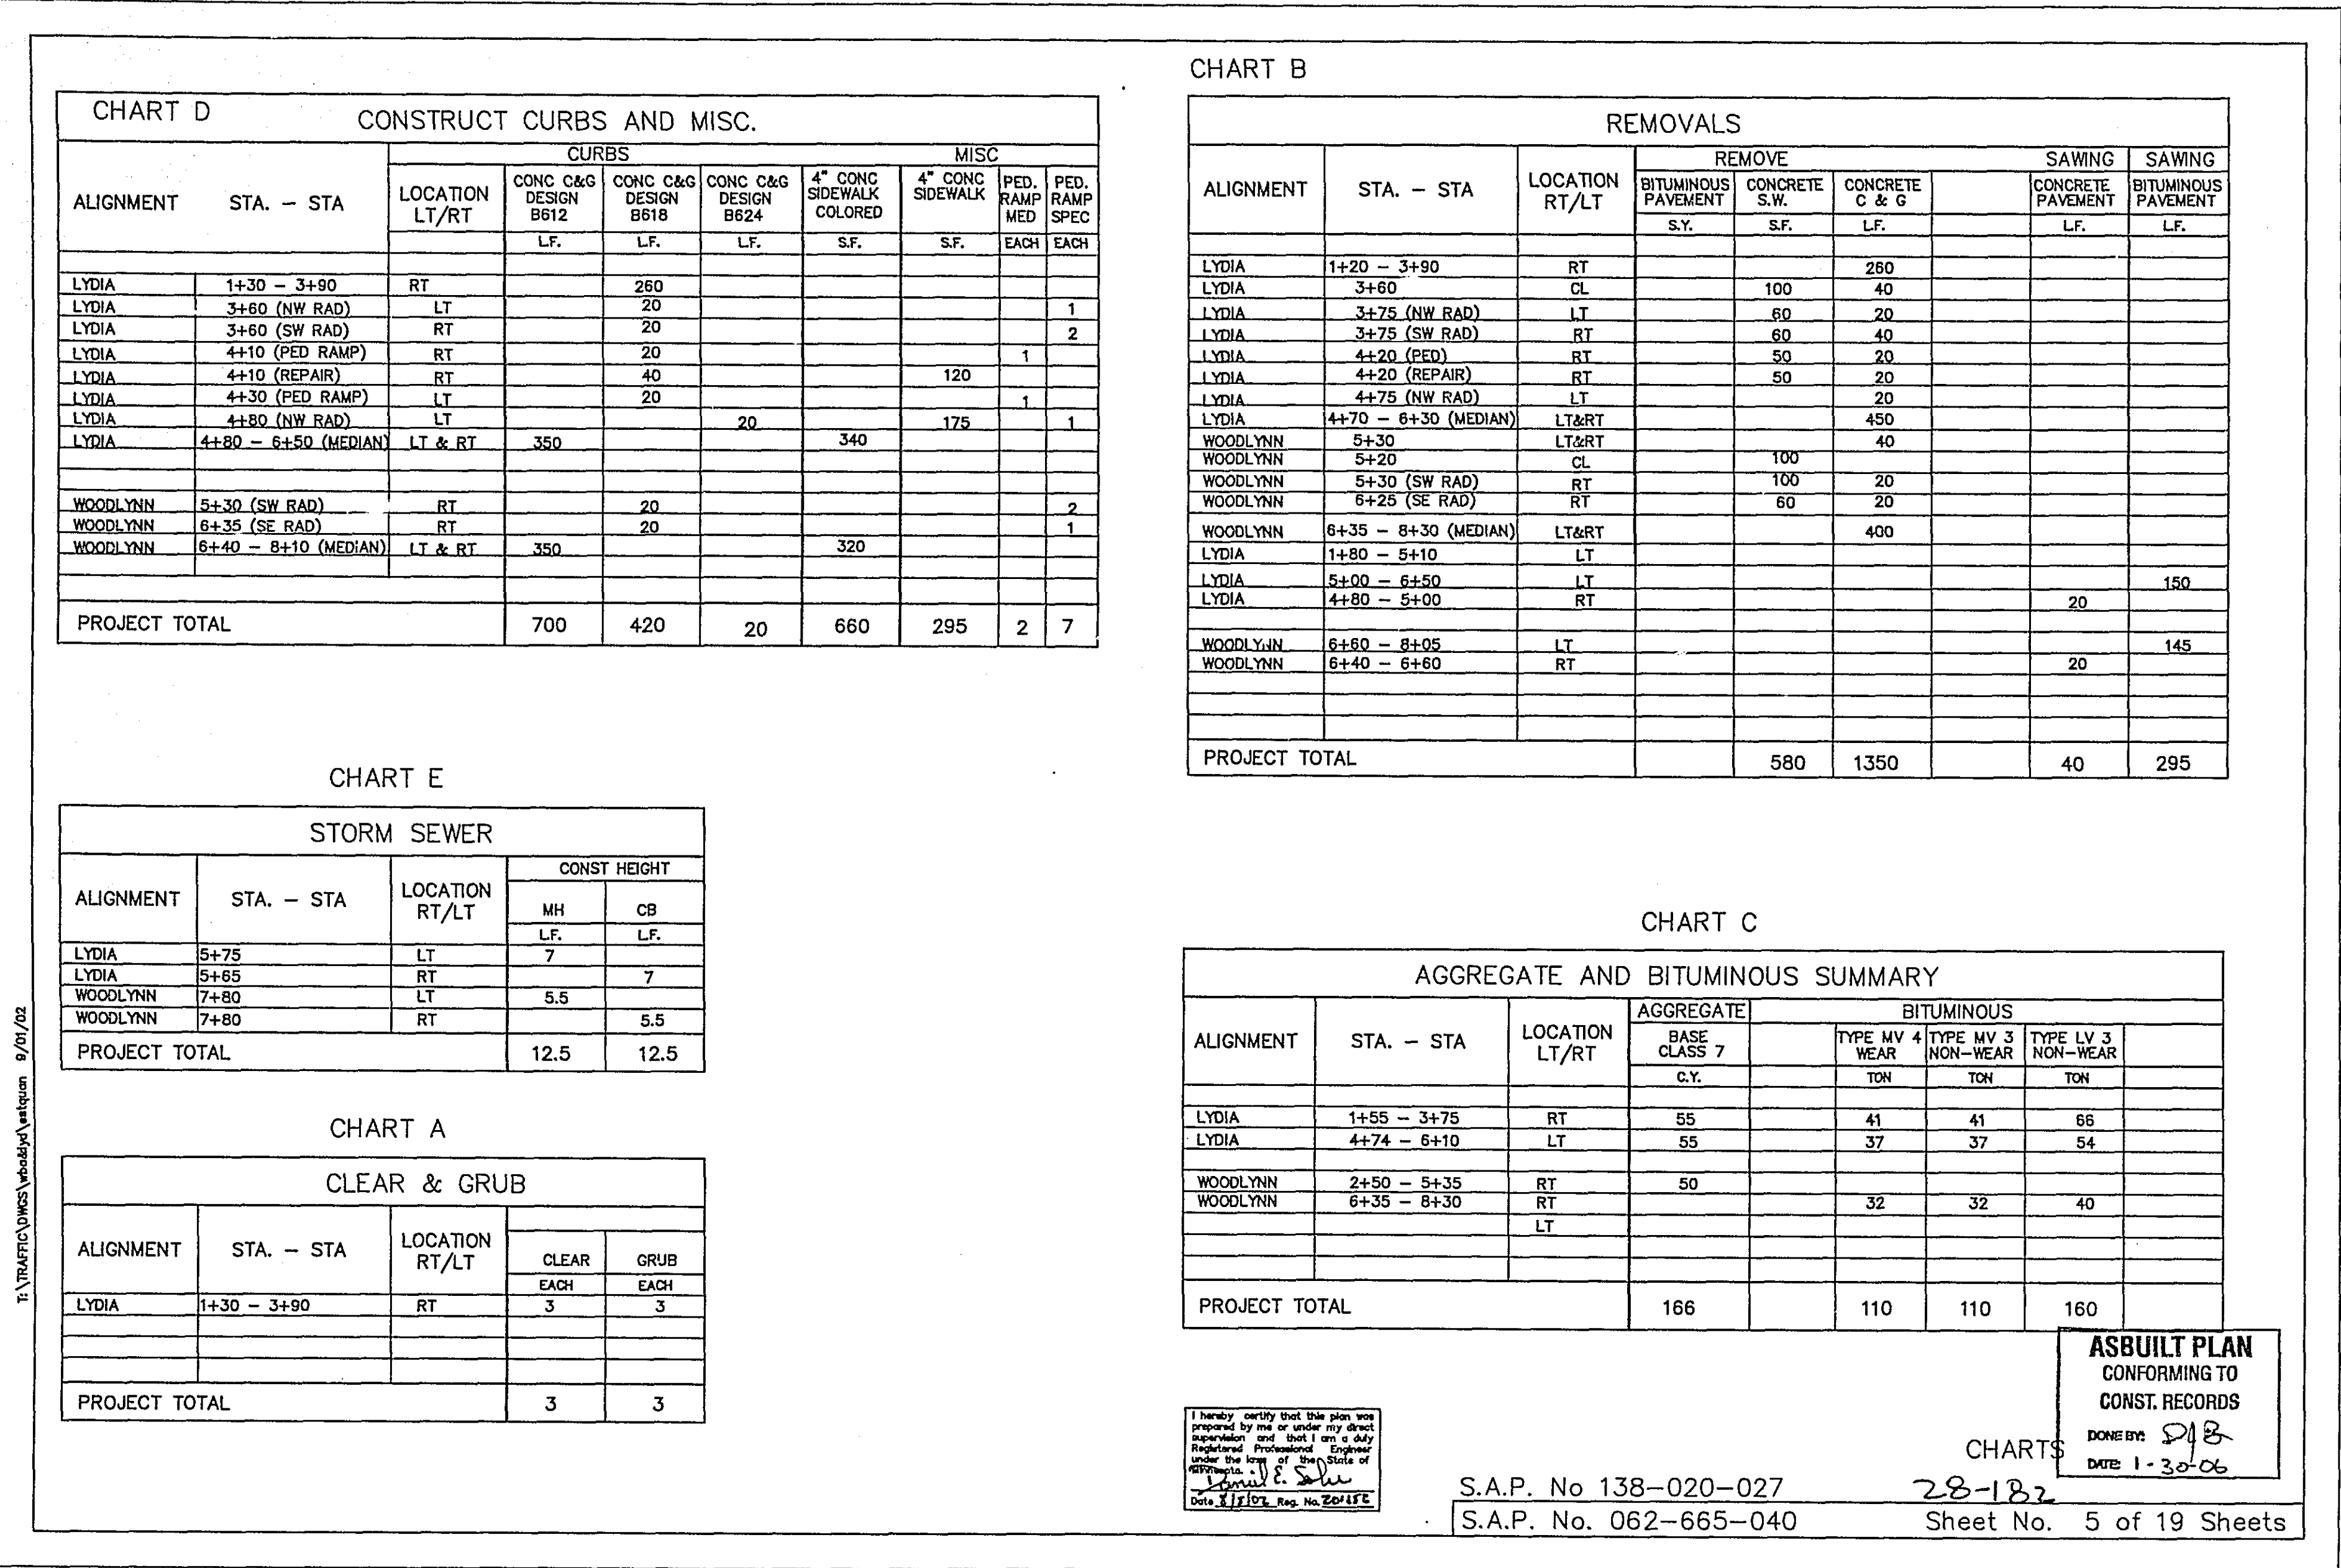
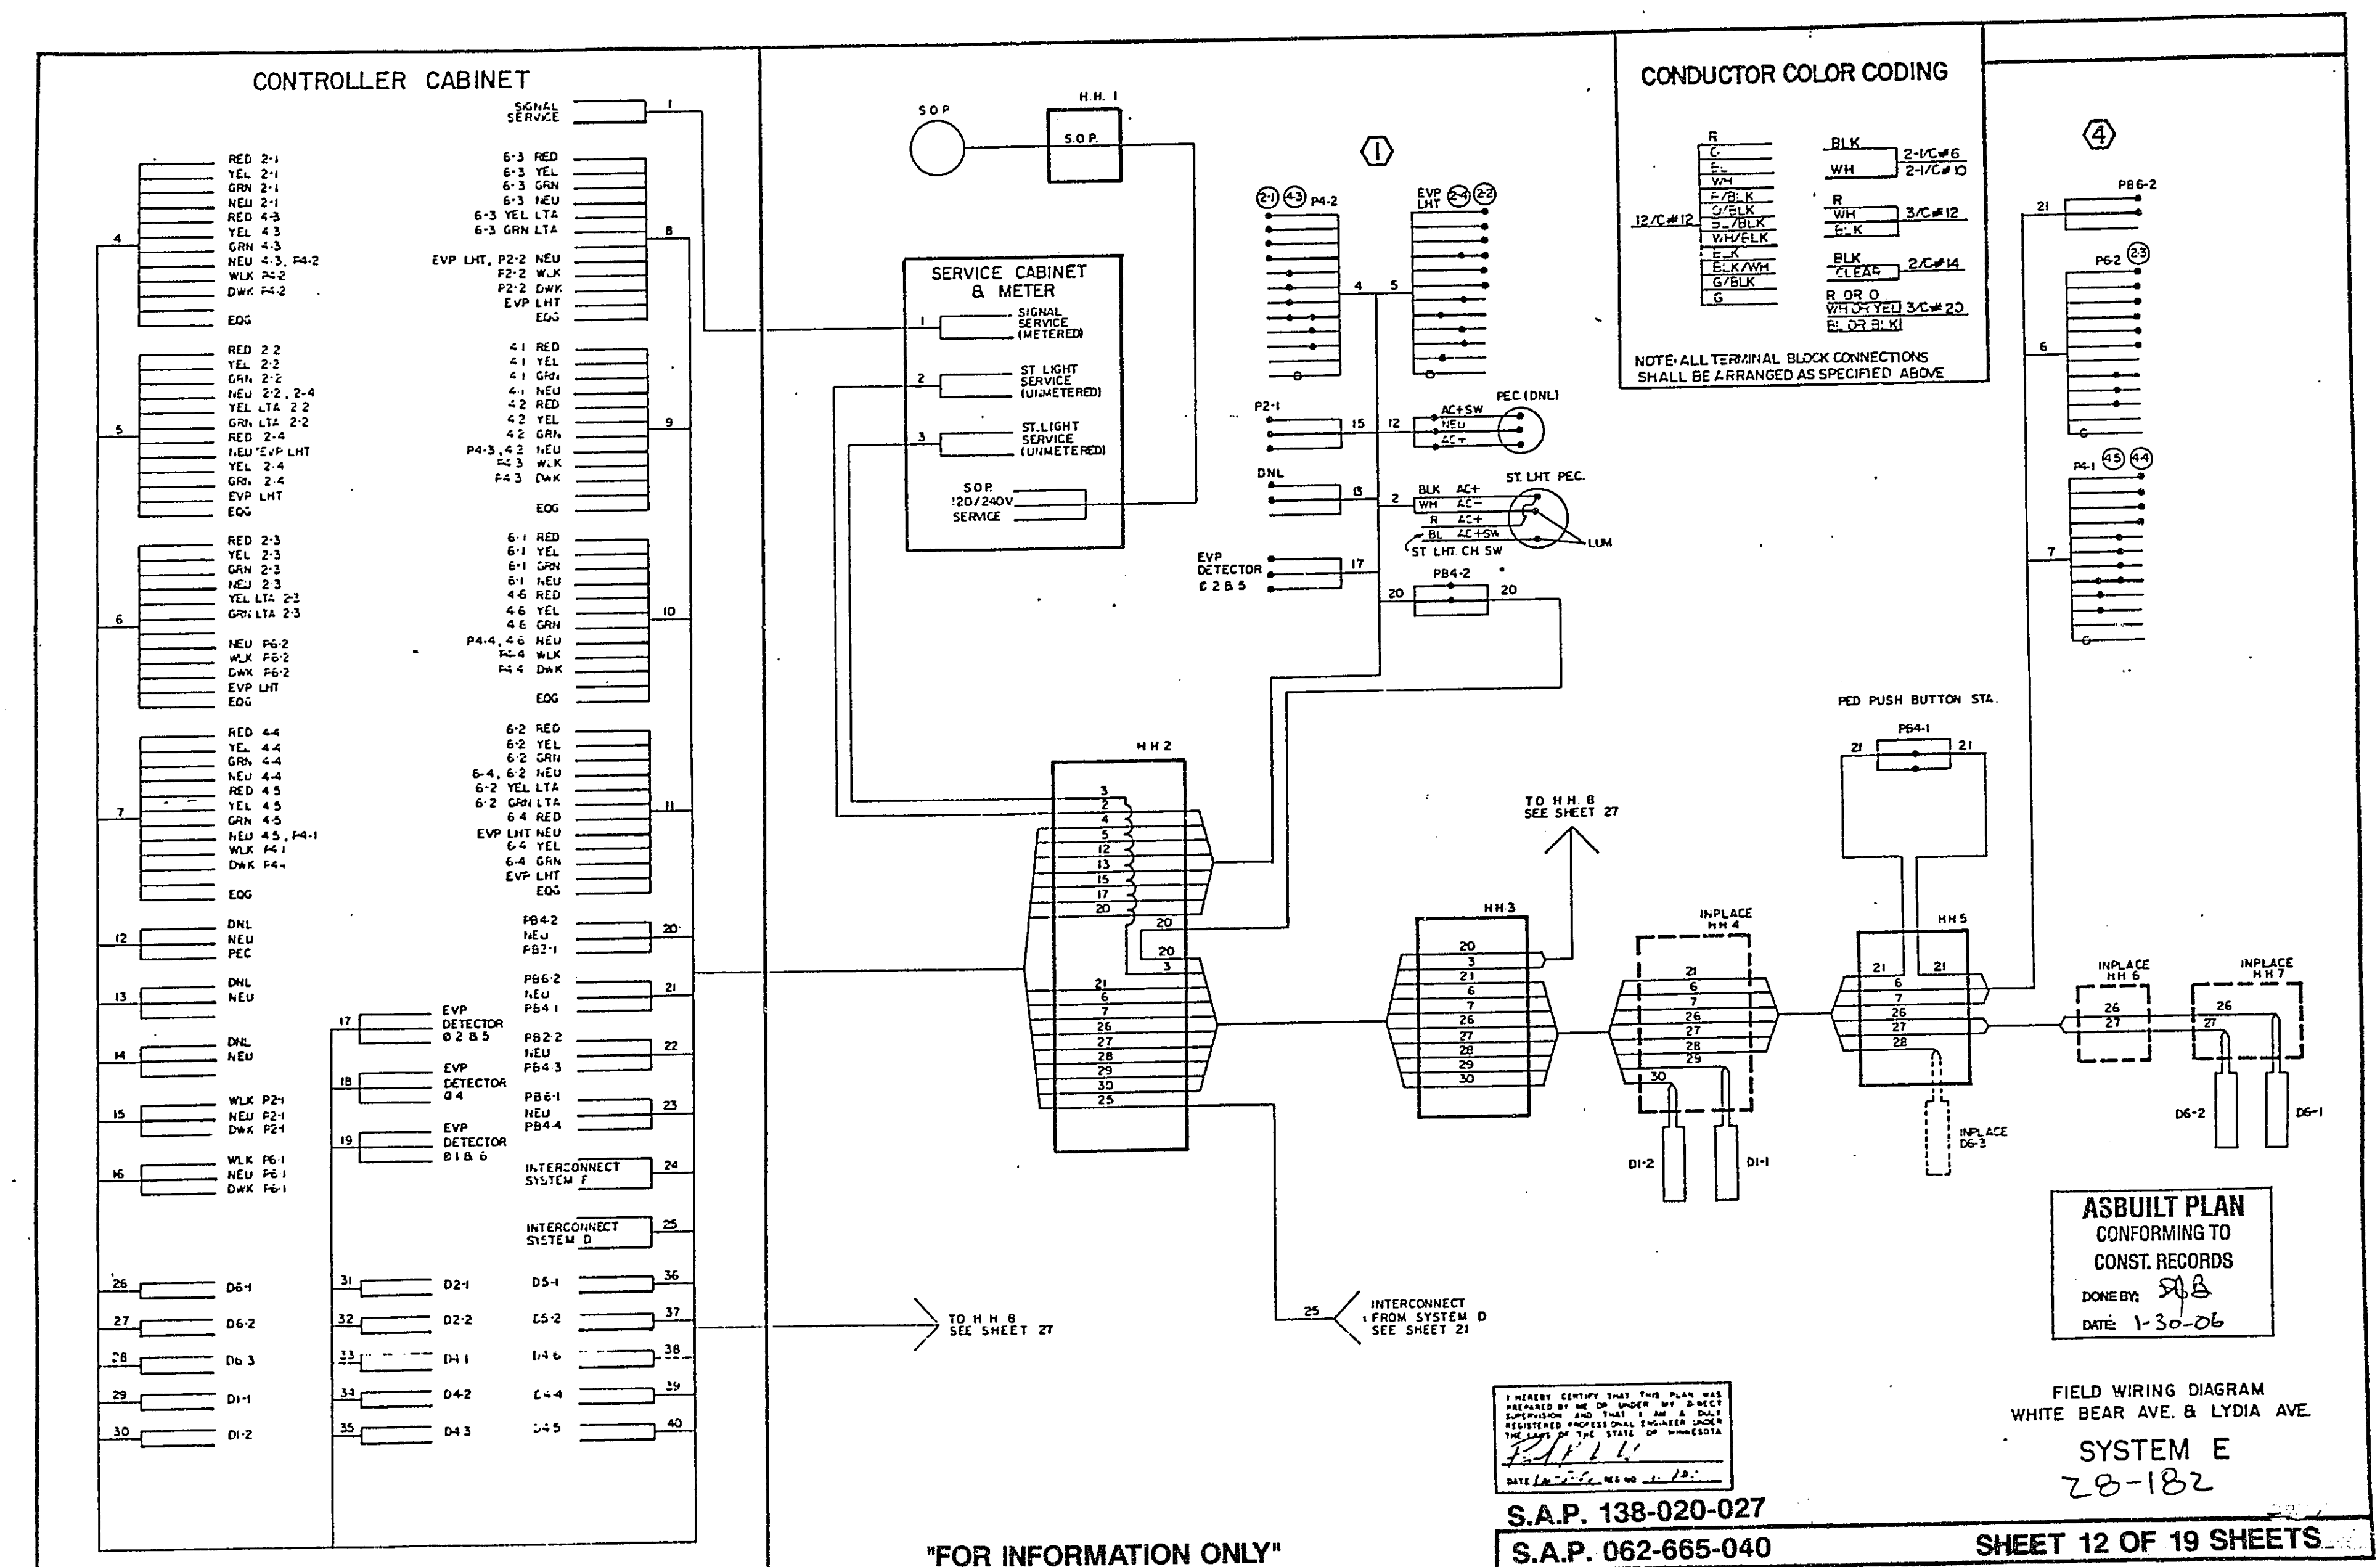
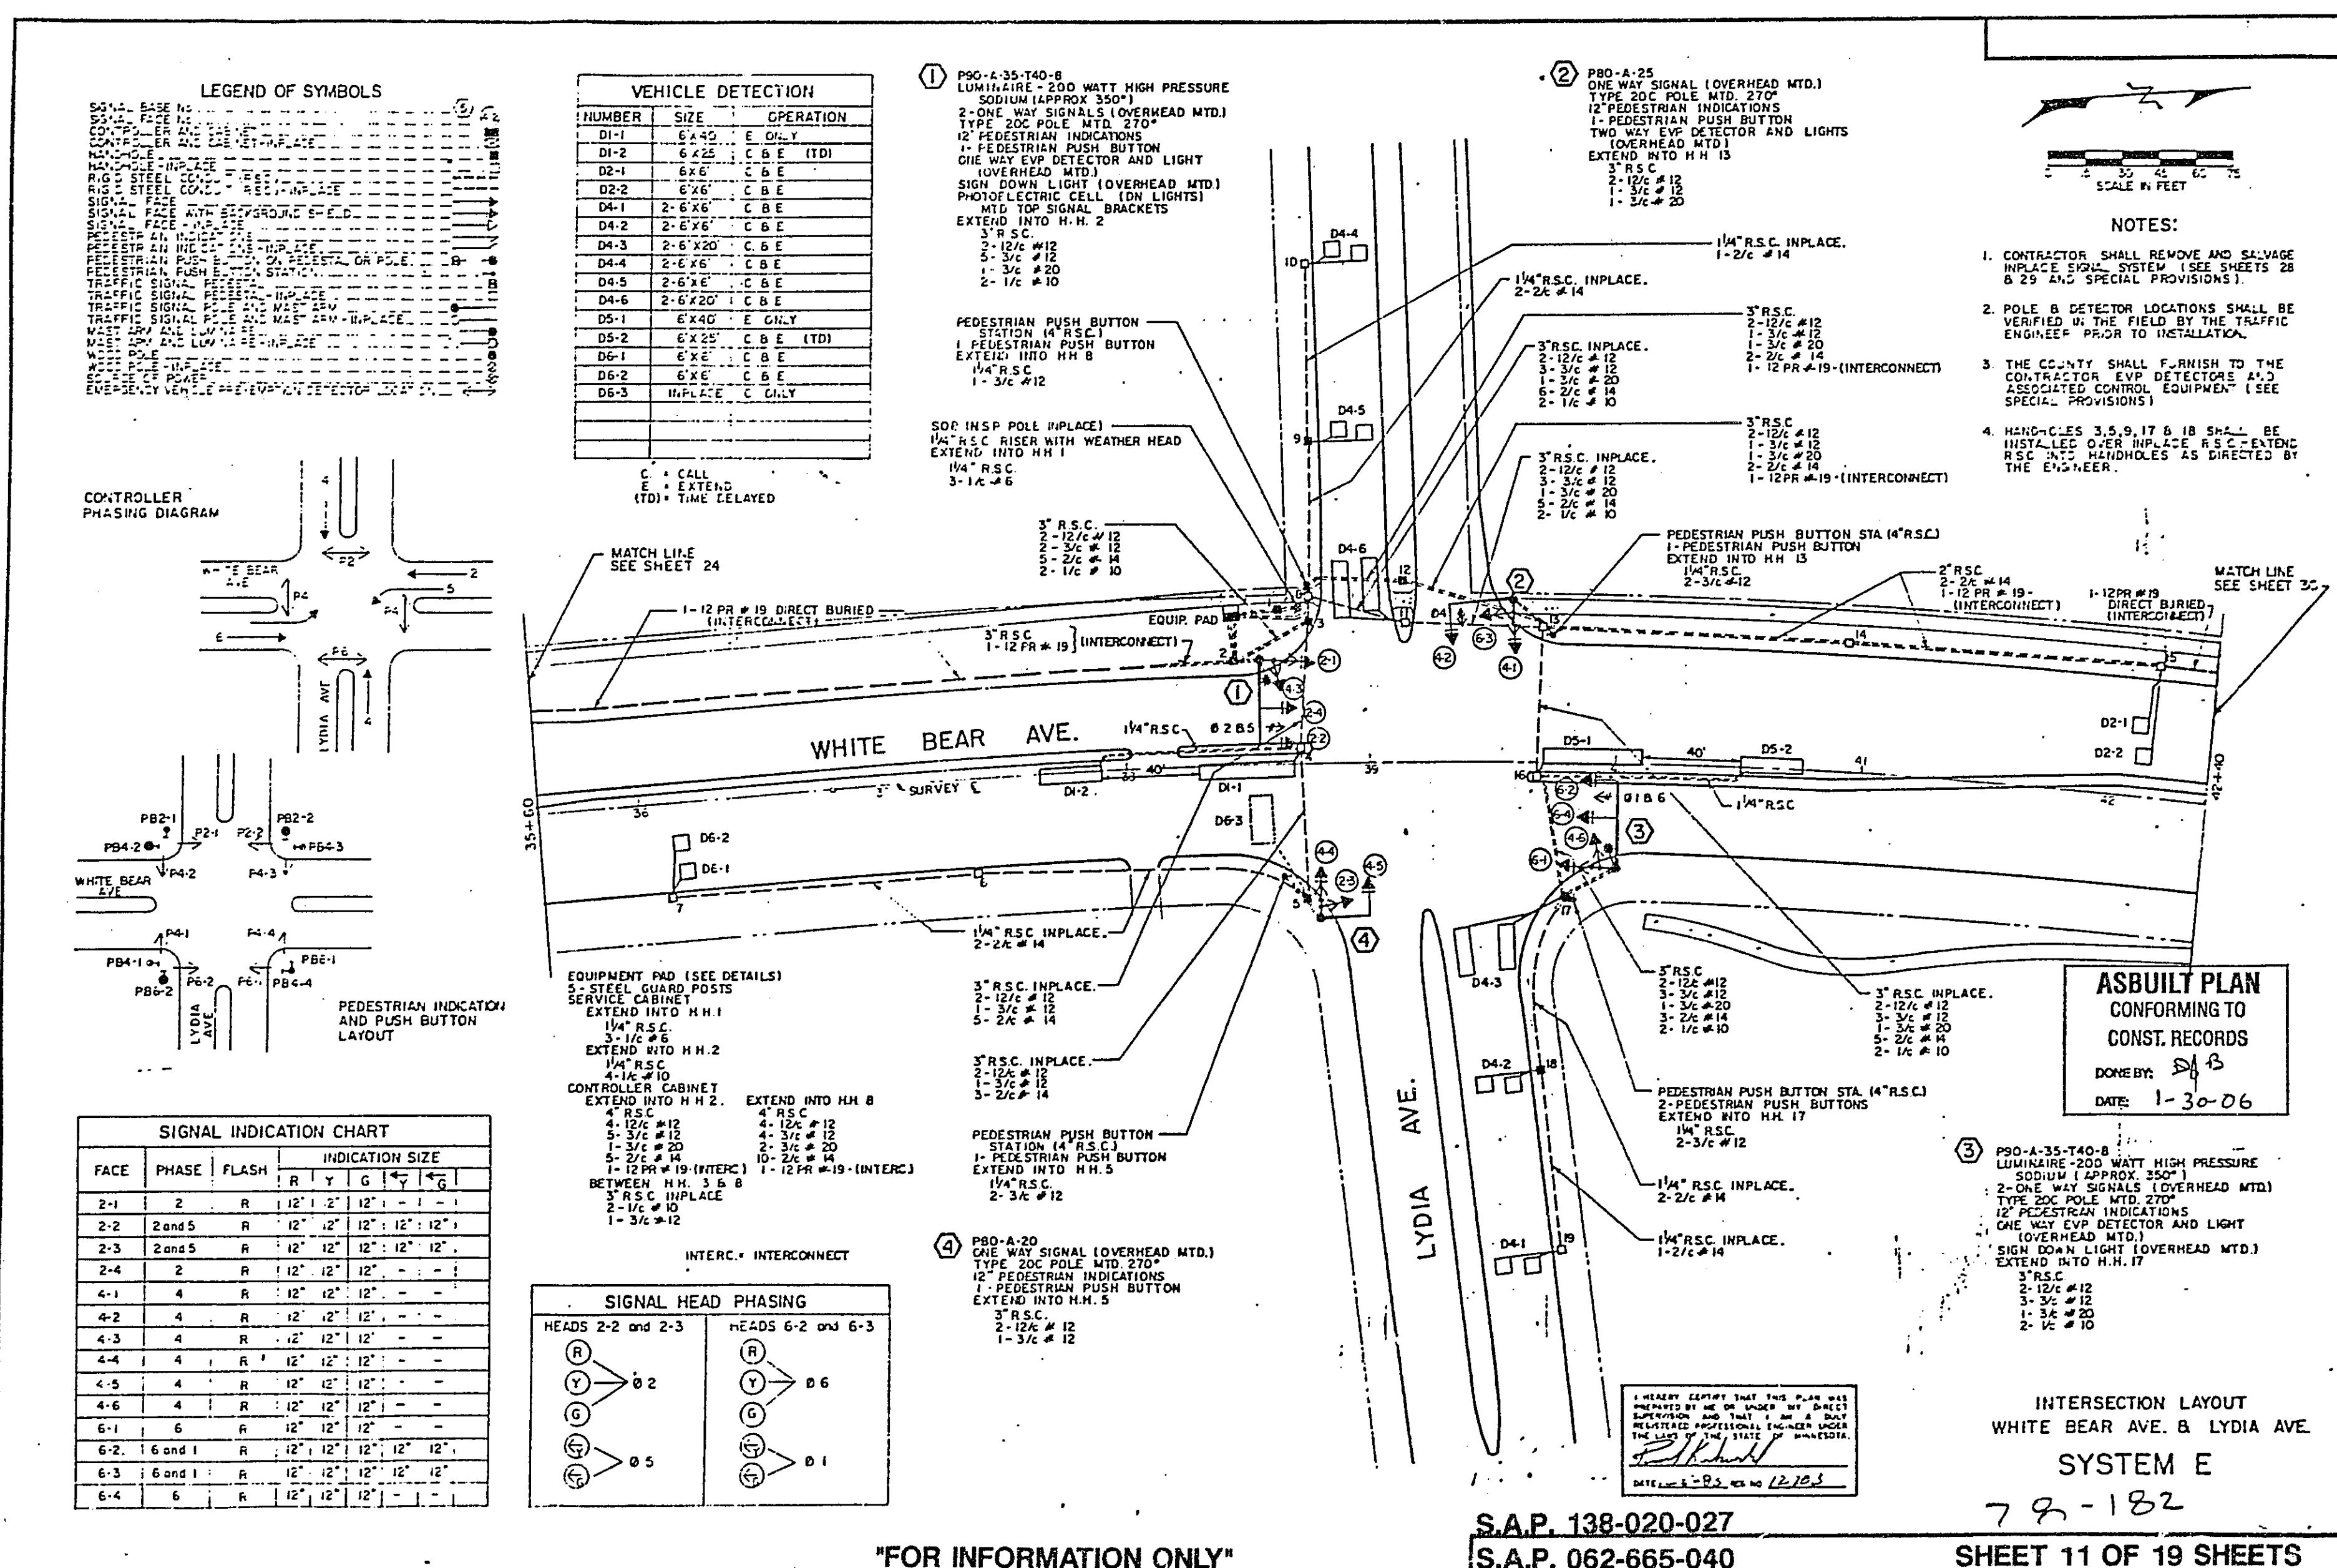
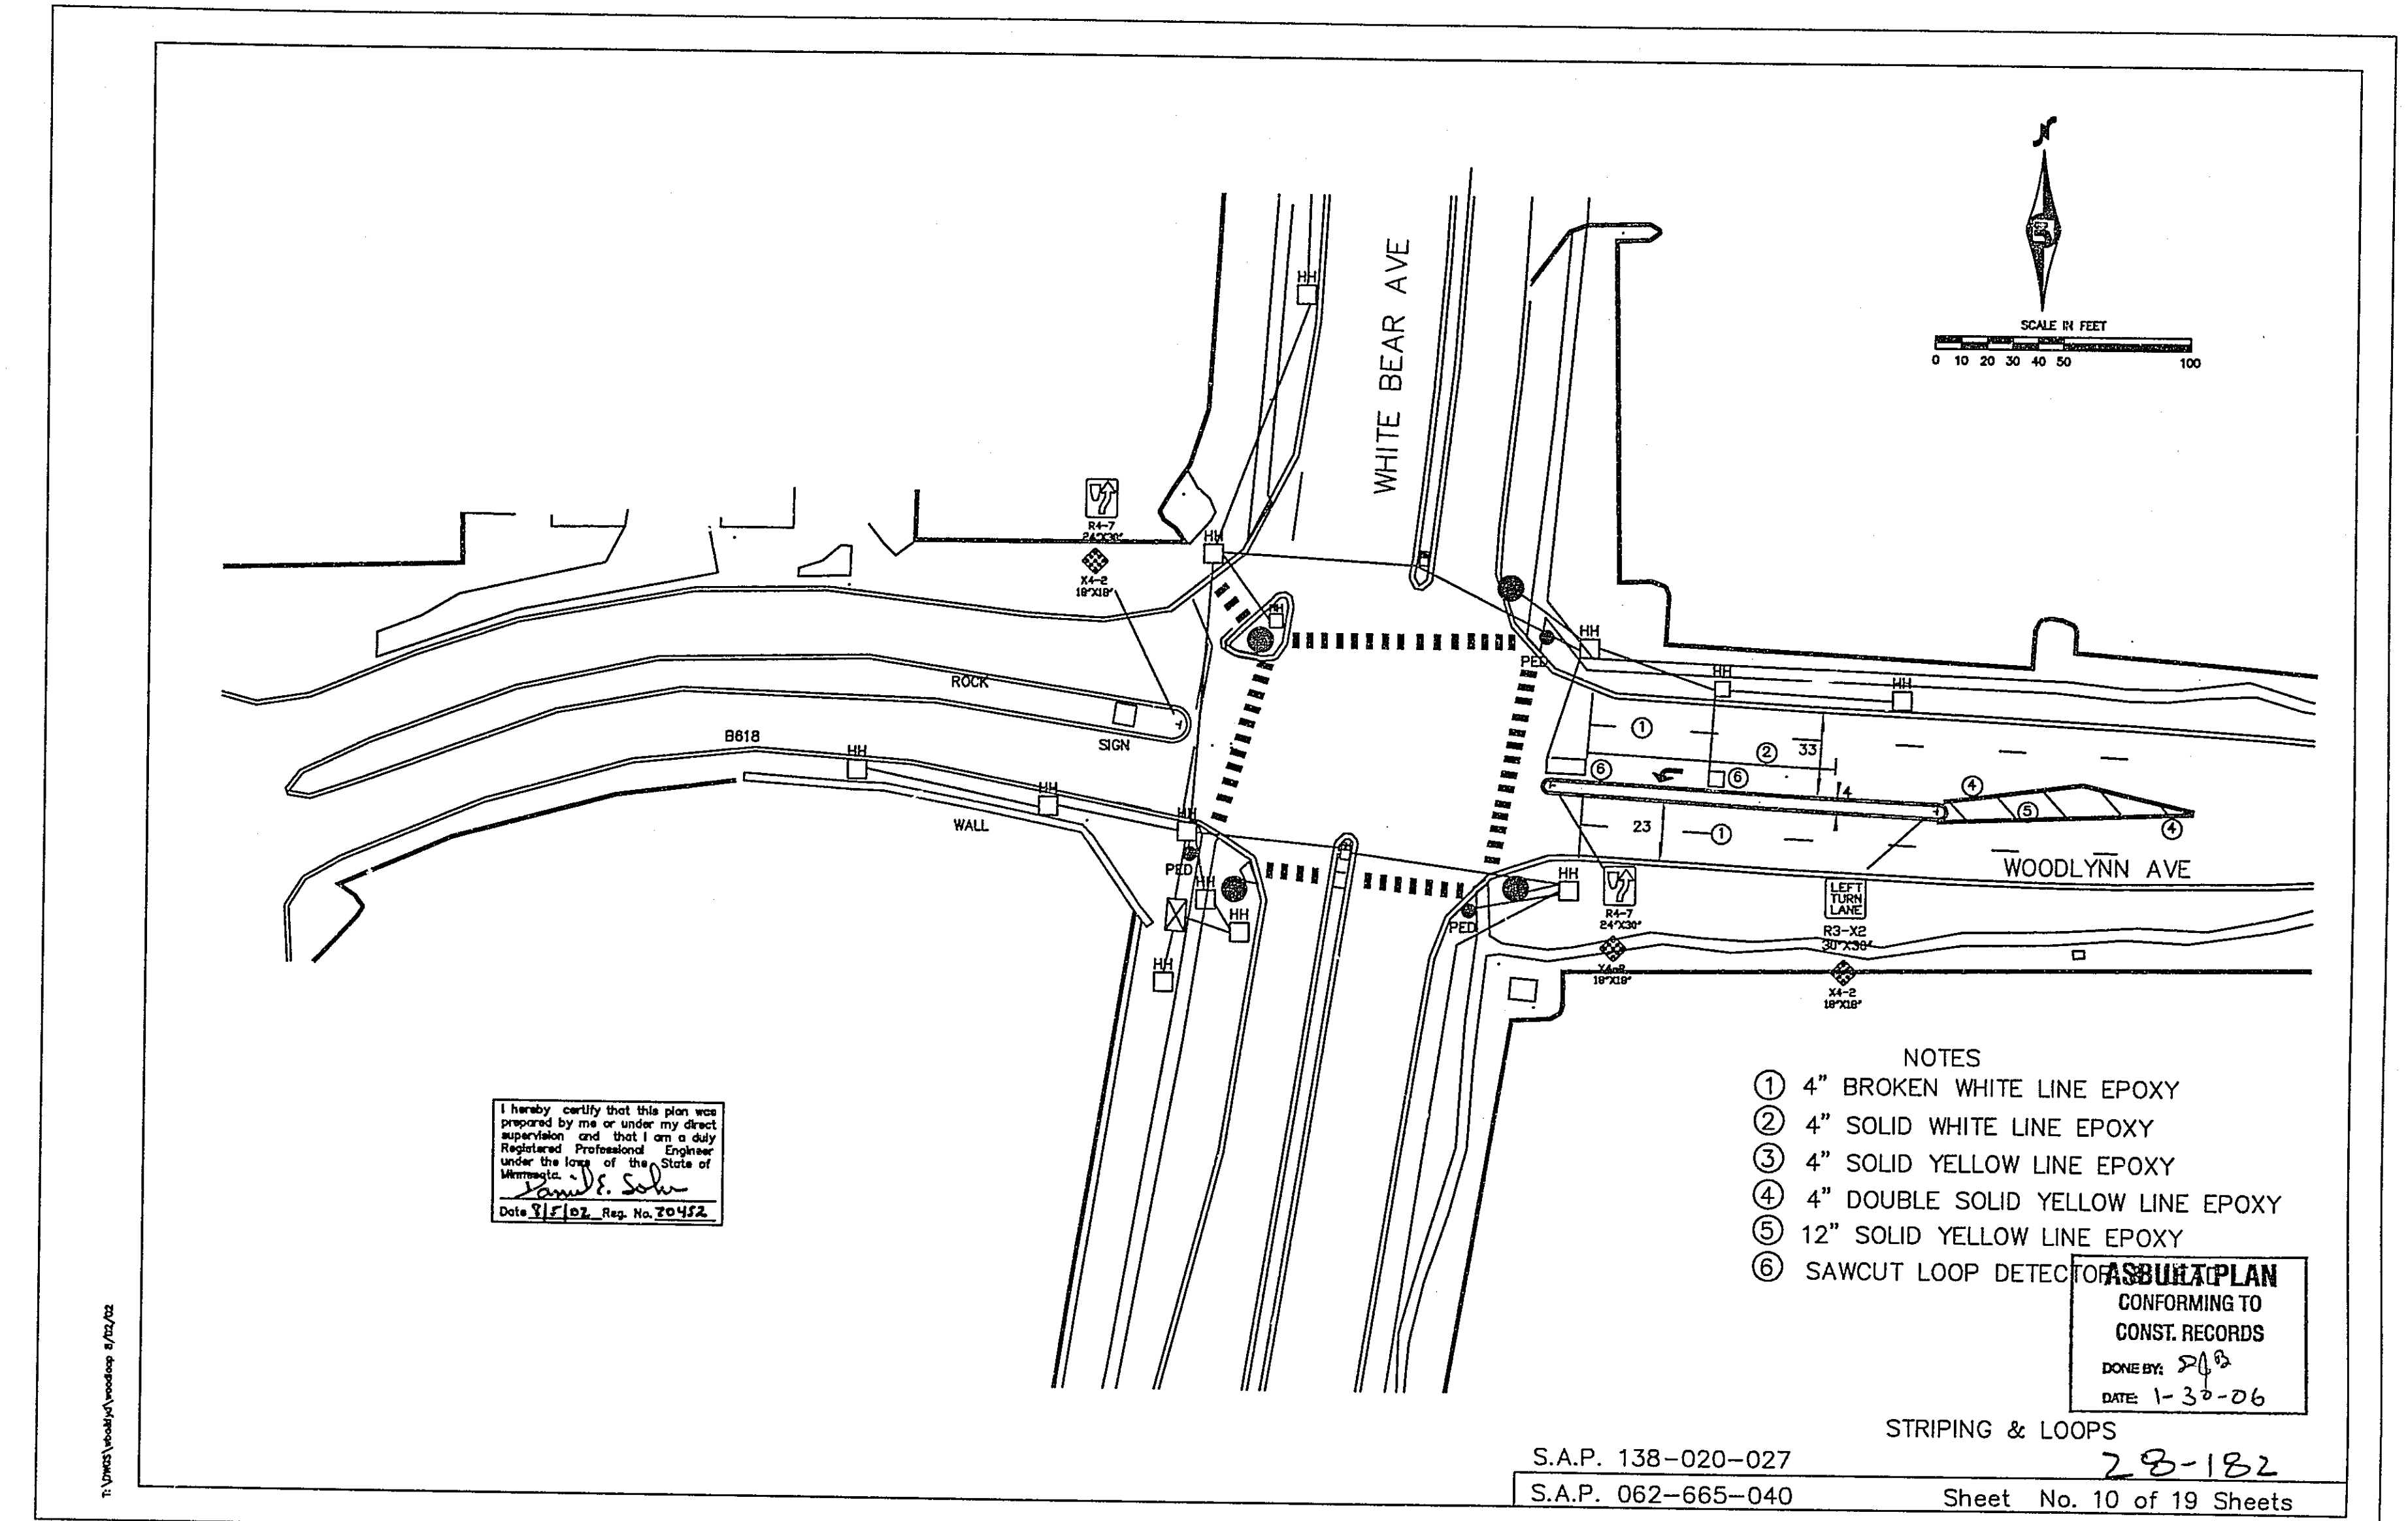
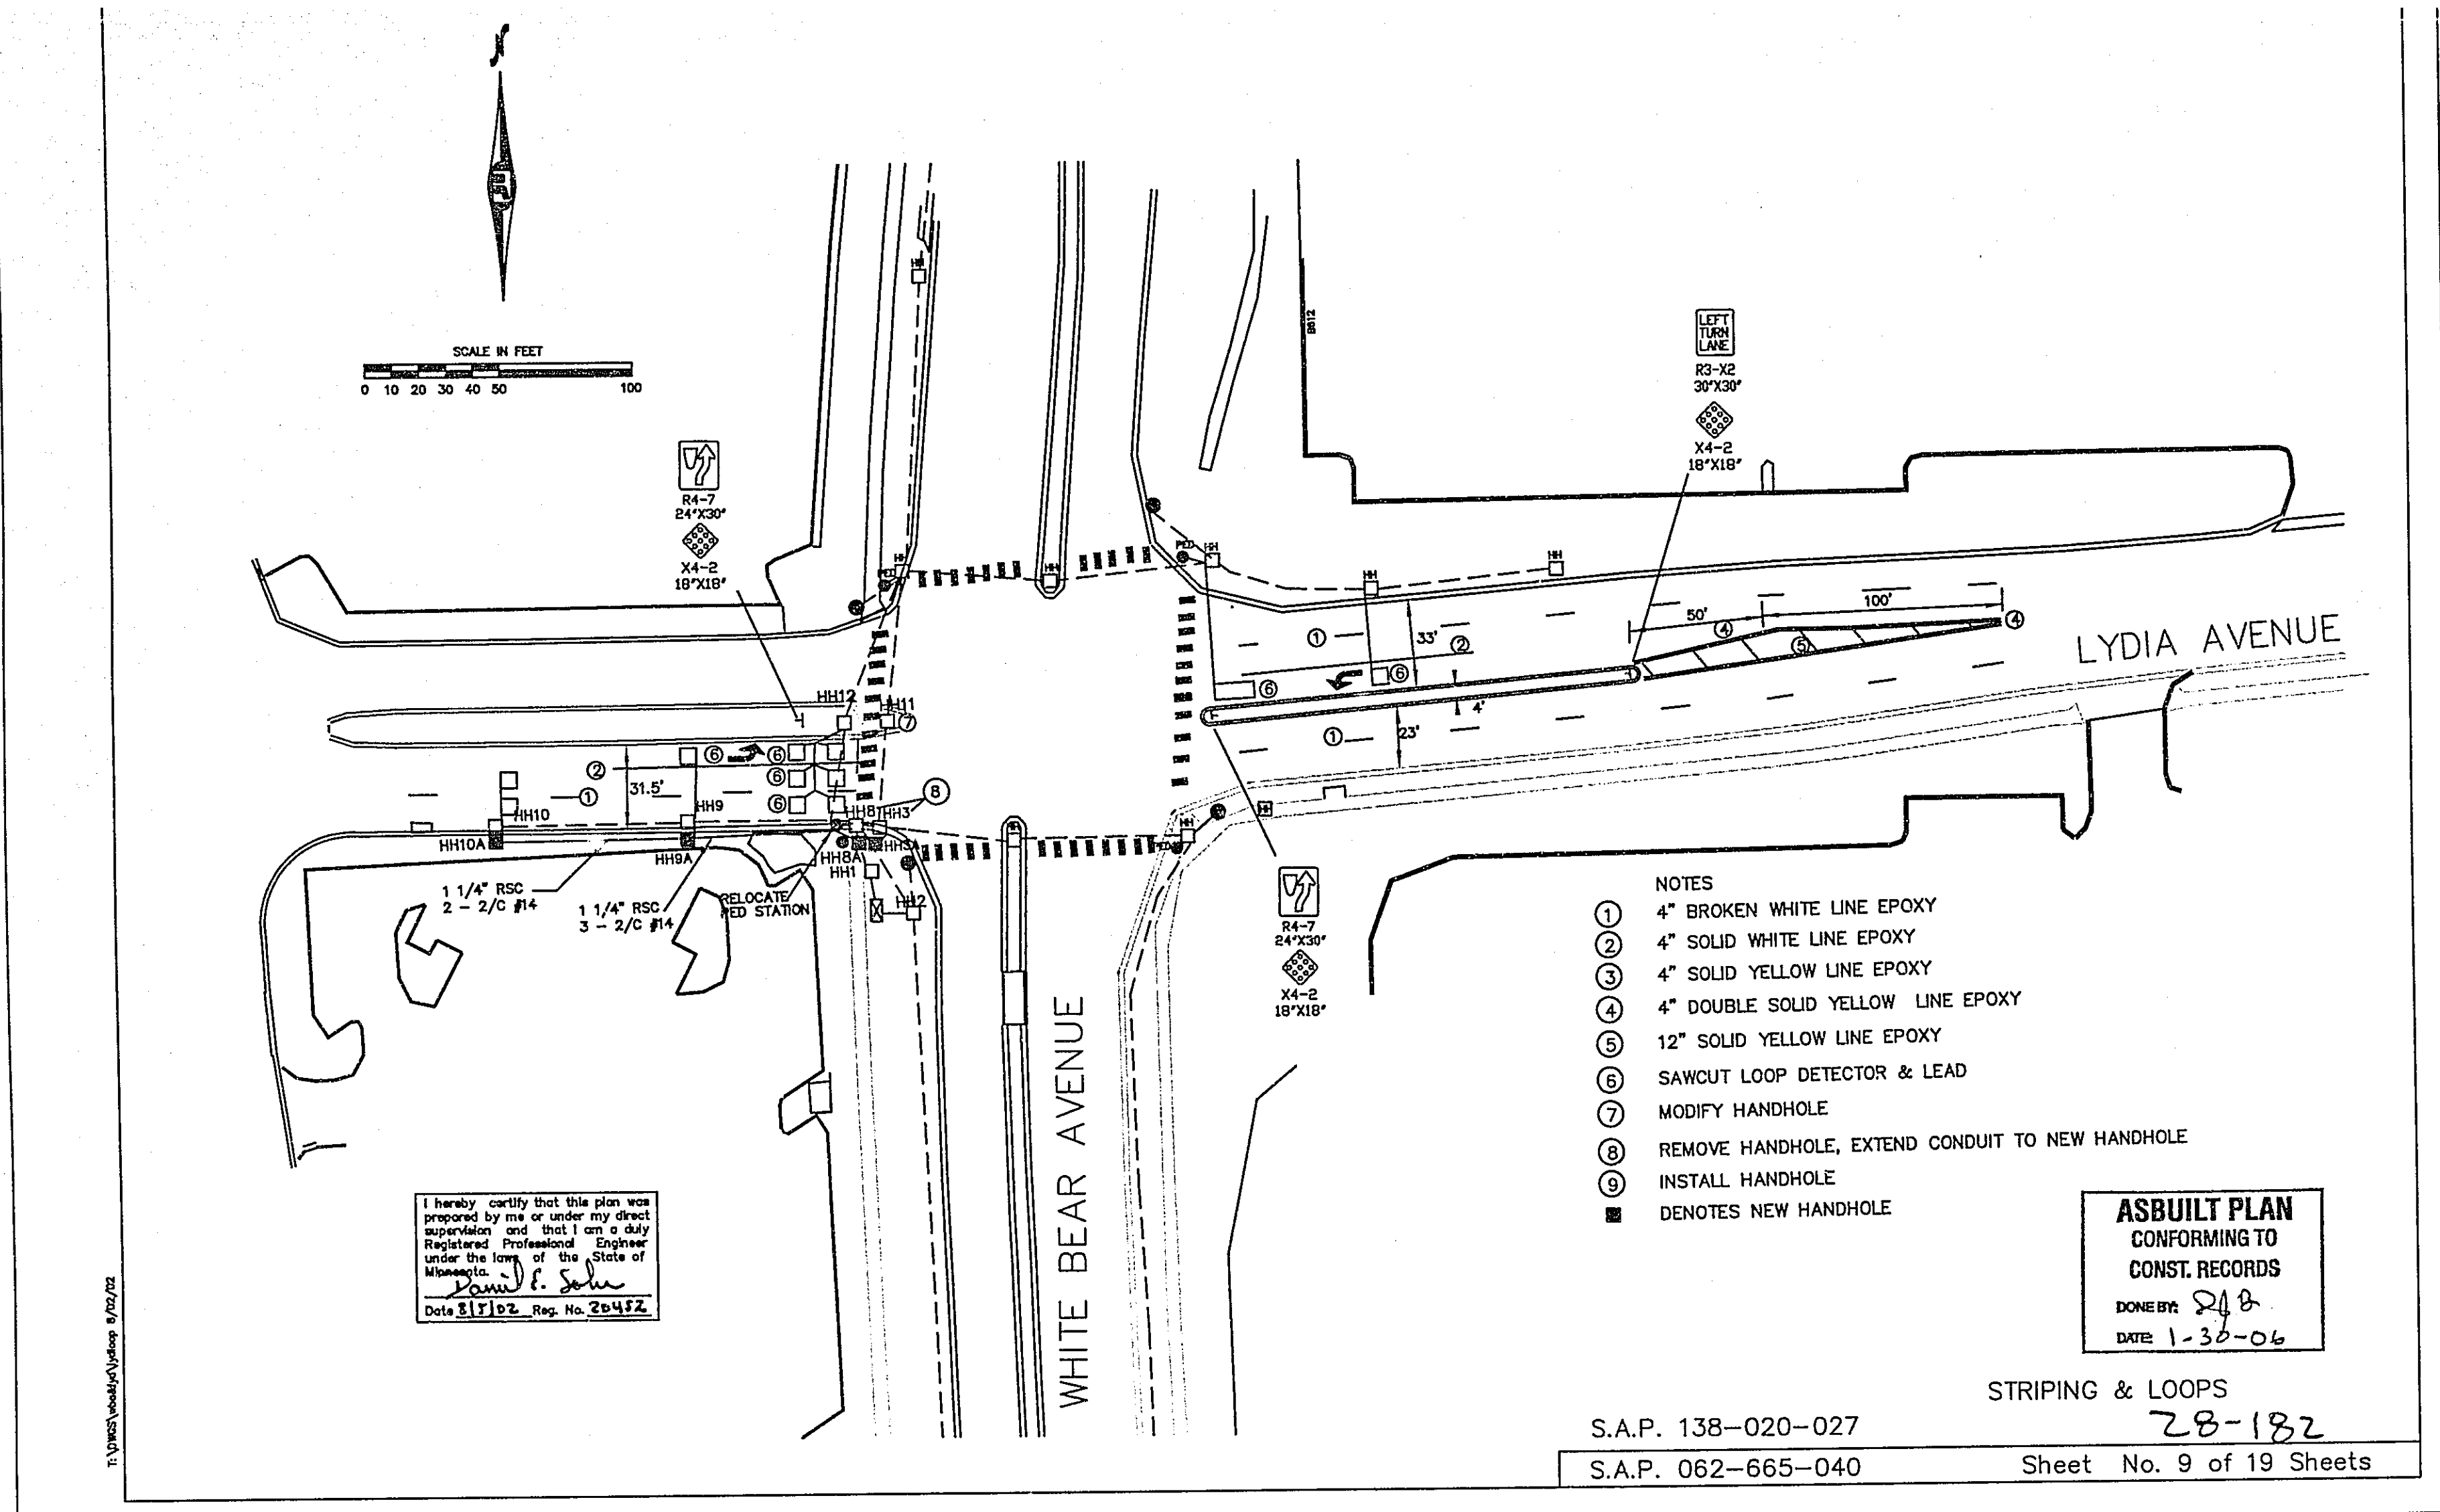


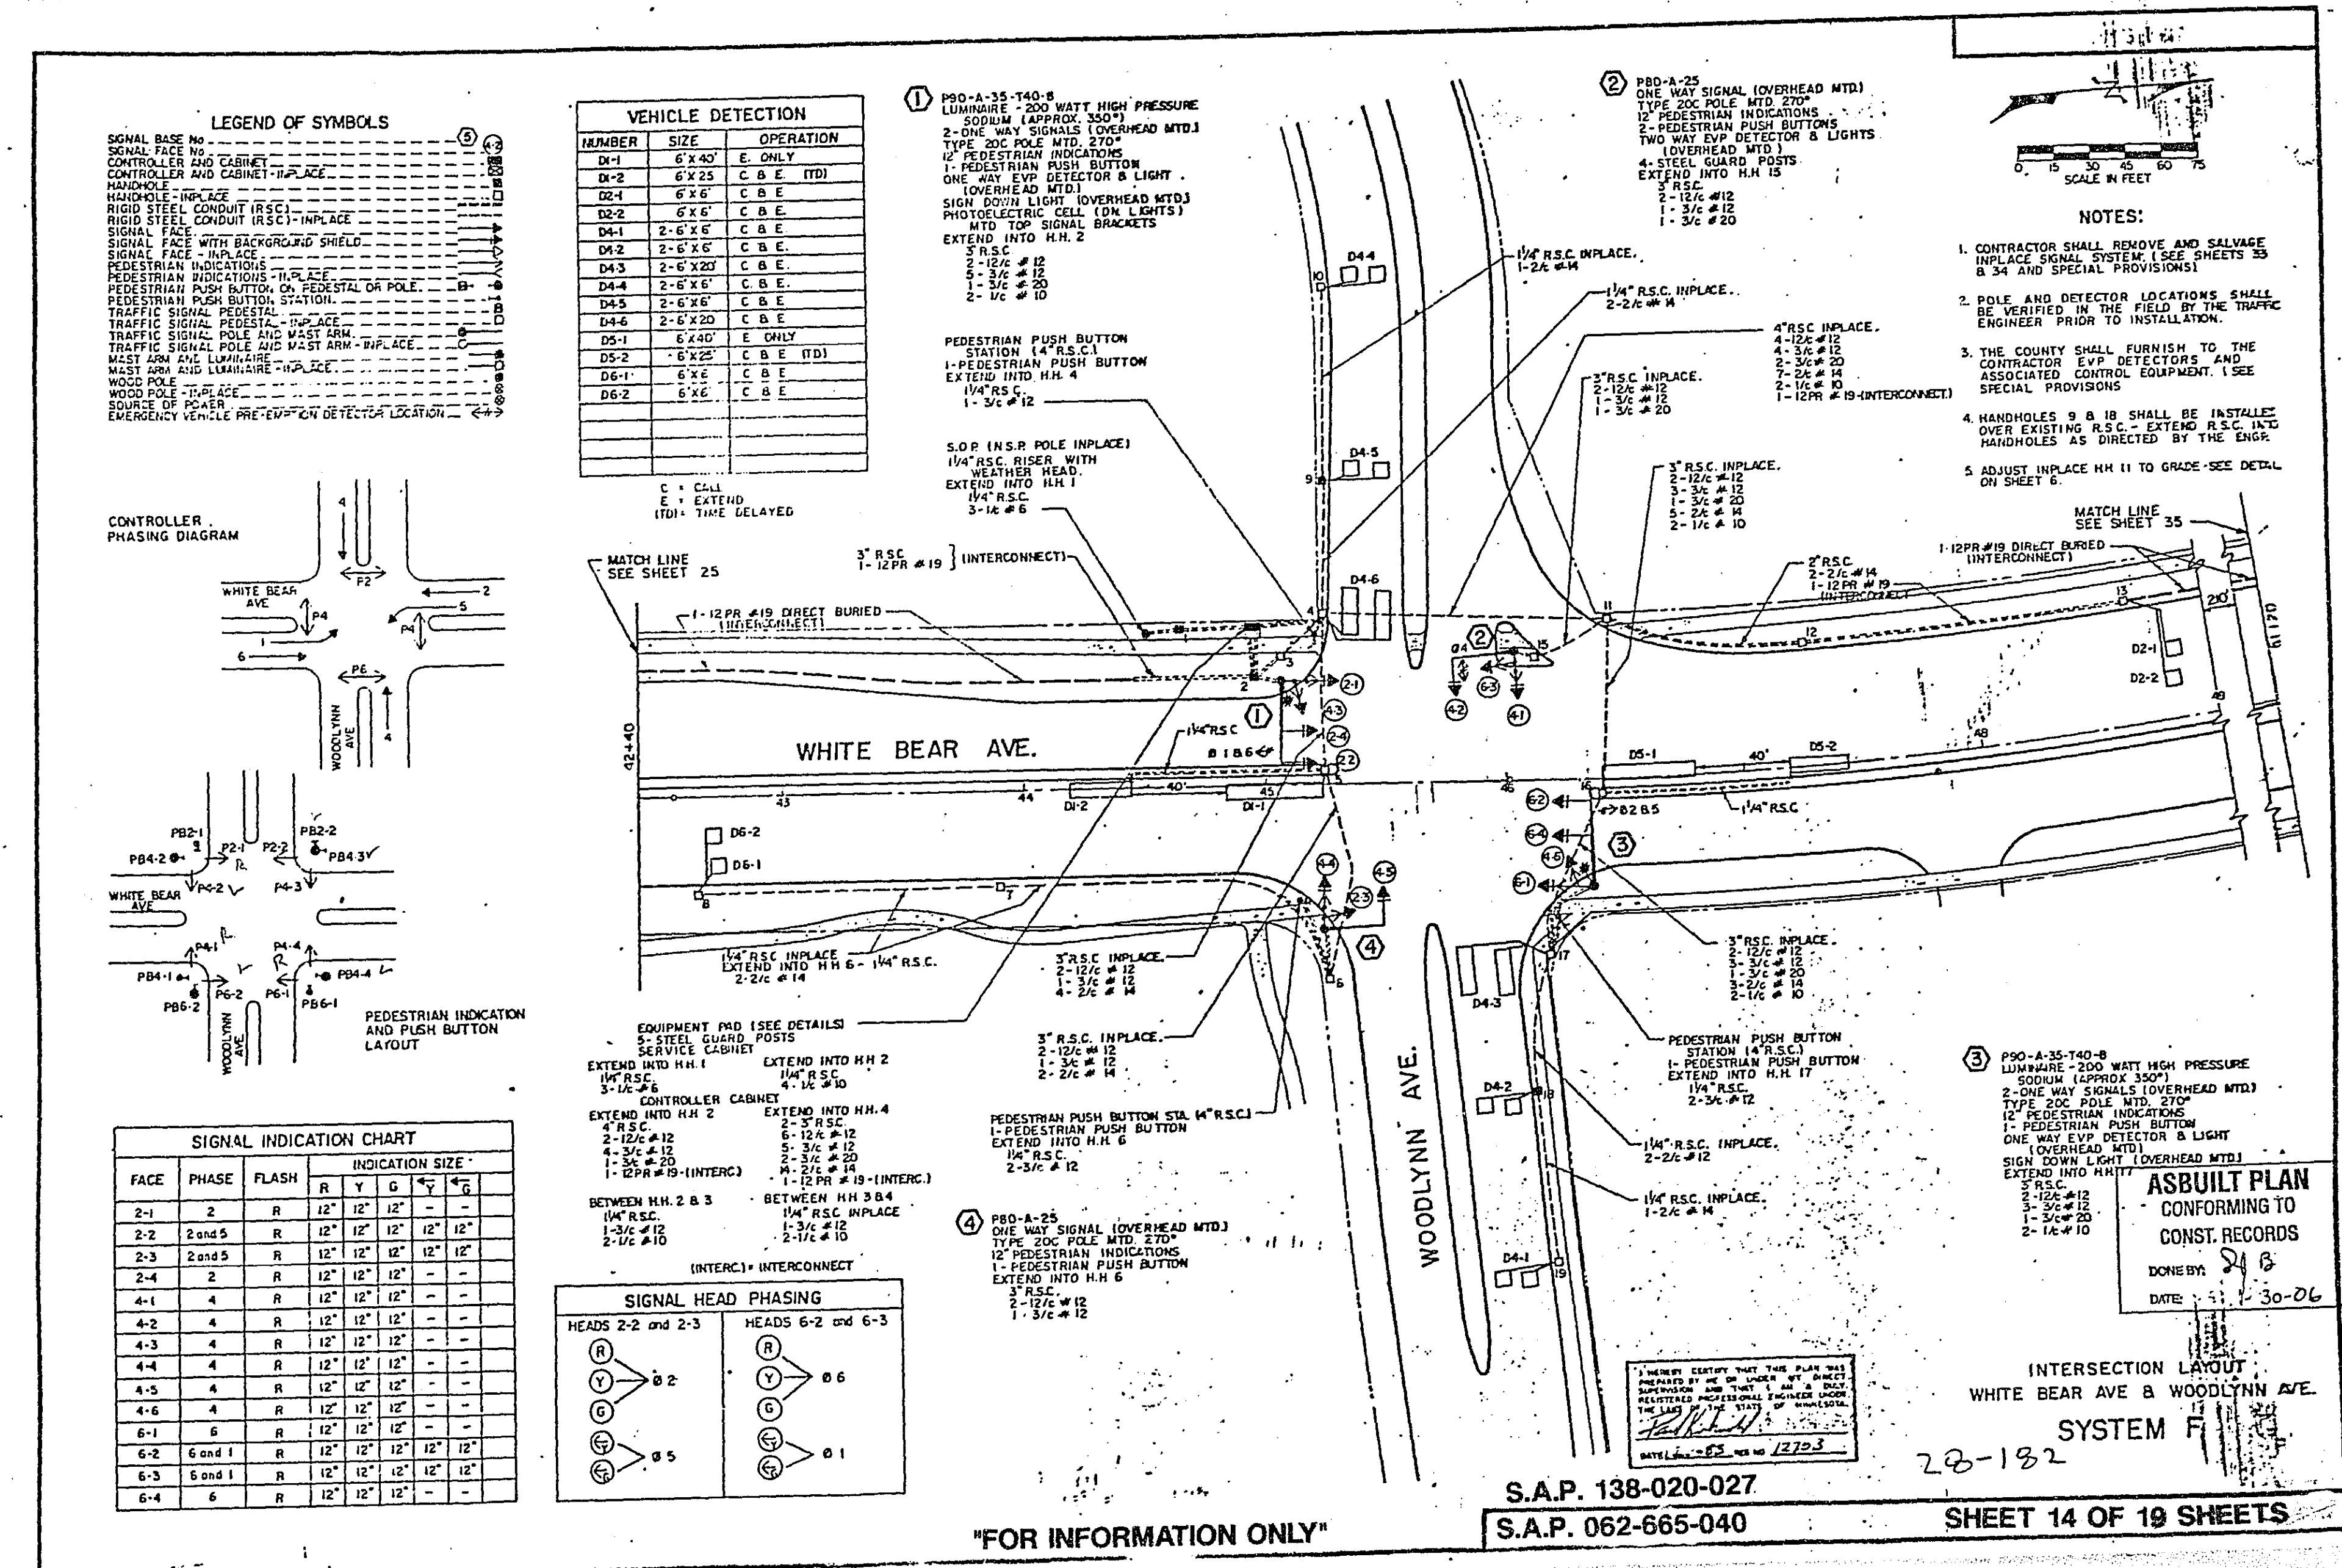

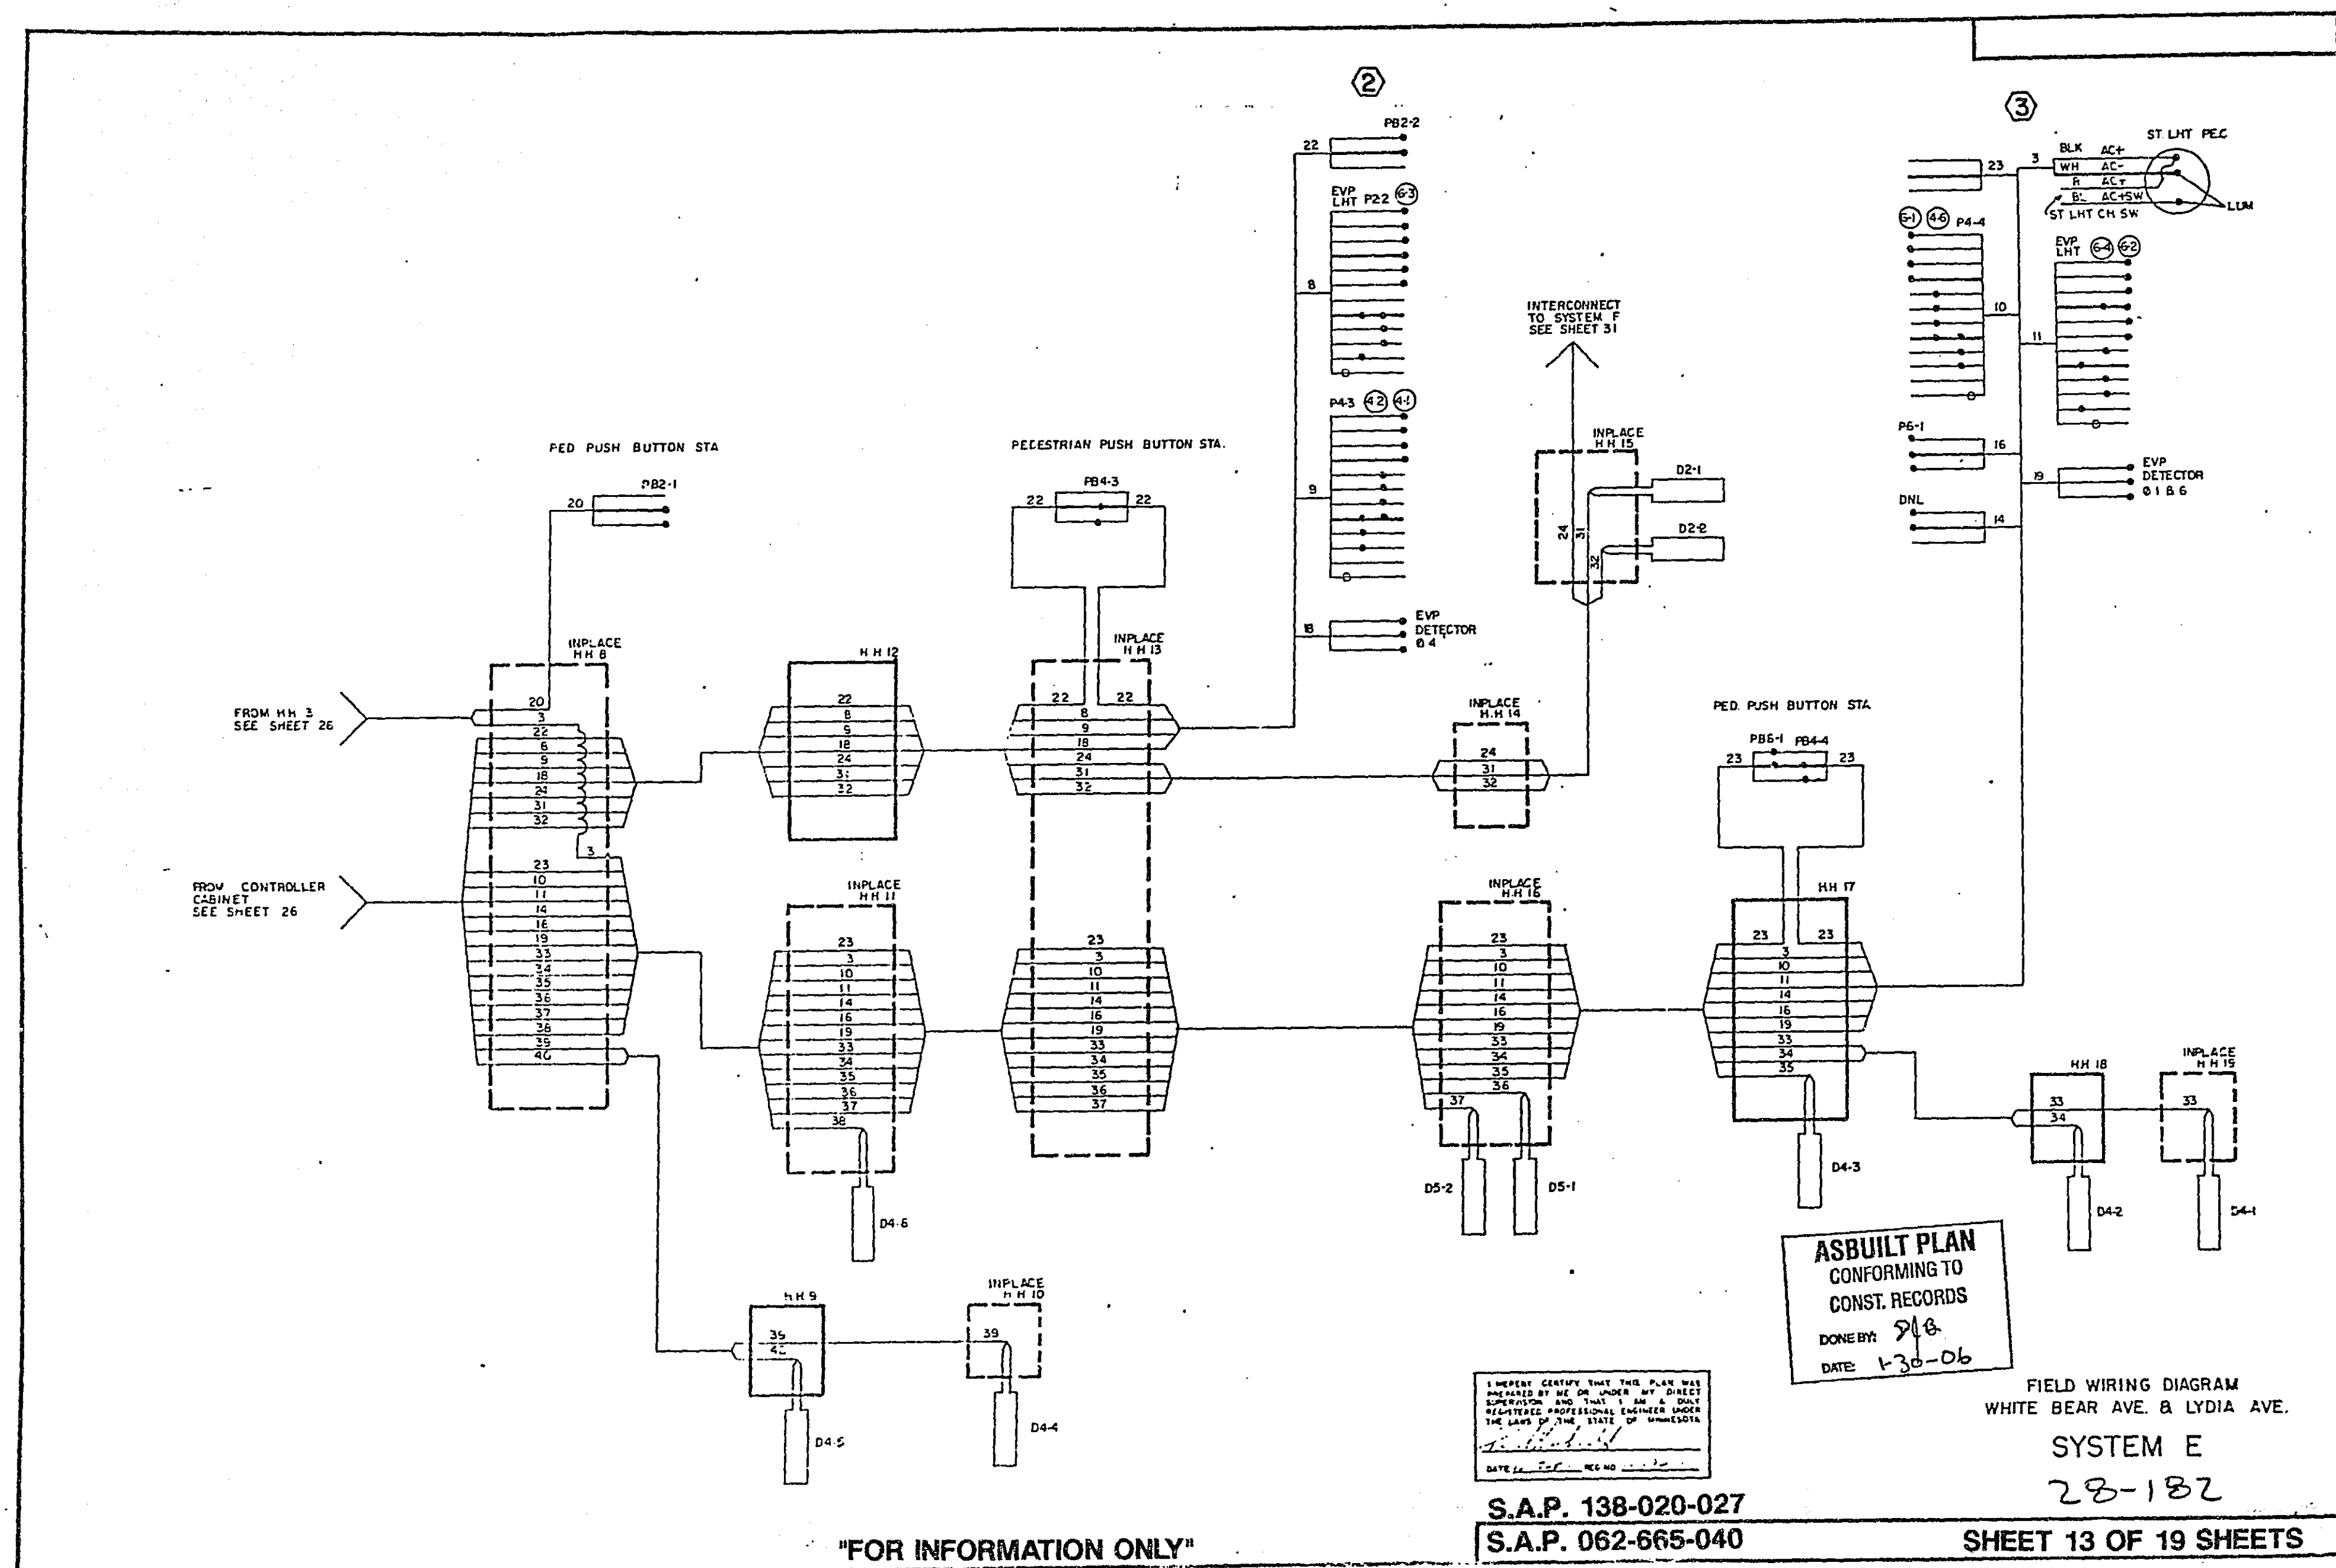

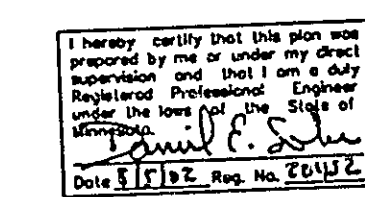

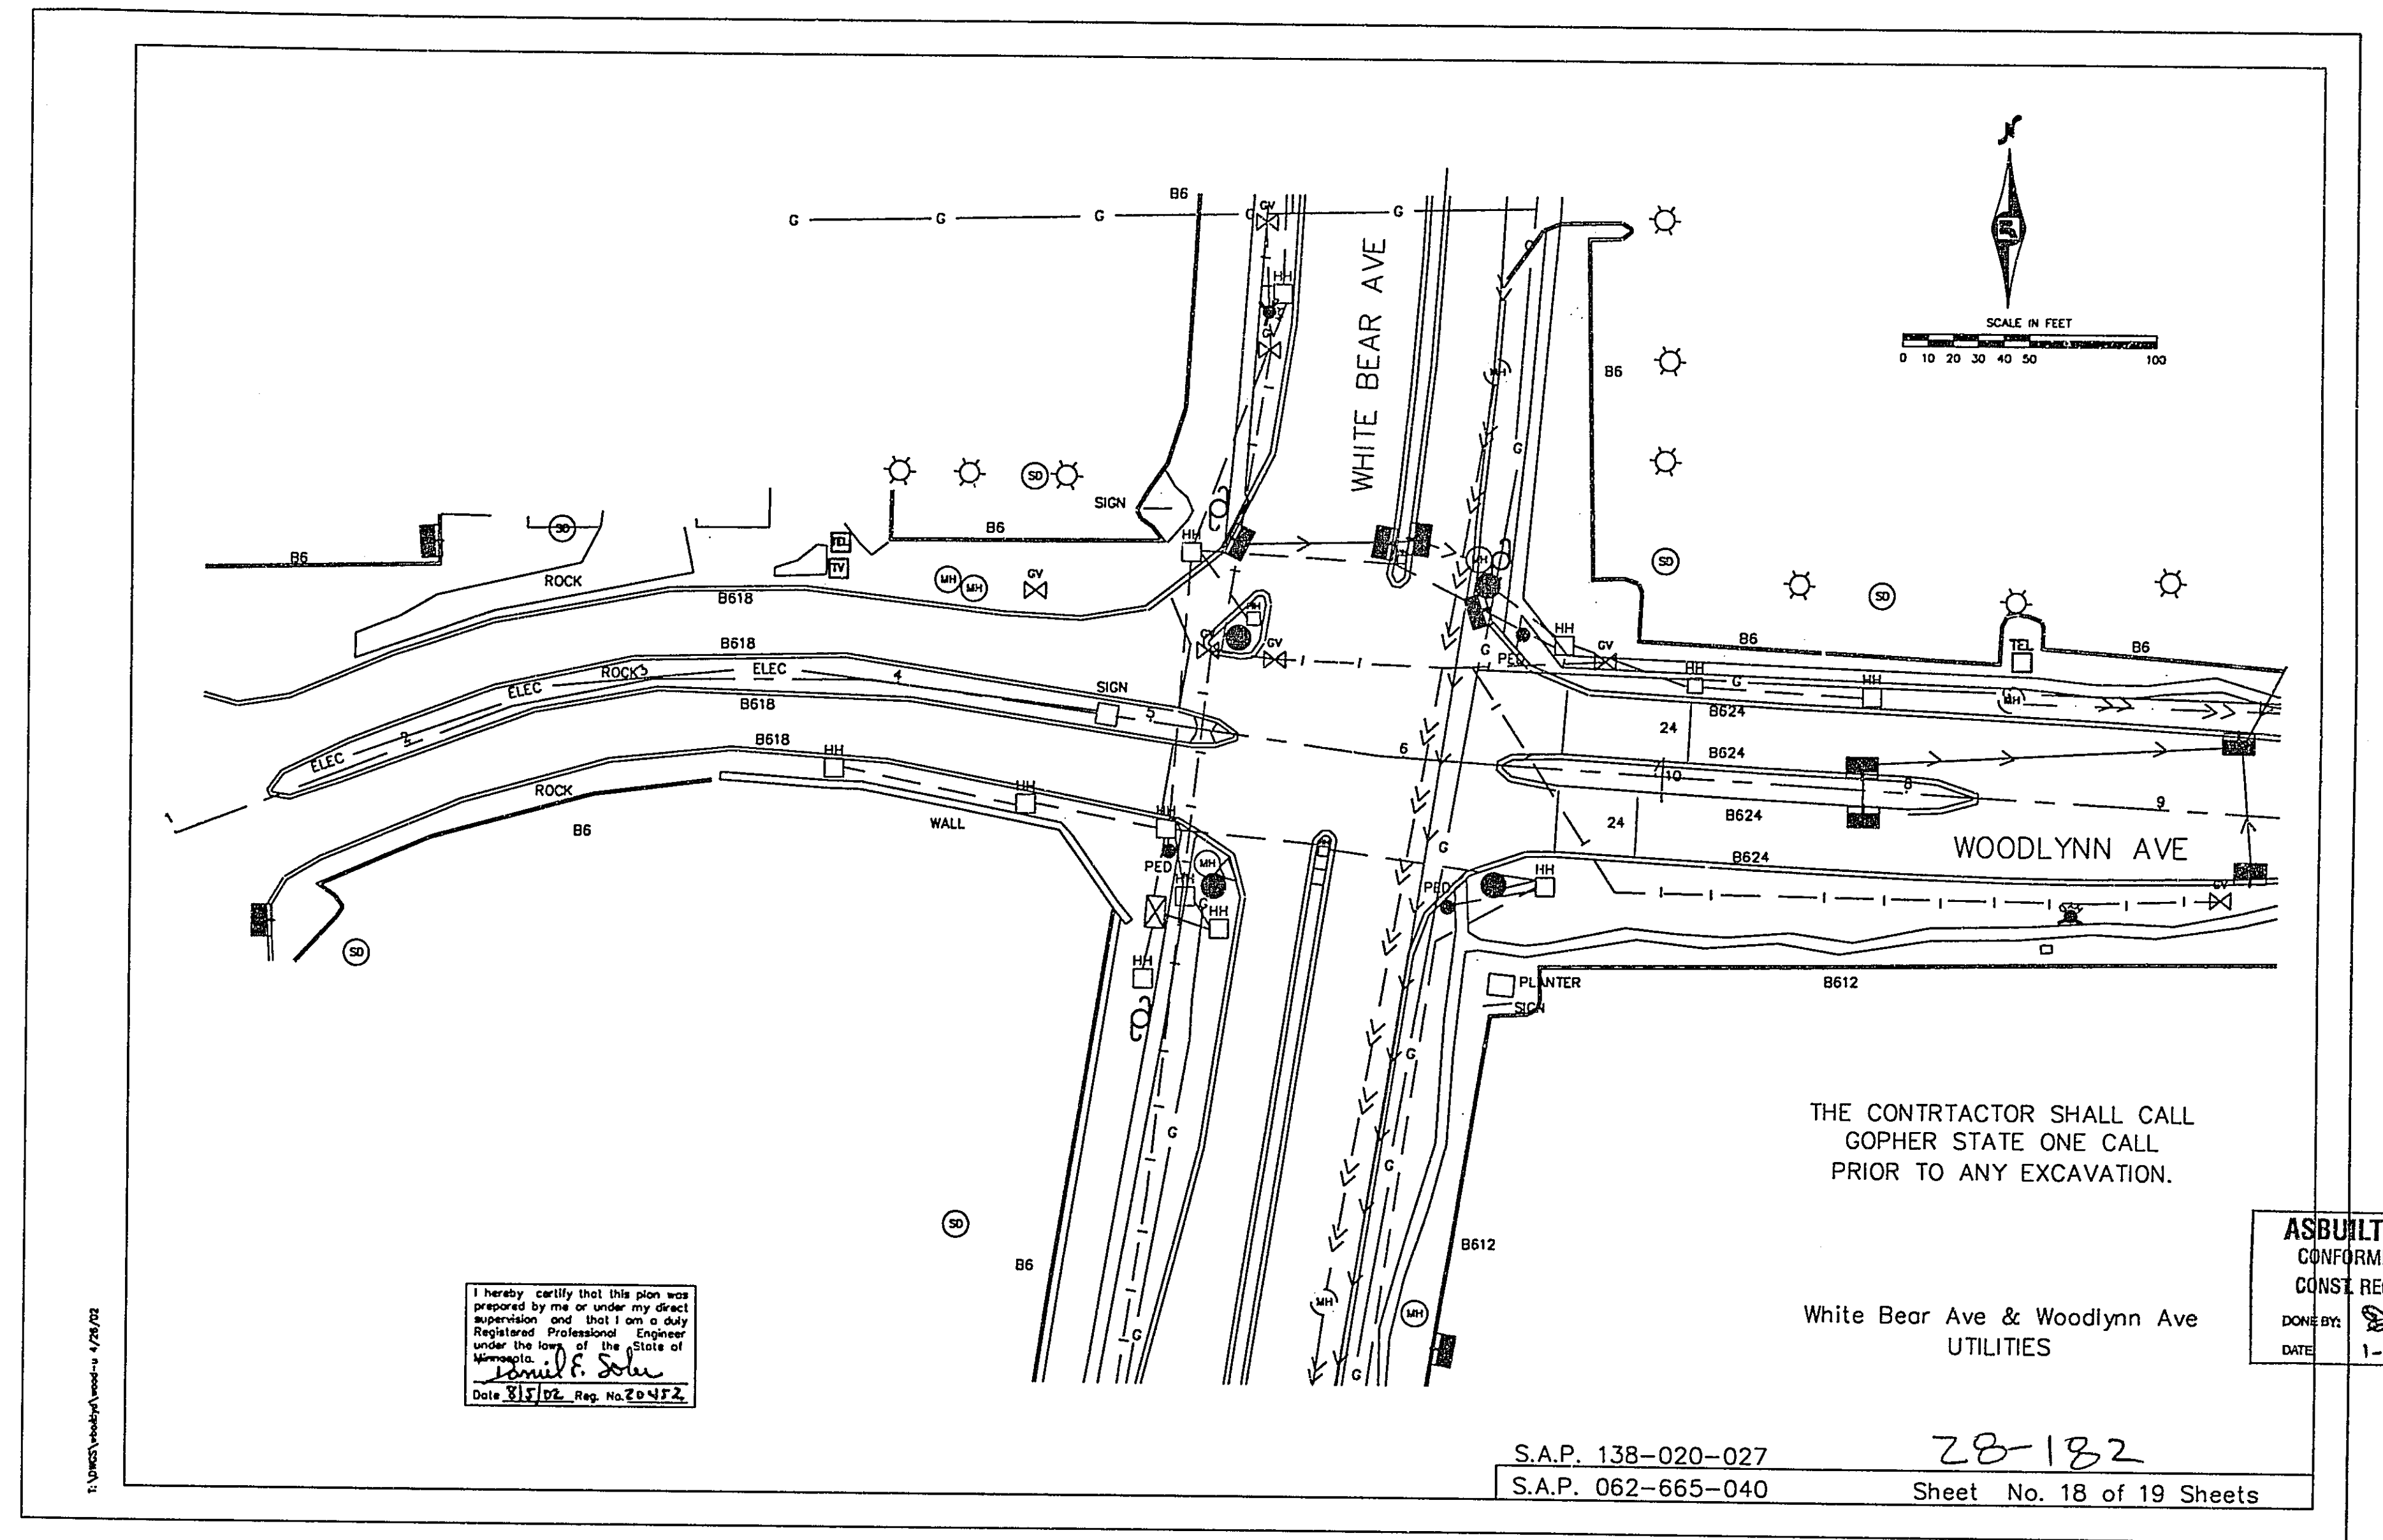

28-182
SHEET 19 OF 19 SHEETS