LINE TABLE						
LINE	LENGTH	BEARING	NORTHING	EASTING	NORTHING	EASTING
L1	126.04	N00°00'00"E	215600.655	551727.308	215726.694	551727.308
L2	8.47	S47°38'49"W	215860.624	551415.697	215854.917	551409.438
L3	62.41	N90°00'00"W	215776.619	551207.328	215776.619	551144.917

CURVE TABLE				
CURVE	LENGTH	RADIUS	DELTA ANGLE	TANGENT
C1	427.42	185.75	131°50'21"	415.63
C2	221.76	300.00	42°21'11"	116.22

GRAPHIC SCALE

50 0 25 50 100
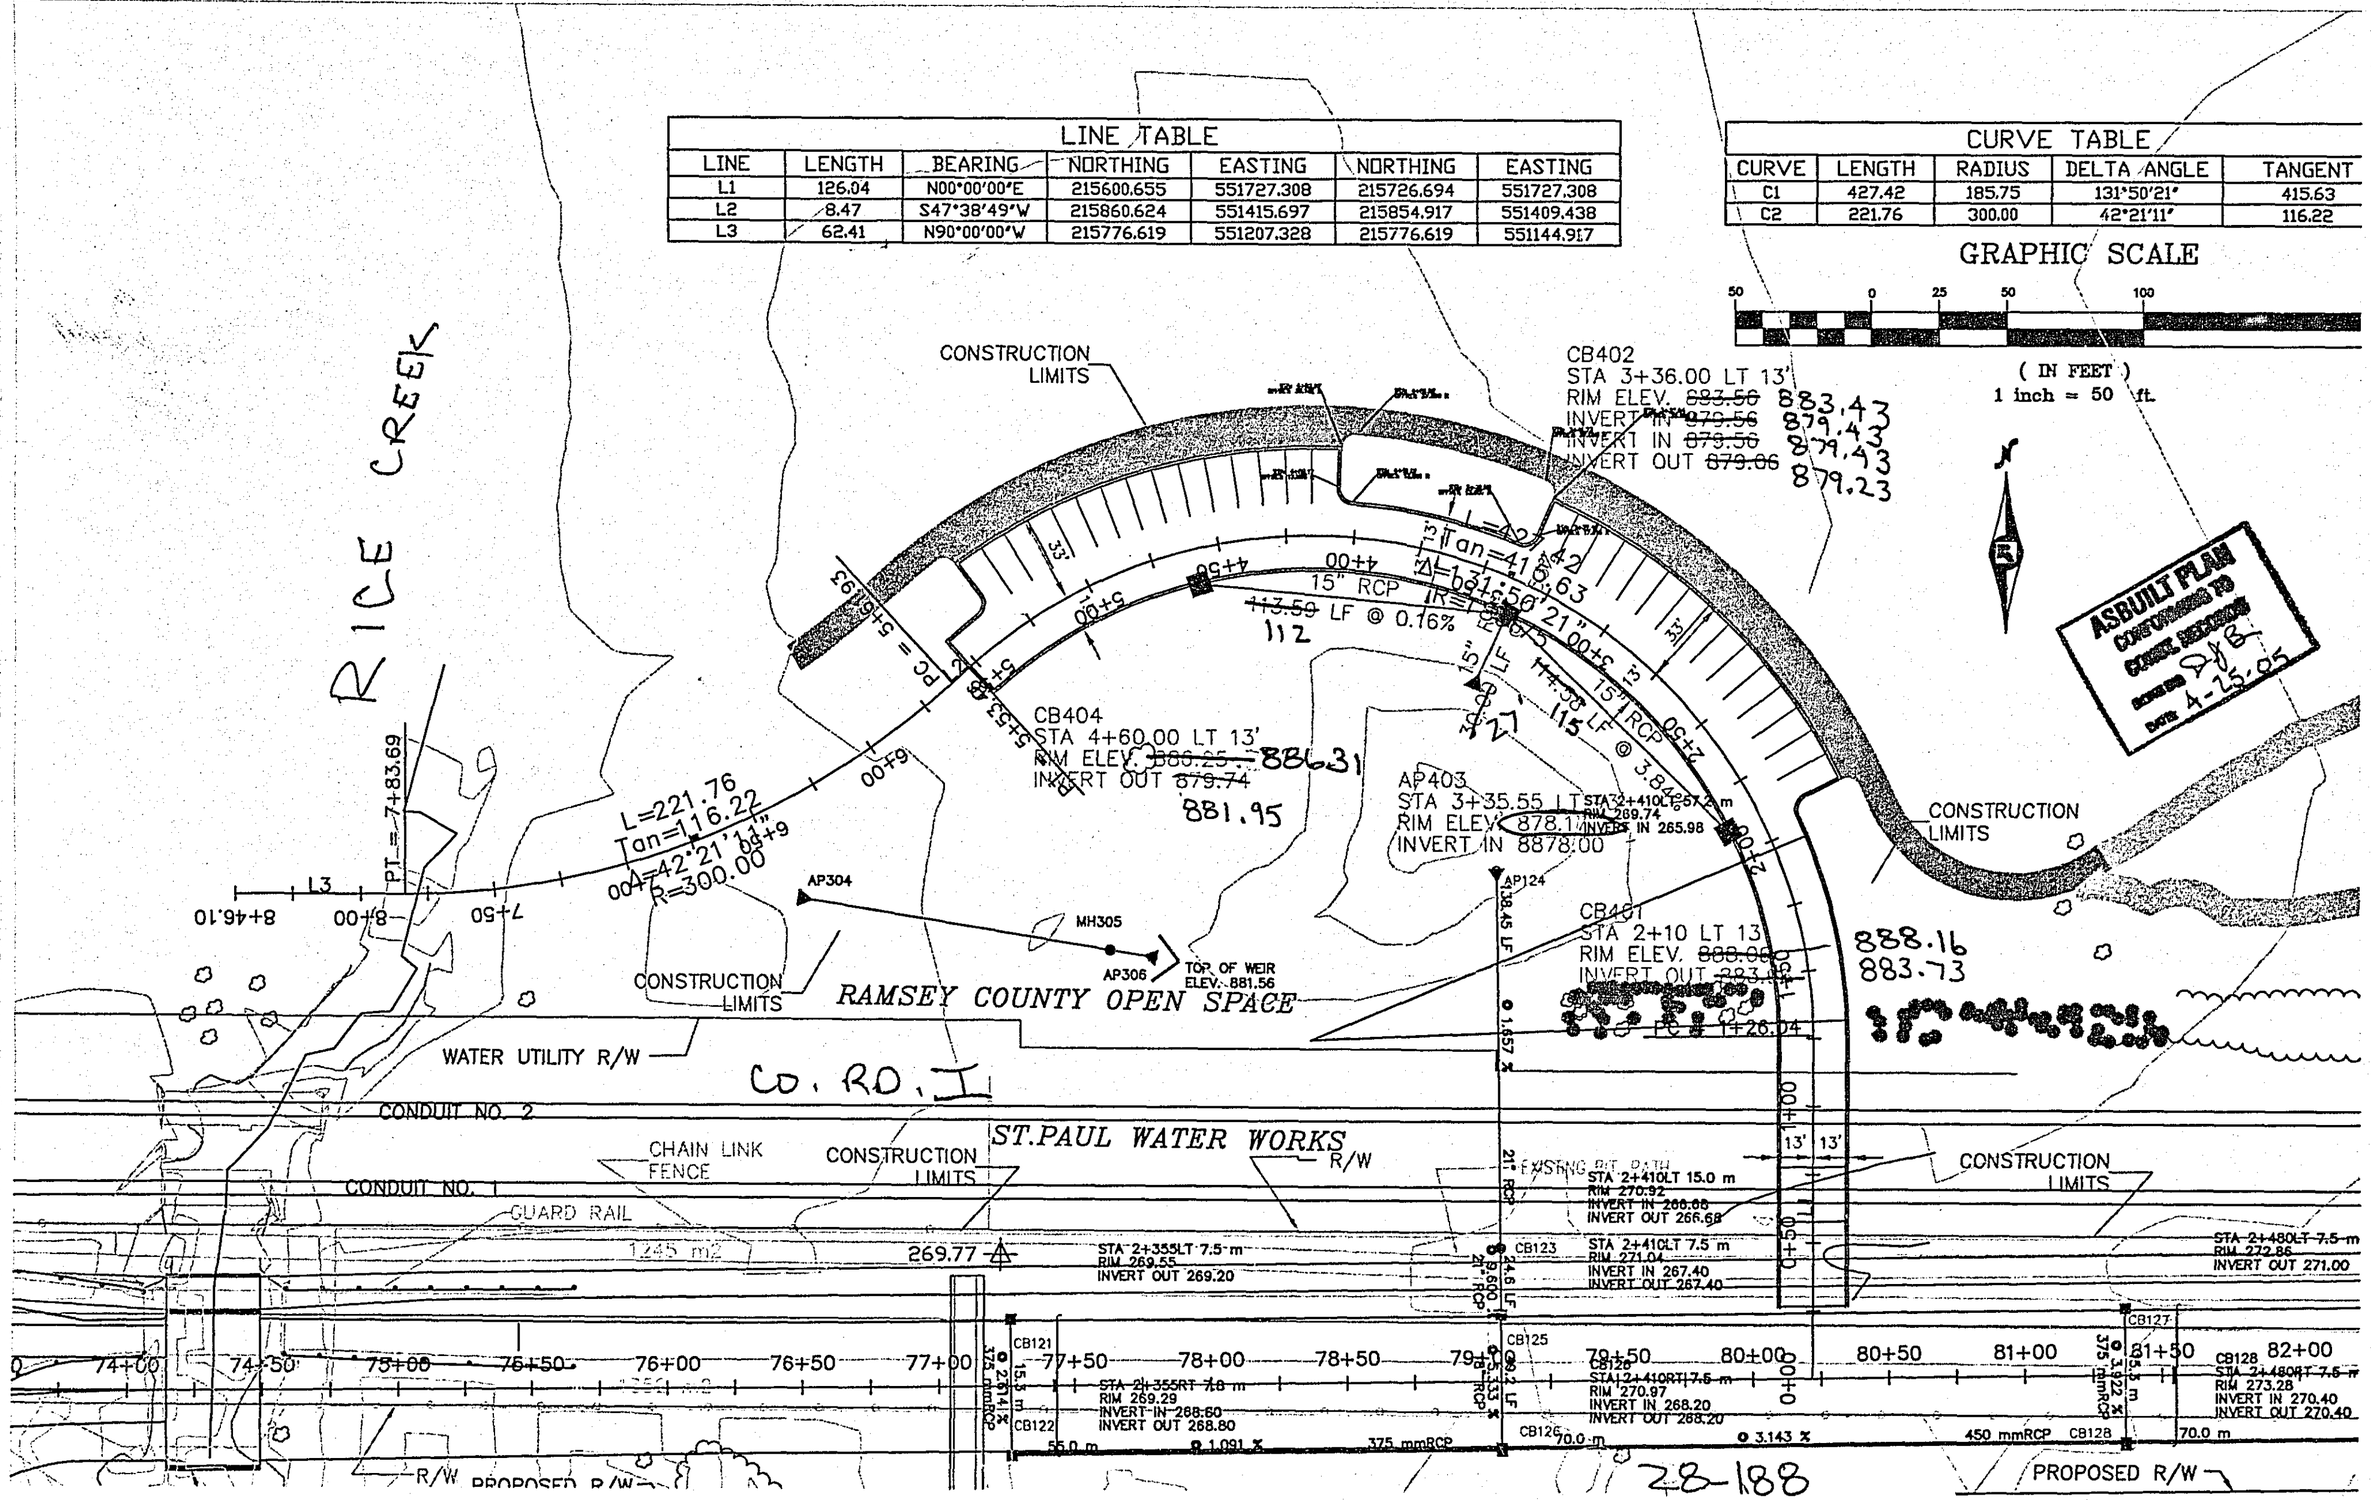
(IN FEET)
1 inch = 50 ft.