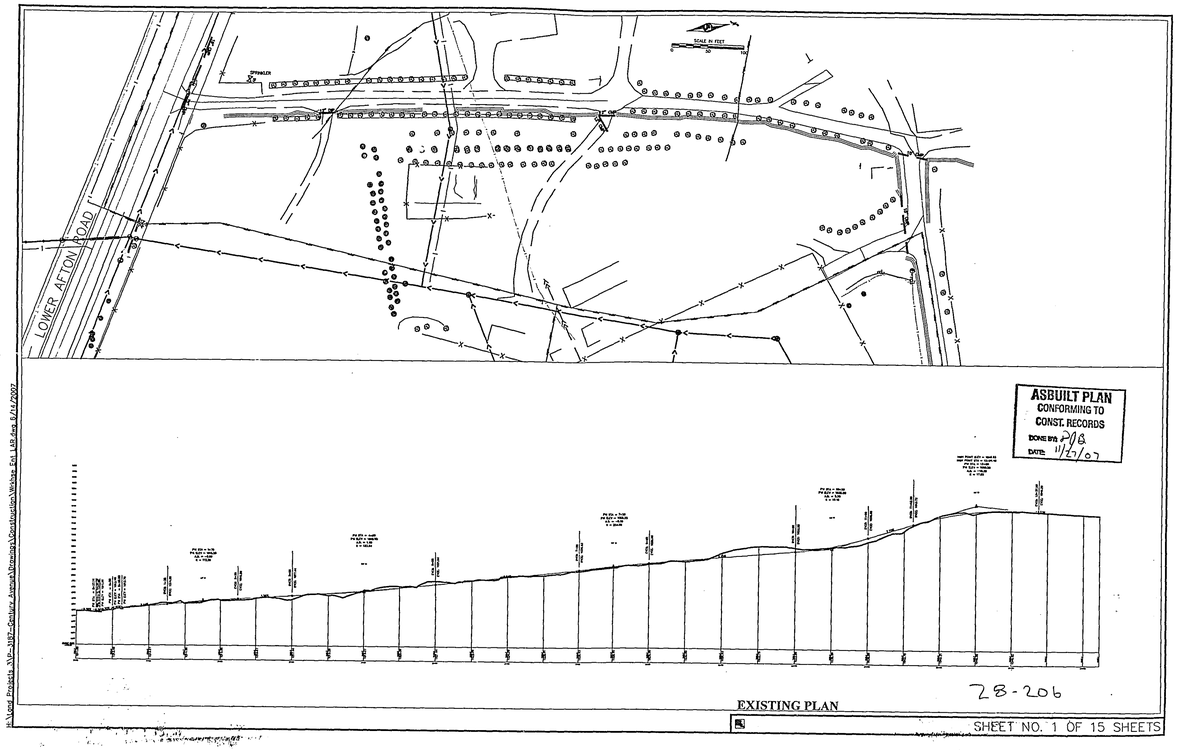

EXISTING PLAN

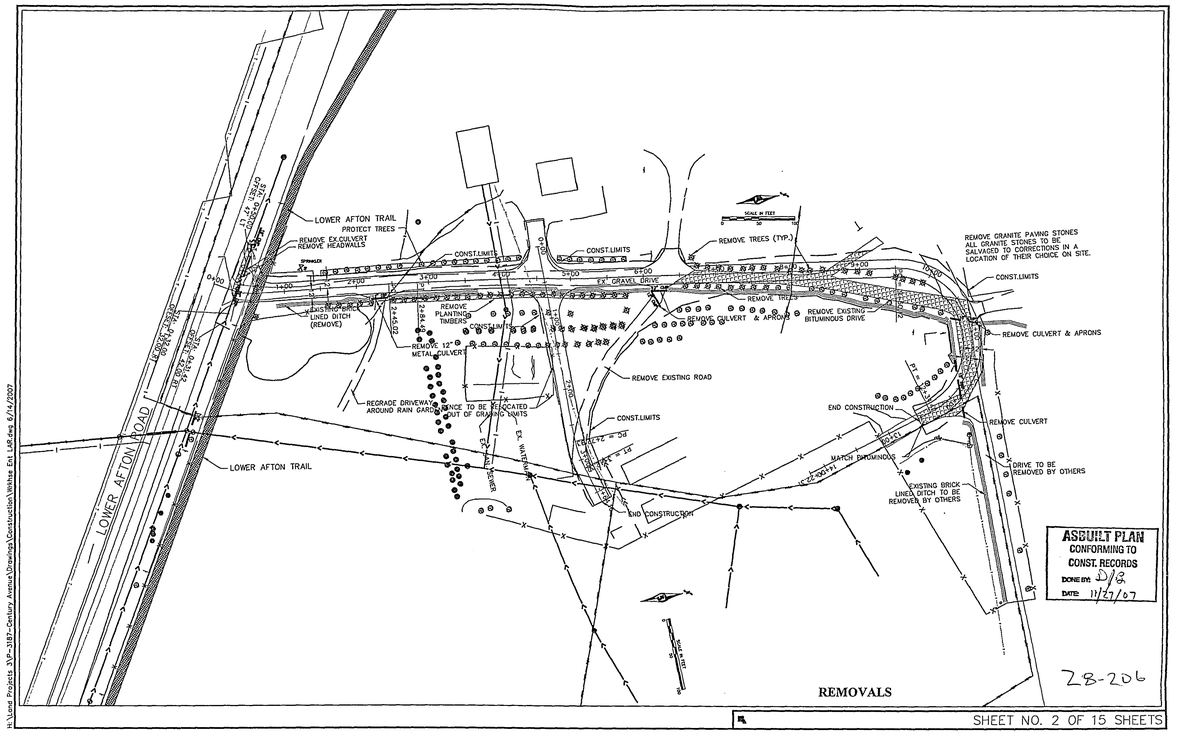

REMOVALS

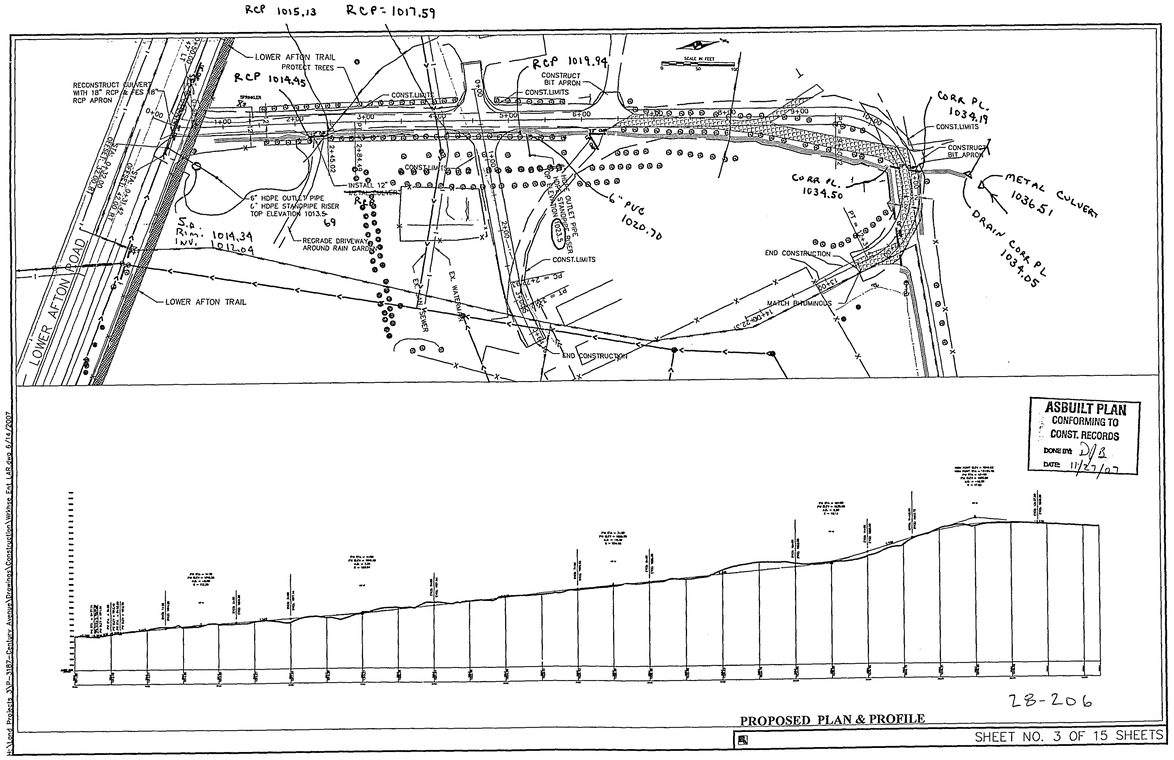

PROPOSED PLAN & PROFILE

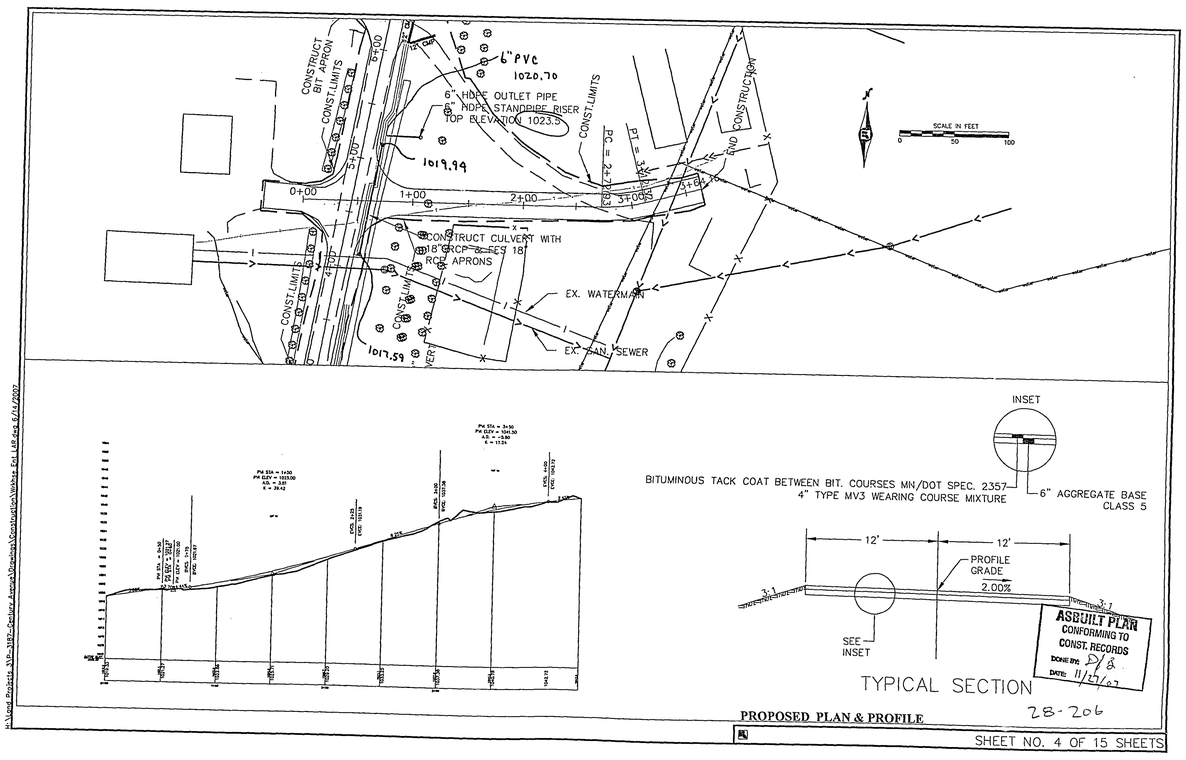

TYPICAL SECTION

PROPOSED PLAN & PROFILE

28-206

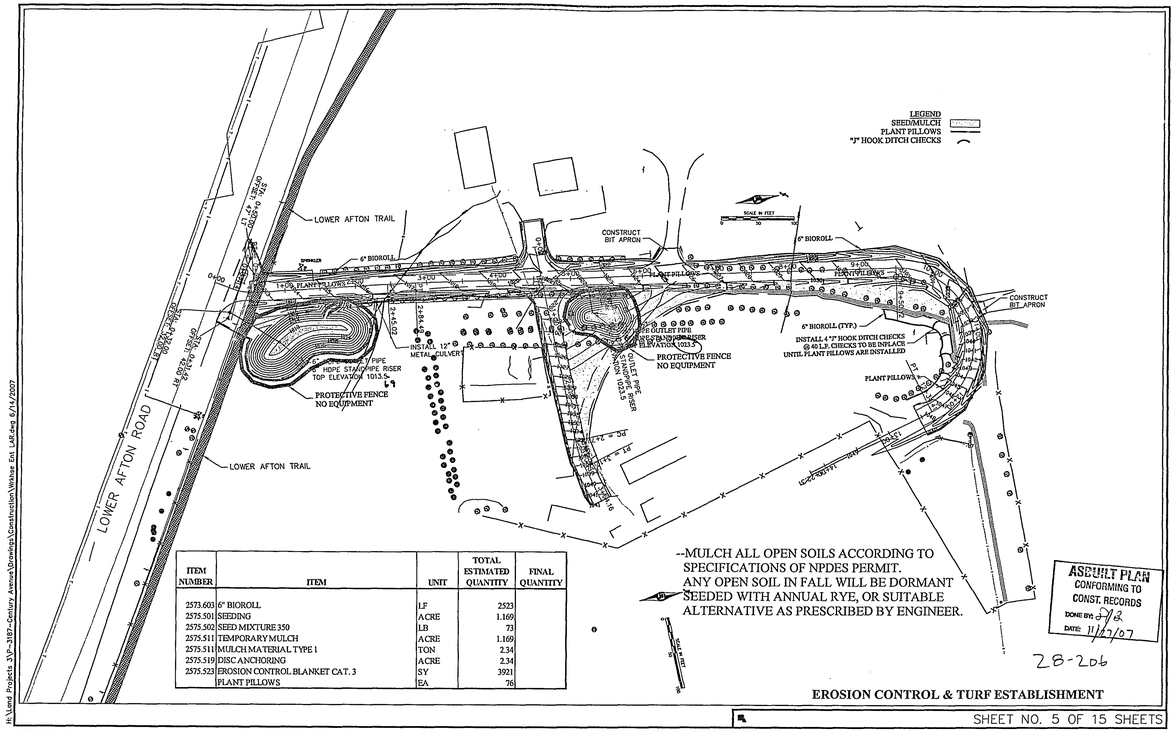

ITEM NUMBER	ITEM	UNIT	TOTAL ESTIMATED QUANTITY	FINAL QUANTITY
2573.603	6" BIOROLL	LF	2523	
2575.501	SEEDING	ACRE	1.169	
2575.502	SEED MIXTURE 350	LB	73	
2575.511	TEMPORARY MULCH	ACRE	1.169	
2575.511	MULCH MATERIAL TYPE I	TON	2.34	
2575.519	DISC ANCHORING	ACRE	2.34	
2575.523	EROSION CONTROL BLANKET CAT. 3	SY	3921	
	PLANT PILLOWS	EA	76	

--MULCH ALL OPEN SOILS ACCORDING TO SPECIFICATIONS OF NPDES PERMIT. ANY OPEN SOIL IN FALL WILL BE DORMANT SEEDED WITH ANNUAL RYE, OR SUITABLE ALTERNATIVE AS PRESCRIBED BY ENGINEER.

ASBUILT PLAN
CONFORMING TO CONST. RECORDS
DONE BY: DJS
DATE: 11/27/07

28-206

EROSION CONTROL & TURF ESTABLISHMENT

H:\Land Projects 3YP-2187-Century Avenue\Drawings\Construction\Wikkse Ext LAR.dwg 6/13/2007

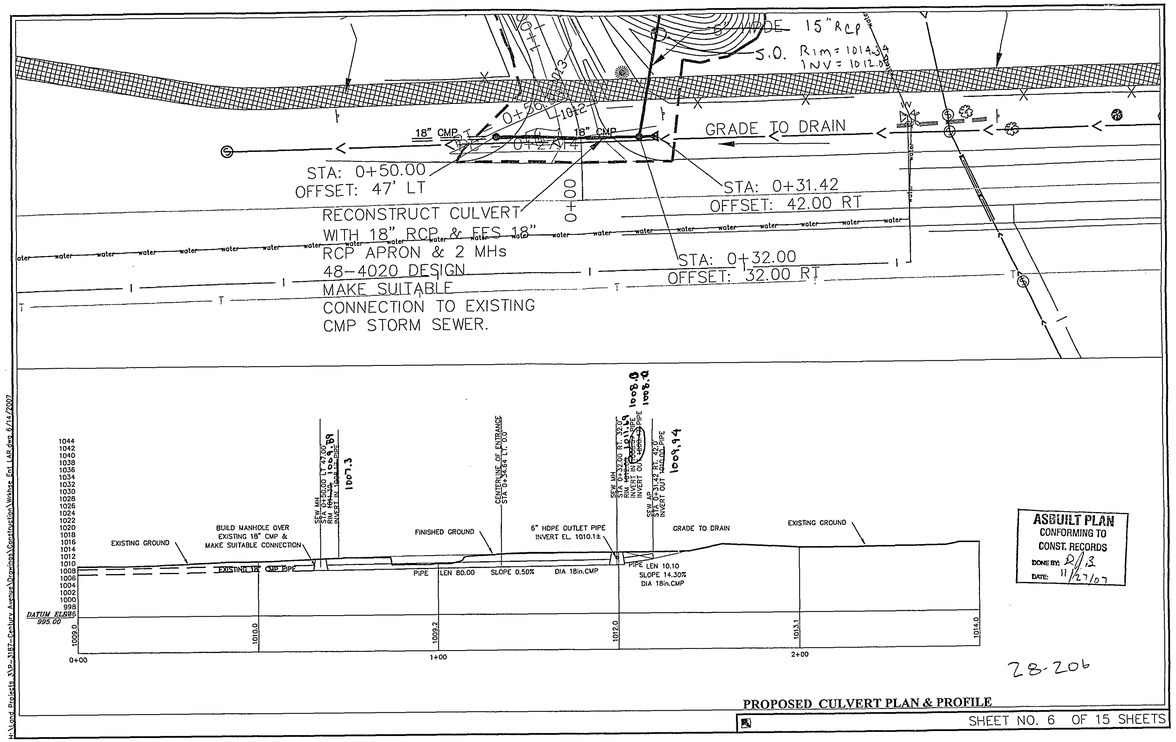

ASBUILT PLAN
CONFORMING TO CONST. RECORDS
DONE BY: DJS
DATE: 11/27/07

28-206

PROPOSED CULVERT PLAN & PROFILE

H:\Land Projects 3YP-2187-Century Avenue\Drawings\Construction\Wikkse Ext LAR.dwg 6/13/2007

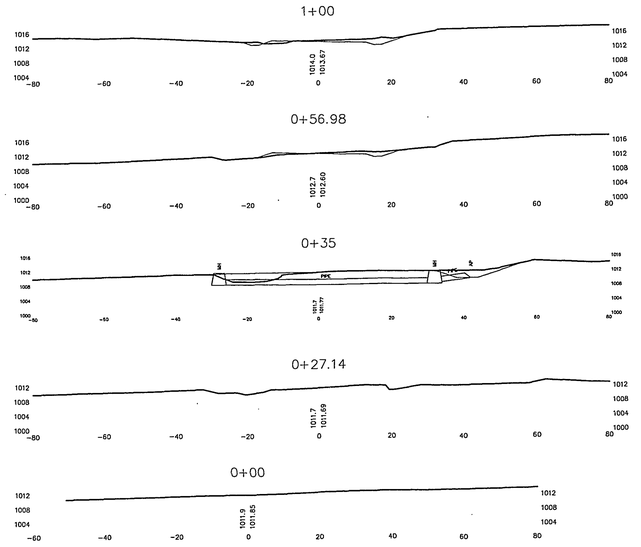

ASBUILT PLAN
CONFORMING TO CONST. RECORDS
DONE BY: DJS
DATE: 11/27/07

28-206

CROSS-SECTIONS

H:\Land Projects 3YP-2187-Century Avenue\Drawings\Construction\Wikkse Ext LAR.dwg 6/13/2007

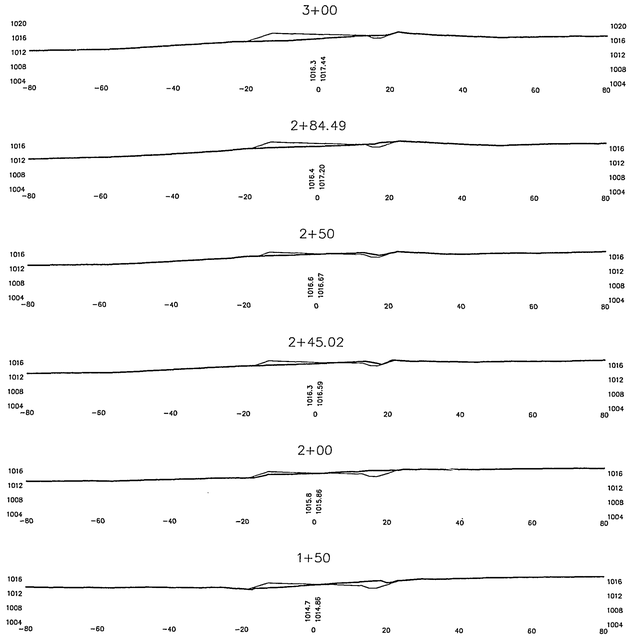

ASBUILT PLAN
CONFORMING TO CONST. RECORDS
DONE BY: DJS
DATE: 11/27/07

28-206

CROSS-SECTIONS

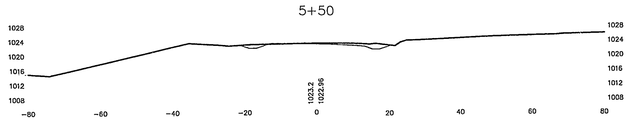

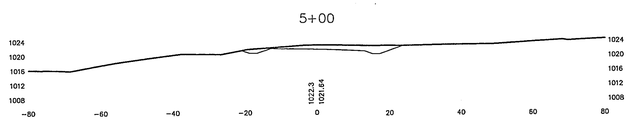

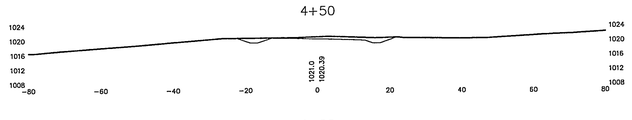

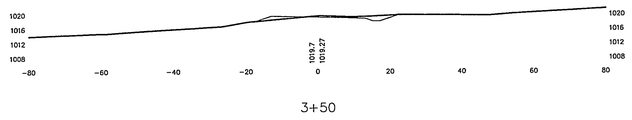

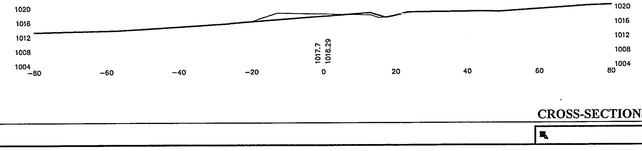

ASBUILT PLAN
CONFORMING TO
CONST. RECORDS
DONE BY: DJB
DATE: 11/27/07

28-206

CROSS-SECTIONS

H:\Land Projects 3VP-3187-Century Avenue\Drawings\Construction\Wekiva Ent LAR.dwg 6/13/2007

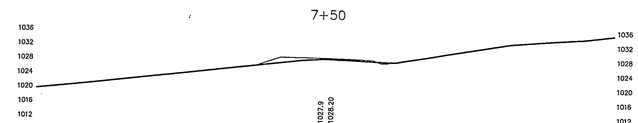

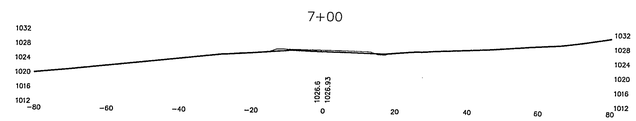

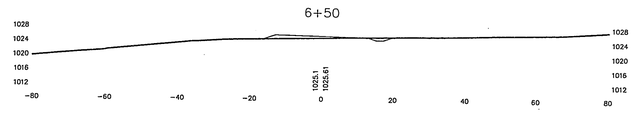

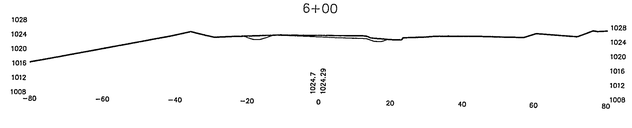

ASBUILT PLAN
CONFORMING TO
CONST. RECORDS
DONE BY: DJB
DATE: 11/27/07

28-206

CROSS-SECTIONS

H:\Land Projects 3VP-3187-Century Avenue\Drawings\Construction\Wekiva Ent LAR.dwg 6/13/2007

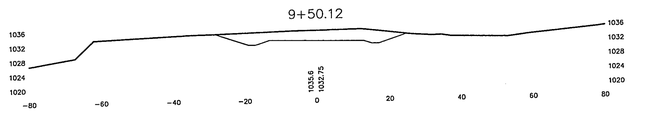

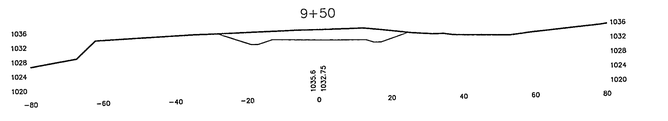

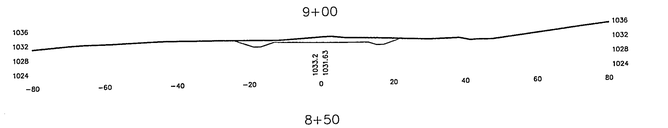

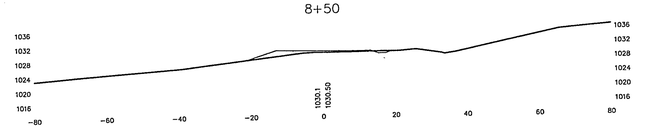

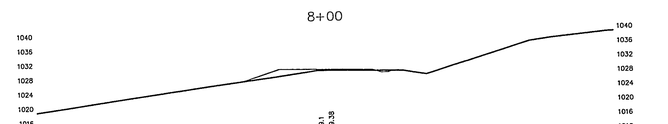

ASBUILT PLAN
CONFORMING TO
CONST. RECORDS
DONE BY: DJB
DATE: 11/27/07

28-206

CROSS-SECTIONS

H:\Land Projects 3VP-3187-Century Avenue\Drawings\Construction\Wekiva Ent LAR.dwg 6/13/2007

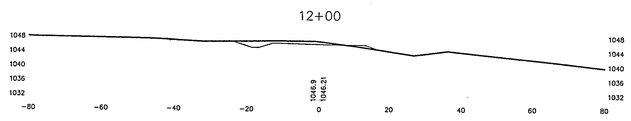

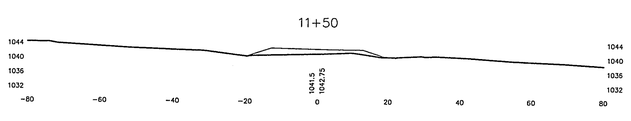

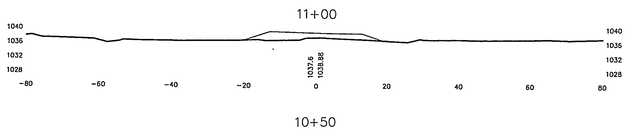

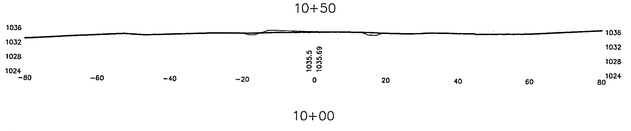

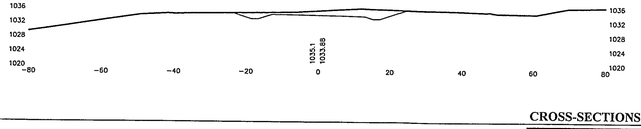

ASBUILT PLAN
CONFORMING TO
CONST. RECORDS
DONE BY: DJB
DATE: 11/27/07

28-206

CROSS-SECTIONS

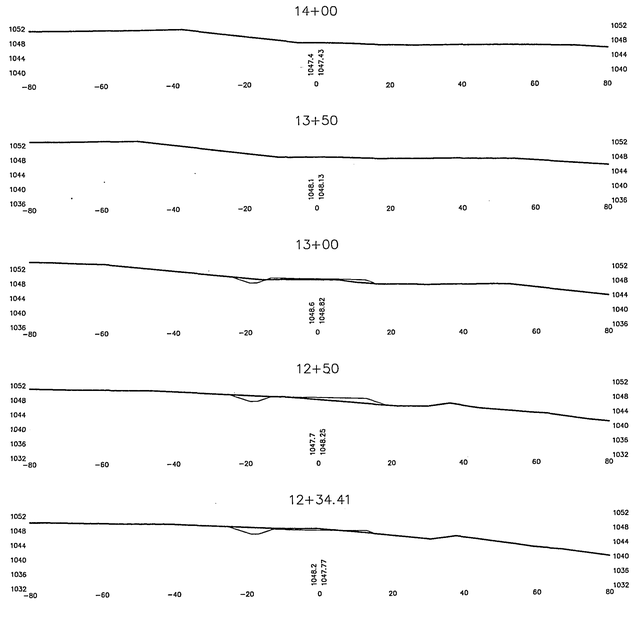

ASBUILT PLAN
CONFORMING TO
CONST. RECORDS
DONE BY: DJB
DATE: 11/27/07

28-206

CROSS-SECTIONS

SHEET NO. 13 OF 15 SHEETS

H:\Land Projects 3Y9--3187--Century Avenue\Drawings\Construction\Wekwa Ent LAR.dwg 6/13/2007

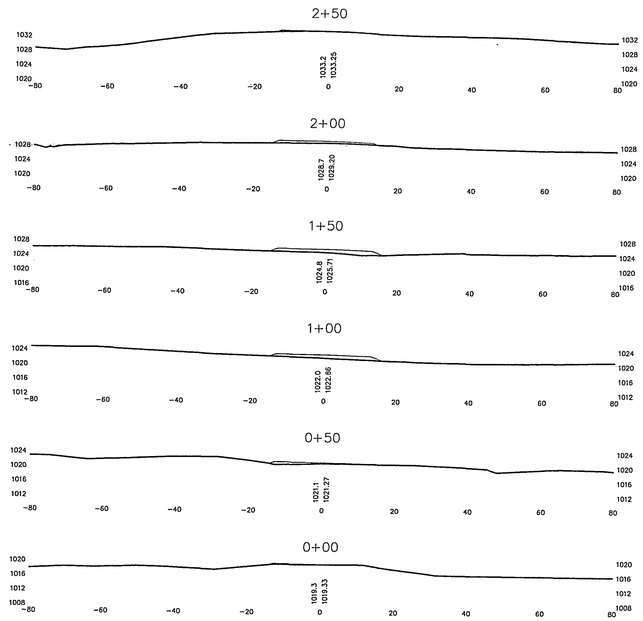

ASBUILT PLAN
CONFORMING TO
CONST. RECORDS
DONE BY: DJB
DATE: 11/27/07

28-206

CROSS-SECTIONS

SHEET NO. 14 OF 15 SHEETS

H:\Land Projects 3Y9--3187--Century Avenue\Drawings\Construction\Wekwa Ent LAR.dwg 6/13/2007

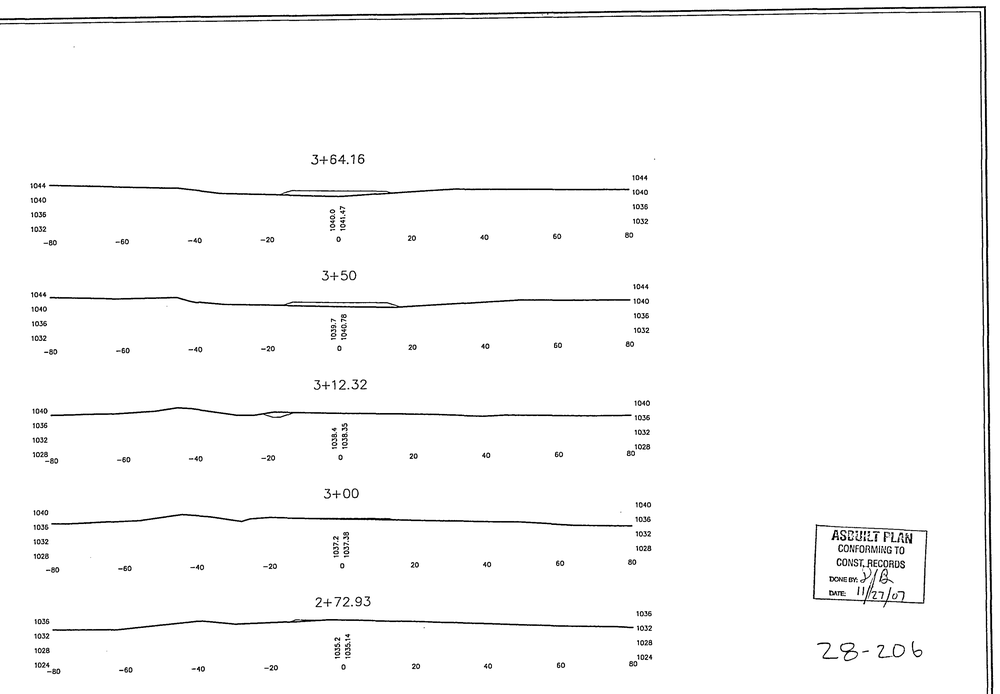

ASBUILT PLAN
CONFORMING TO
CONST. RECORDS
DONE BY: DJB
DATE: 11/27/07

28-206

CROSS-SECTIONS

SHEET NO. 15 OF 15 SHEETS

H:\Land Projects 3Y9--3187--Century Avenue\Drawings\Construction\Wekwa Ent LAR.dwg 6/13/2007

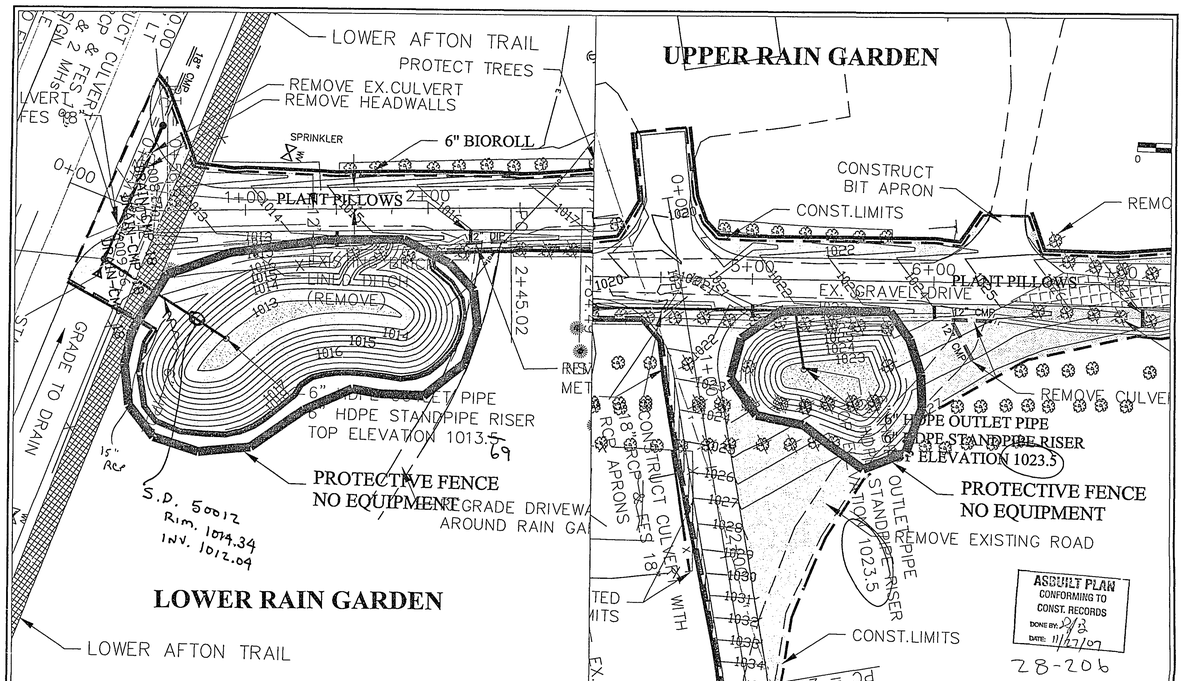

ASBUILT PLAN
CONFORMING TO
CONST. RECORDS
DONE BY: DJB
DATE: 11/27/07

28-206

S.A.P. 62-672-04 CTB SHEET NO. OF SHEETS

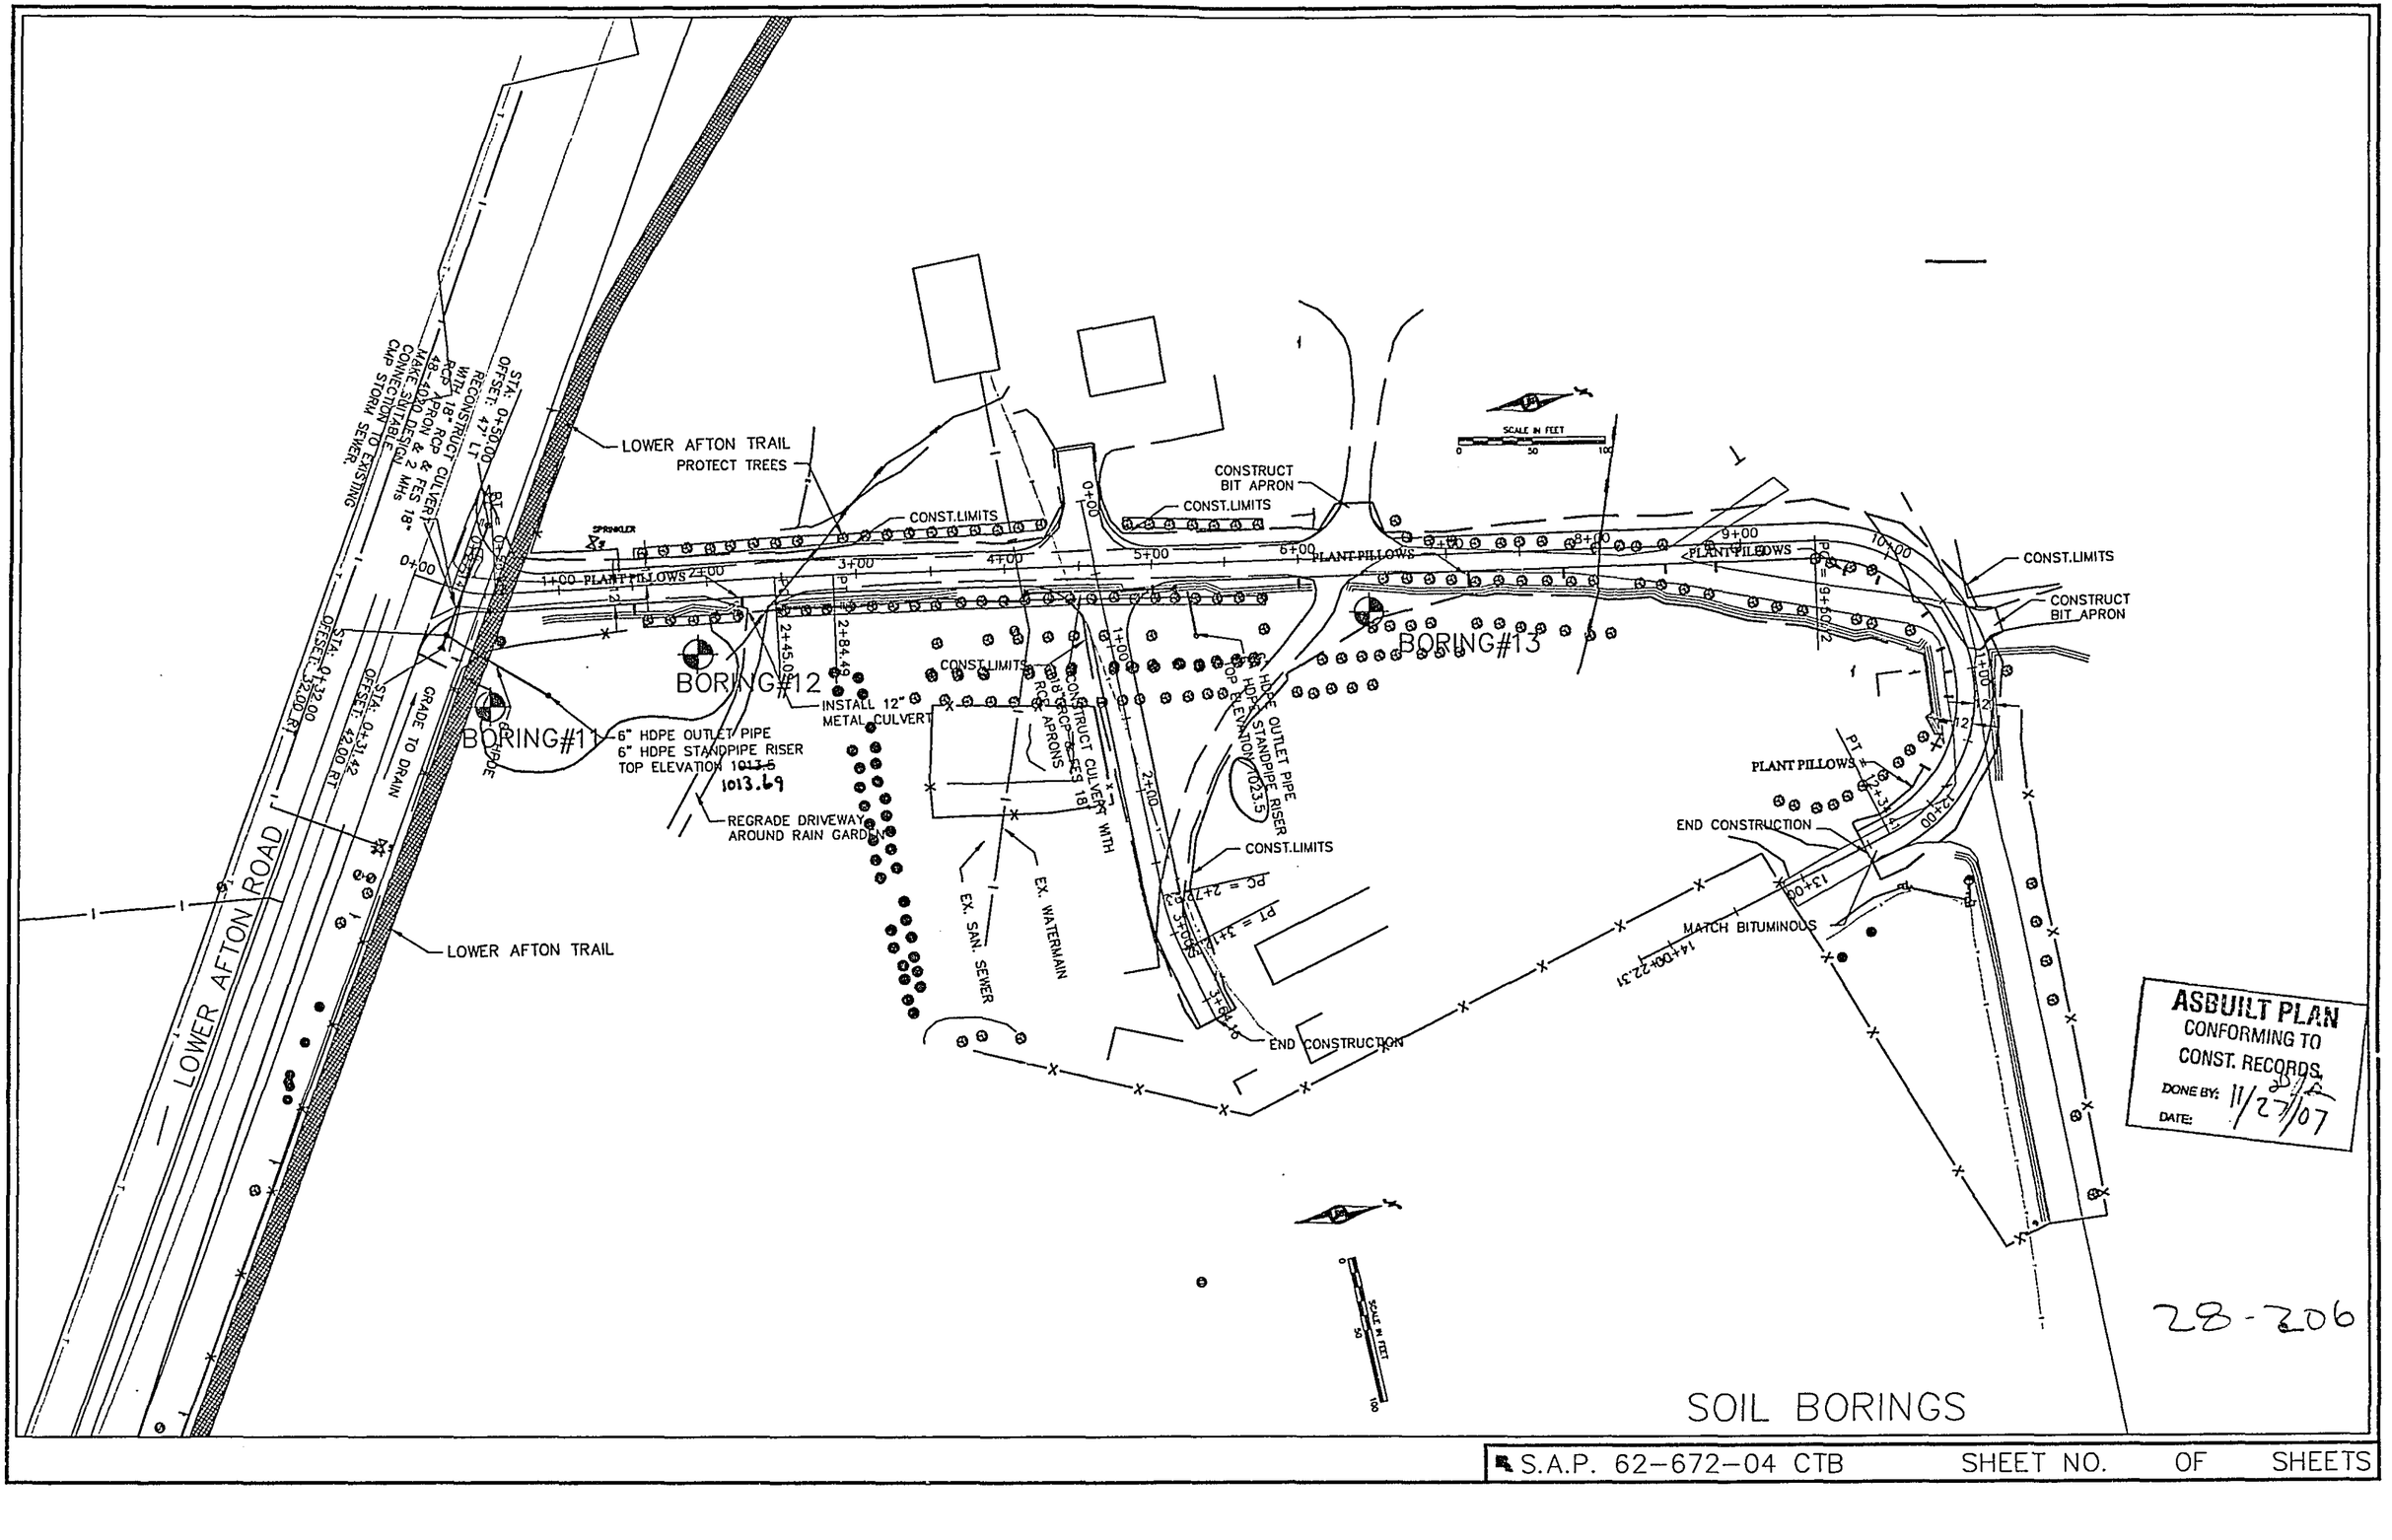
LOWER AFTON TRAIL
PROTECT TREES
CONST.LIMITS
CONSTRUCT BIT APRON
PLANT PILLOWS
SCALE IN FEET
0
50
100
BORING#11
BORING#12
BORING#13
6" HDPE OUTLET PIPE
6" HDPE STANDPIPE RISER
TOP ELEVATION 1013.5
1013.69
INSTALL 12" METAL CULVERT
REGRADE DRIVEWAY AROUND RAIN GARDEN
CONSTRUCT CULVERT WITH RCP APRONS
EX. SAN. SEWER
EX. WATERMAIN
HDPE OUTLET PIPE
HDPE STANDPIPE RISER
TOP ELEVATION 1023.5
END CONSTRUCTION
MATCH BITUMINOUS
LOWER AFTON ROAD
GRADE TO DRAIN
ASBUILT PLAN
CONFORMING TO
CONST. RECORDS
DONE BY:
DATE: 11/27/07
28-206
SOIL BORINGS
S.A.P. 62-672-04 CTB
SHEET NO.
OF
SHEETS