


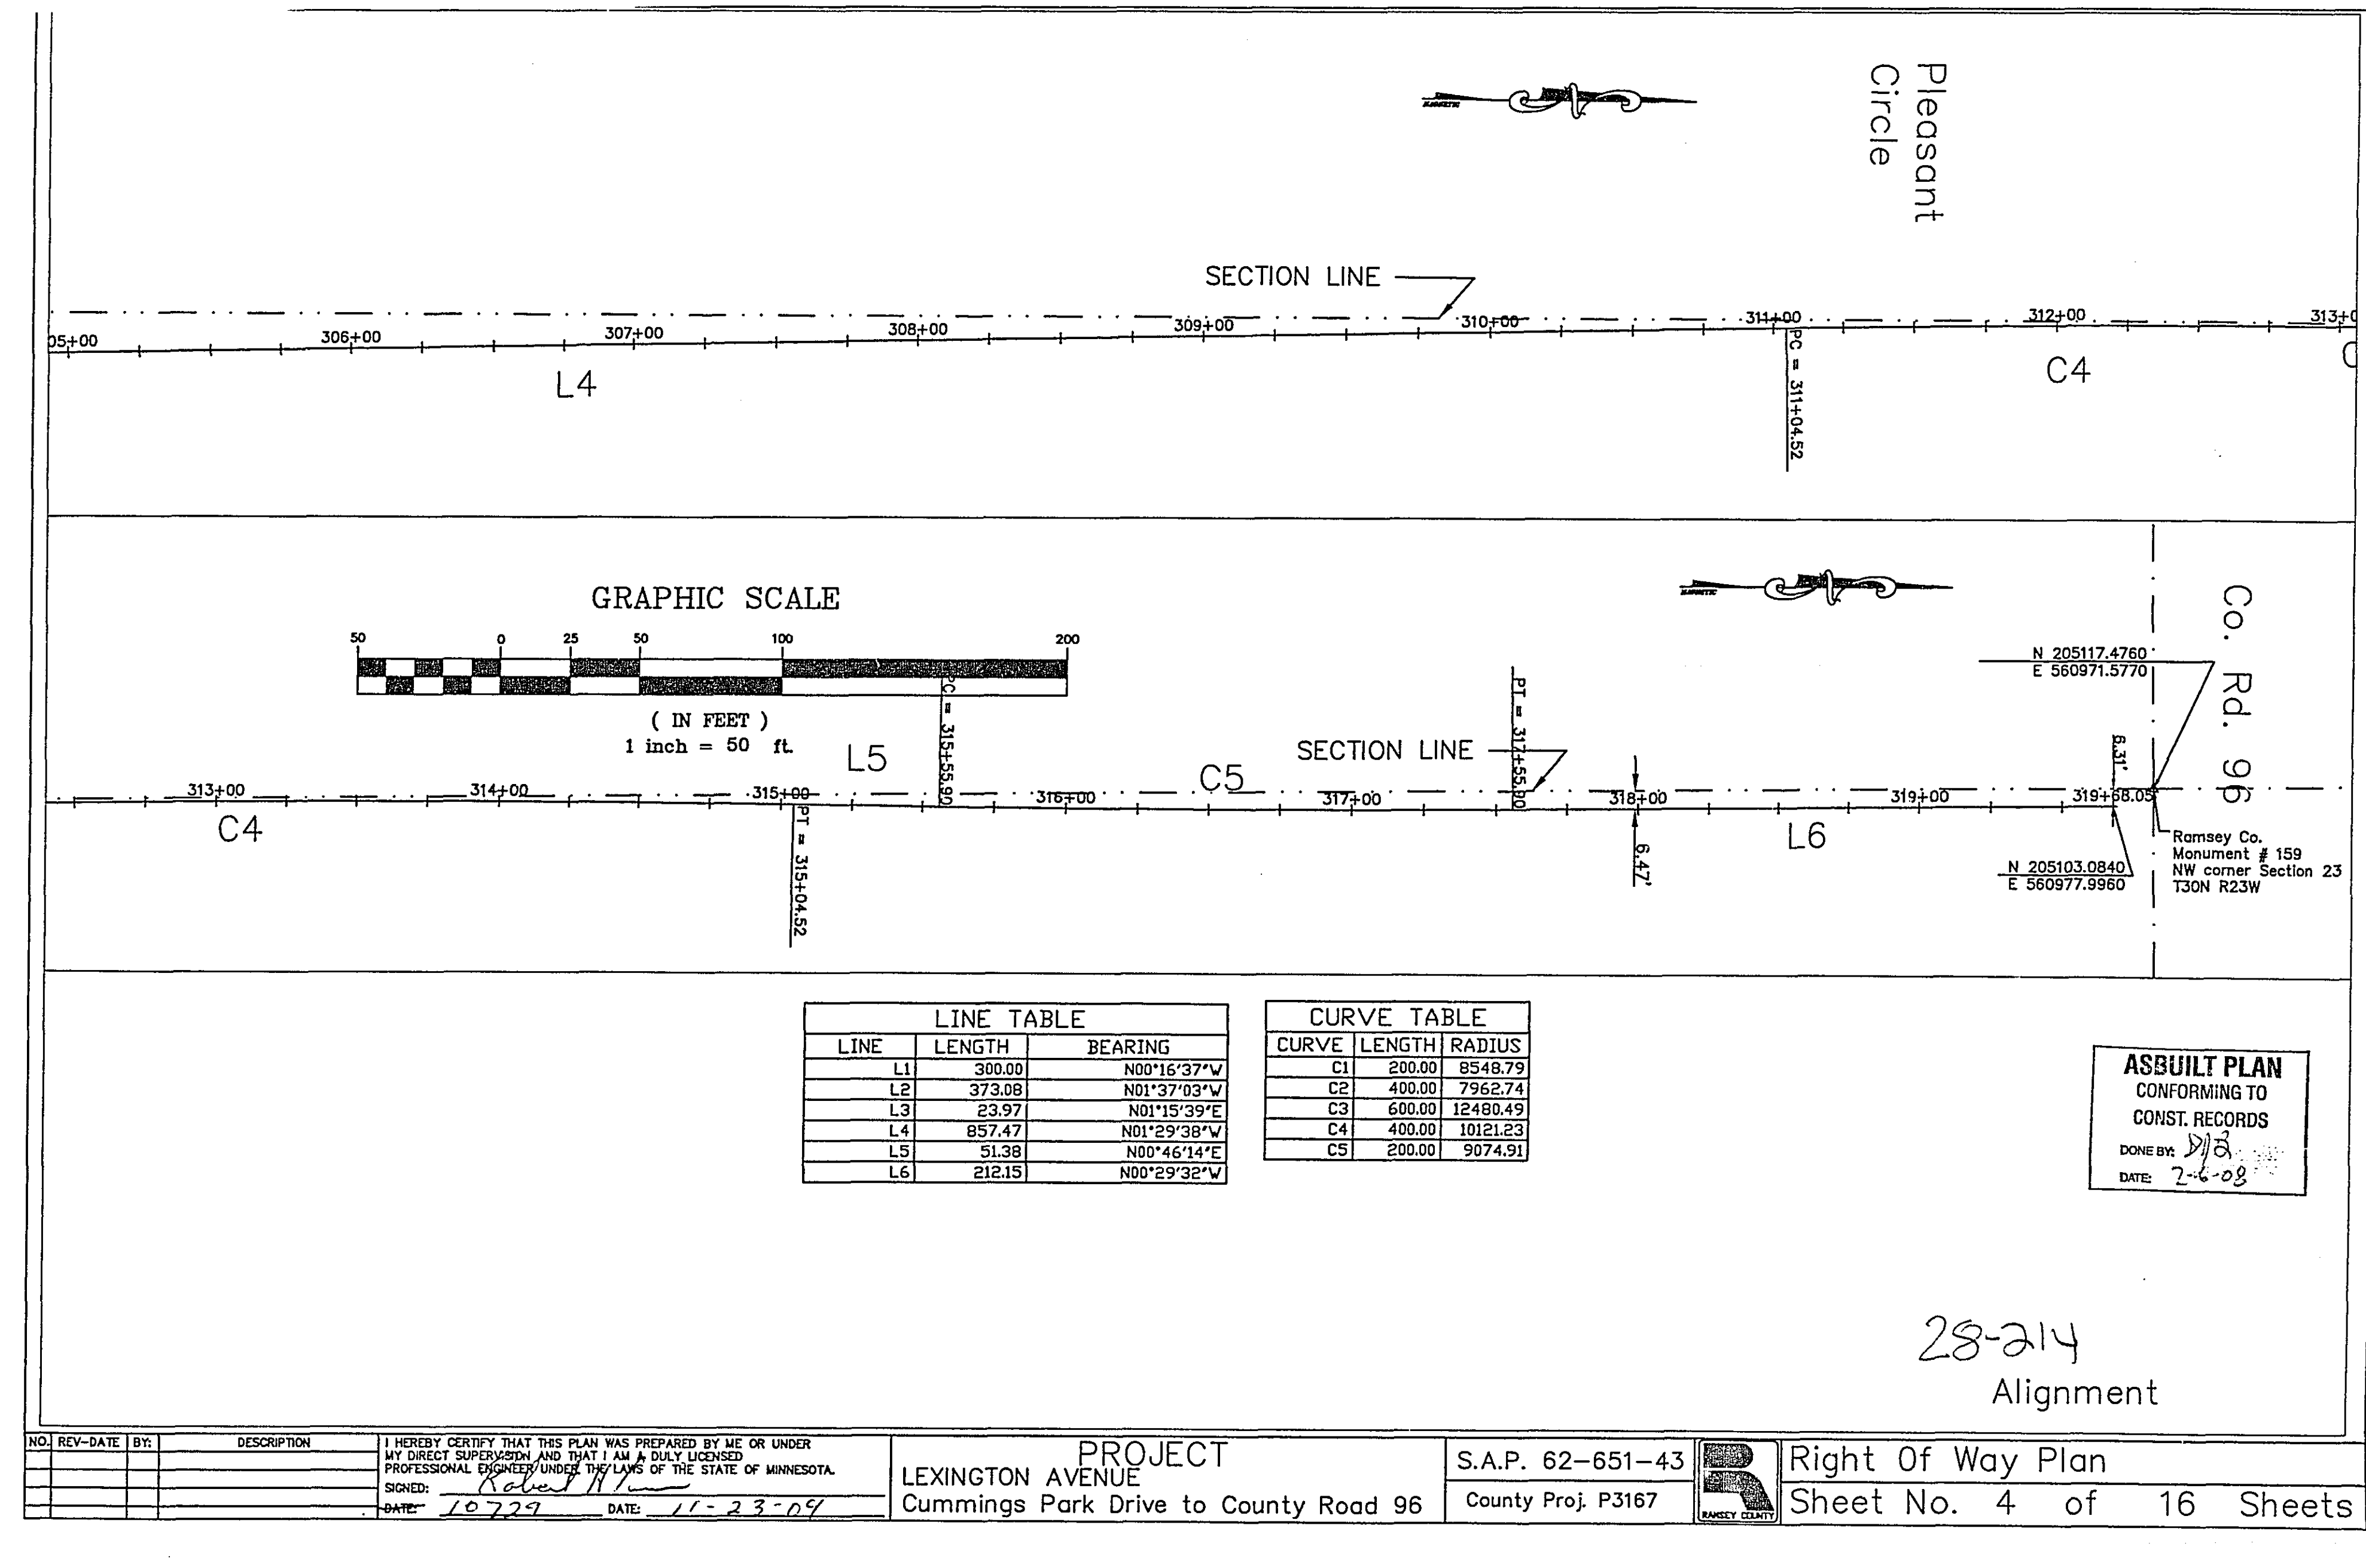


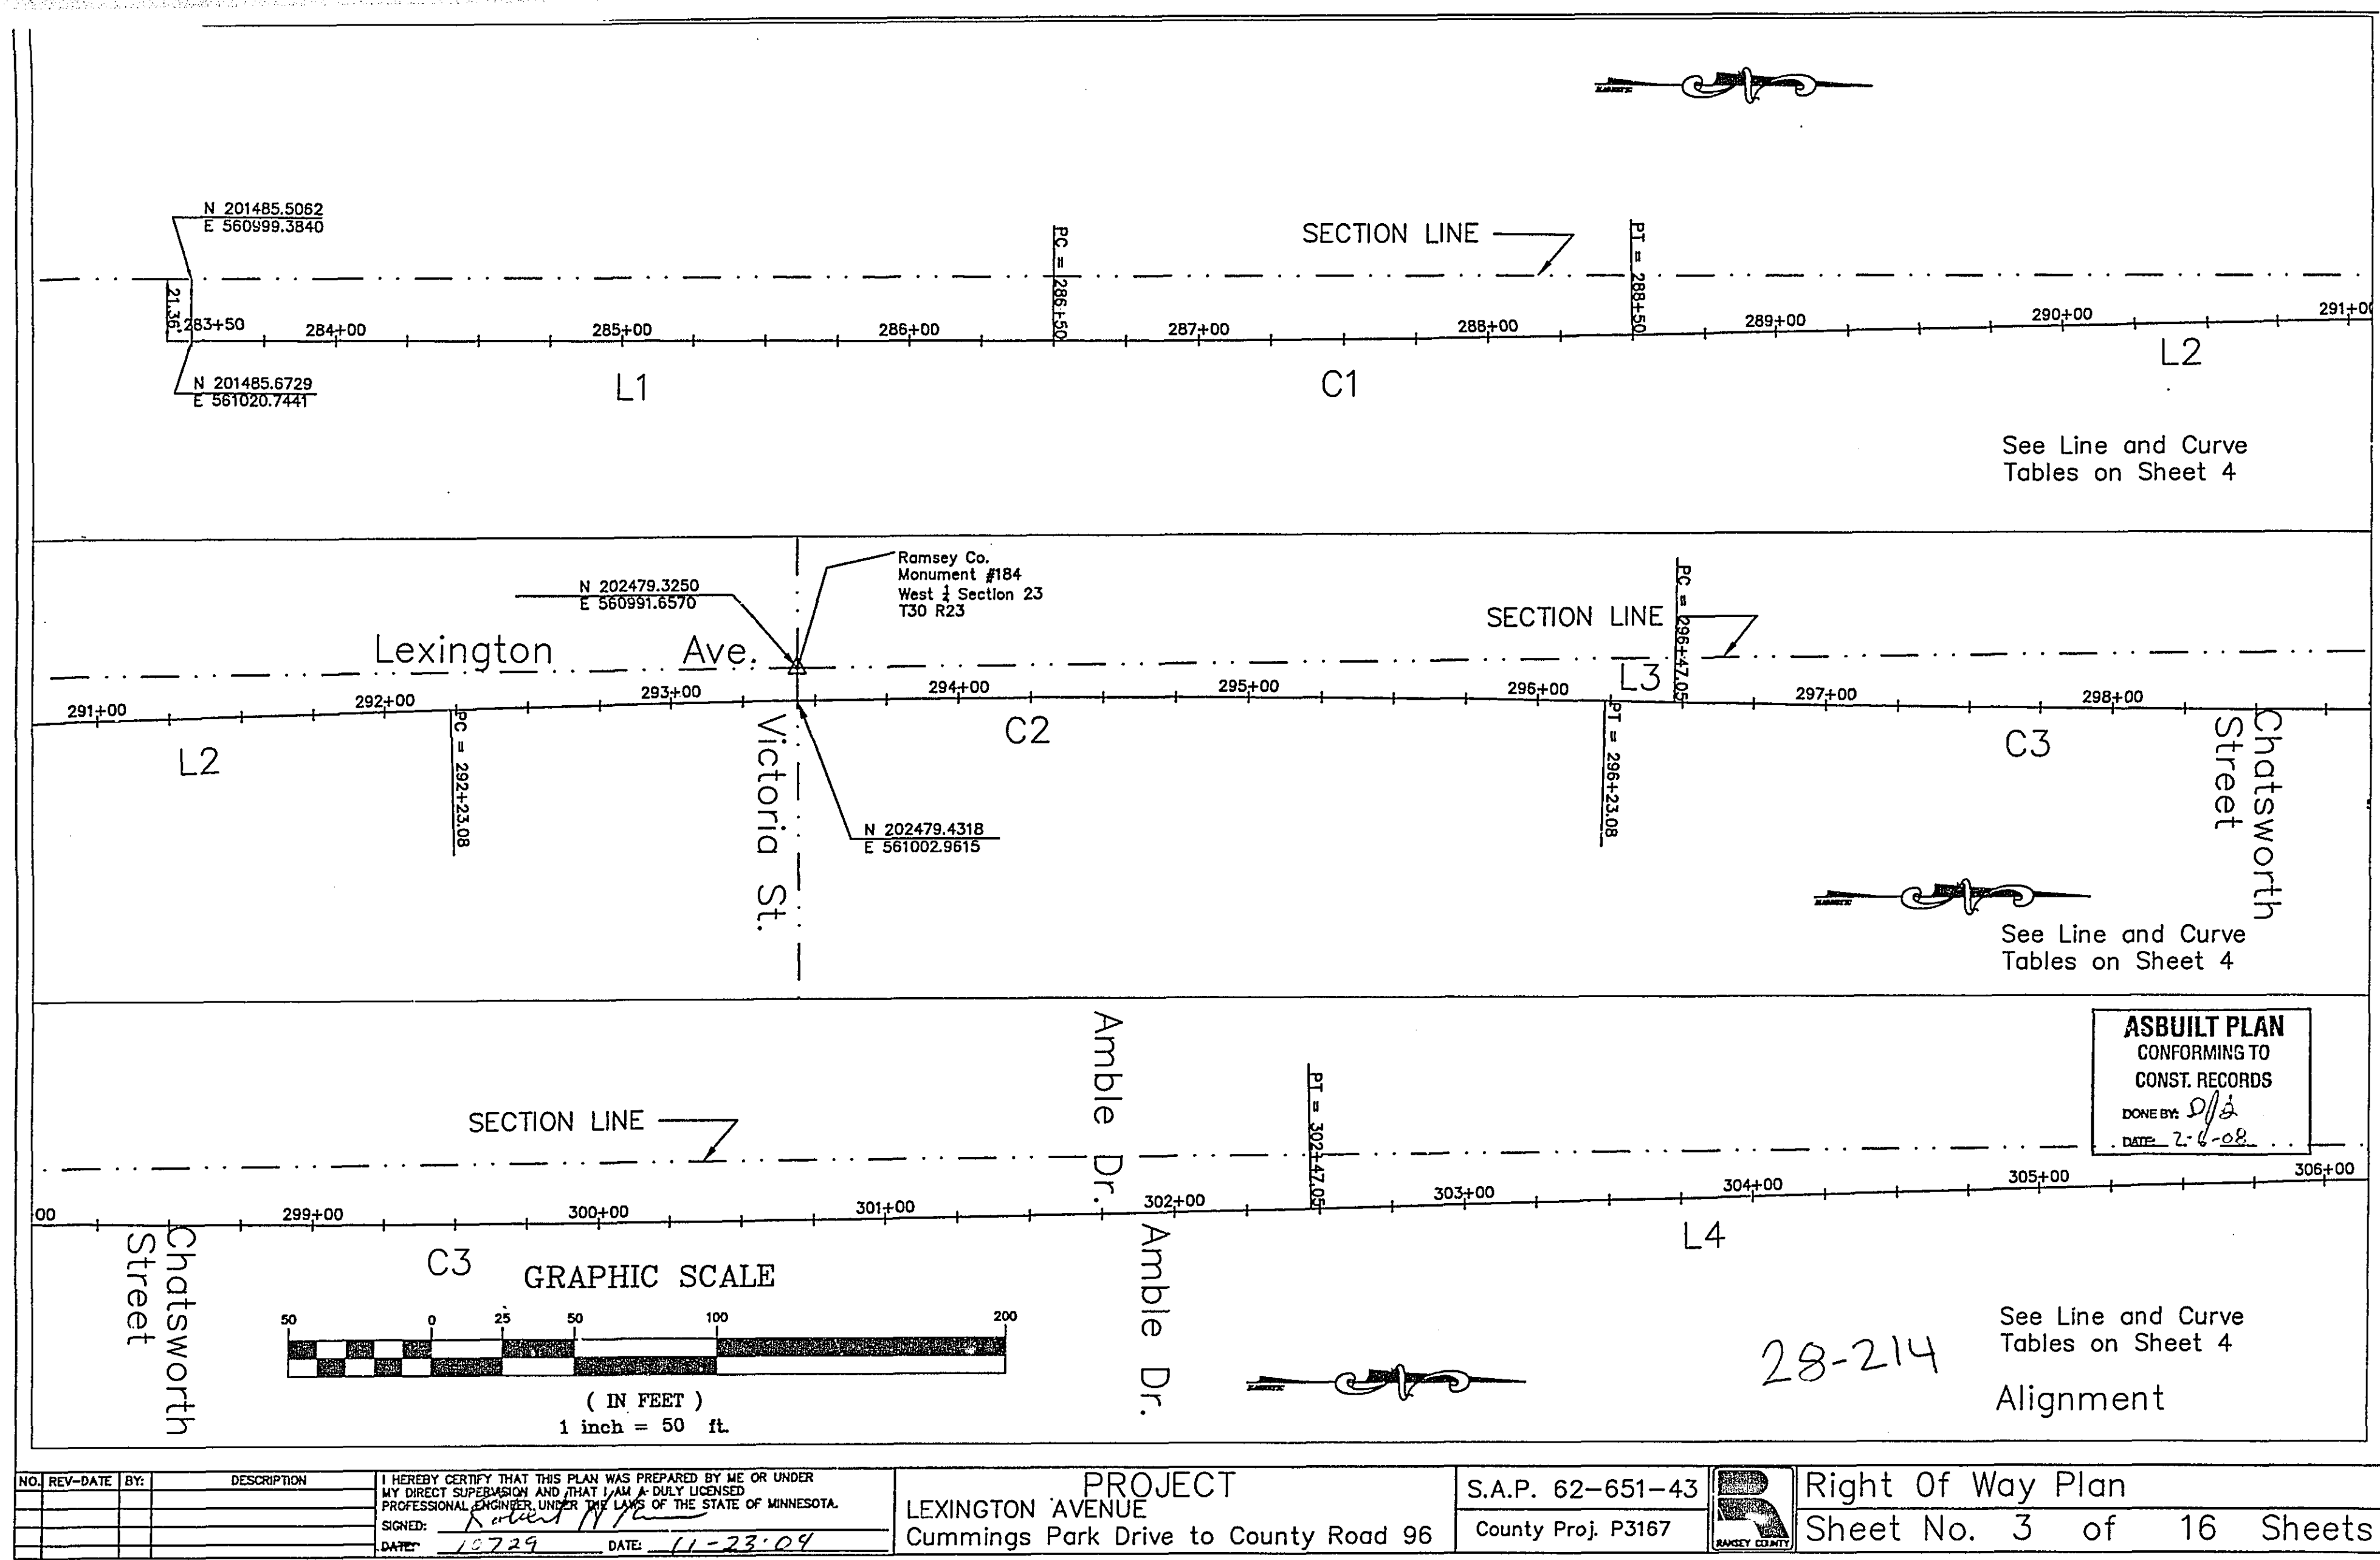

LEXINGTON RIGHT OF WAY CHART (Cummings Park Dr. to County Rd. 96)									
PARCEL #	PROPERTY ID NUMBER	ADDRESS	PARTIES OF INTEREST	PARCEL SIZE (SQ. FT.)	PERMANENT EASEMENT (SQ. FT.)	TEMPORARY EASEMENT (SQ. FT.)	DRILLAGE EASEMENT (SQ. FT.)		
CITY OF ARDEN HILLS - M.S.A.P. 187-02-010				MORTGAGE HOLDER					
200	22-30-23-43-0007	4333 LEXINGTON AVENUE NORTH	CARMICHAEL PAPERMAN, INC.		225	591			
201	22-30-23-41-0011	4245 LEXINGTON AVENUE NORTH	CSU CORPORATION		2050	1825			
202	22-30-23-41-0018	4255 LEXINGTON AVENUE NORTH	CSU CORPORATION		1550	3200			
203	22-30-23-41-0035		CITY OF ARDEN HILLS		WALL EASEMENT 12446				
204	22-30-23-41-0034	4365 LEXINGTON AVENUE NORTH	DAVID K. HADGUE KATHLEEN M. HADGUE		0	1844			
205	22-30-23-41-0035	4367 LEXINGTON AVENUE NORTH	ROGER A. SABOT BEVERLEY SABOT		0	995			
206	22-30-23-41-0017	1104 AMBLE DRIVE	LEONARD E. GALLUS MARJORIE E. GALLUS		0	0			
207	22-30-23-41-0027	1105 AMBLE DRIVE	C. GREGORY PETERSON JEAN M. PETERSON		1171	950			
208	22-30-23-41-0029	4408 AMBLE CIRCLE	ROBERT A. LARSA CHRISTINE A. LARSA		558	887			
209	22-30-23-41-0009	4414 AMBLE CIRCLE	DANIEL J. SMITH MARCEA P. SMITH		848	1832			
210	22-30-23-41-0010	4416 AMBLE CIRCLE	GEORGE W. PHILLIPS MICHELLE R. PHILLIPS		387	1046			
211	22-30-23-41-0043	4460 PLEASANT DRIVE	DAVID J. BROWNE ELLEN L. BROWNE		851	2417			
212	22-30-23-41-0042	4460 PLEASANT DRIVE	JANARD J. MICHEL JILL M. MICHEL		129	1484			
213	22-30-23-41-0041	4472 PLEASANT DRIVE	DONALD S. EATON		0	0			
214	22-30-23-41-0040	4460 PLEASANT DRIVE	ANDREW J. HOLMAN TRINEL EATON		0	950			
215	22-30-23-41-0040	4460 PLEASANT DRIVE	CAROLYN DOSTLER		0	0			
CITY OF SHOREVIEW - M.S.A.P. 187-020-18									
216	22-30-23-32-0047	WESTON WAY	WESTON WOODS OF SHOREVIEW ASSOCIATION WALK OF EXCELLENCE HOMES, INC.		0	0			
217	22-30-22-23-0234	4314 CHATSWORTH ST. N.	ROLLING HILLS TOWN ASSOC.		1128	1810			
218	22-30-22-23-0234	4314 CHATSWORTH ST. N.	ROLLING HILLS TOWN ASSOC.		30	680			
219	22-30-22-23-0058	1084 AMBLE DRIVE	JOHN W. GUNTER		482	649			
220	22-30-22-23-0059	1085 AMBLE DRIVE	DONALD W. CHRISTENSEN WENDY R. CHRISTENSEN		814	1004			
221	22-30-22-23-0047	1086 CHURCHILL PLACE	BILLY S. JOHNSON		0	0			
222	22-30-22-23-0048	1092 CHURCHILL PLACE	HELEN B. GARDENBERG		0	503			
223	22-30-22-23-0045	1094 CHURCHILL PLACE	ADAM WITTEMAN		0	792			
224	22-30-22-23-0042	1093 CHURCHILL PLACE	PAUL B. DANIELSON ARND A. THOMPSON		0	506			
225	22-30-22-23-0039	1095 CHURCHILL PLACE	SHERYL A. HERR		0	0			
226	22-30-22-22-0031	4448 LEXINGTON AVENUE NORTH	LISA J. RING		248	1445			
227	22-30-22-22-0032	4458 LEXINGTON AVENUE NORTH	WILFRED R. ORT		375	1076			
228	22-30-22-22-0033	4468 LEXINGTON AVENUE NORTH	SHAWN L. FORDGROSVES MARJORIE E. FORDGROSVES		182	3035			
229	22-30-22-22-0034	4478 LEXINGTON AVENUE NORTH	WENDY A. MONTGOMERY MICHELLE A. MONTGOMERY		0	2892			
230	22-30-22-22-0035	4488 LEXINGTON AVENUE NORTH	CHARLES F. STEWART		0	1107			
231	22-30-22-22-0036	4498 LEXINGTON AVENUE NORTH	TONY L. WILLARD		0	772			
232	22-30-22-22-0040	4504 LEXINGTON AVENUE NORTH	TERRY H. LARSEN		0	1477			
233	22-30-22-22-0039	4514 LEXINGTON AVENUE NORTH	KYLE ANN LARSEN		0	492			
234	22-30-22-22-0160	4520 LEXINGTON AVENUE NORTH	KYLE VOIGTSBERGER MICHELLE A. VOIGTSBERGER		0	1310			
235	22-30-22-22-0159	4532 LEXINGTON AVENUE NORTH	DOROTHY H. JEN		228	1781			
				TOTALS	24092	28484			
NO. REV. DATE BY: DESCRIPTION									
I HEREBY CERTIFY THAT THIS PLAN WAS PREPARED BY ME OR UNDER MY DIRECT SUPERVISION AND THAT I AM A DULY LICENSED PROFESSIONAL ENGINEER IN THE STATE OF MINNESOTA.									
SIGNED: 									
LIC. NO. 10229 DATE: 11-22-09									
LEXINGTON				S.A.P. 62-651-43		ROW CHART		28-214	
				County Proj. P-3167		Sheet No. 5 of 16		Sheets	

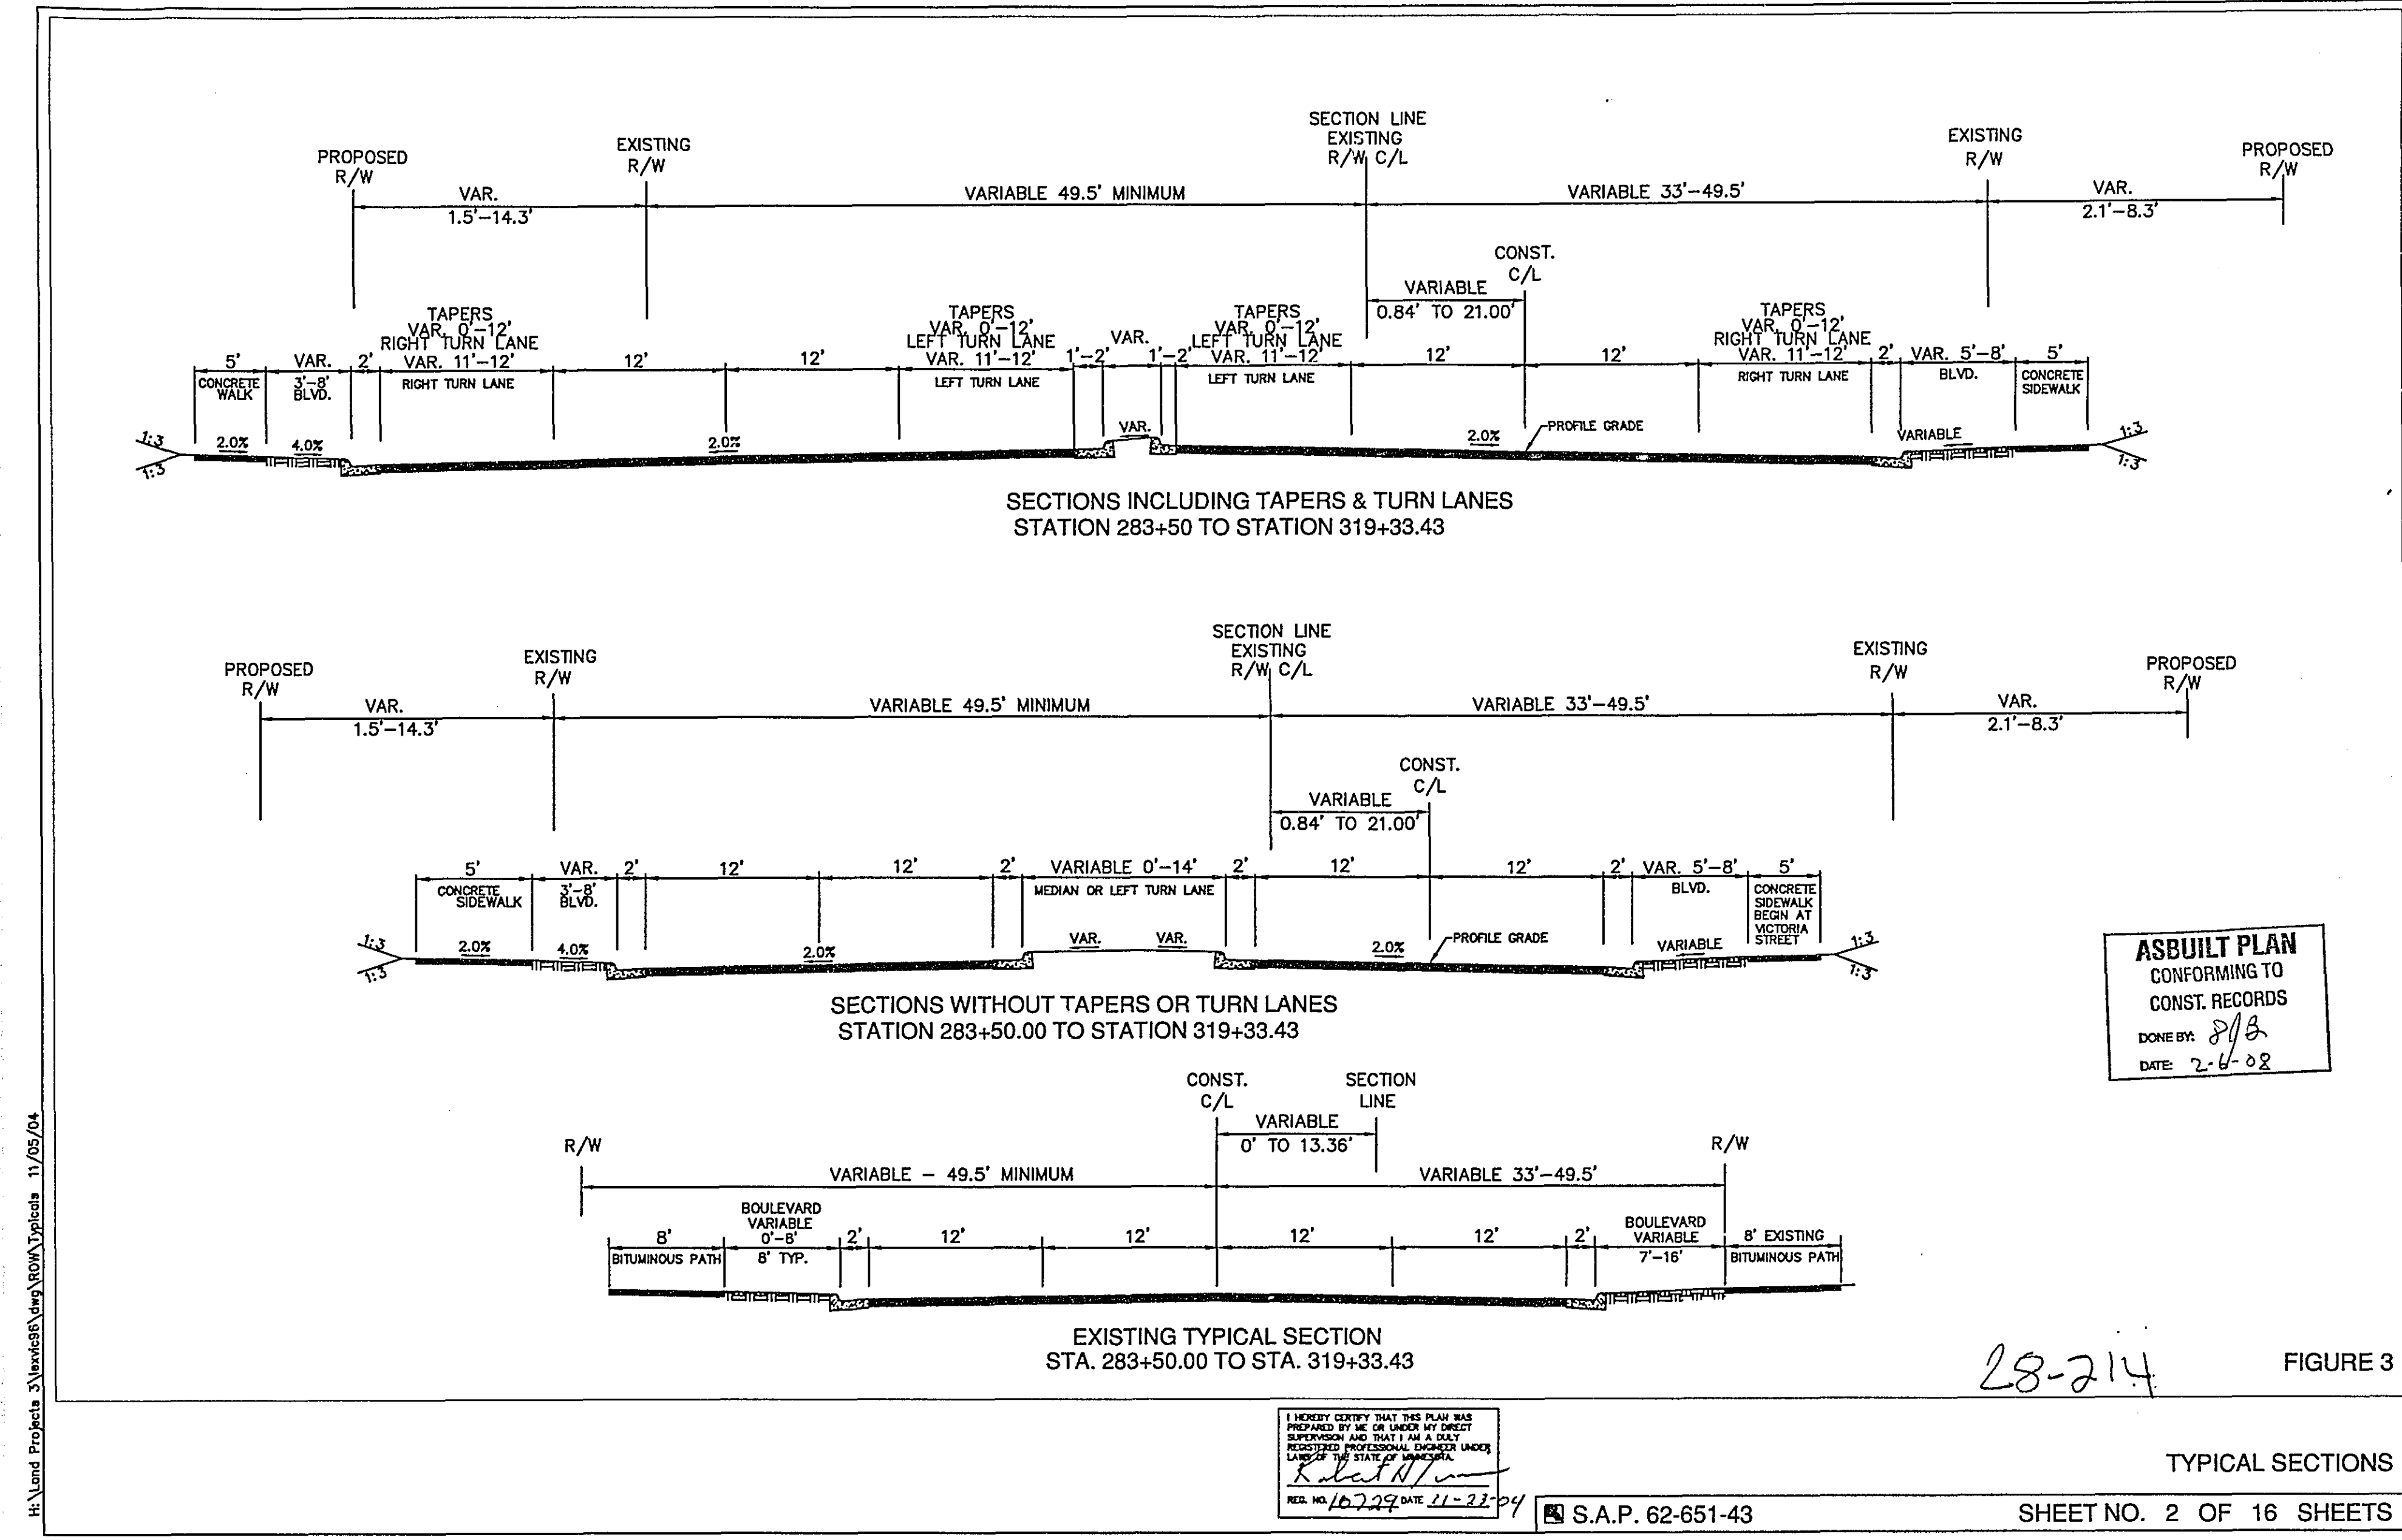

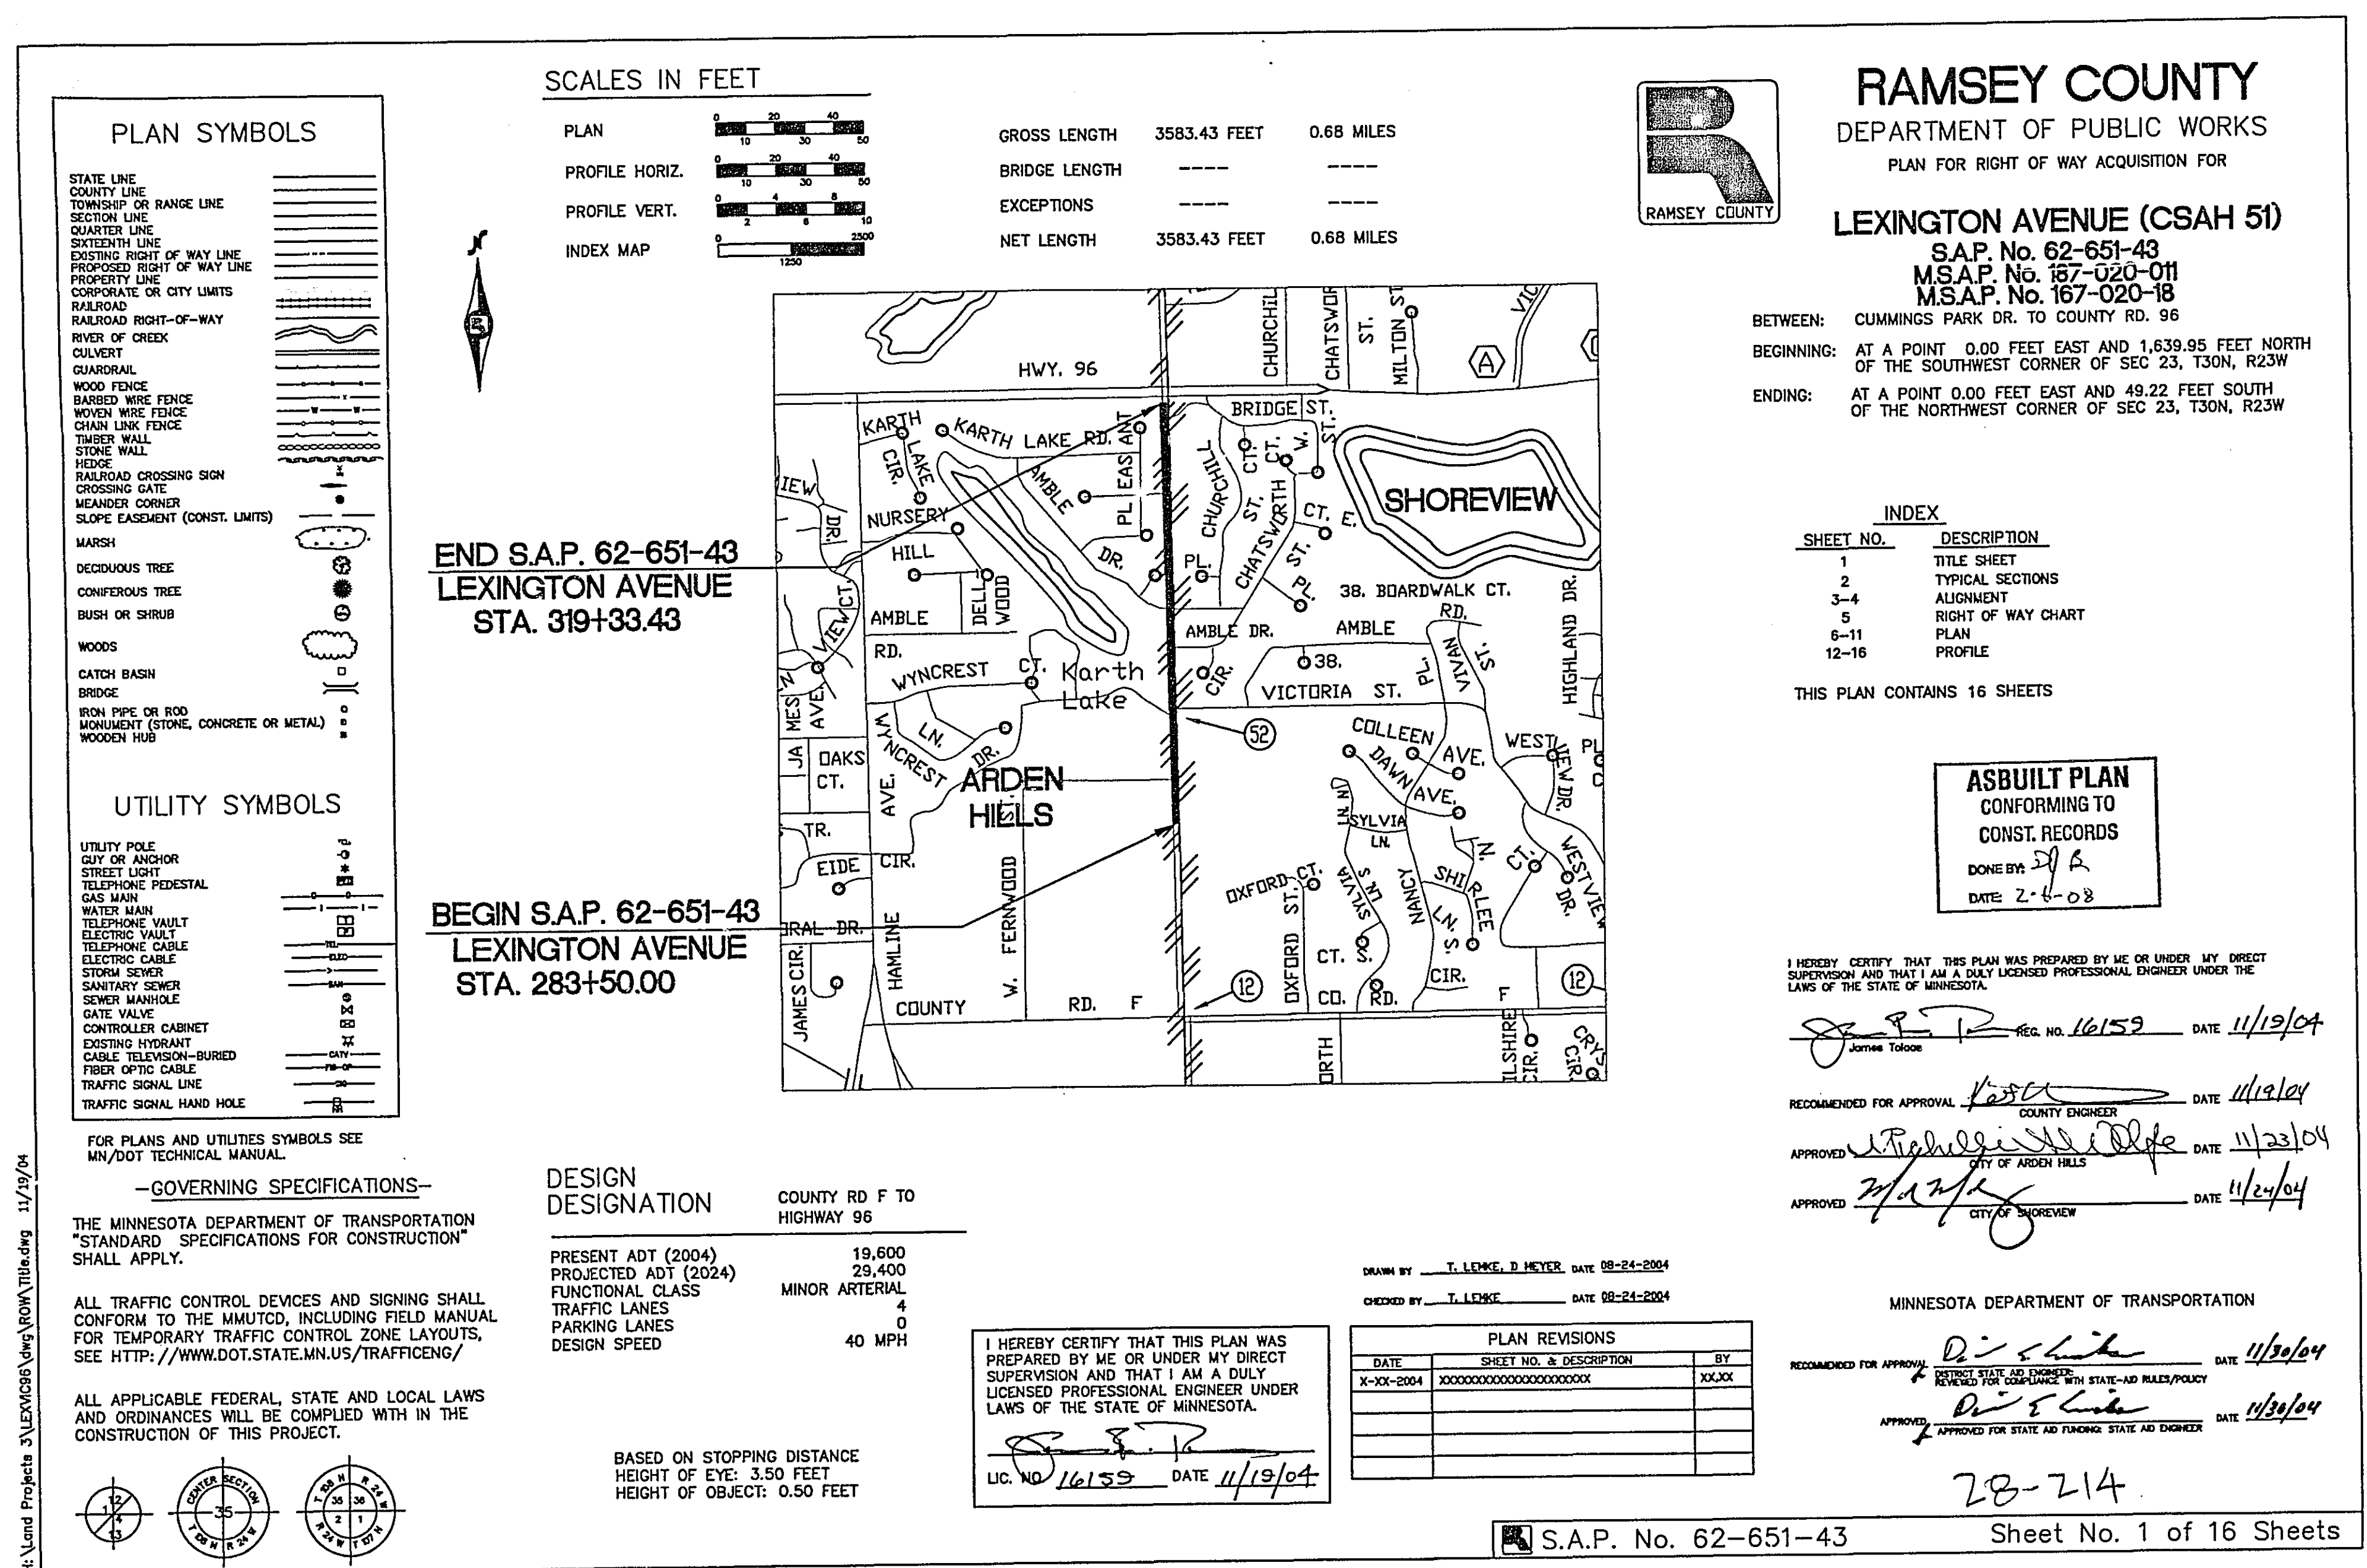