





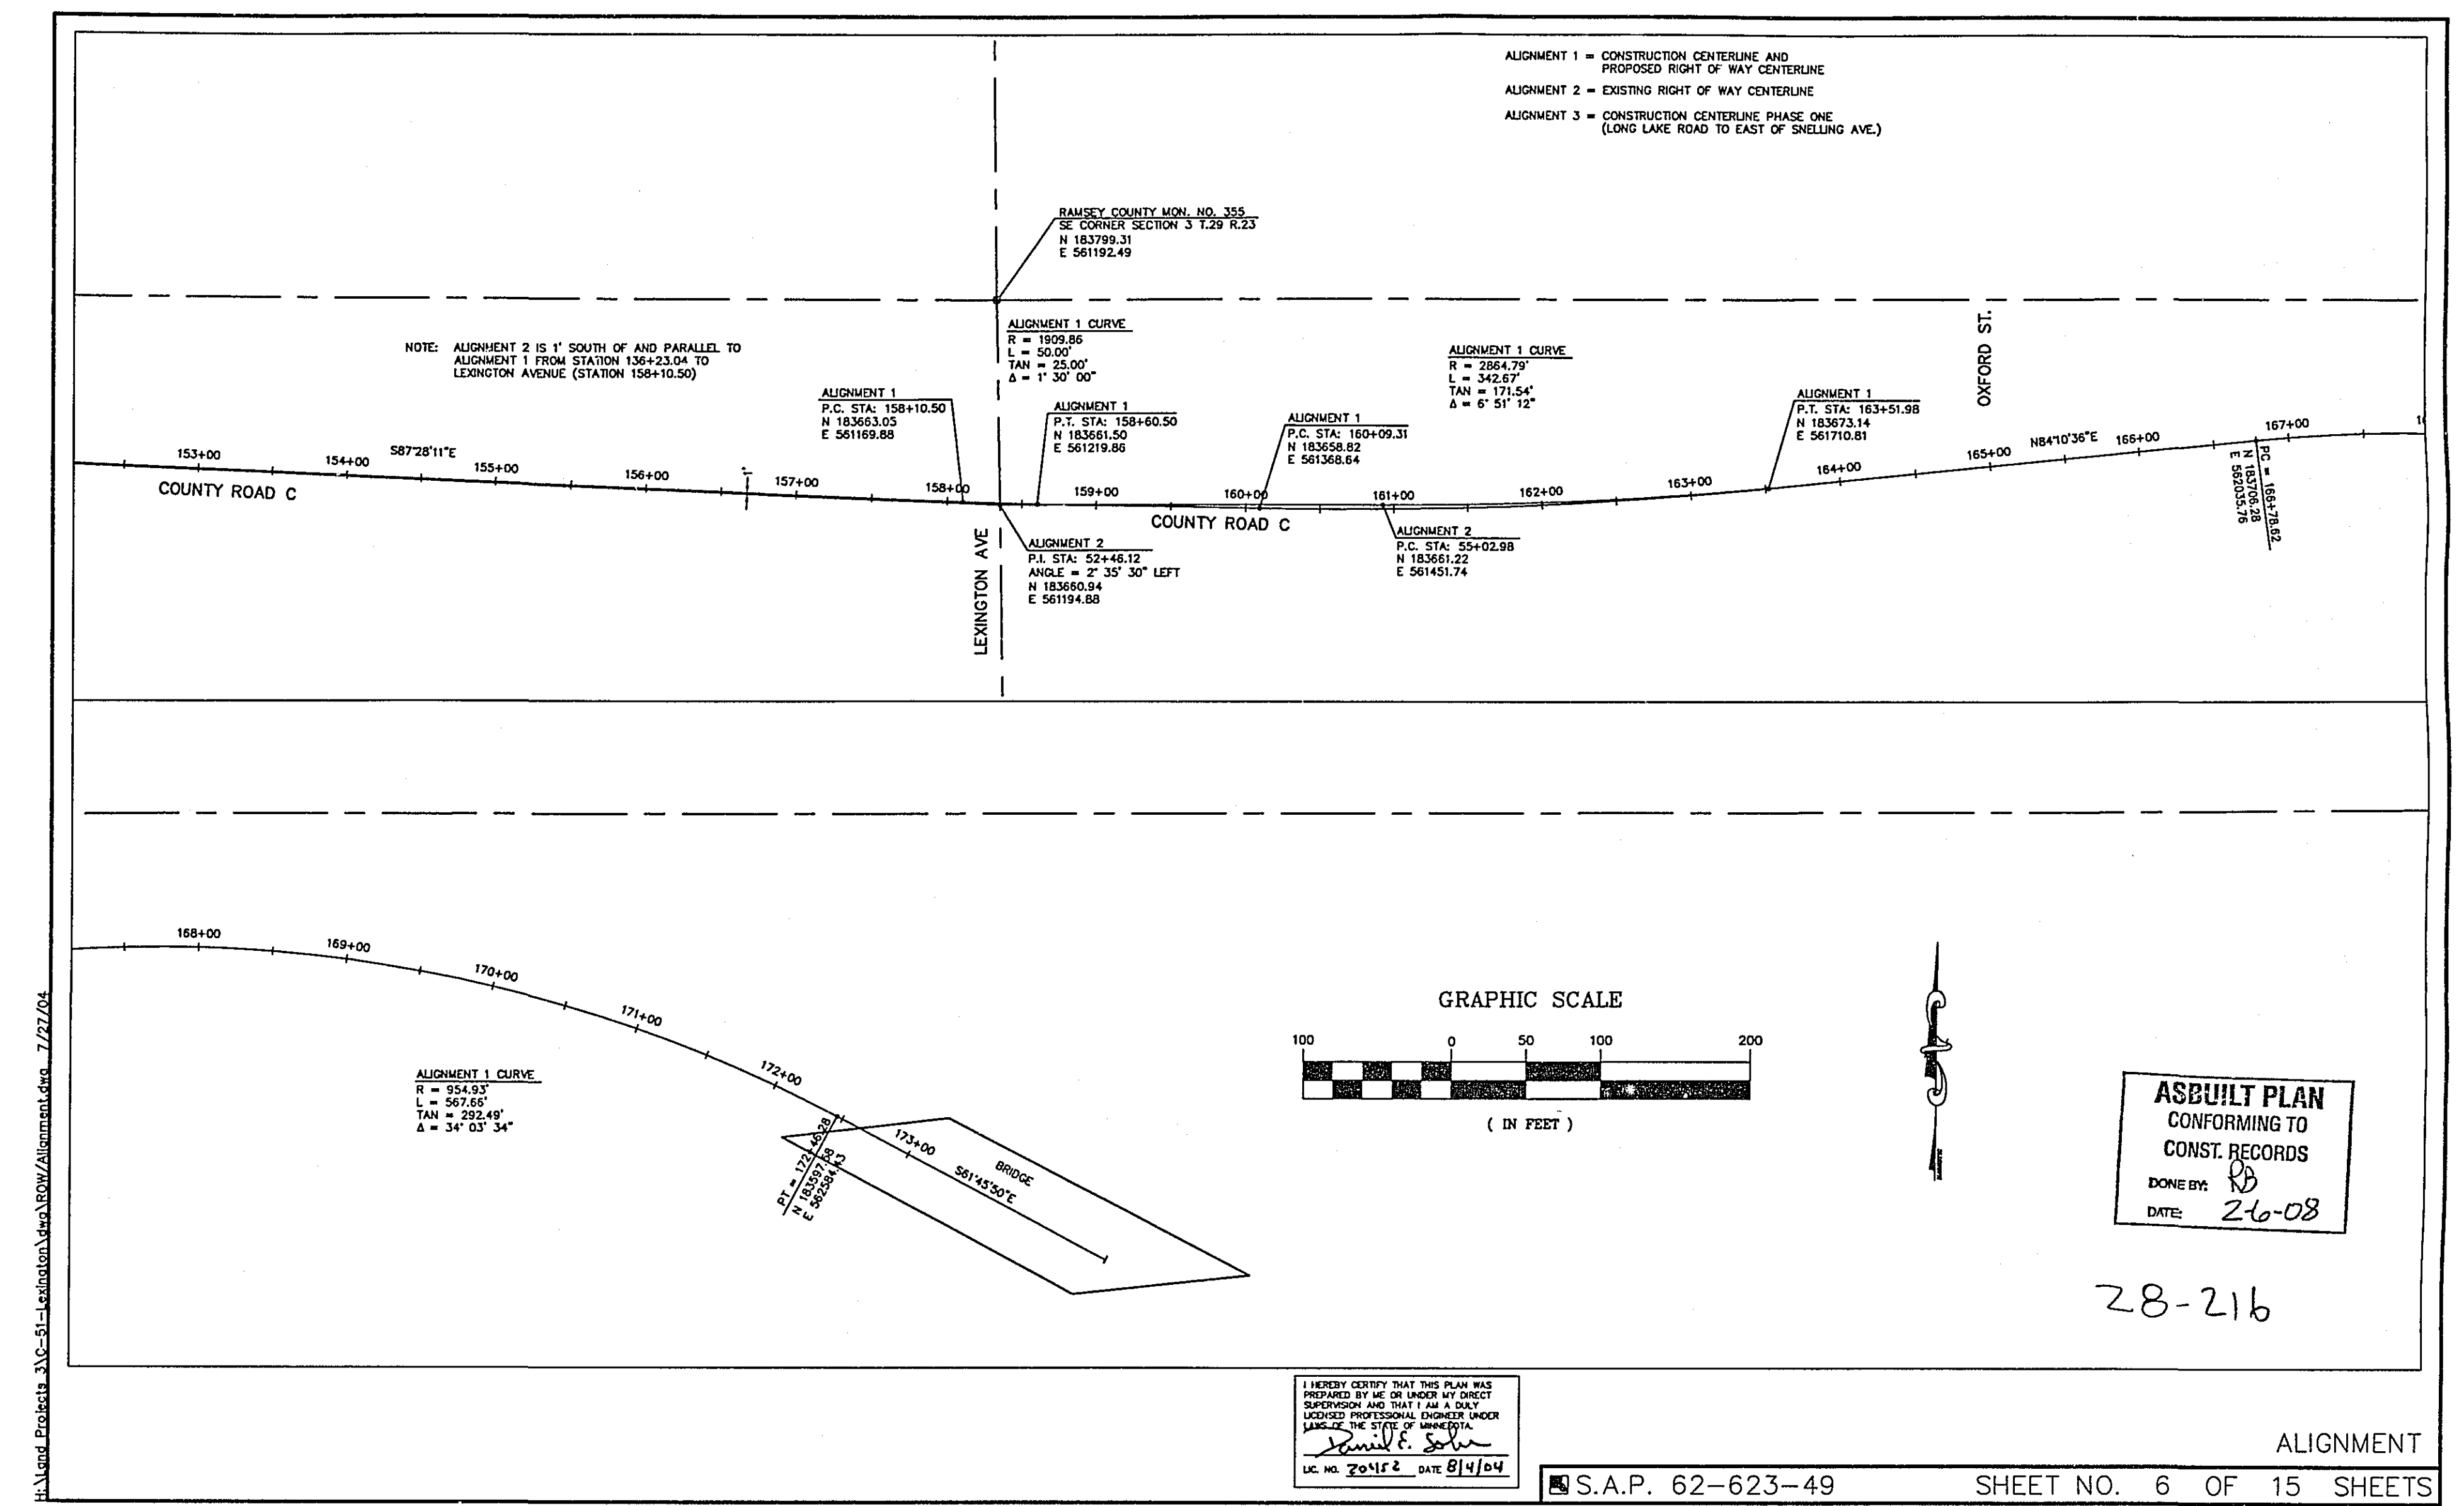

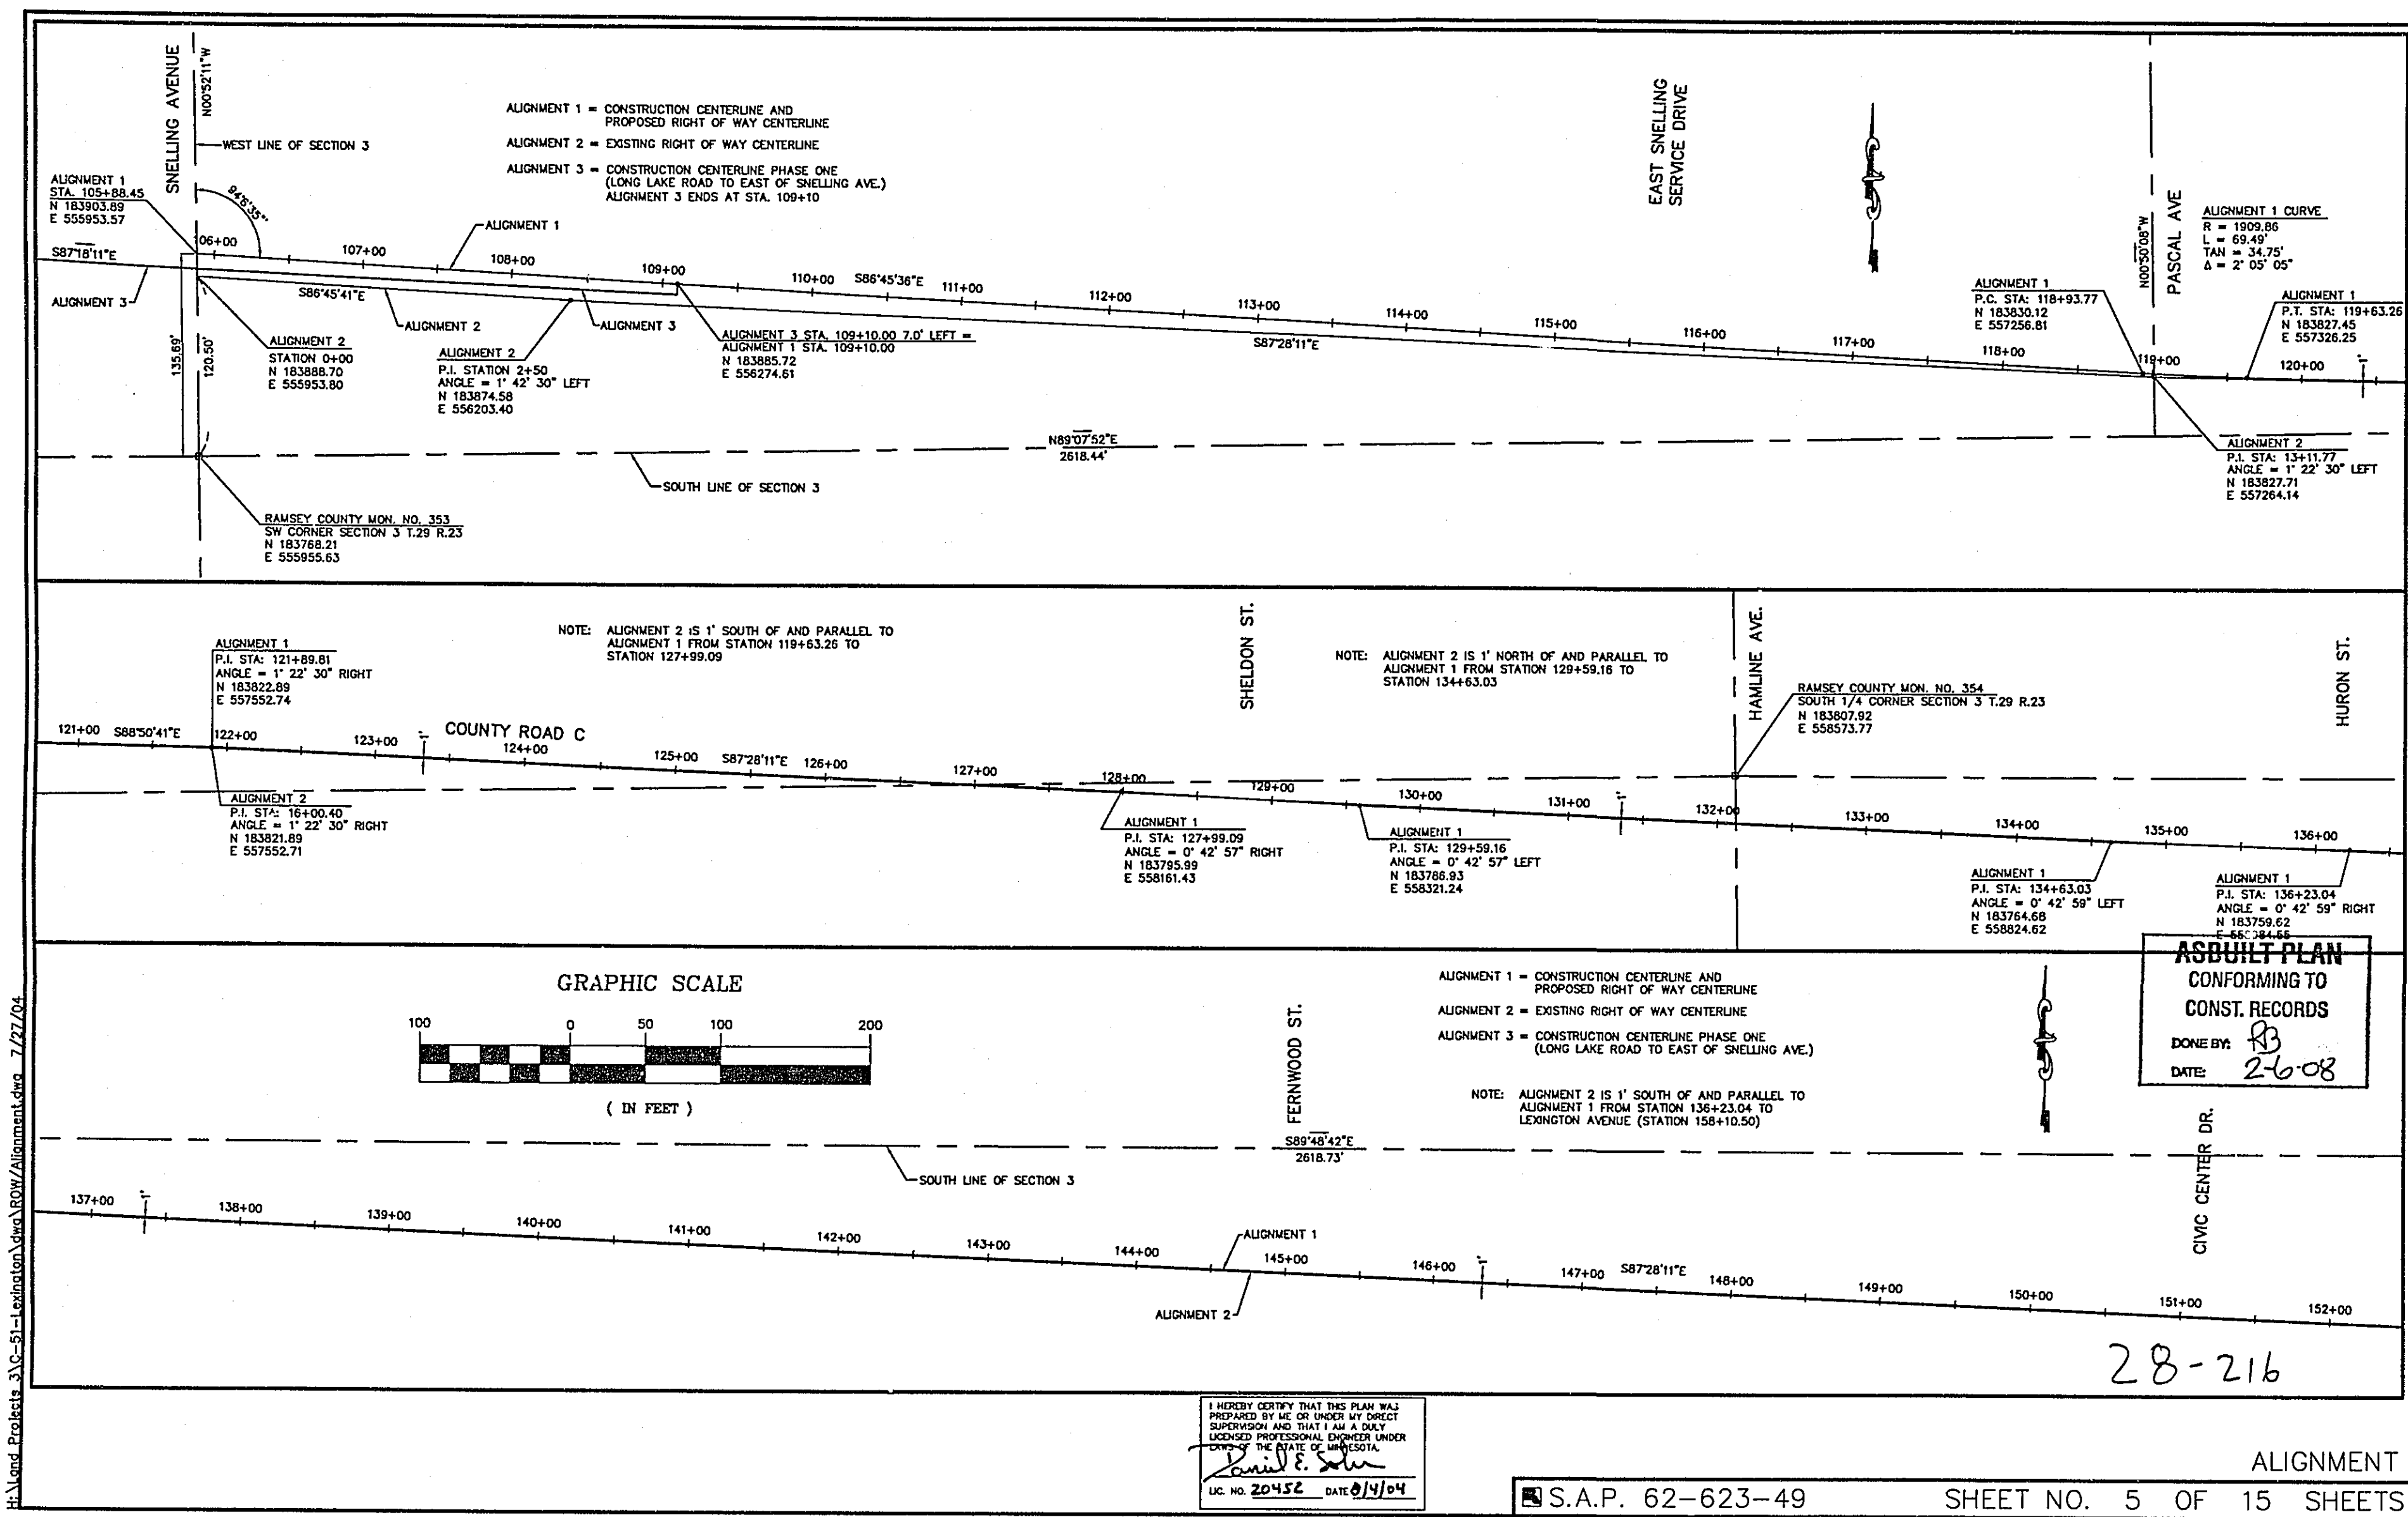


COUNTY ROAD C RIGHT OF WAY CHART (SNELLING AVE. TO OXFORD ST.)															
PARCEL #	PROPERTY ID NUMBER	ADDRESS	PARTIES OF INTEREST	MORTGAGE HOLDER	PARCEL SIZE (SQ. FT.)	PERMANENT EASEMENT (SQ. FT.)	TEMPORARY EASEMENT (SQ. FT.)	BRIDGEWAY EASEMENT (SQ. FT.)	DIFFERENTIAL EASEMENT (SQ. FT.)						
202	03-29-23-33-0024	1501 W. COUNTY ROAD C	COMMUNITY NATIONAL BANK		74853.31	1580	379								
203	03-29-23-33-0003	COUNTY ROAD C	NORTH PRIDE LLC	QATREX III - CF LENDER, LLC NATIONAL CITY BANK OF MICHIGAN/ILLINOIS	647095.43	2383	1992								
204	03-29-23-34-0098	2550 PASCAL AVENUE NORTH	SHIRLEY M. FELZER		10443.71	852	276								
205	03-29-23-34-0097	1448 TALSMAN CURVE	CHRISTINE E. THOMPSON	PRIVENTURE FUNDING ASSOC. TCF NATIONAL BANK	10373.50	849	324								
206	03-29-23-43-0096	1438 TALSMAN CURVE	ALFRED HERNANDEZ MRS. ALFRED HERNANDEZ ROBERTA A. HERNANDEZ		10398.86	817	779	100							
207	03-29-23-34-0095	1432 TALSMAN CURVE	DARREN A. CEDAR MRS. DARREN A. CEDAR PATRICIA L. CEDAR	MORTGAGES UNLIMITED, INC. ENERGY FAMILY FUND ABS AND MORTGAGE GROUP, INC.	10400.10	312	845								
208	03-29-23-34-0094	1428 TALSMAN CURVE	LORNA S. CLUCK	COUNTRYWIDE HOME LOANS, INC. AMERICA'S WHOLESALE LENDER CORP.	10400.04	504	818								
209	03-29-23-34-0093	1420 TALSMAN CURVE	PATRICE L. TUM		10999.74	313	621								
210	03-29-23-34-0092	1412 TALSMAN CURVE	WAYNE LOUIS HERNAN MRS. WAYNE LOUIS HERNAN MAURICE MAE HERNAN		13058.59	60	524								
211	03-29-23-34-0091	1404 TALSMAN CURVE	MARION M. ELSCHMIDT		14199.65		424								
212	03-29-23-34-0090	1398 TALSMAN CURVE	SABAH M. LEONARD	AMERICAN RESIDENTIAL MORTGAGE LP	18780.81		56								
219	11-29-23-22-0001	2630 LEXINGTON AVENUE	MATTHEW D. ALEXANDER STEPHANIE HIRSCH	NATIONAL CITY BANK	21035.15	2856	2567								
220	03-29-23-33-0018		JULIENNOTI NORTHERN BALBOAD		43038.38	113	3279								
221	02-29-23-33-0053	2644 LEXINGTON AVENUE	GEORGE J. RELING		51345.00			600							
					TOTALS	18029	12883	150	600						
										</					

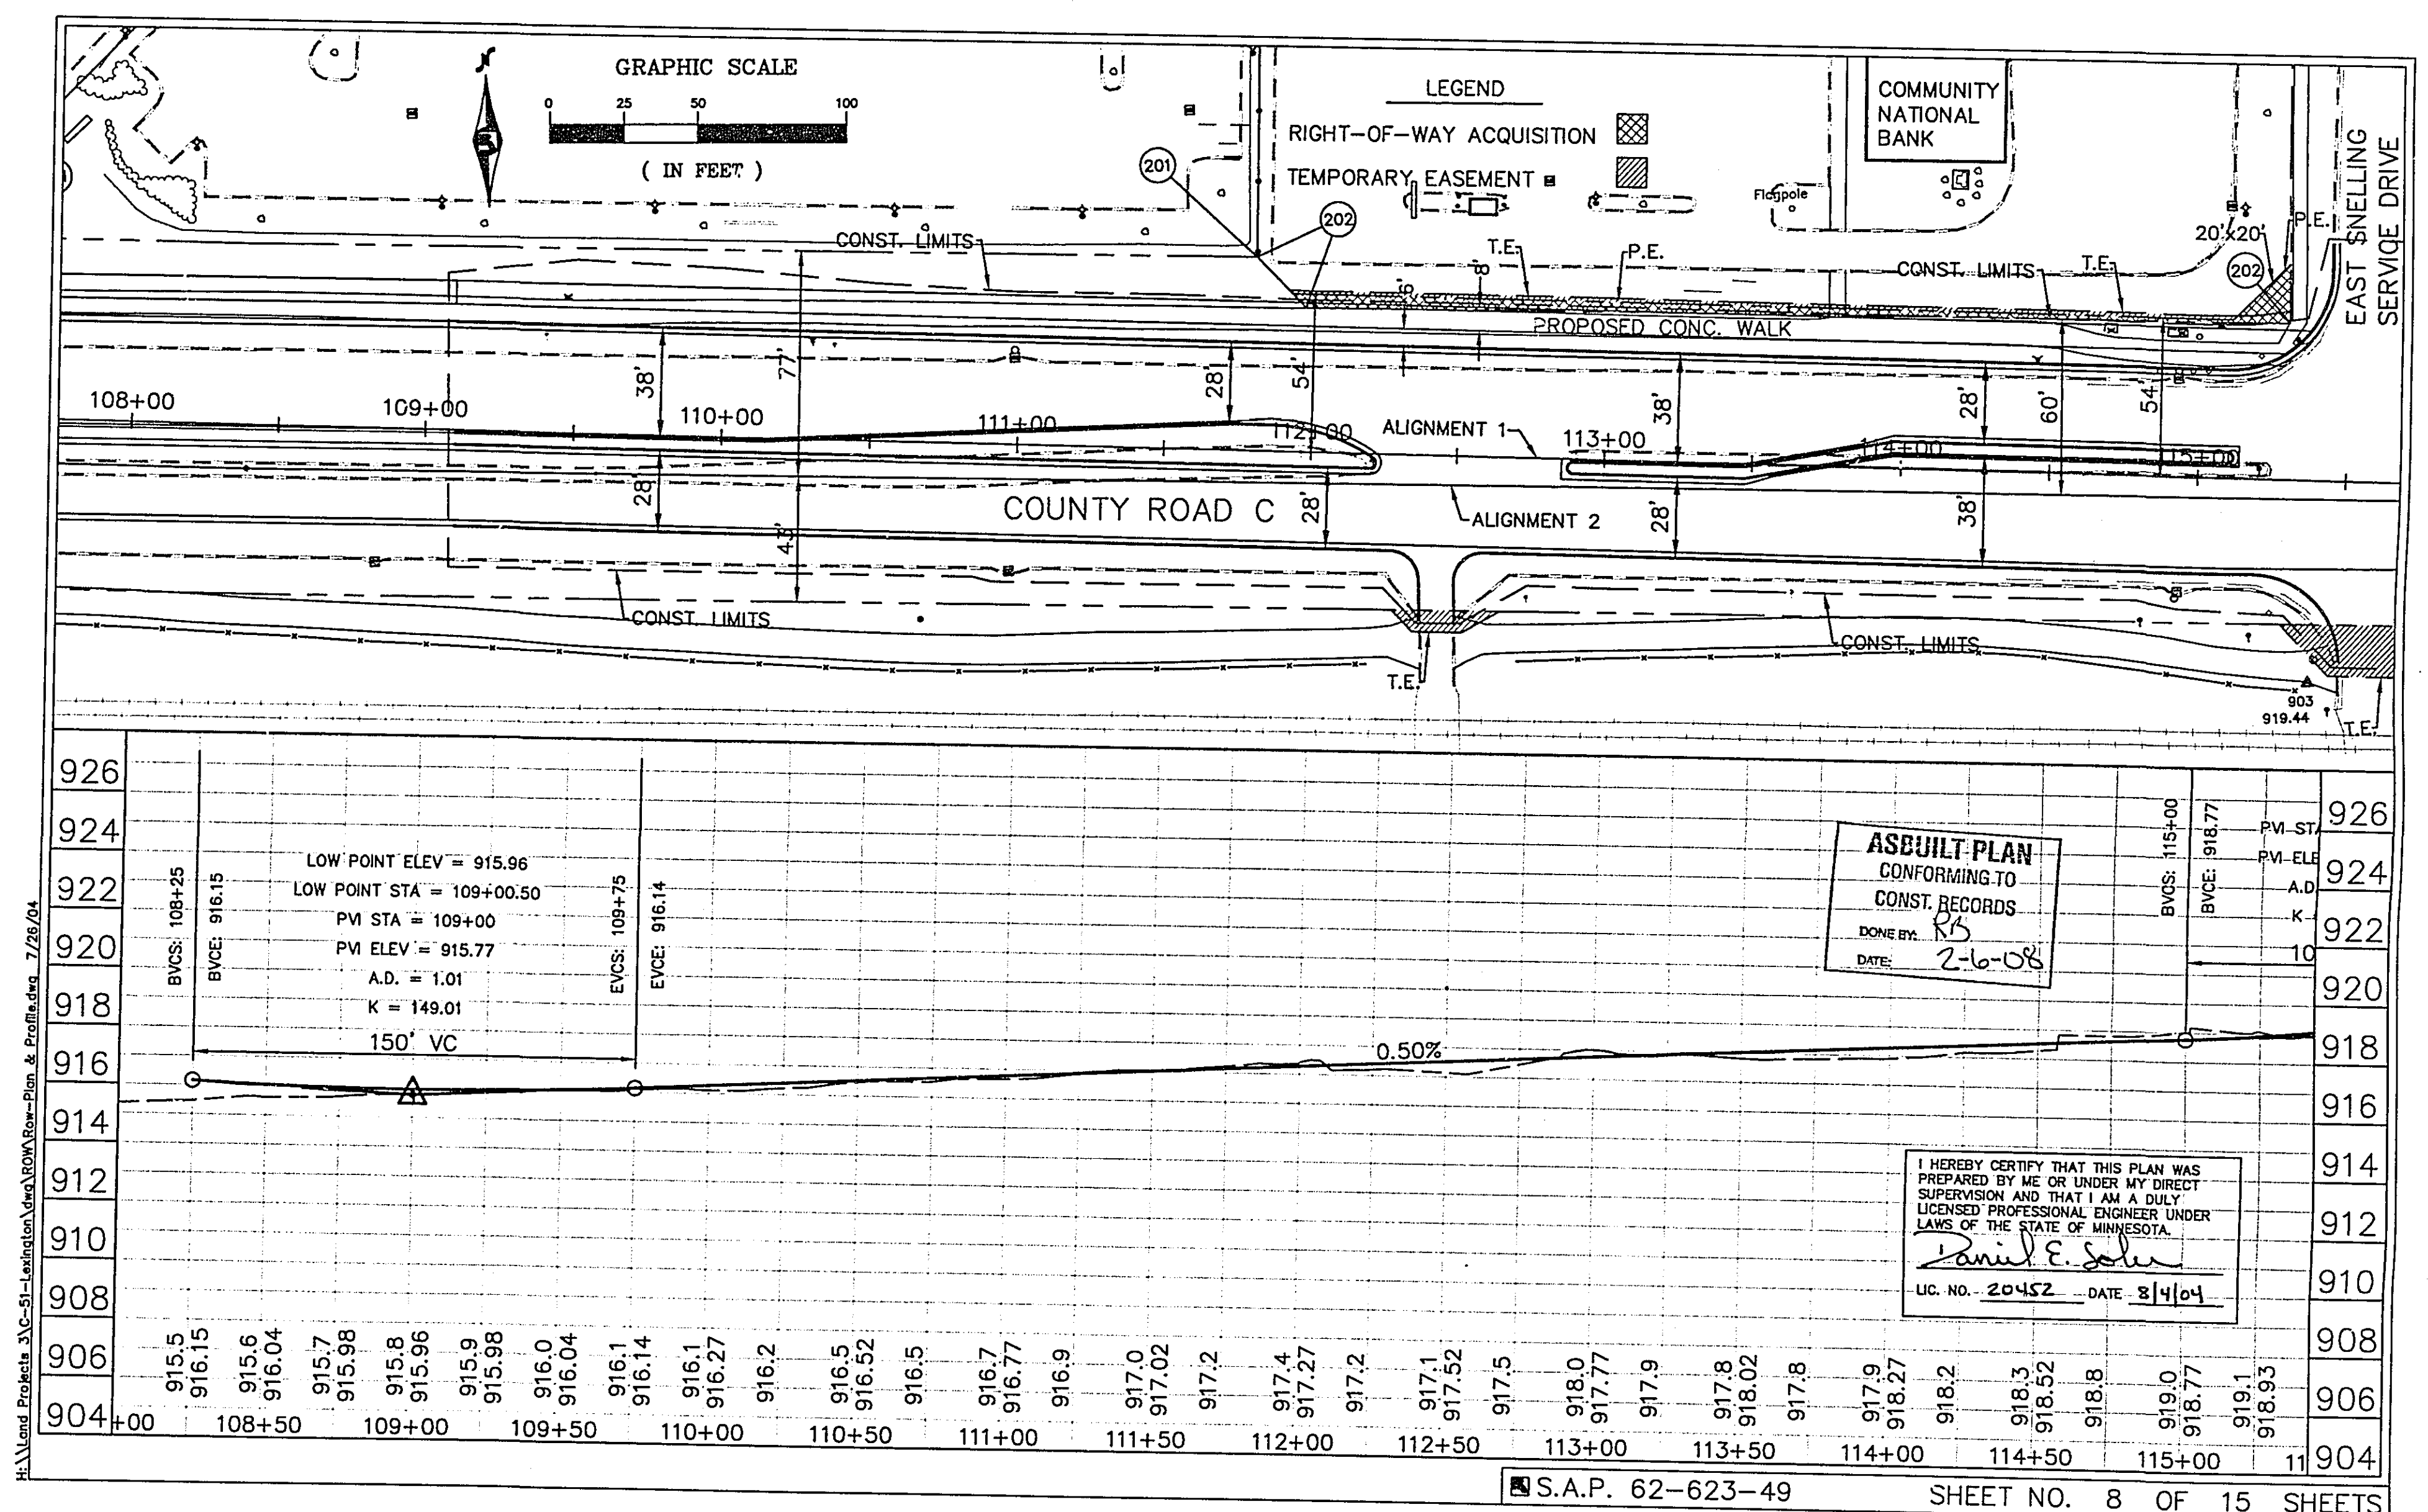


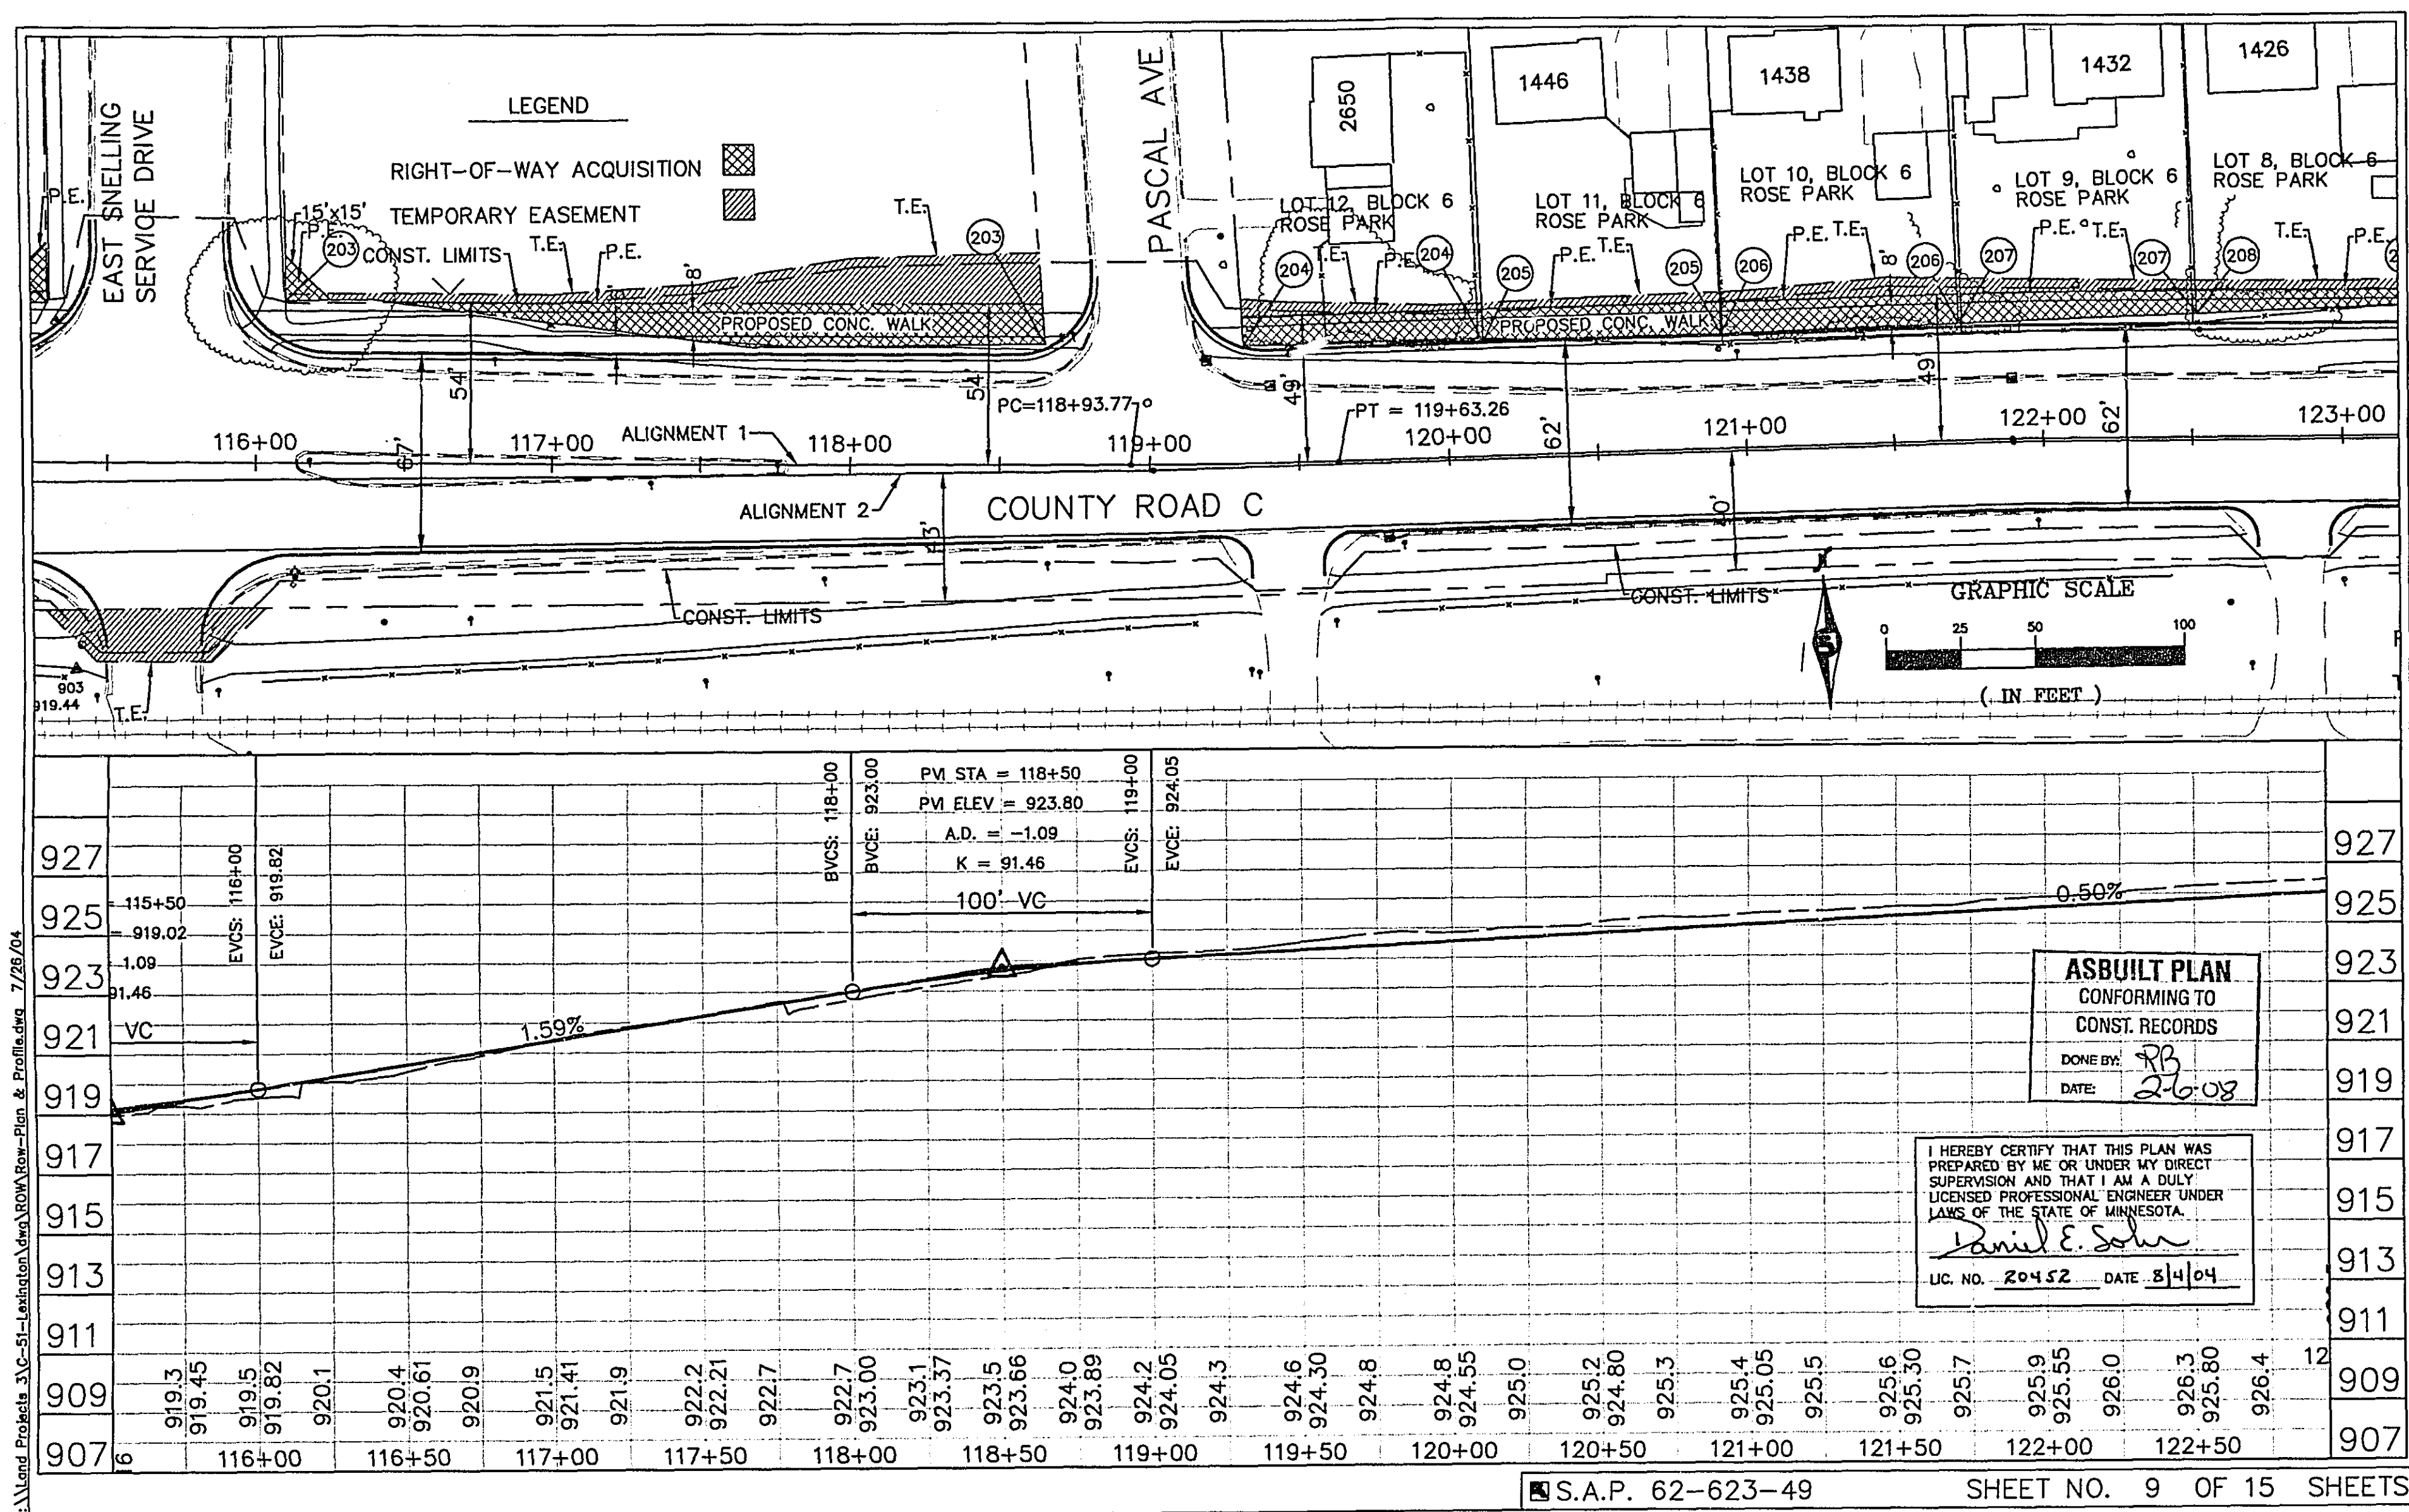


28-216

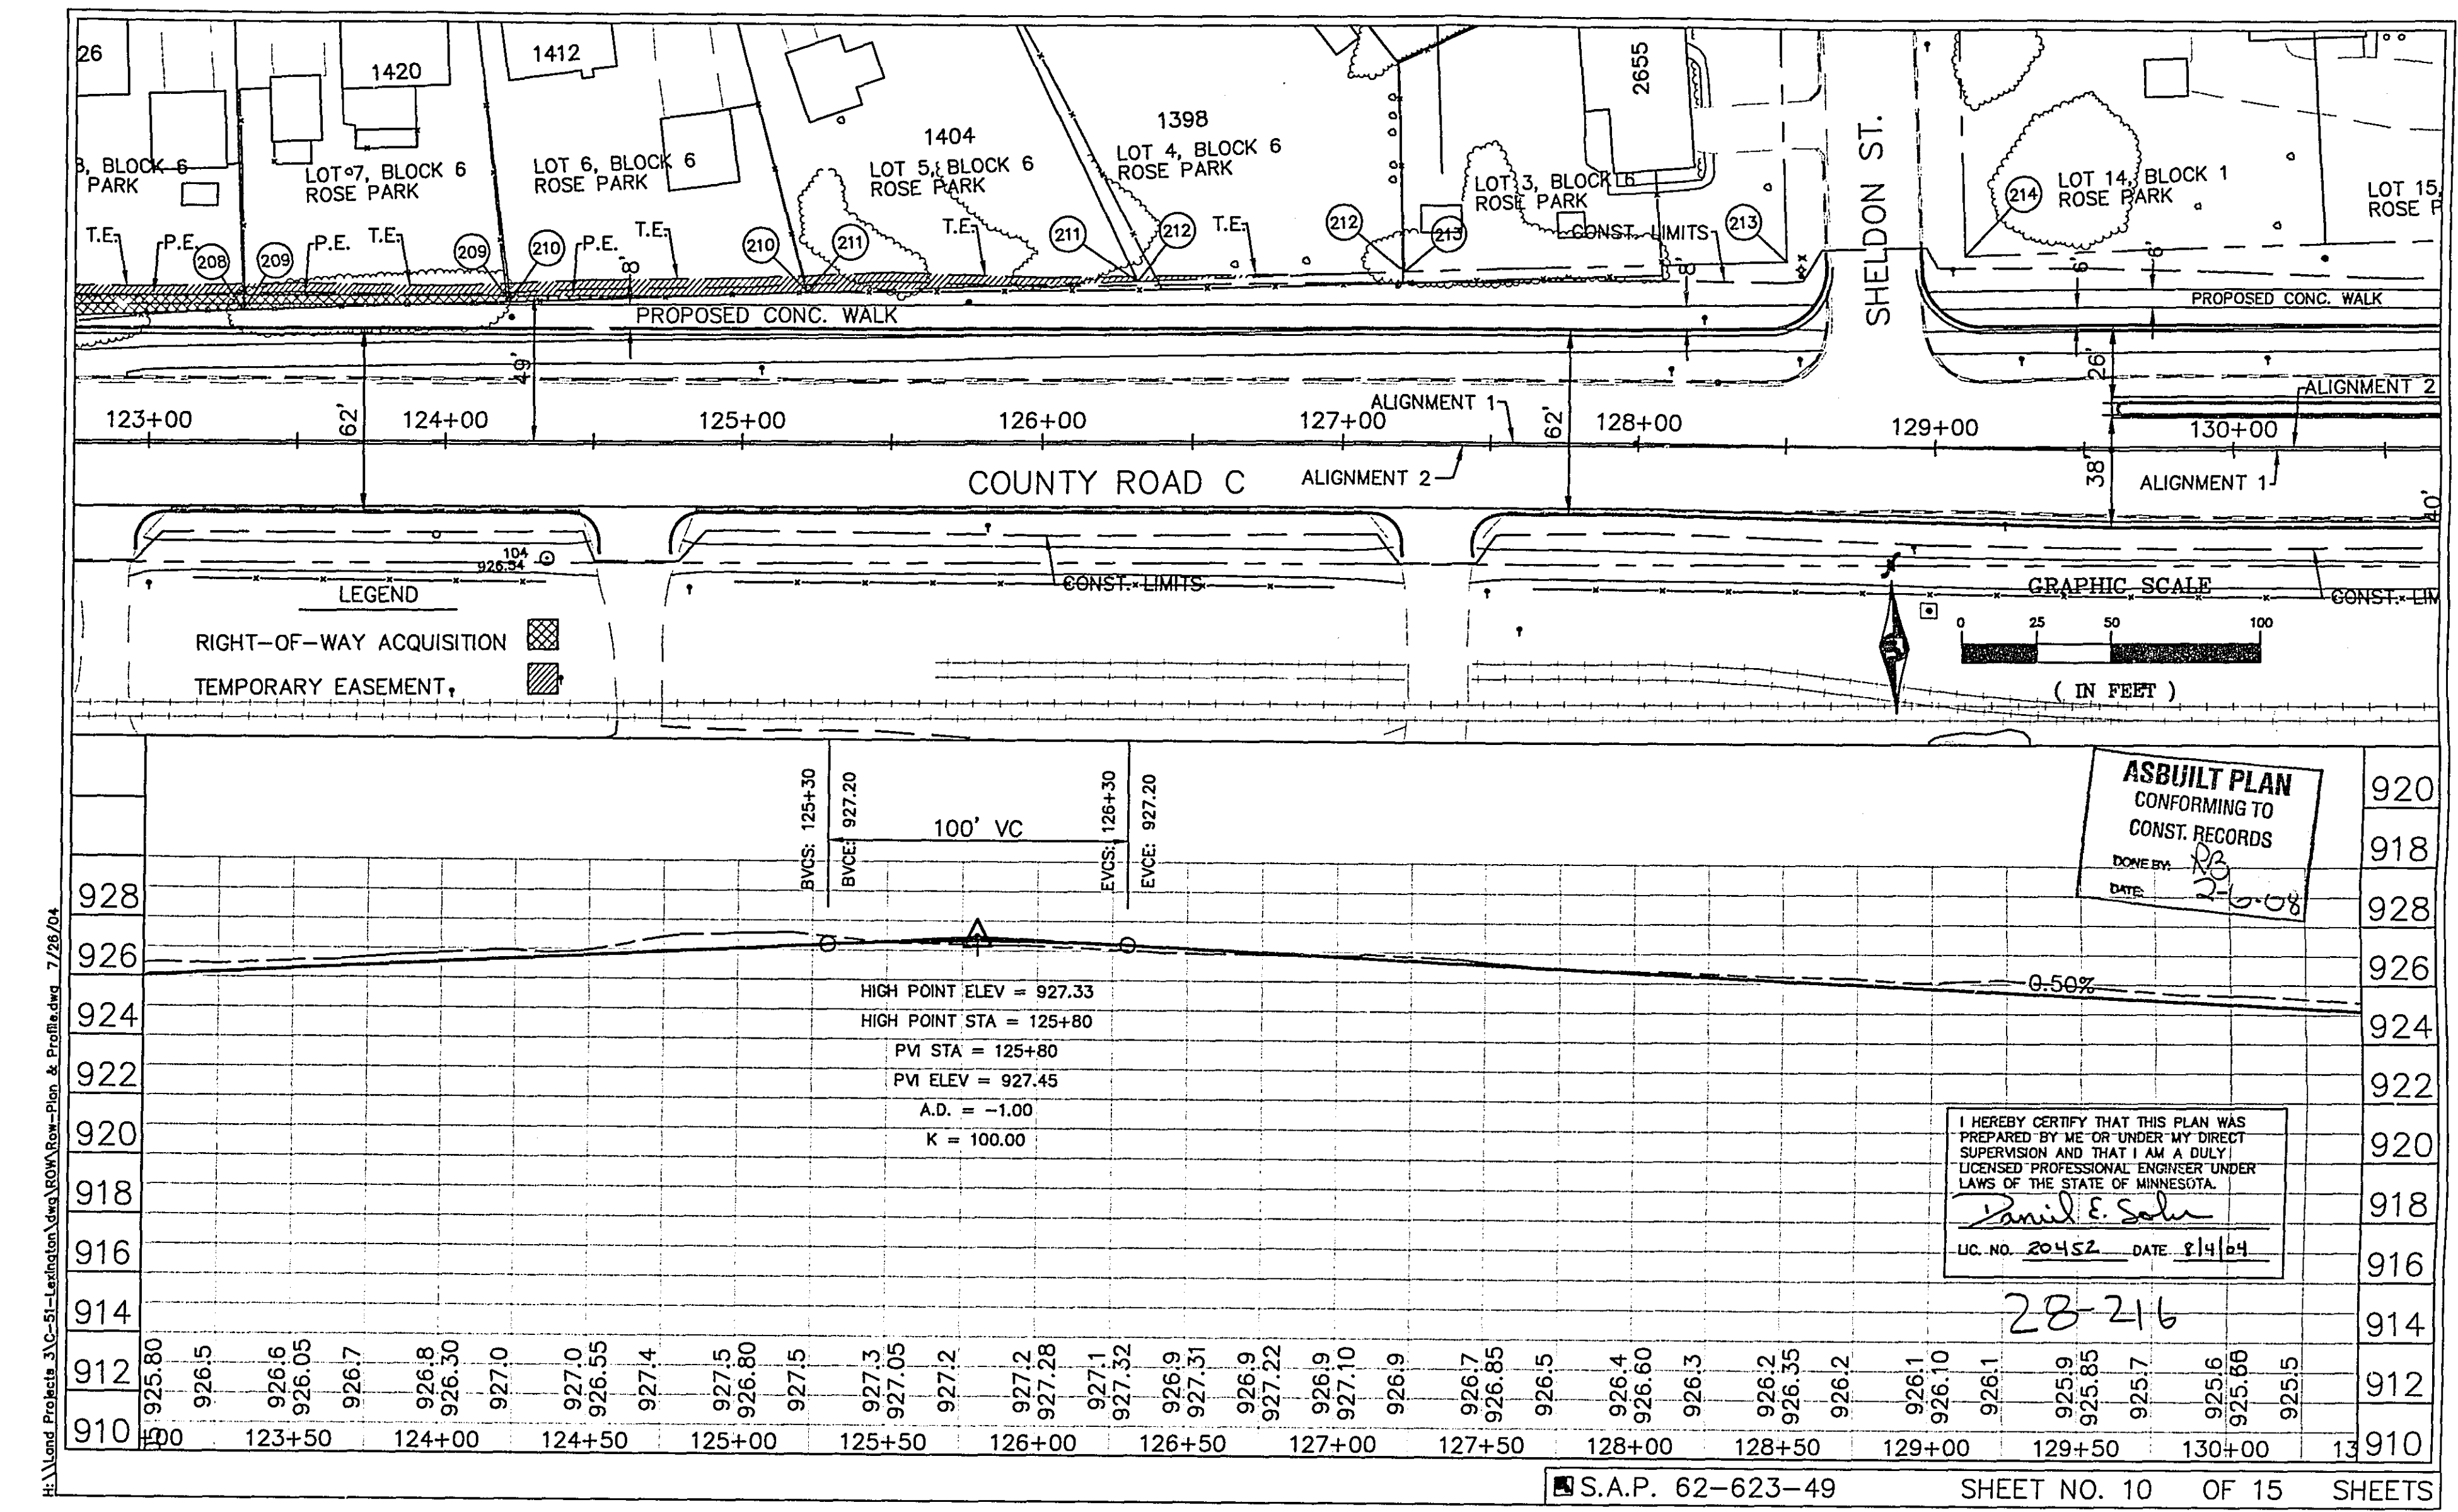




28-216

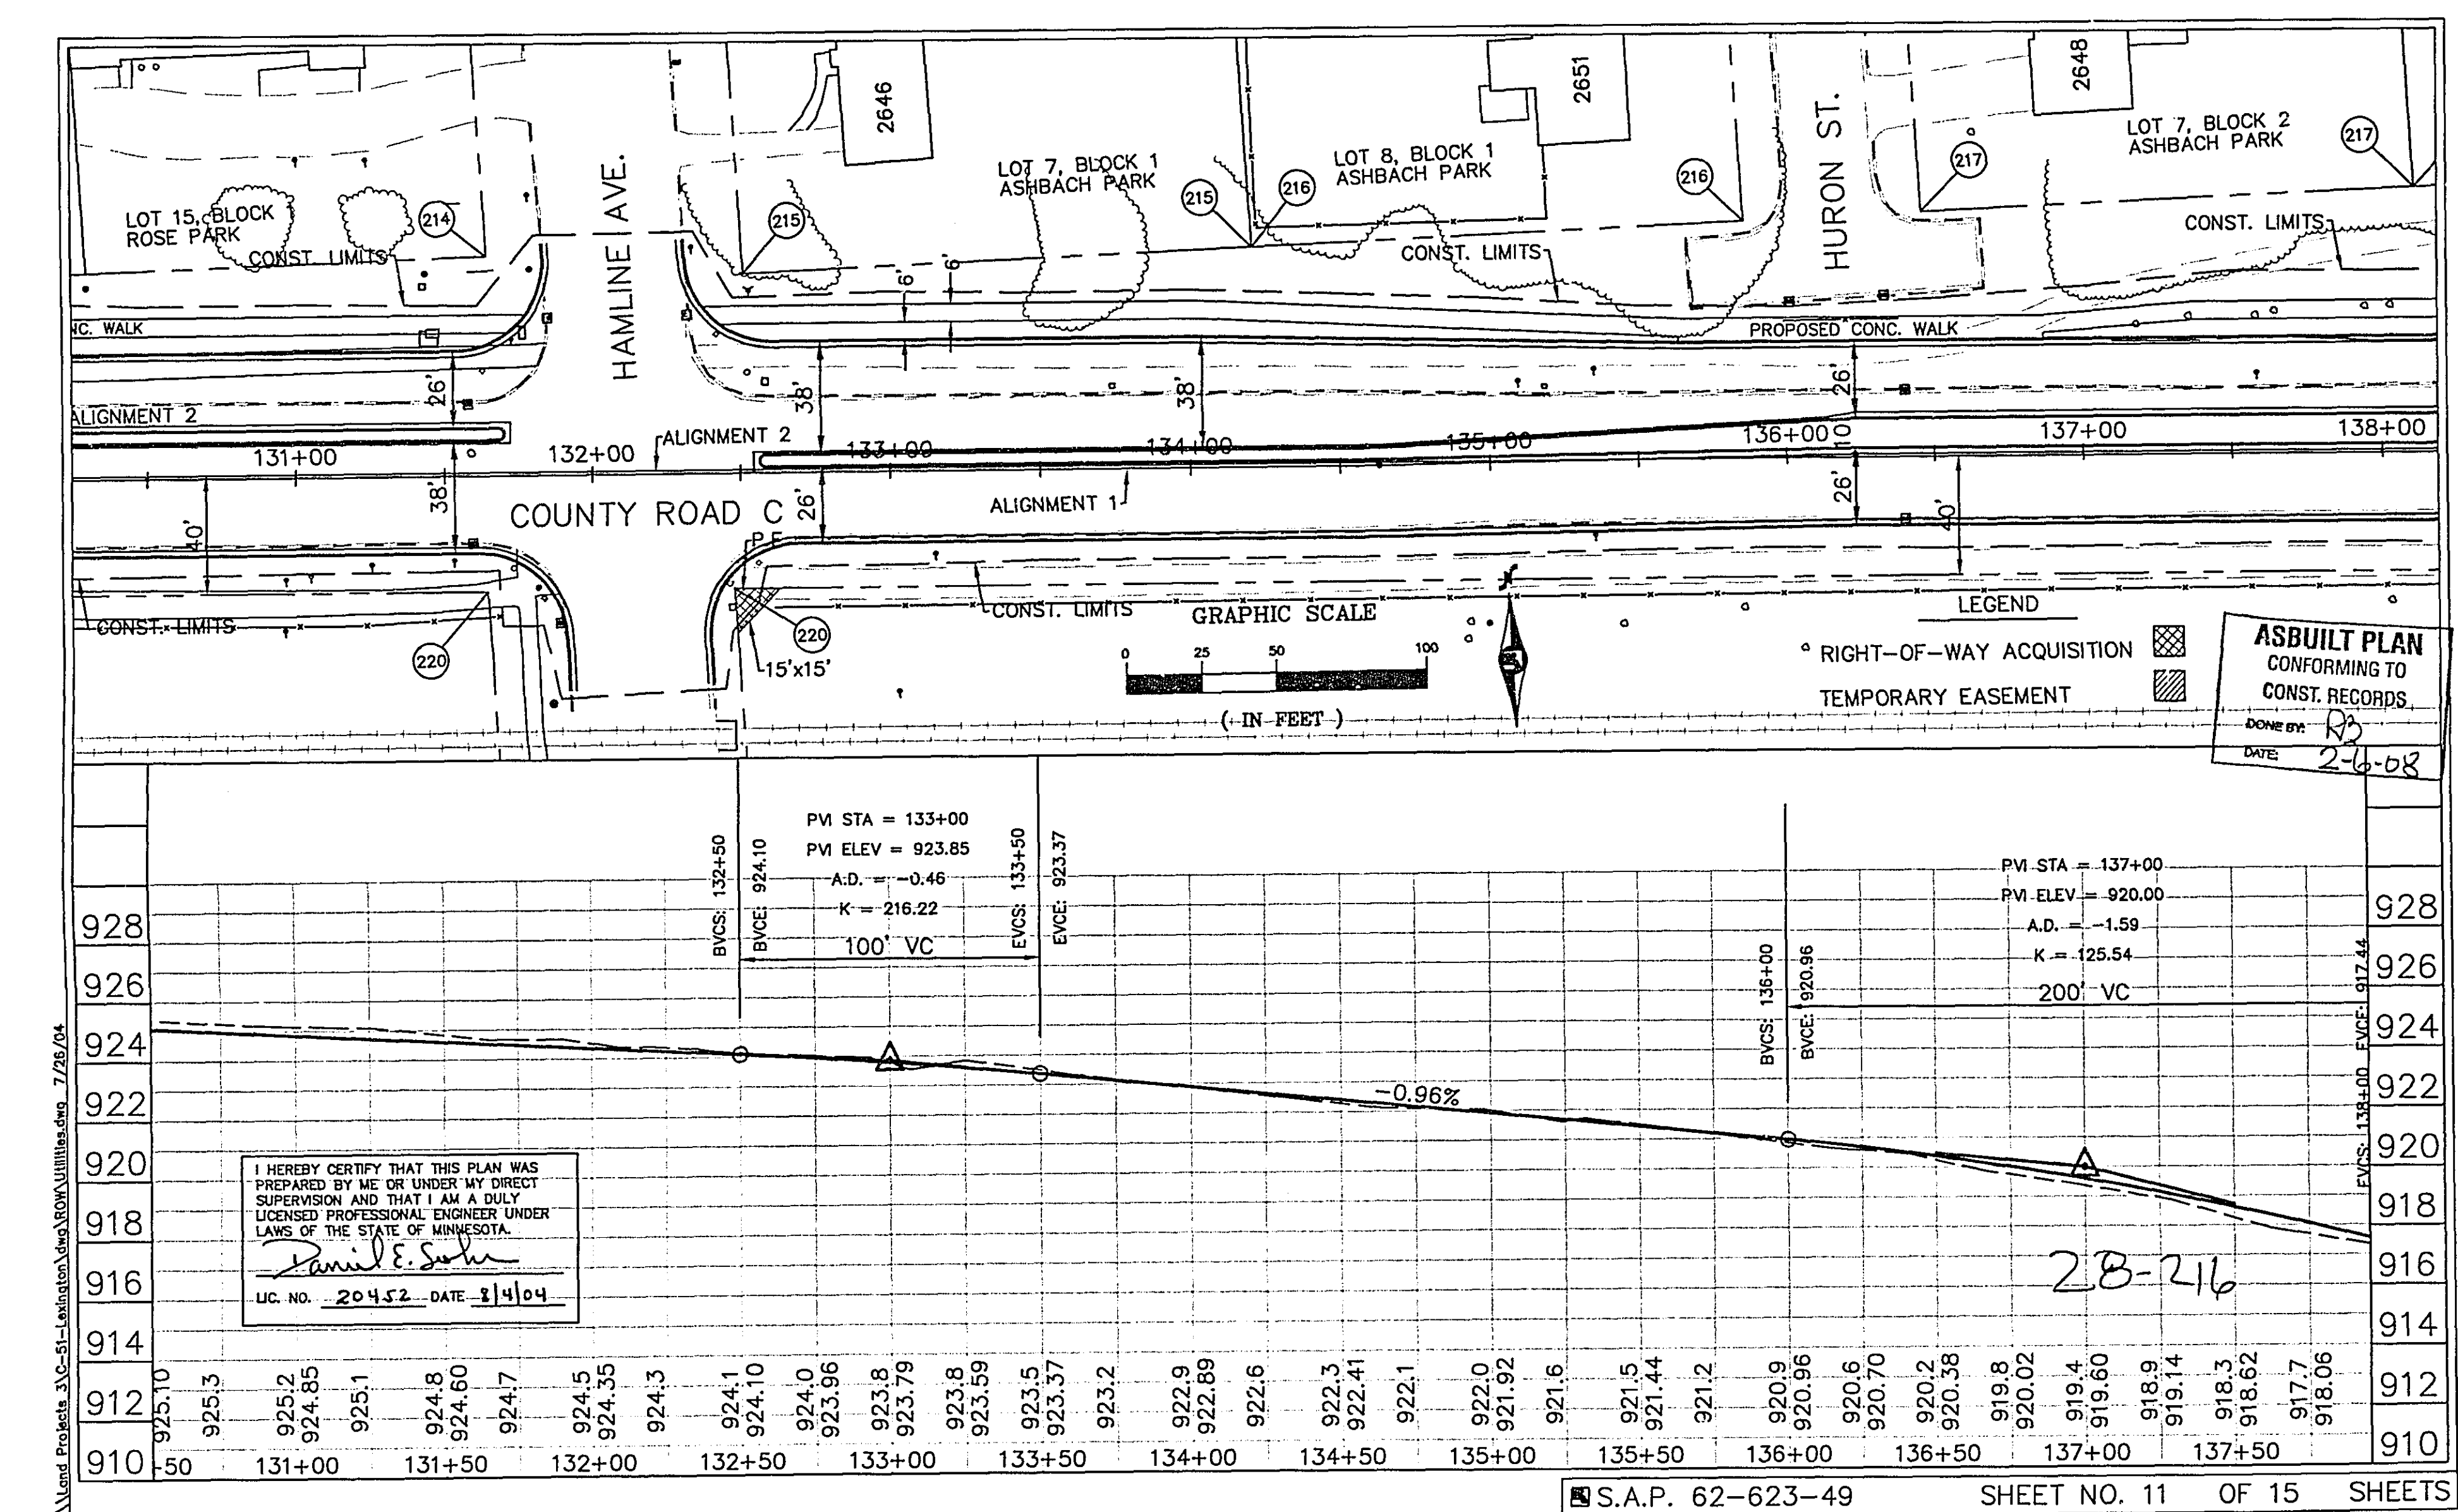

28-216

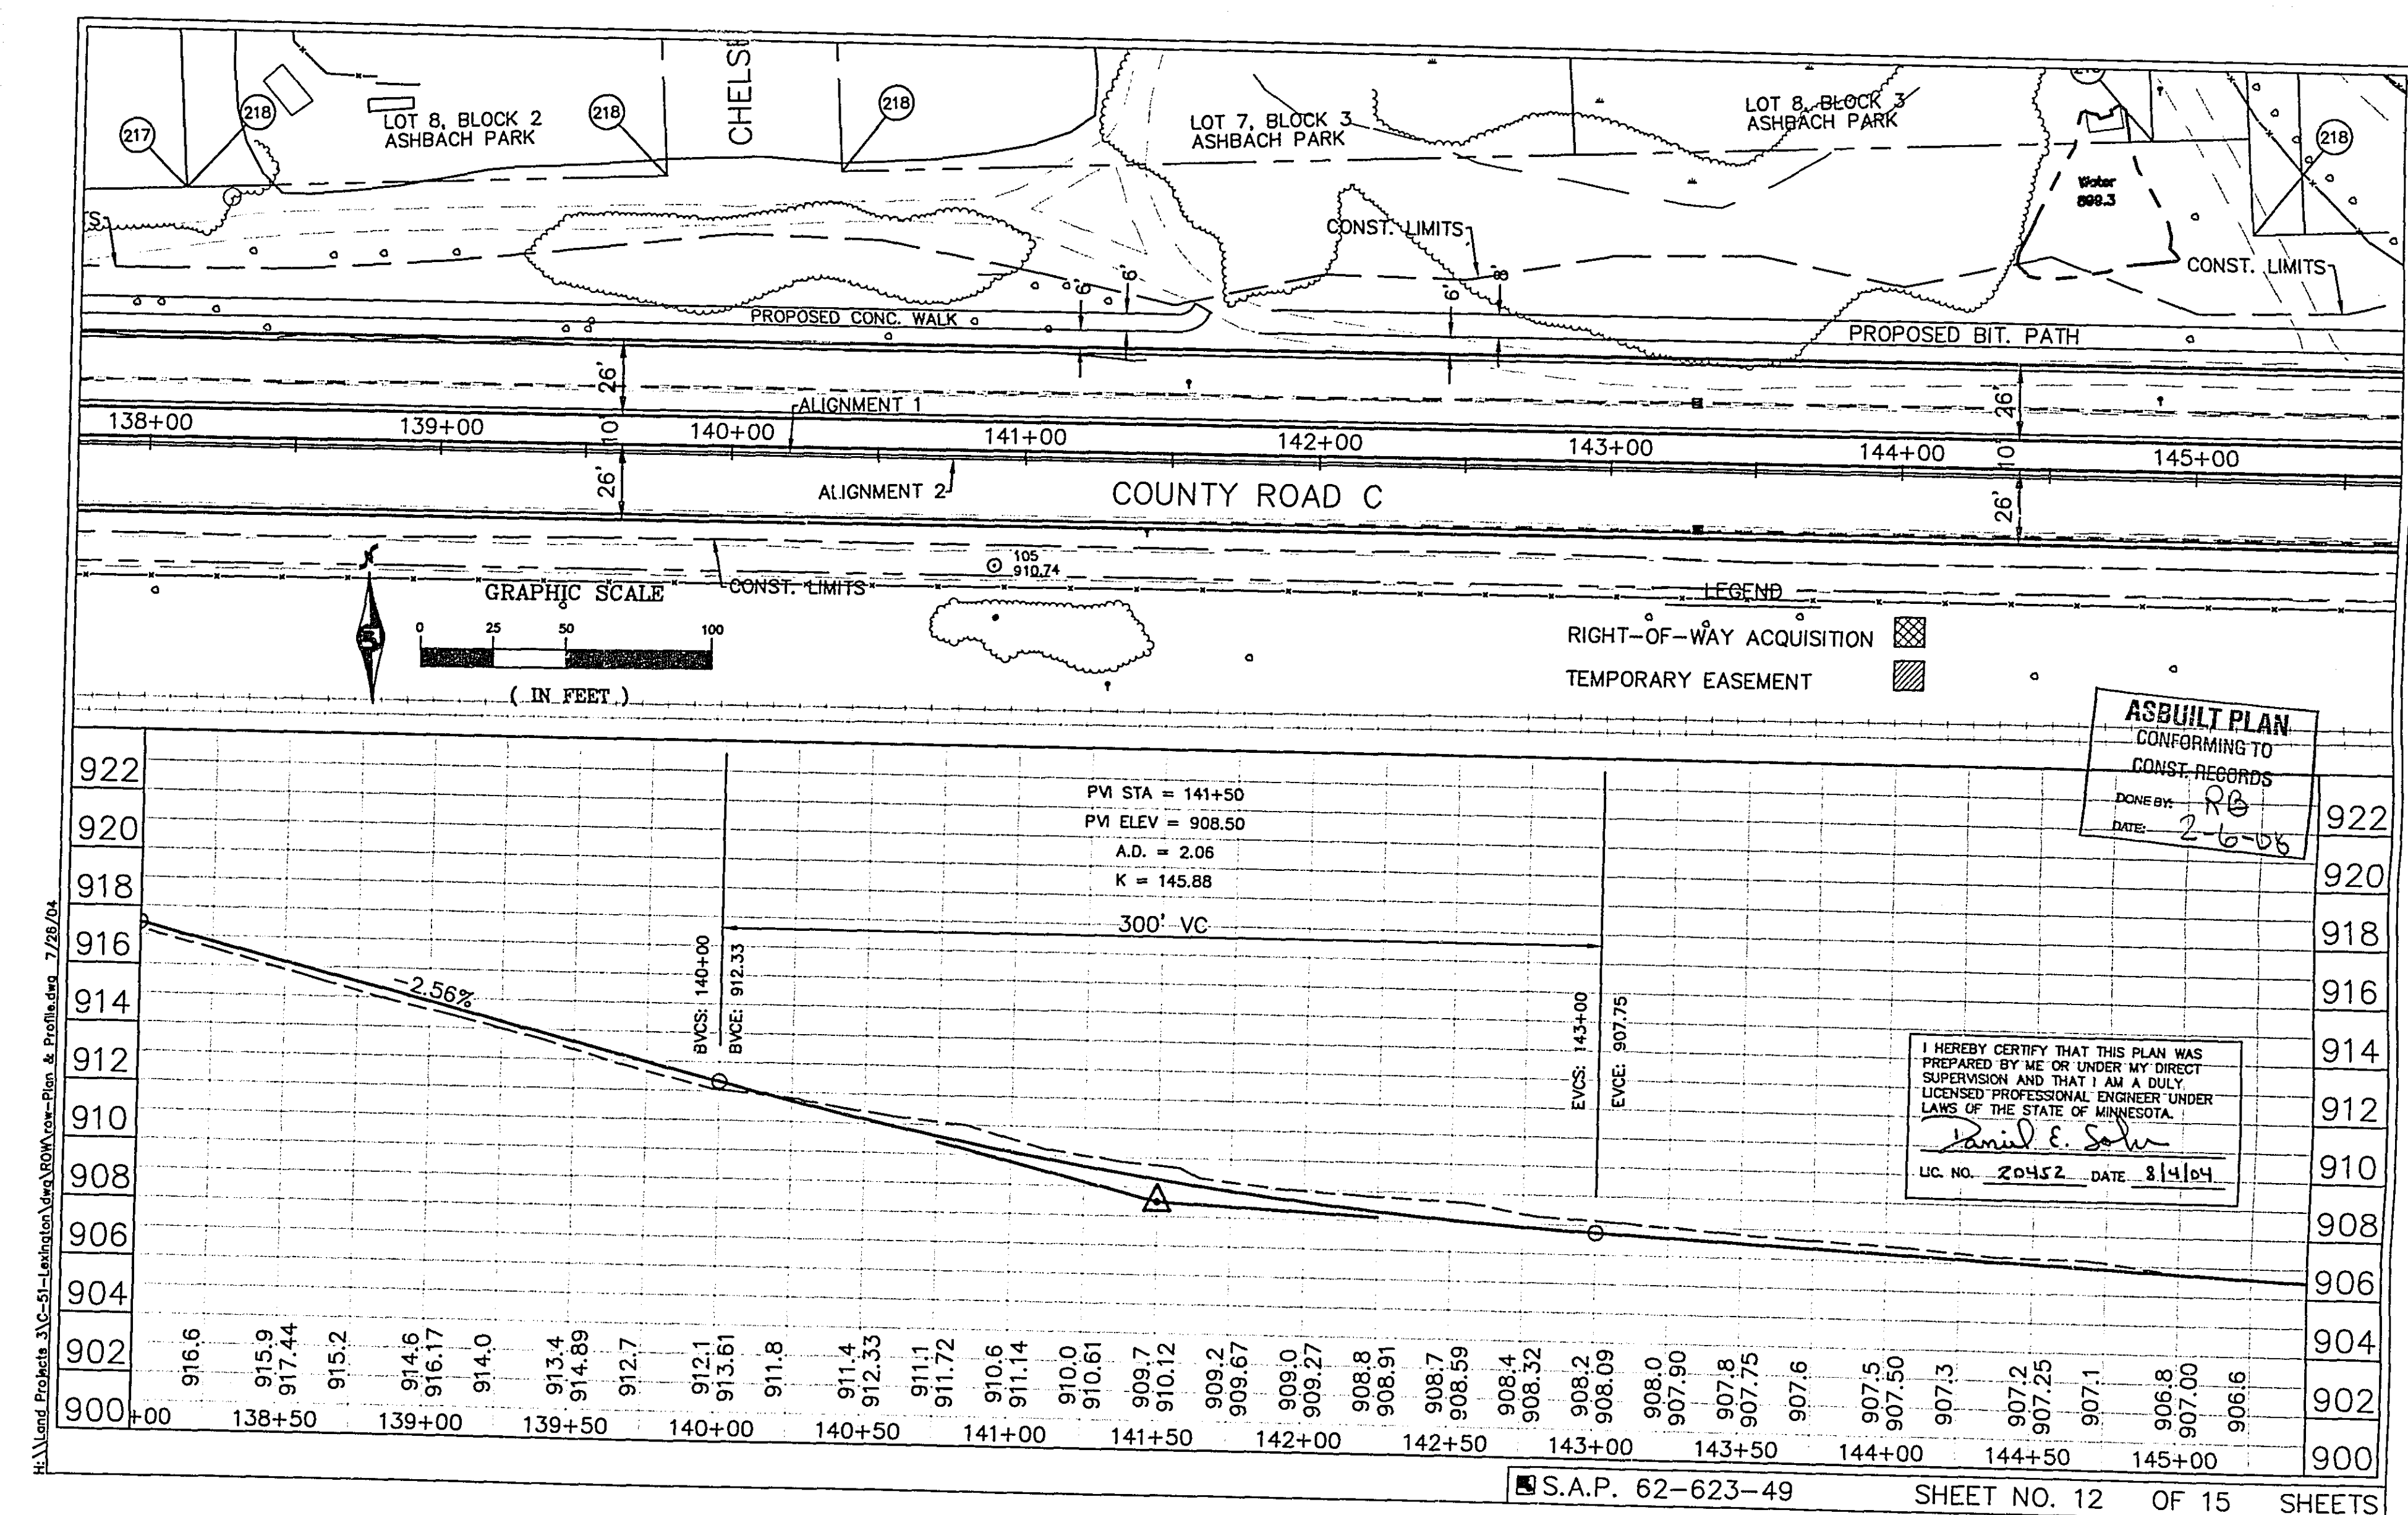

28-216

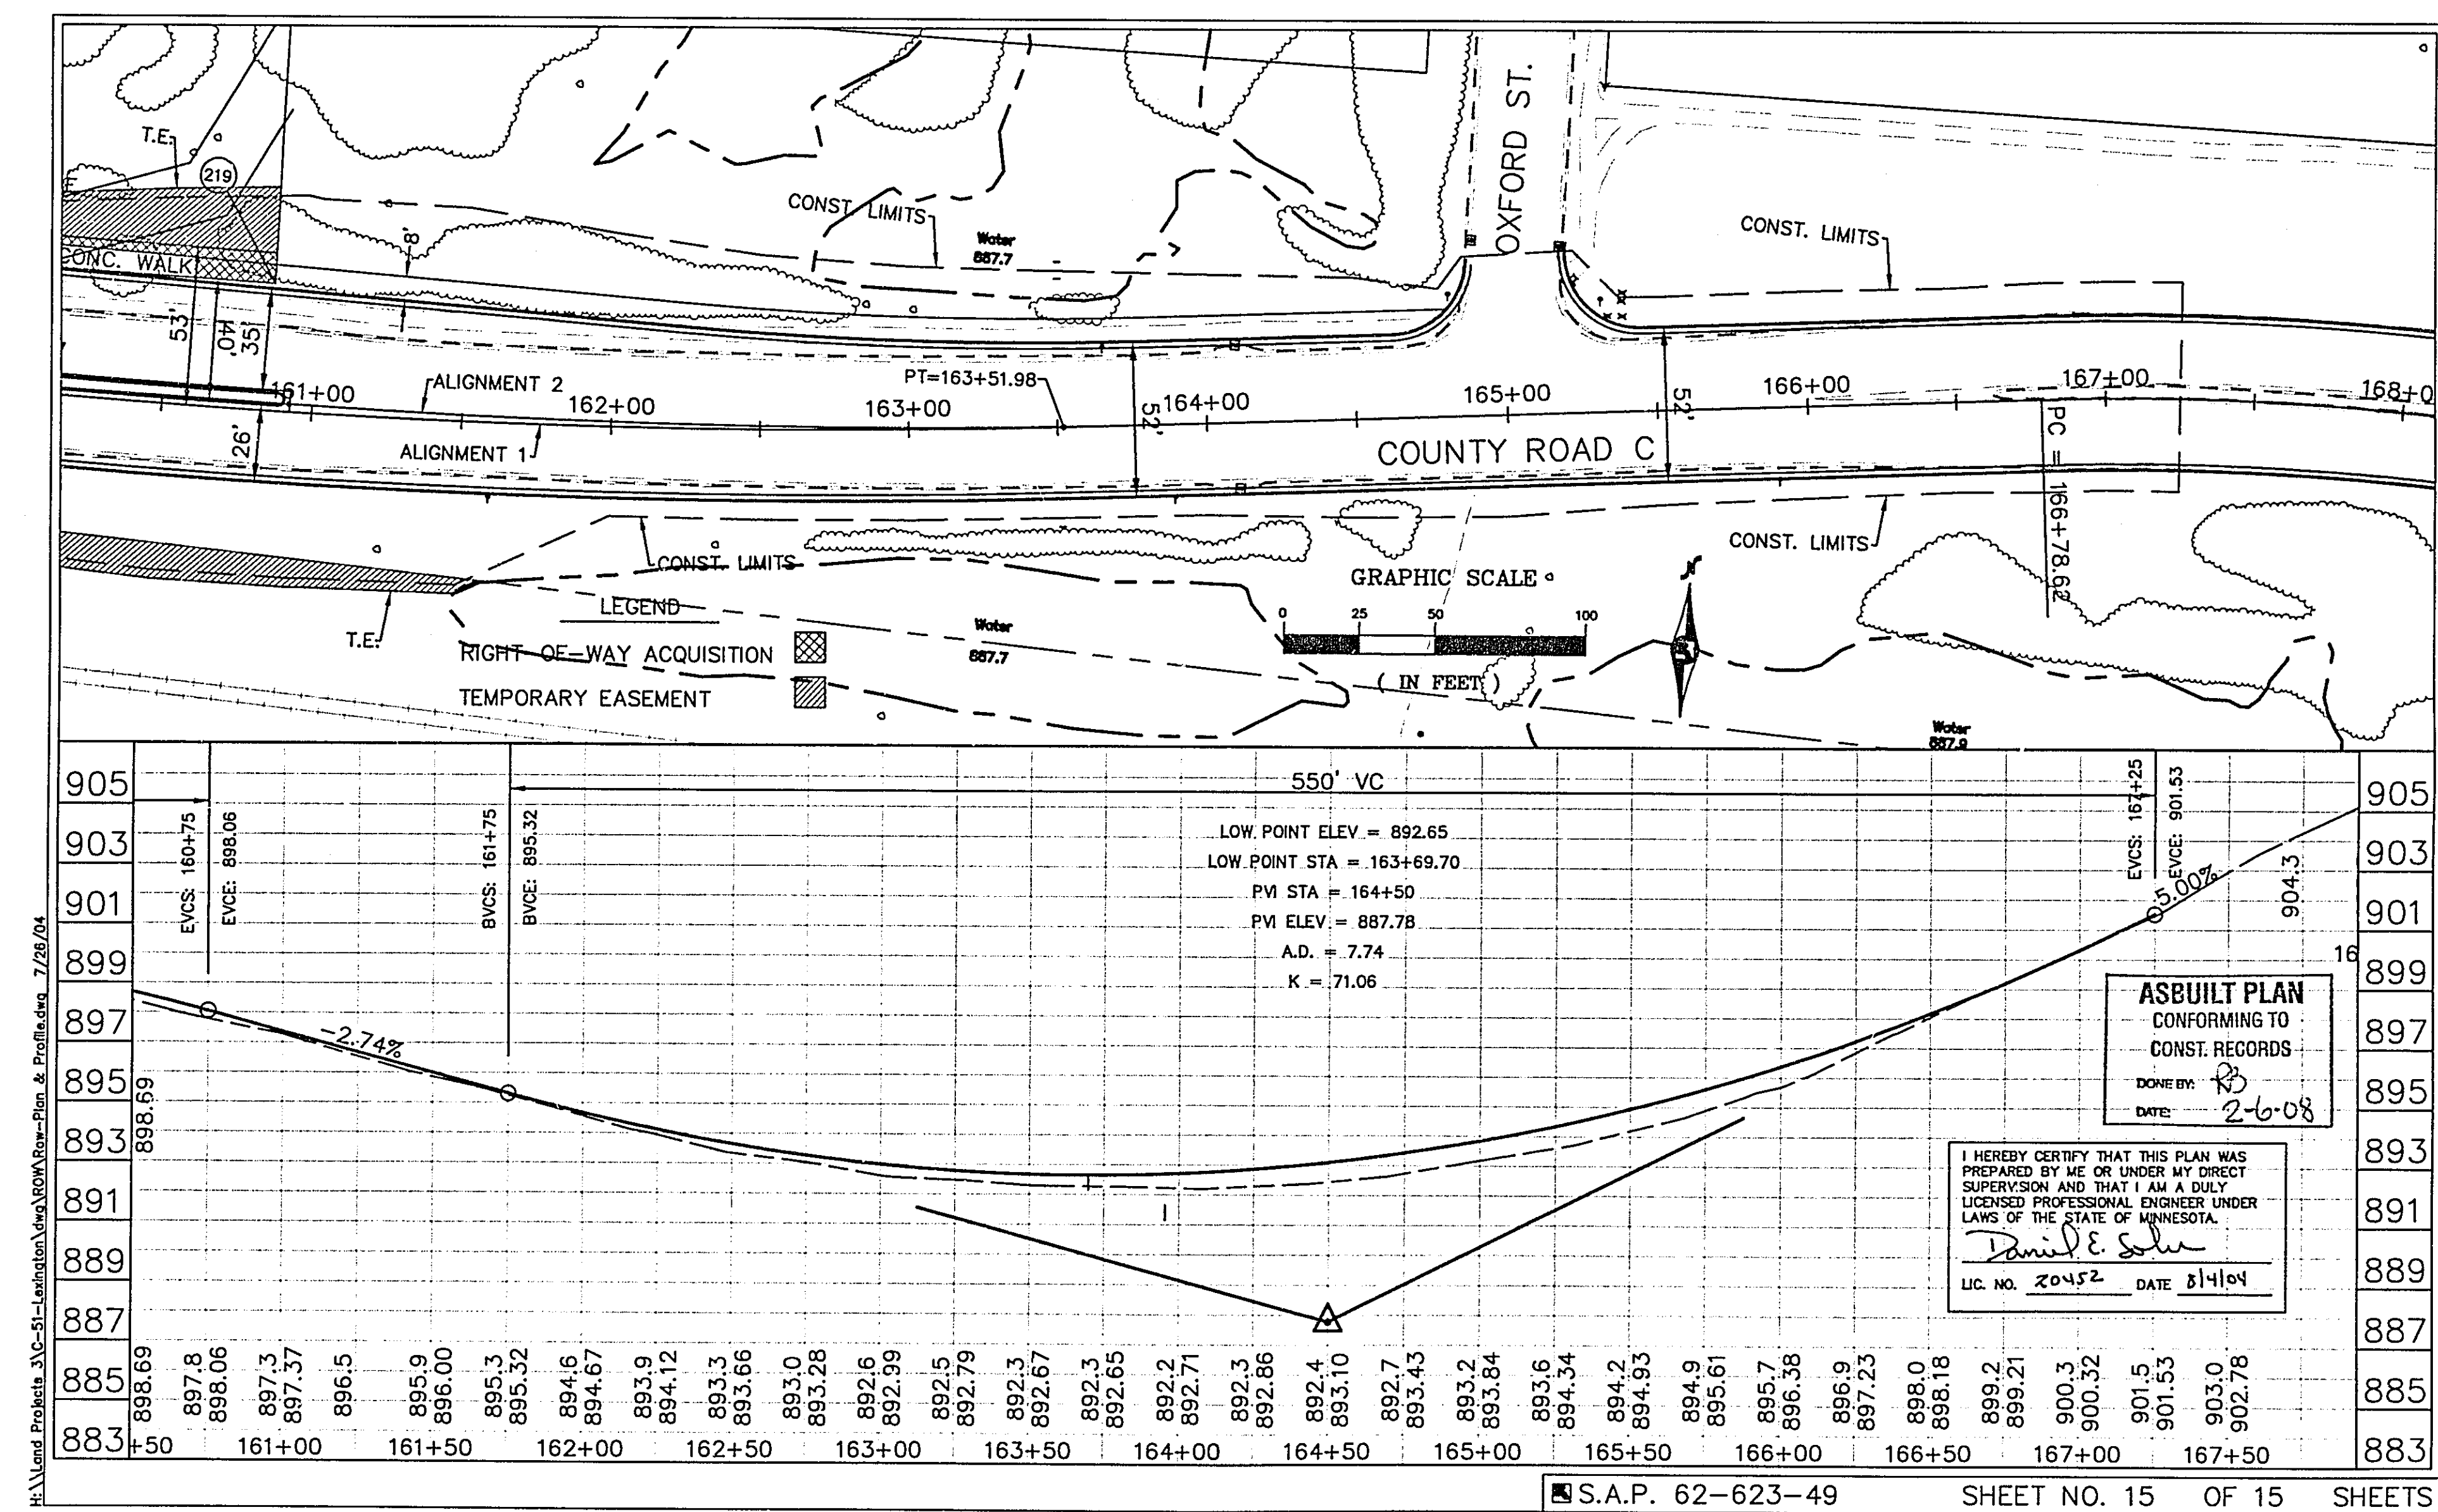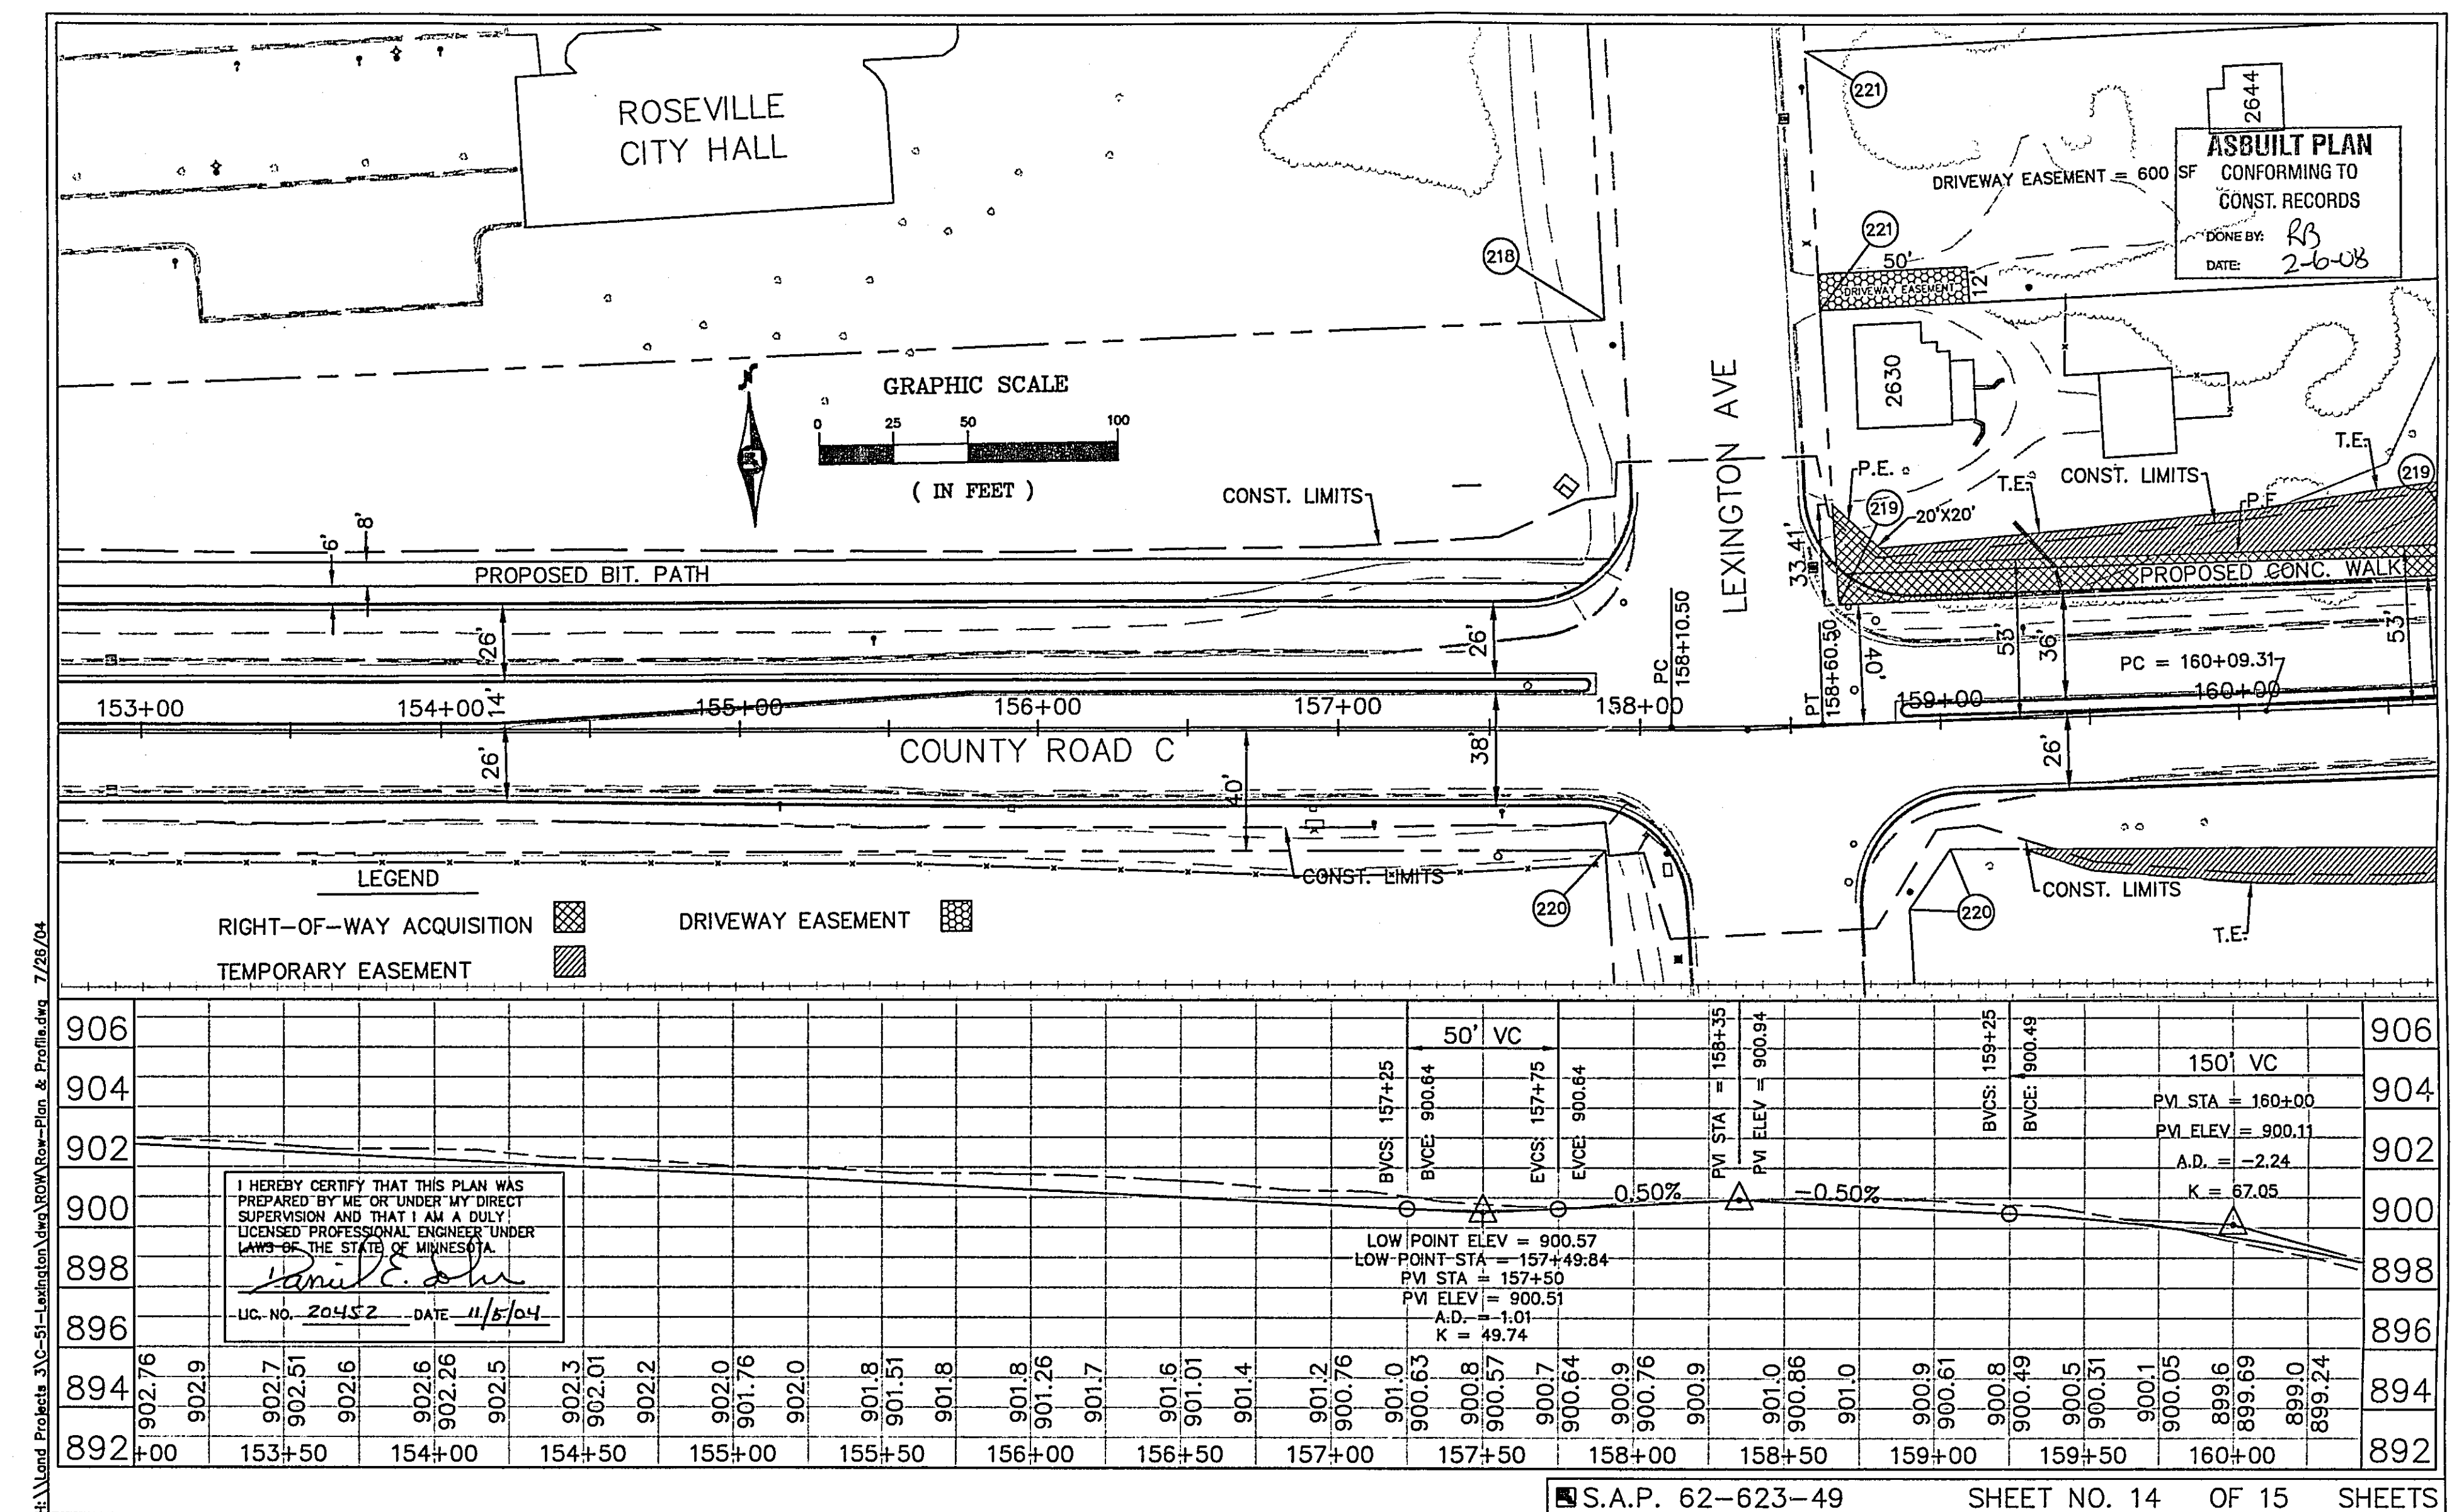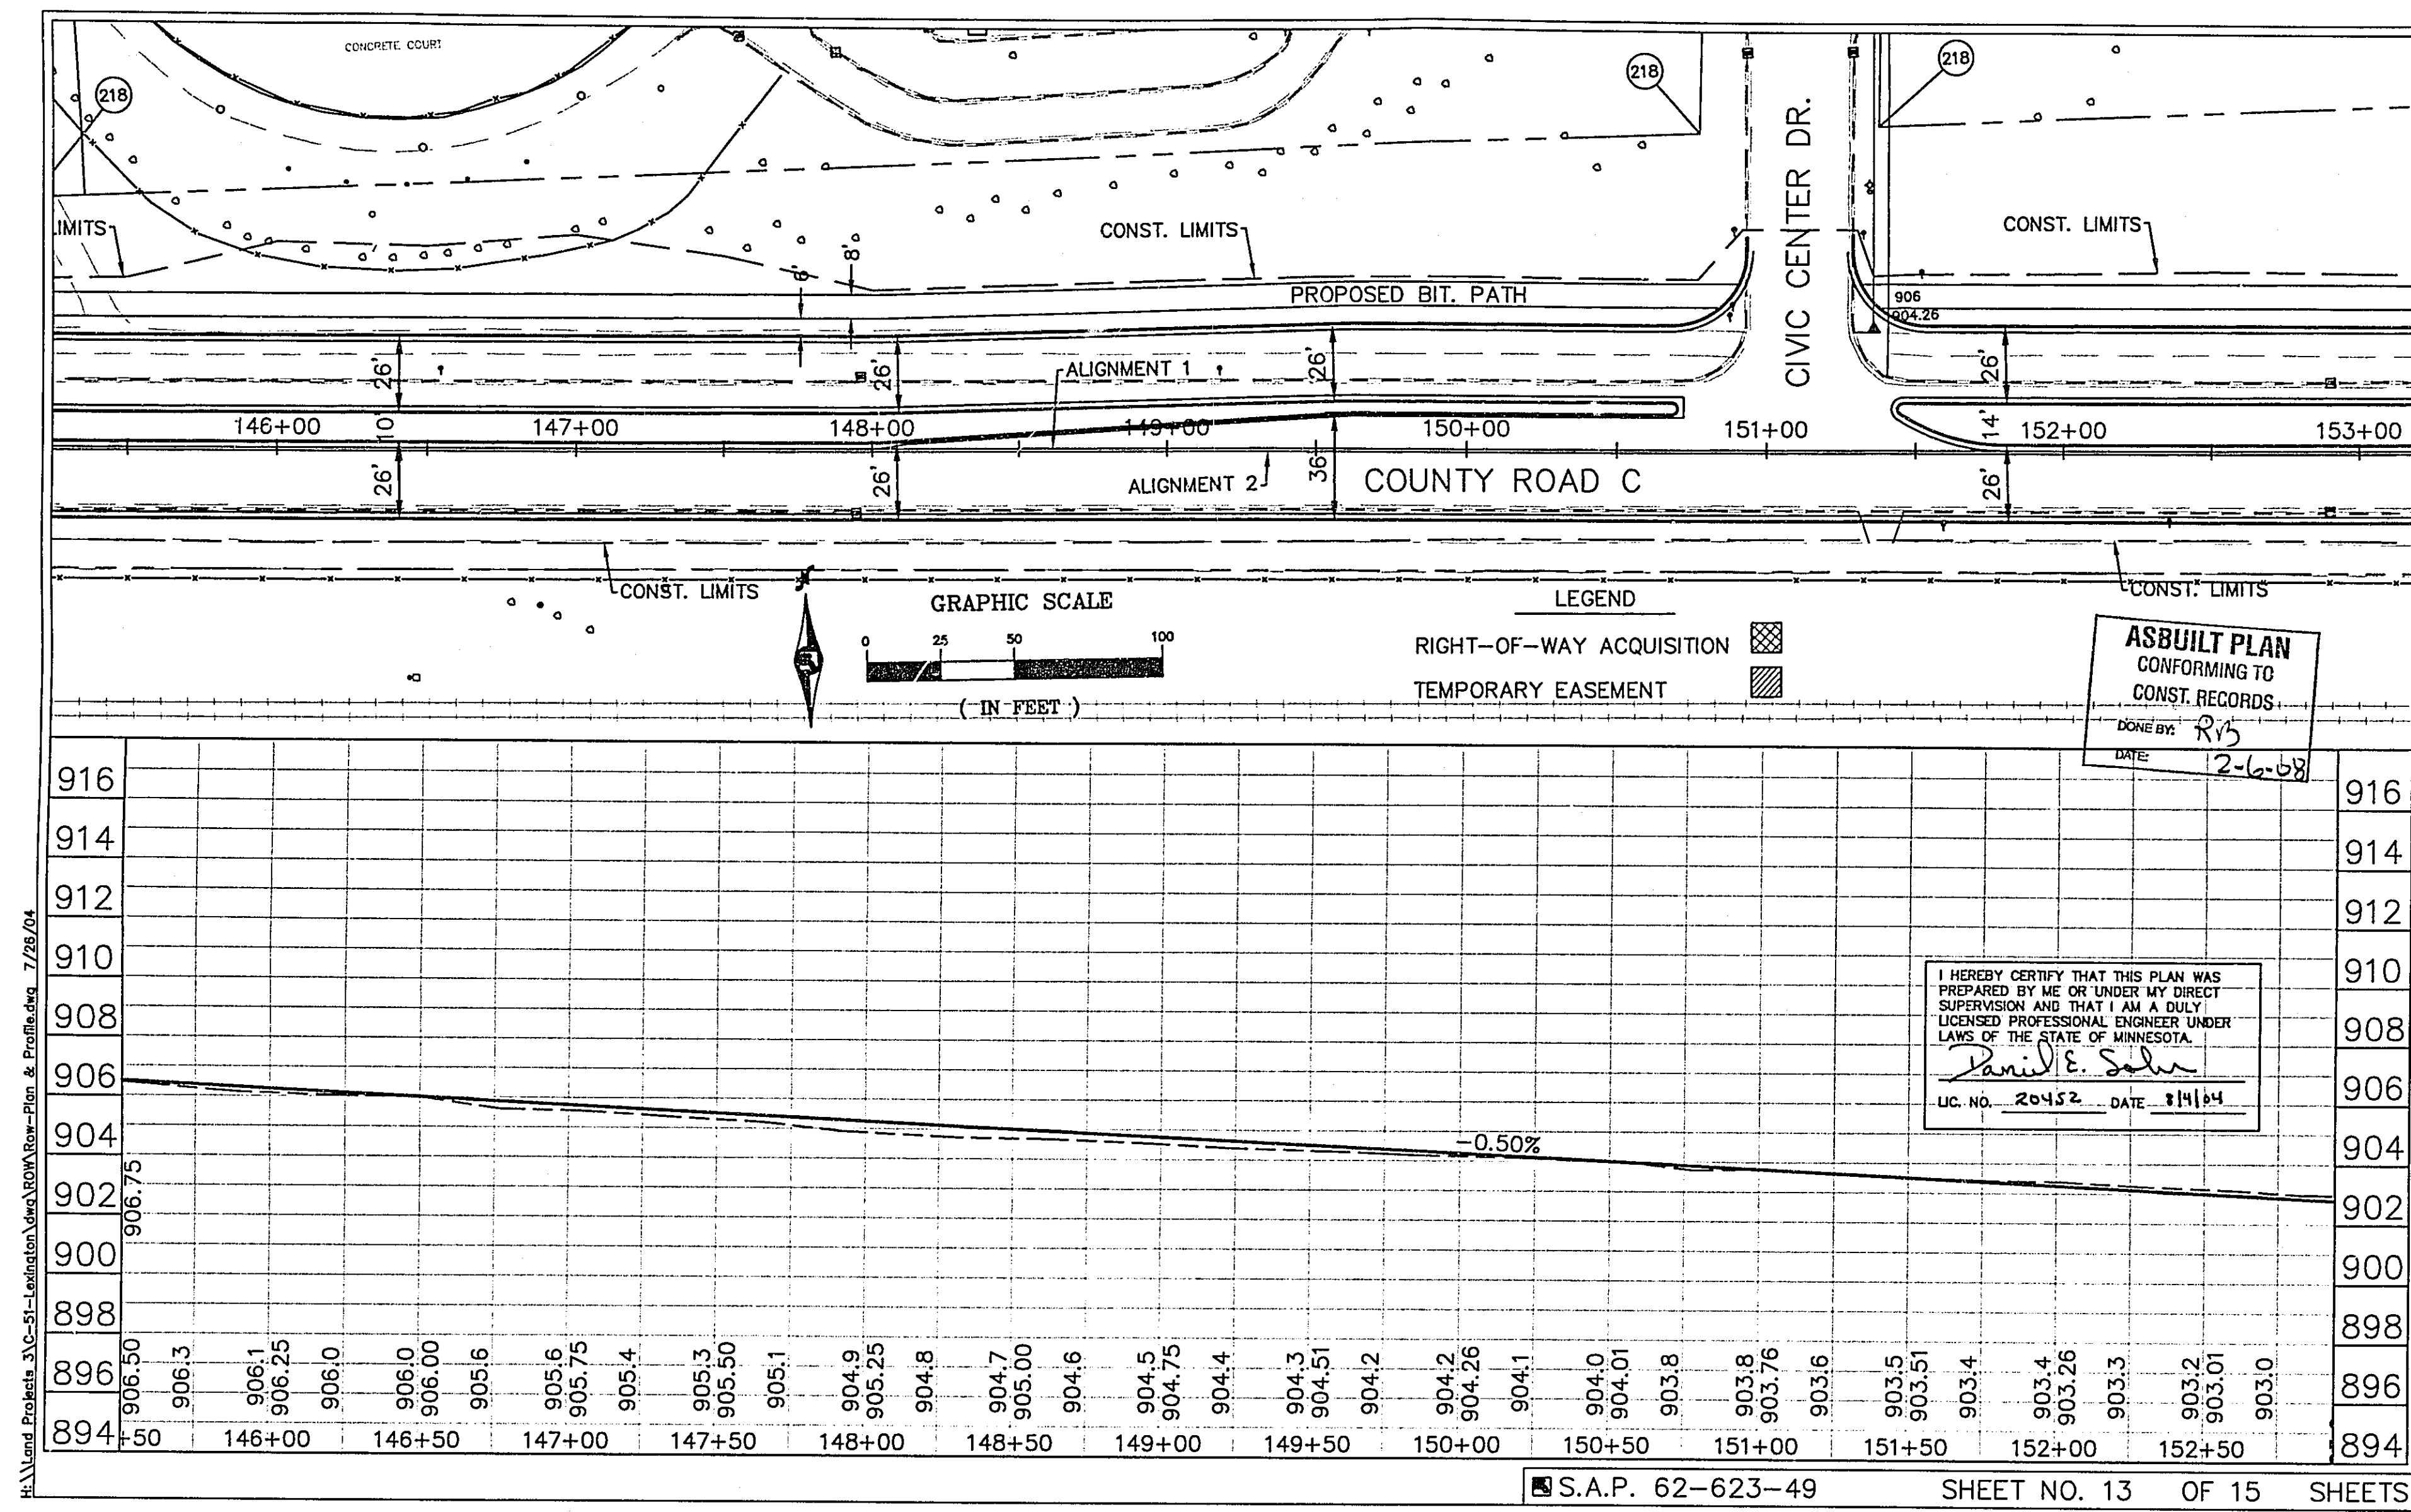

28-216