


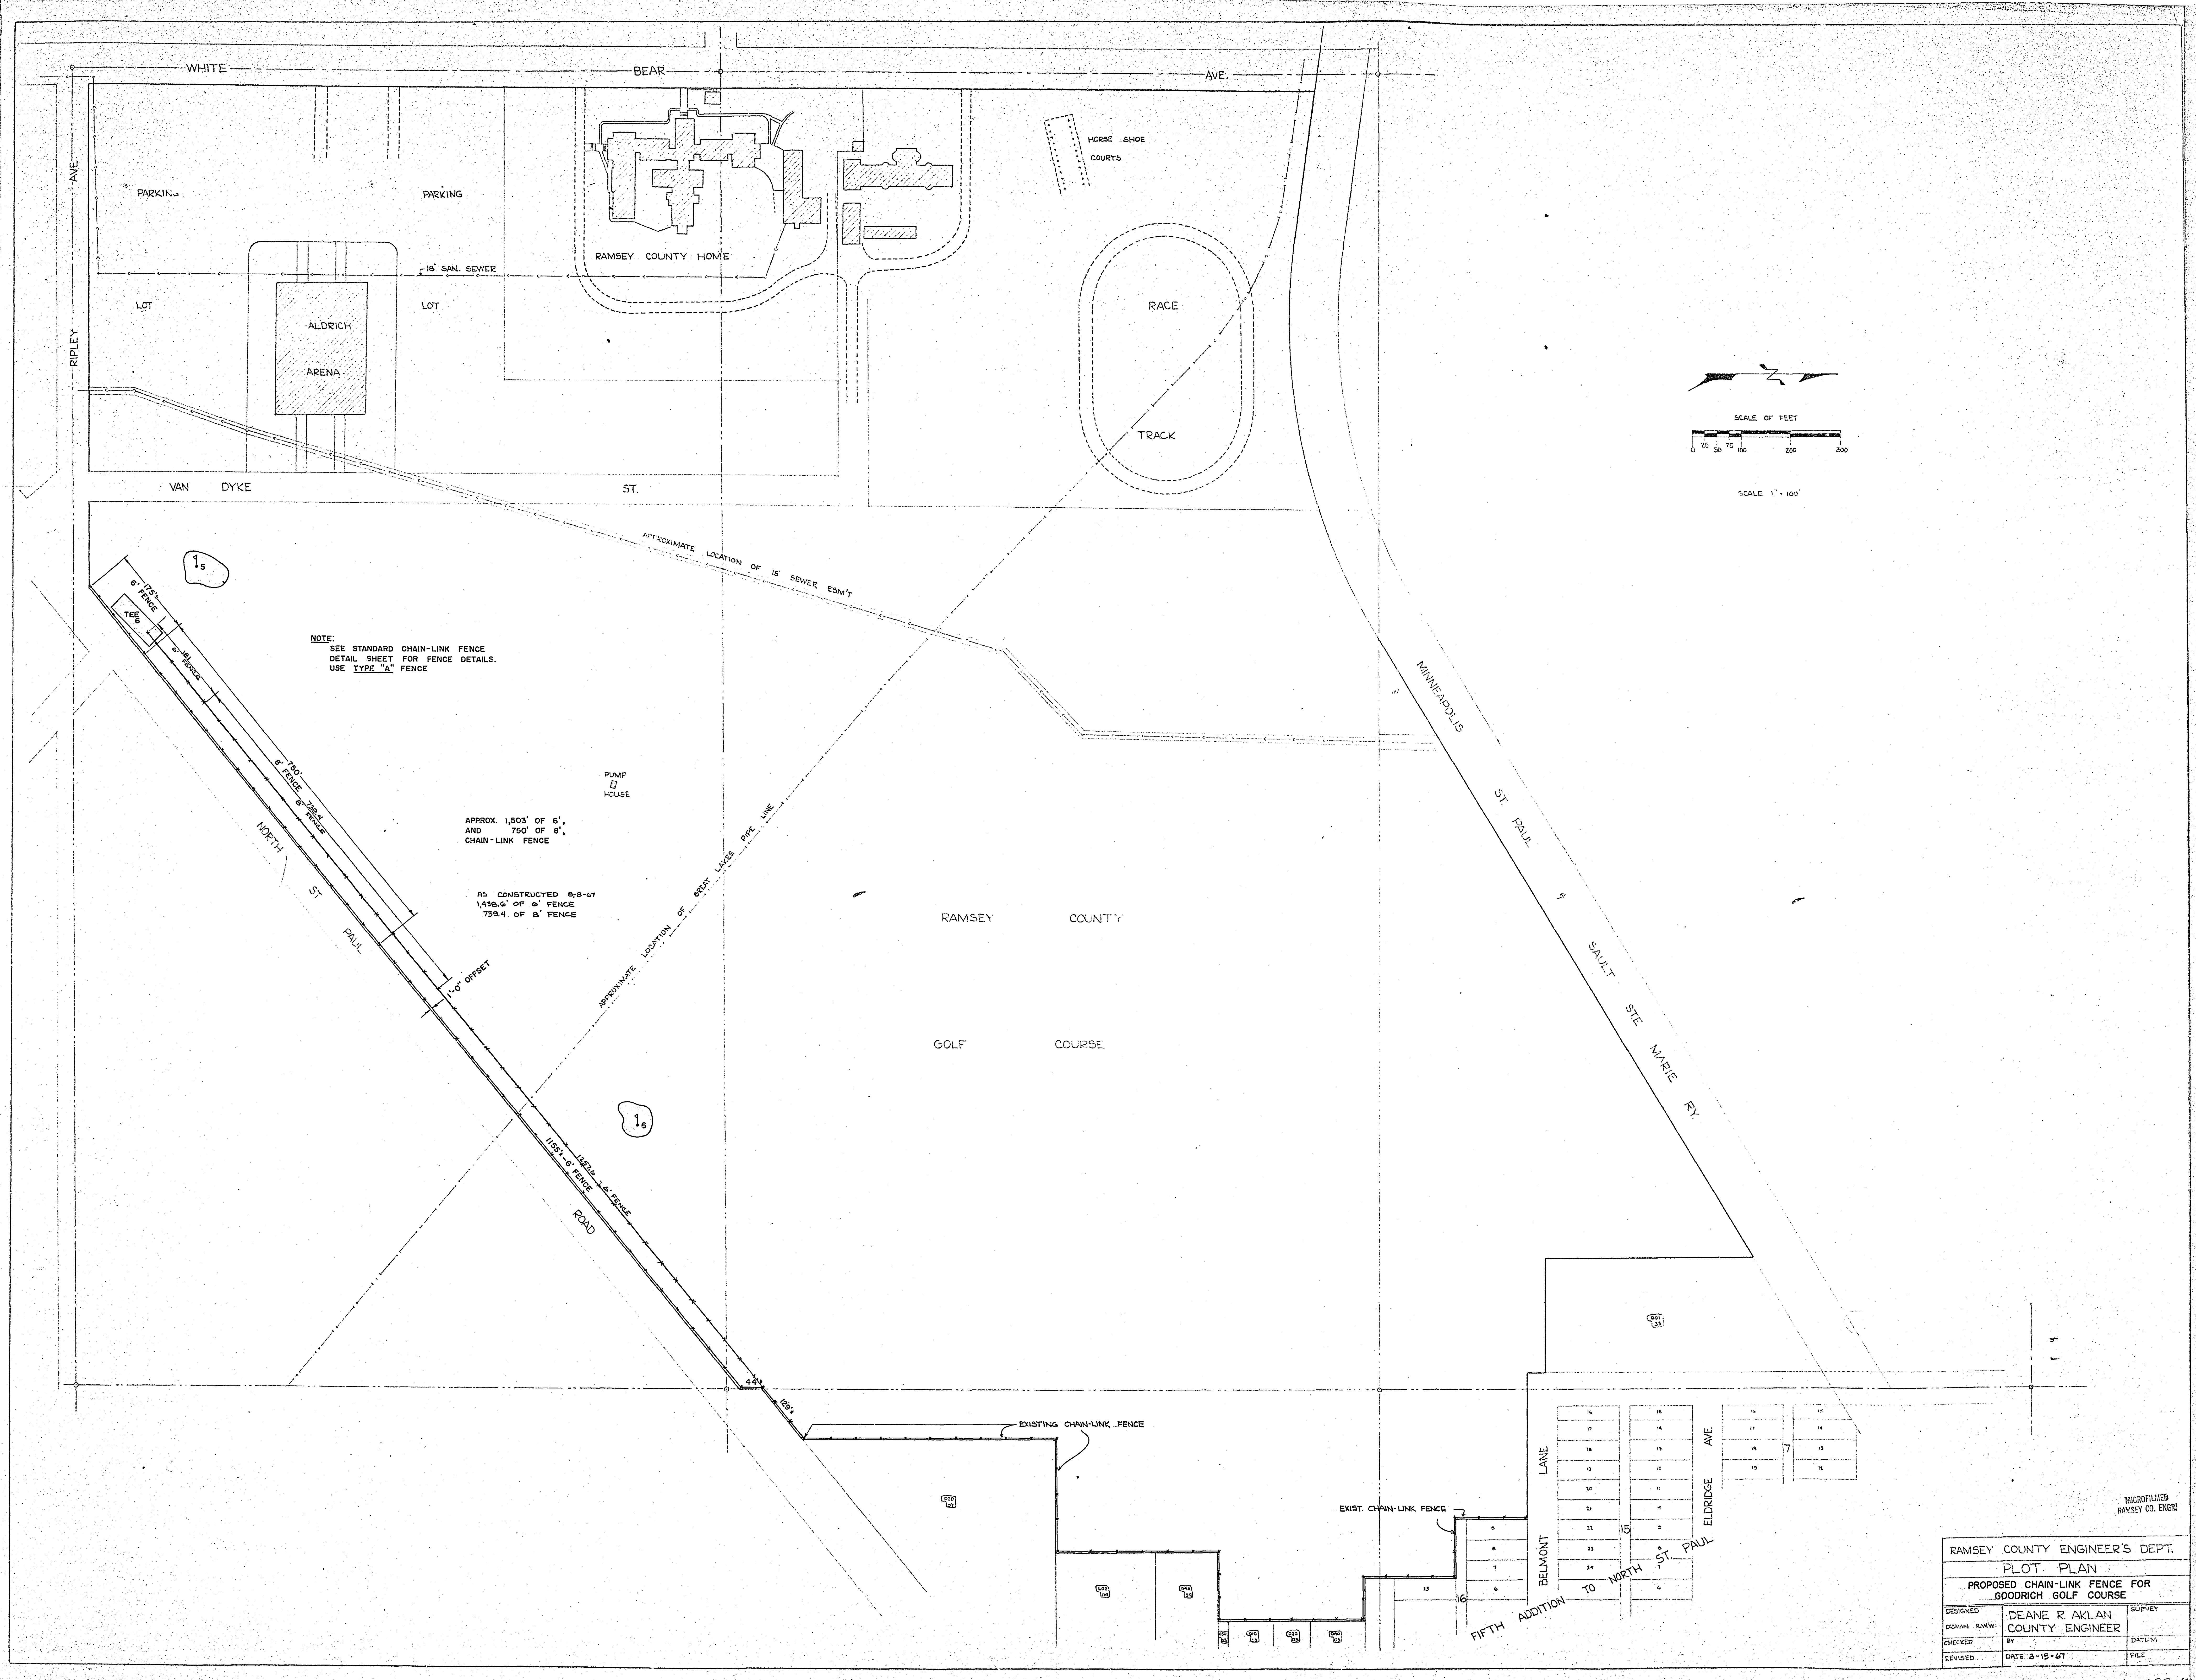

RAMSEY COUNTY ENGINEER'S DEPT.		
PLOT PLAN		
PROPOSED CHAIN-LINK FENCE FOR GOODRICH GOLF COURSE		
DESIGNED	DEANE R AKLAN	SURVEY
DRAWN R.W.M.	COUNTY ENGINEER	
CHECKED	BY	DATUM
REVISED	DATE 3-15-67	FILE

MICROFILMED
RAMSEY CO. ENGR