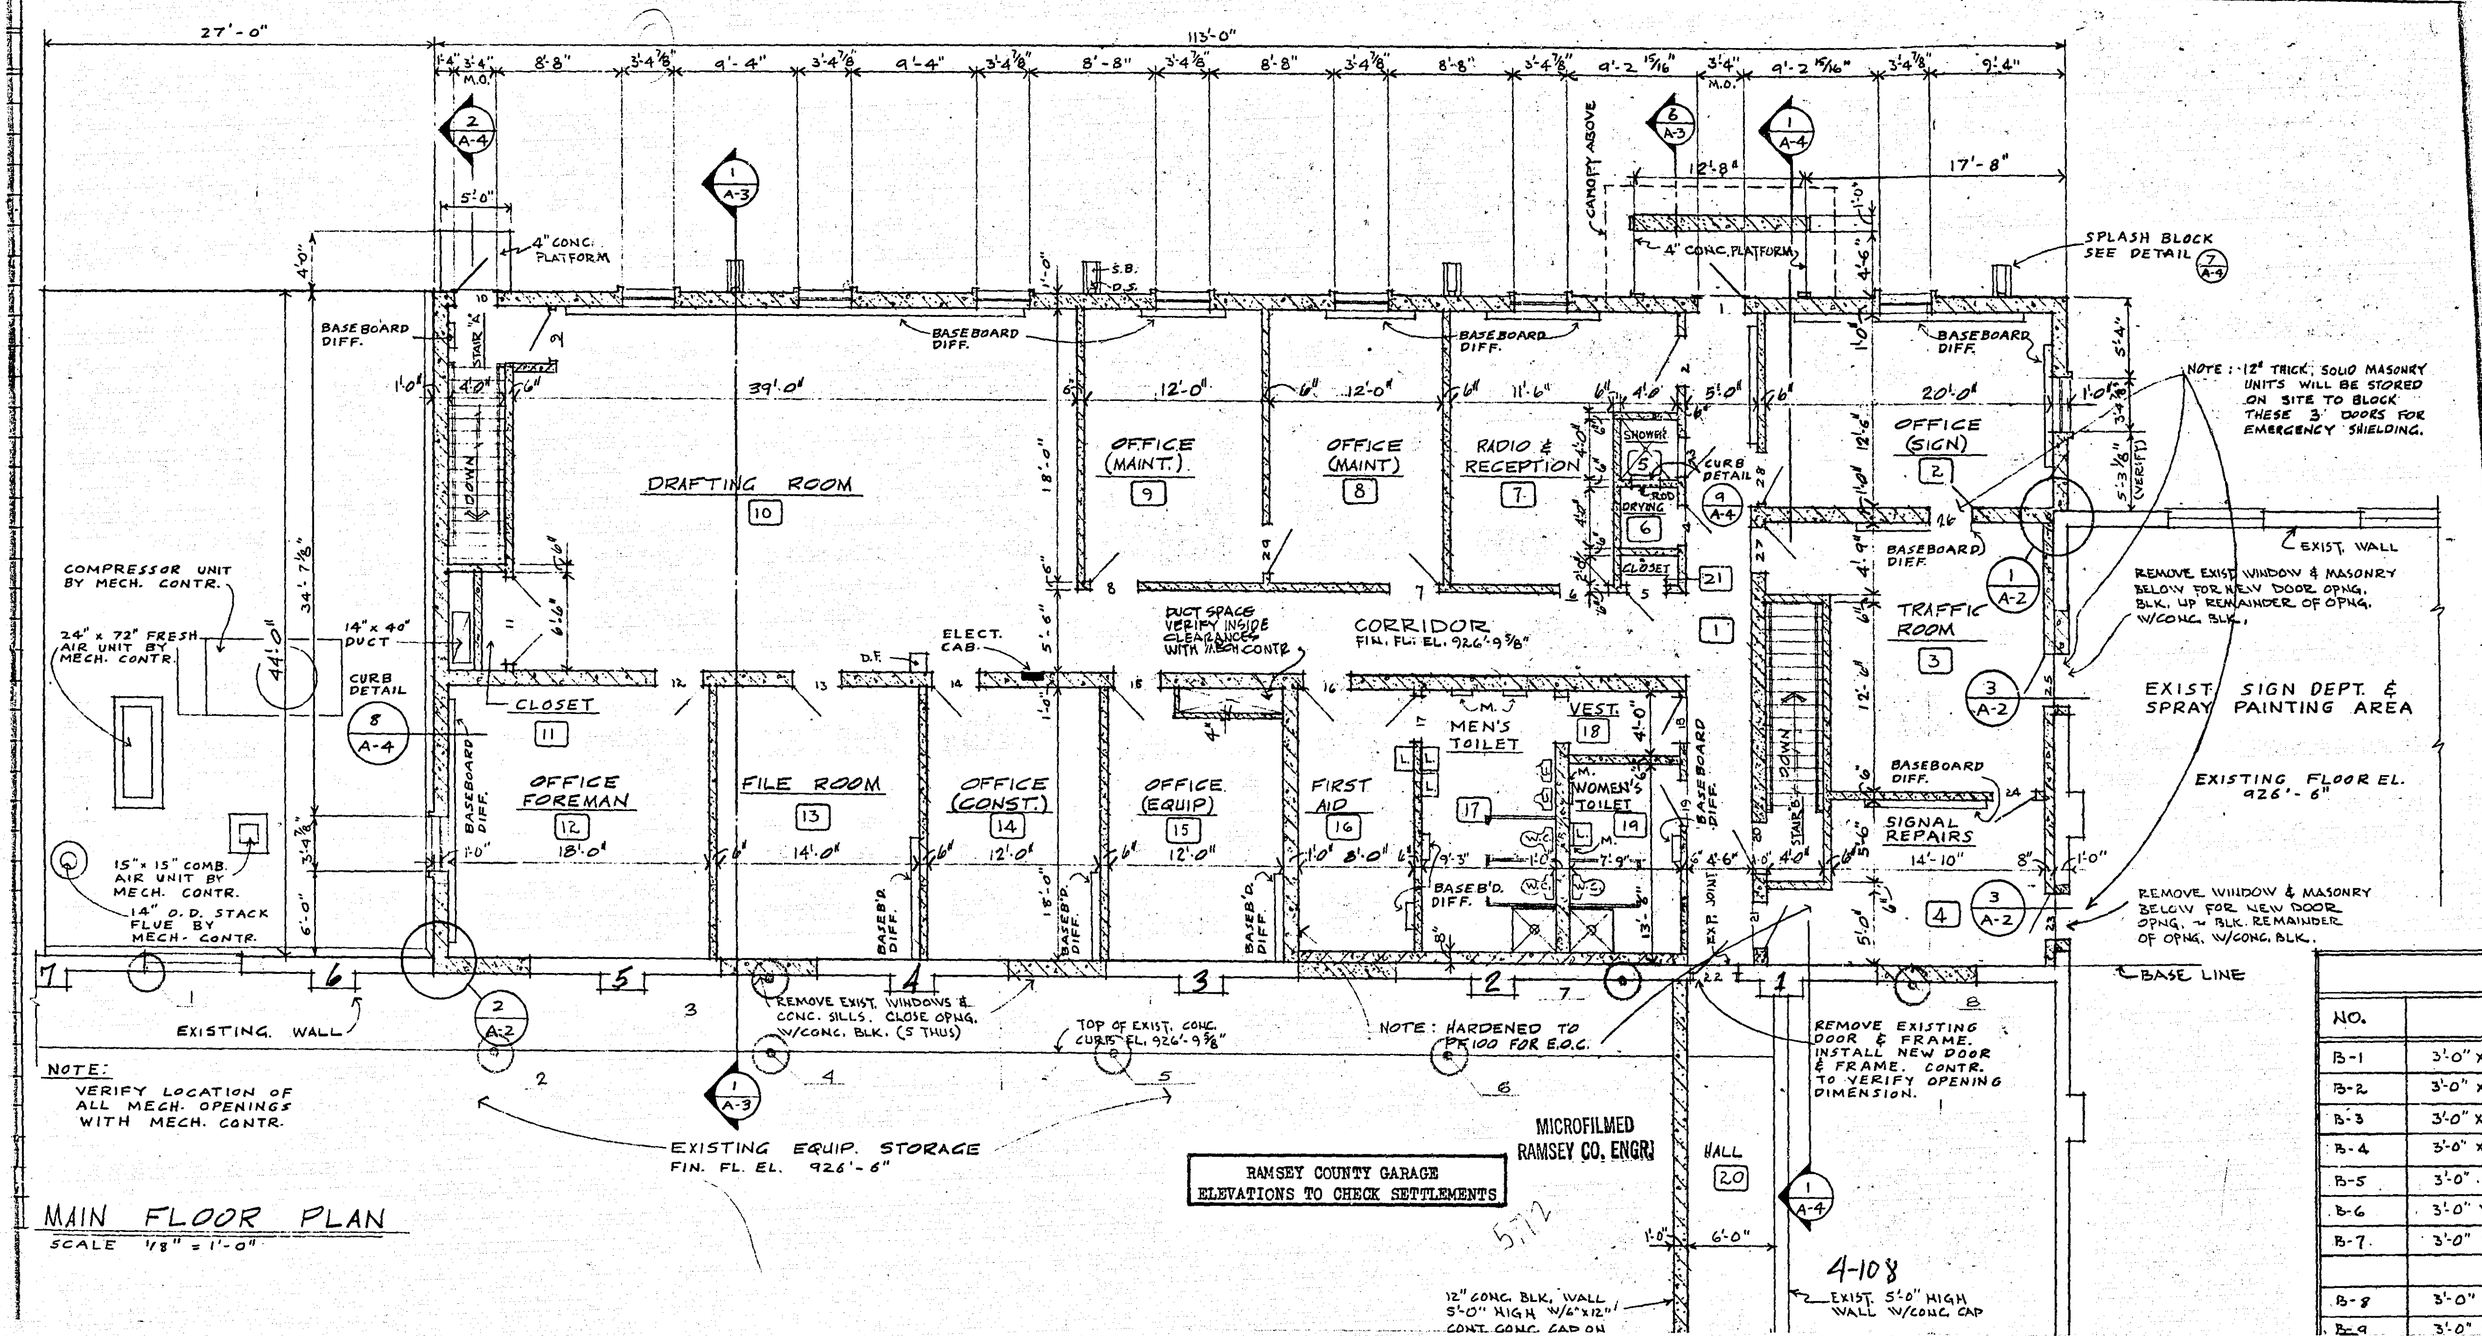

NO.	
B-1	3'-0" x 7'
B-2	3'-0" x 6'-
B-3	3'-0" x 6'-
B-4	3'-0" x 6'-
B-5	3'-0" x 6'
B-6	3'-0" x 7'
B-7	3'-0" x 6'
B-8	3'-0" x 7'
B-9	3'-0" x 6'-

MAIN FLOOR PLAN

SCALE 1/8" = 1'-0"

RAMSEY COUNTY GARAGE

ELEVATIONS TO CHECK SETTLEMENTS

45-116 EYE-EASE 45-416 20/20 BUFF

LOCATION (see plan)	CRACK OPENING 12-28-67	3-27-68	6-28-68	10-9-68	1-9-69	ELEVATION AT CRACK 12-28-67	3-27-68	6-28-68	10-9-68	1-9-69	ELEVATION BOTTOM OF TRUSS N. SIDE (from N.E. corner to the W.) 12-28-67	3-27-68	6-28-68	10-9-68	1-9-69
1	1/8"	1/8"	3/32"	1/8"	1/8"						114.92	114.97	114.97	114.91	114.96
2	5/8"	1/2"	3/8"	7/16"	7/16"	100.22	100.21	100.17	100.21	100.24	114.90	114.89	114.89	114.87	114.87
3						100.16	100.16	100.19	100.15	100.22	114.88	114.87	114.89	114.87	114.86
4	3/4"	1"	13/16"	3/4"	13/16"	100.22	100.22	100.27	100.23	100.24	114.89	114.88	114.91	114.87	114.86
5	5/8"	3/4"	3/4"	11/16"	13/16"	100.24	100.23	100.19	100.23	100.25	114.91	114.90	114.91	114.90	114.89
6	9/16"	5/8"	5/8"	9/16"	5/8"	100.22	100.22	100.19	100.16	100.22	114.95	114.94	114.96	114.87	114.93
7	7/16"	3/8"	3/8"	7/16"	5/16"	100.16	100.17	100.16	100.14	100.20	114.99	114.97	115.00	114.95	114.97
8	1/2"	* 1"	1"	1"	1-1/32"	99.97	99.96	99.94	99.93	99.97	115.01	115.00	115.01	115.00	115.00
9											115.03	115.03	115.03	115.02	115.02
10											115.05	115.04	115.03	115.03	115.03

* EXPANSION JOINT GONE

MICROFILMED
RAMSEY CO. ENGR.

4-108