


Note: 9/3/70

Ken: The owners of Parcel 7 are trying to retain the east two acres along Century Ave. I do not know if the County has made a determination on the two acres as of this date.

Joe Perutka

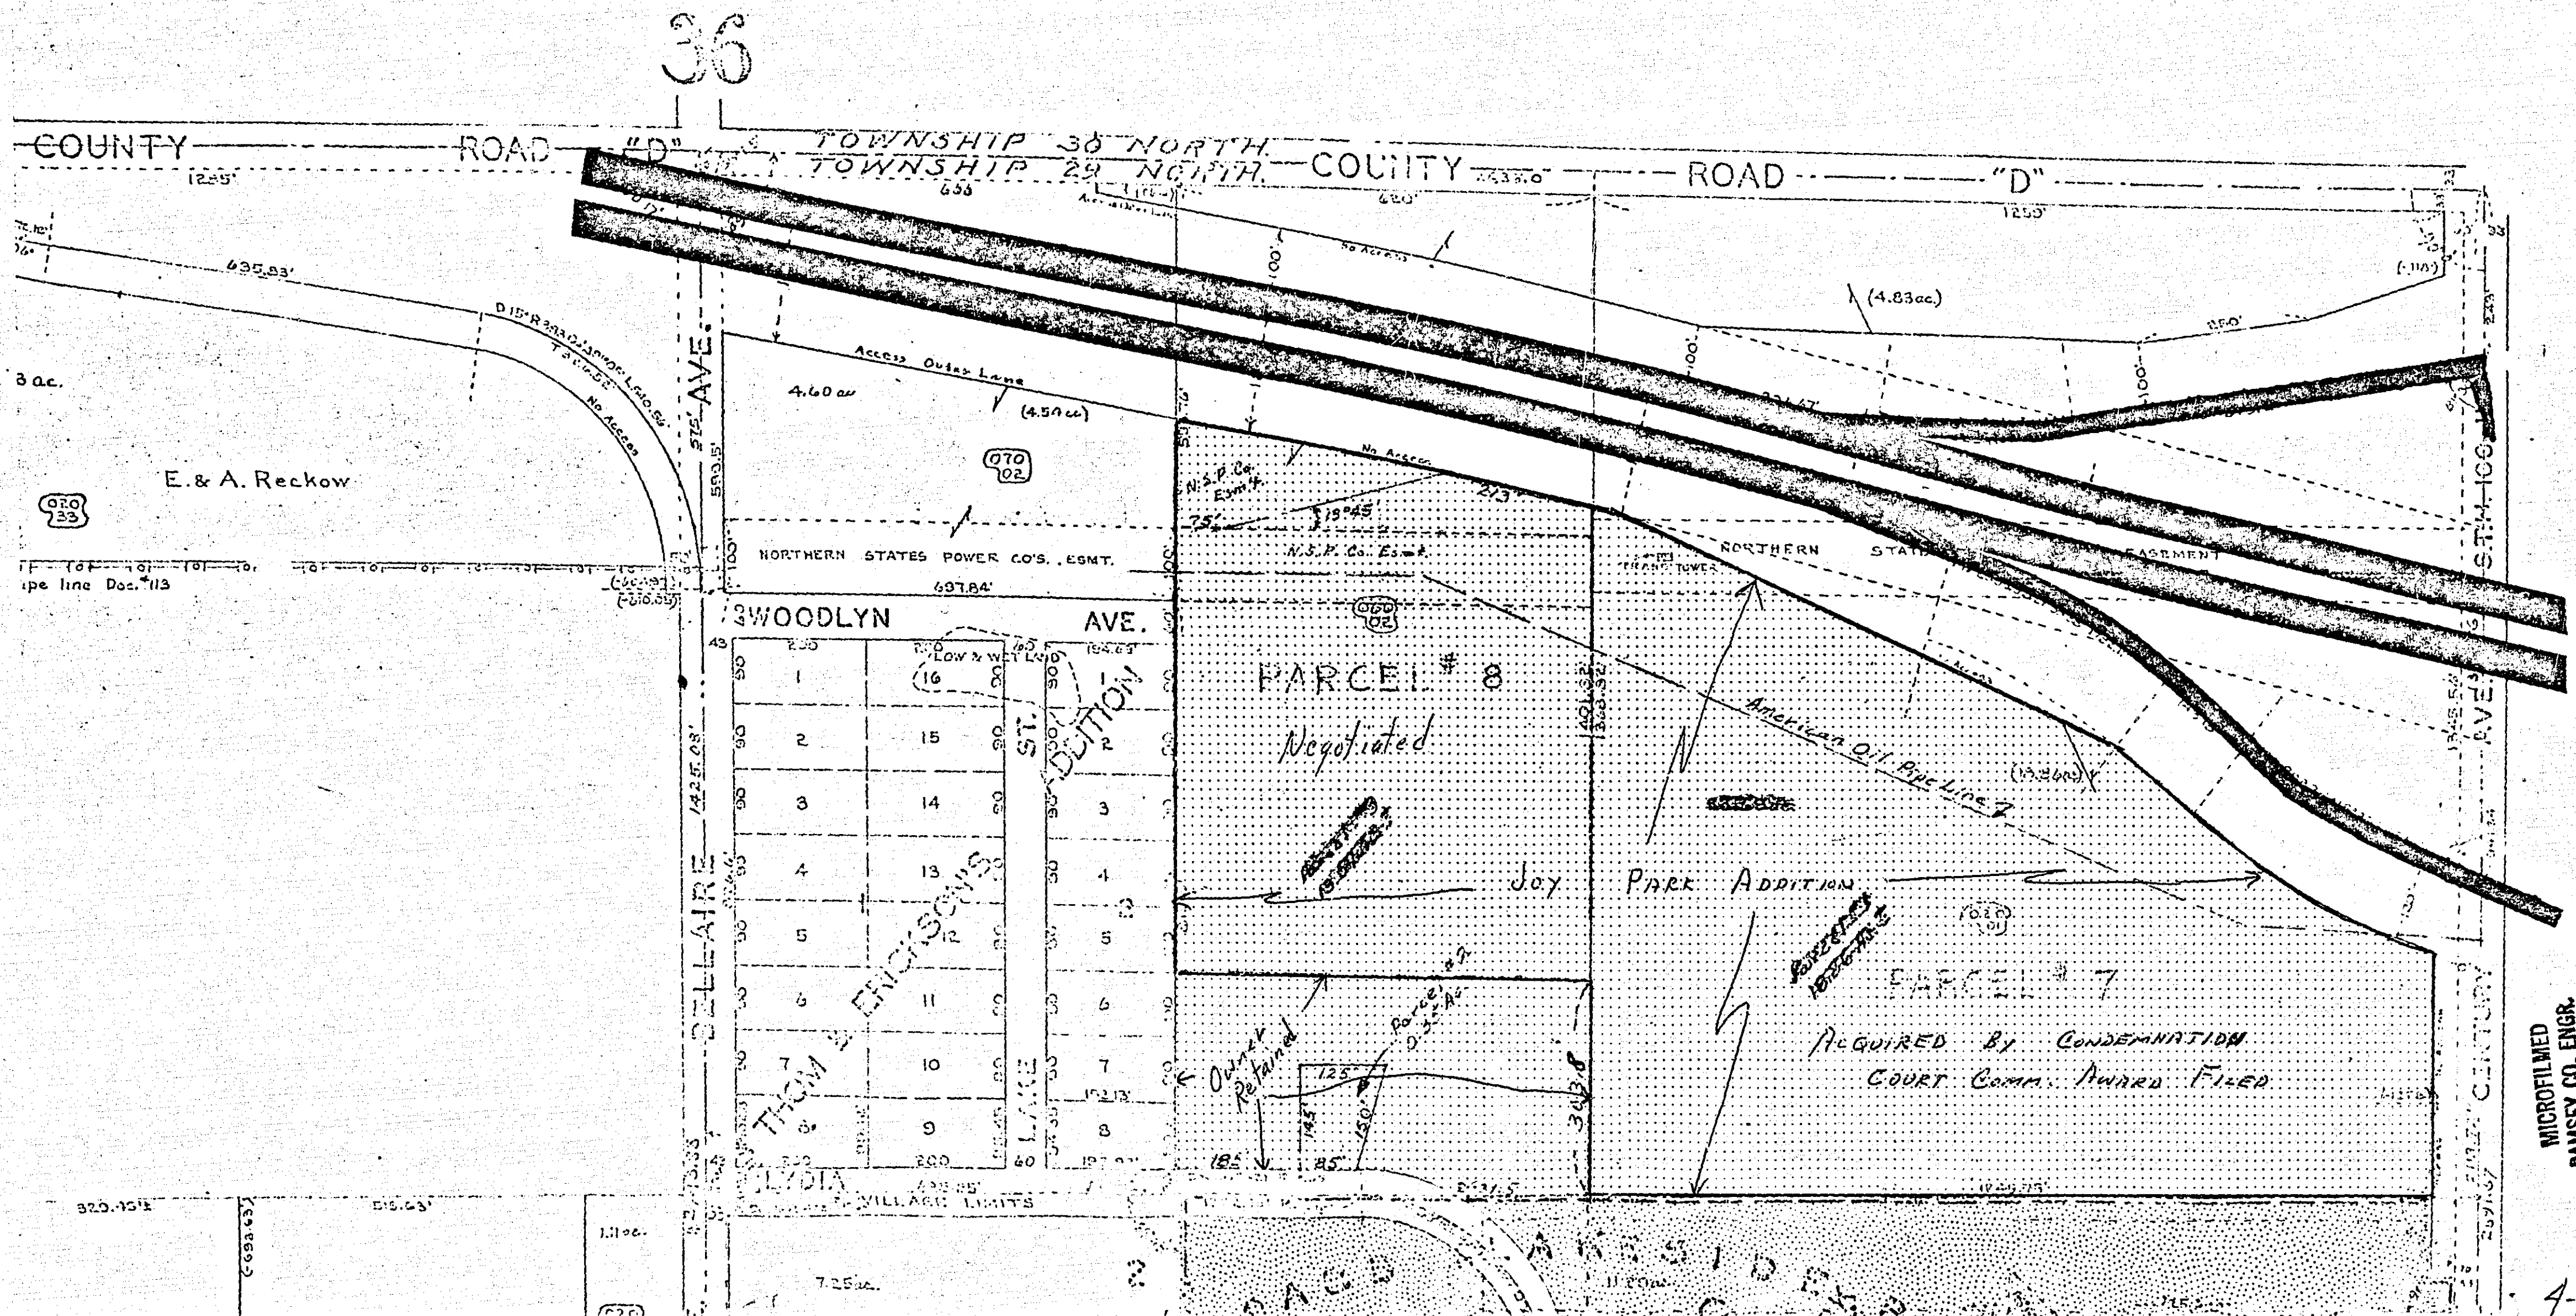

MICROFILMED
RAMSEY CO. ENGR.

4-114