



Fed. Proj. No.

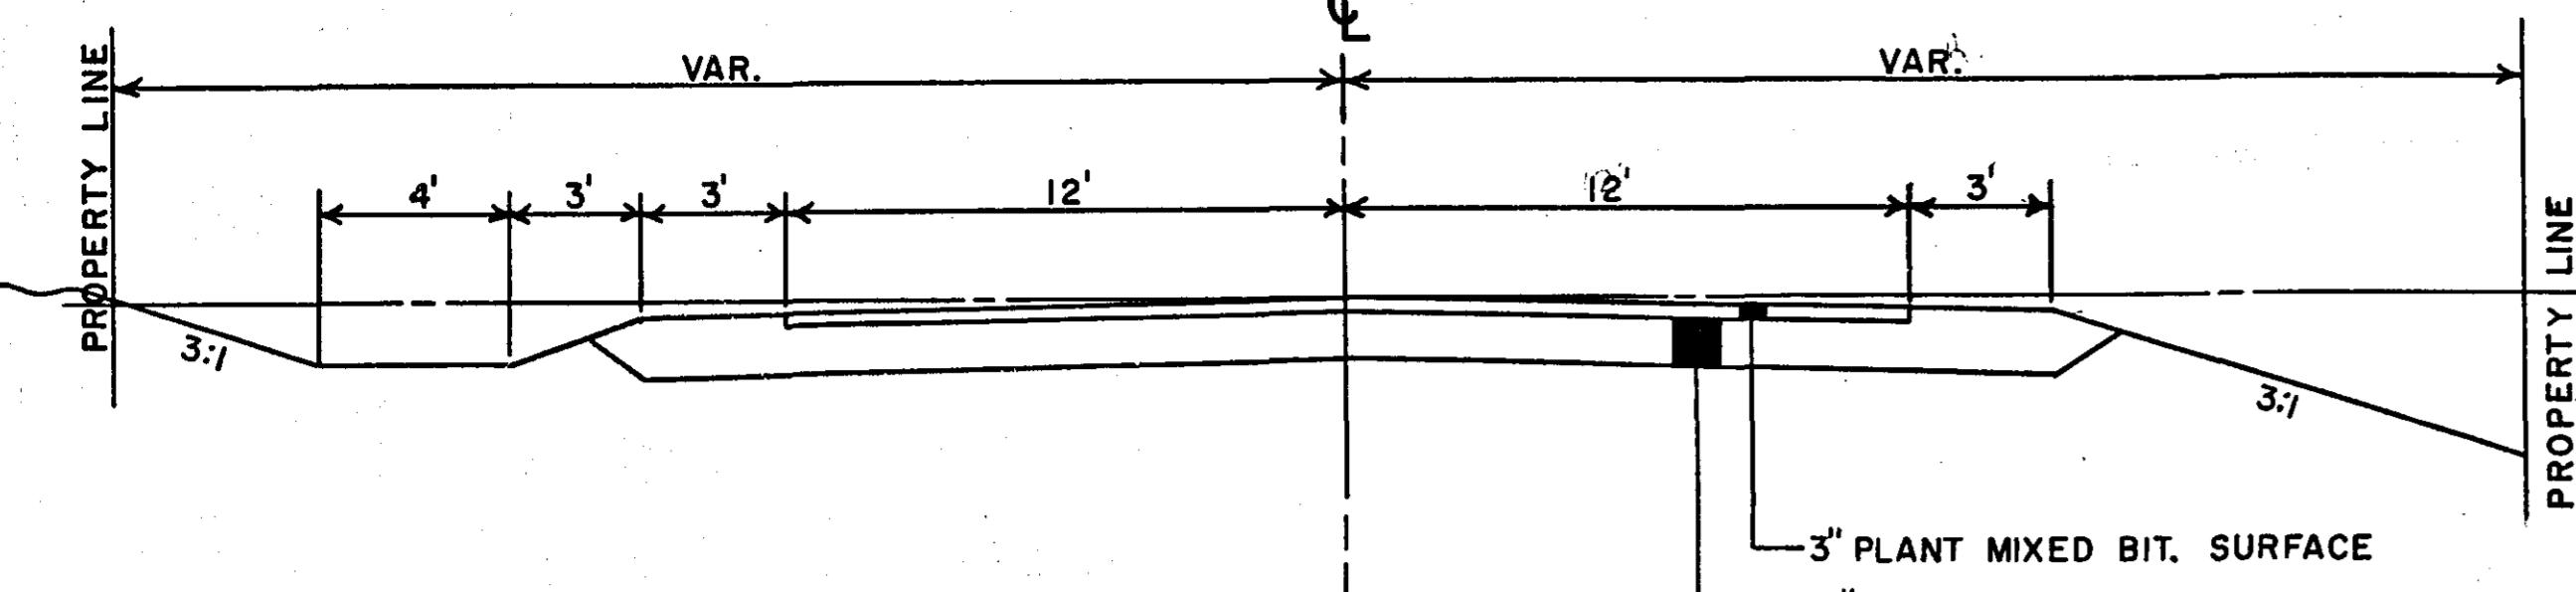

TYPICAL SECTION

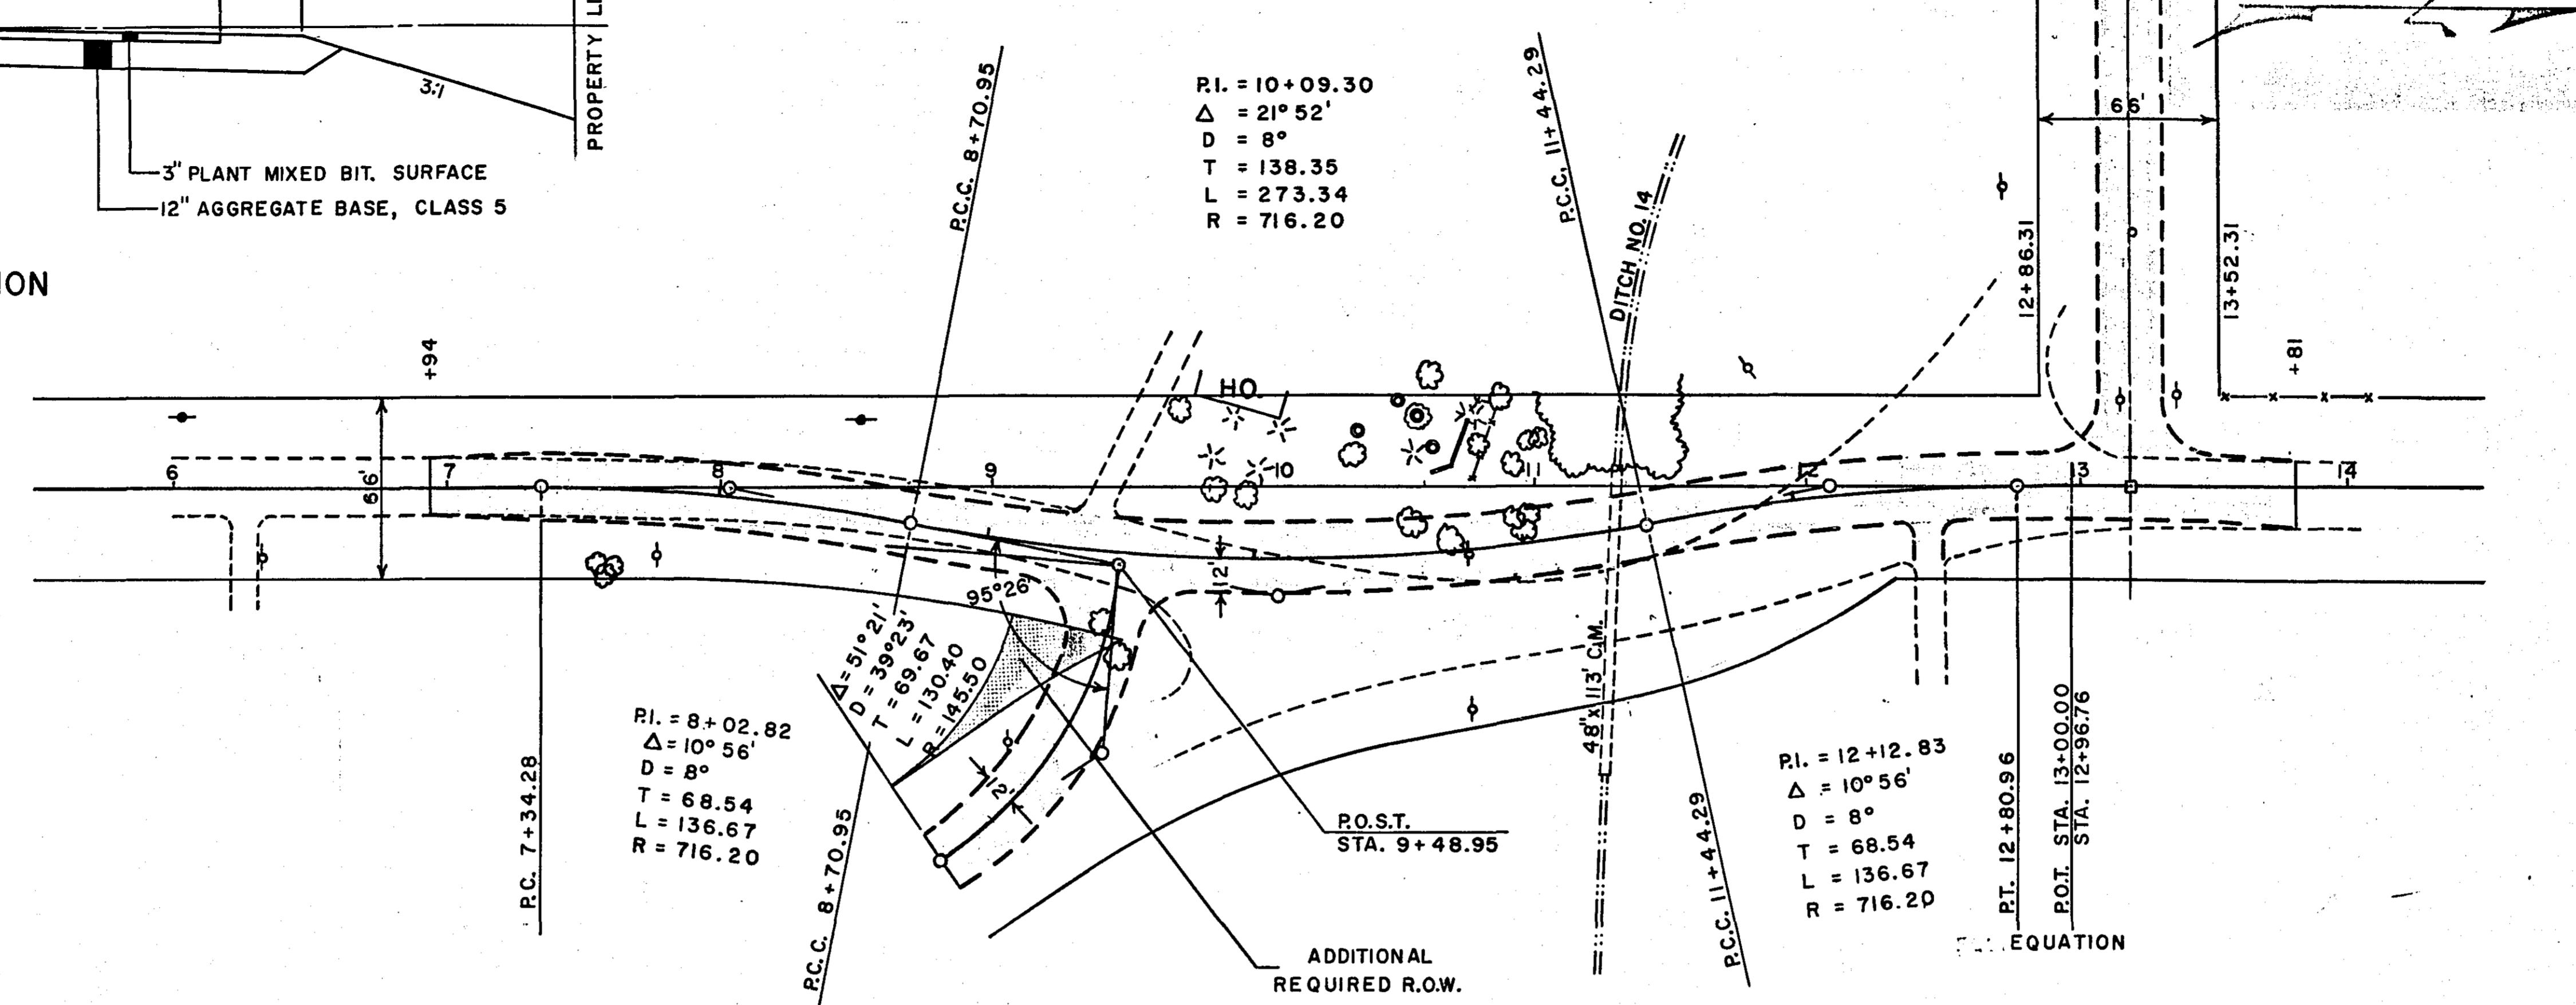

B.M. 916.06
TOP MONUMENT - STATION
13+19.31, SECTION LINE
ALIGNMENT:

916

915

914

MATCH EXISTING
GRADEVC = 100'
M = 0.248MATCH EXISTING
GRADE

- 0.625%

+1.363%

RECOMMENDED FOR APPROVAL _____ DATE _____

DIRECTOR OF SAFETY _____

RECOMMENDED FOR APPROVAL _____ DATE _____

MAINTENANCE ENGINEER _____

RECOMMENDED FOR APPROVAL _____ DATE _____

CONSTRUCTION ENGINEER _____

RECOMMENDED FOR APPROVAL _____ DATE _____

RECOMMENDED FOR APPROVAL _____ DATE _____

APPROVED _____ DATE _____

COUNTY ENGINEER _____

RAMSEY COUNTY ENGINEERS DEPT.


DEANE R. ANKLAN
COUNTY ENGINEERREVISION OF KOEHLER ROAD -
EDGERTON INTERSECTION

I hereby certify that this plan, specification, or report was prepared by me or under my direct supervision and that I am a duly Registered Professional Engineer under the laws of the State of Minnesota.
Marvin D. Kettler
Date 5/14/71 Reg. No. 5781

DRAWN: D.W.S.
DATE 5-23-71

ENCL 1 OF 2

Fed. Proj. No.

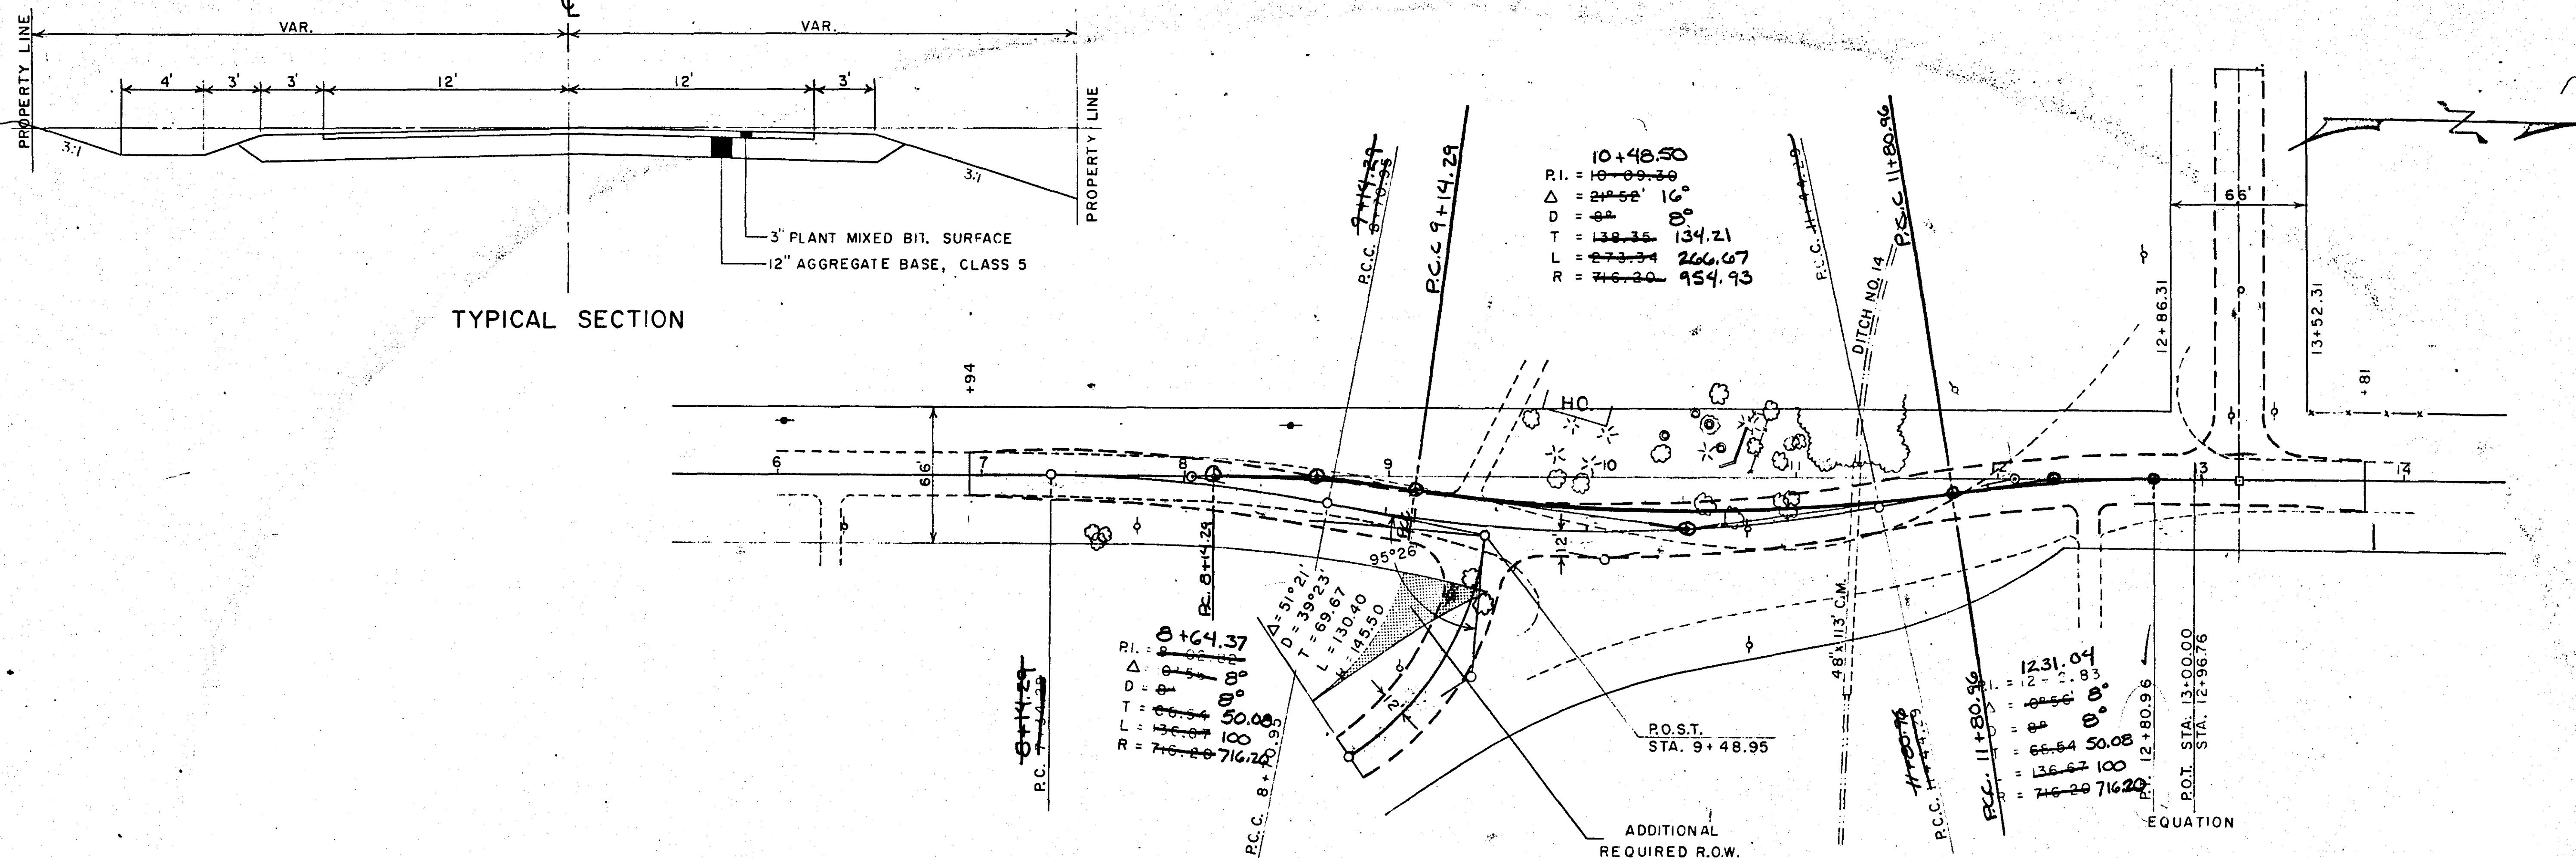

B.M. 916.06
TOP MONUMENT STATION
EXIST. SECTION LINE
ALIGNMENT

