


LEGEND

— 1980 SURVEY
- - - 1968 SURVEY (AFTER DREDGING)



SCALE:
HOR. 1" = 10'
VERT. 1" = 2'

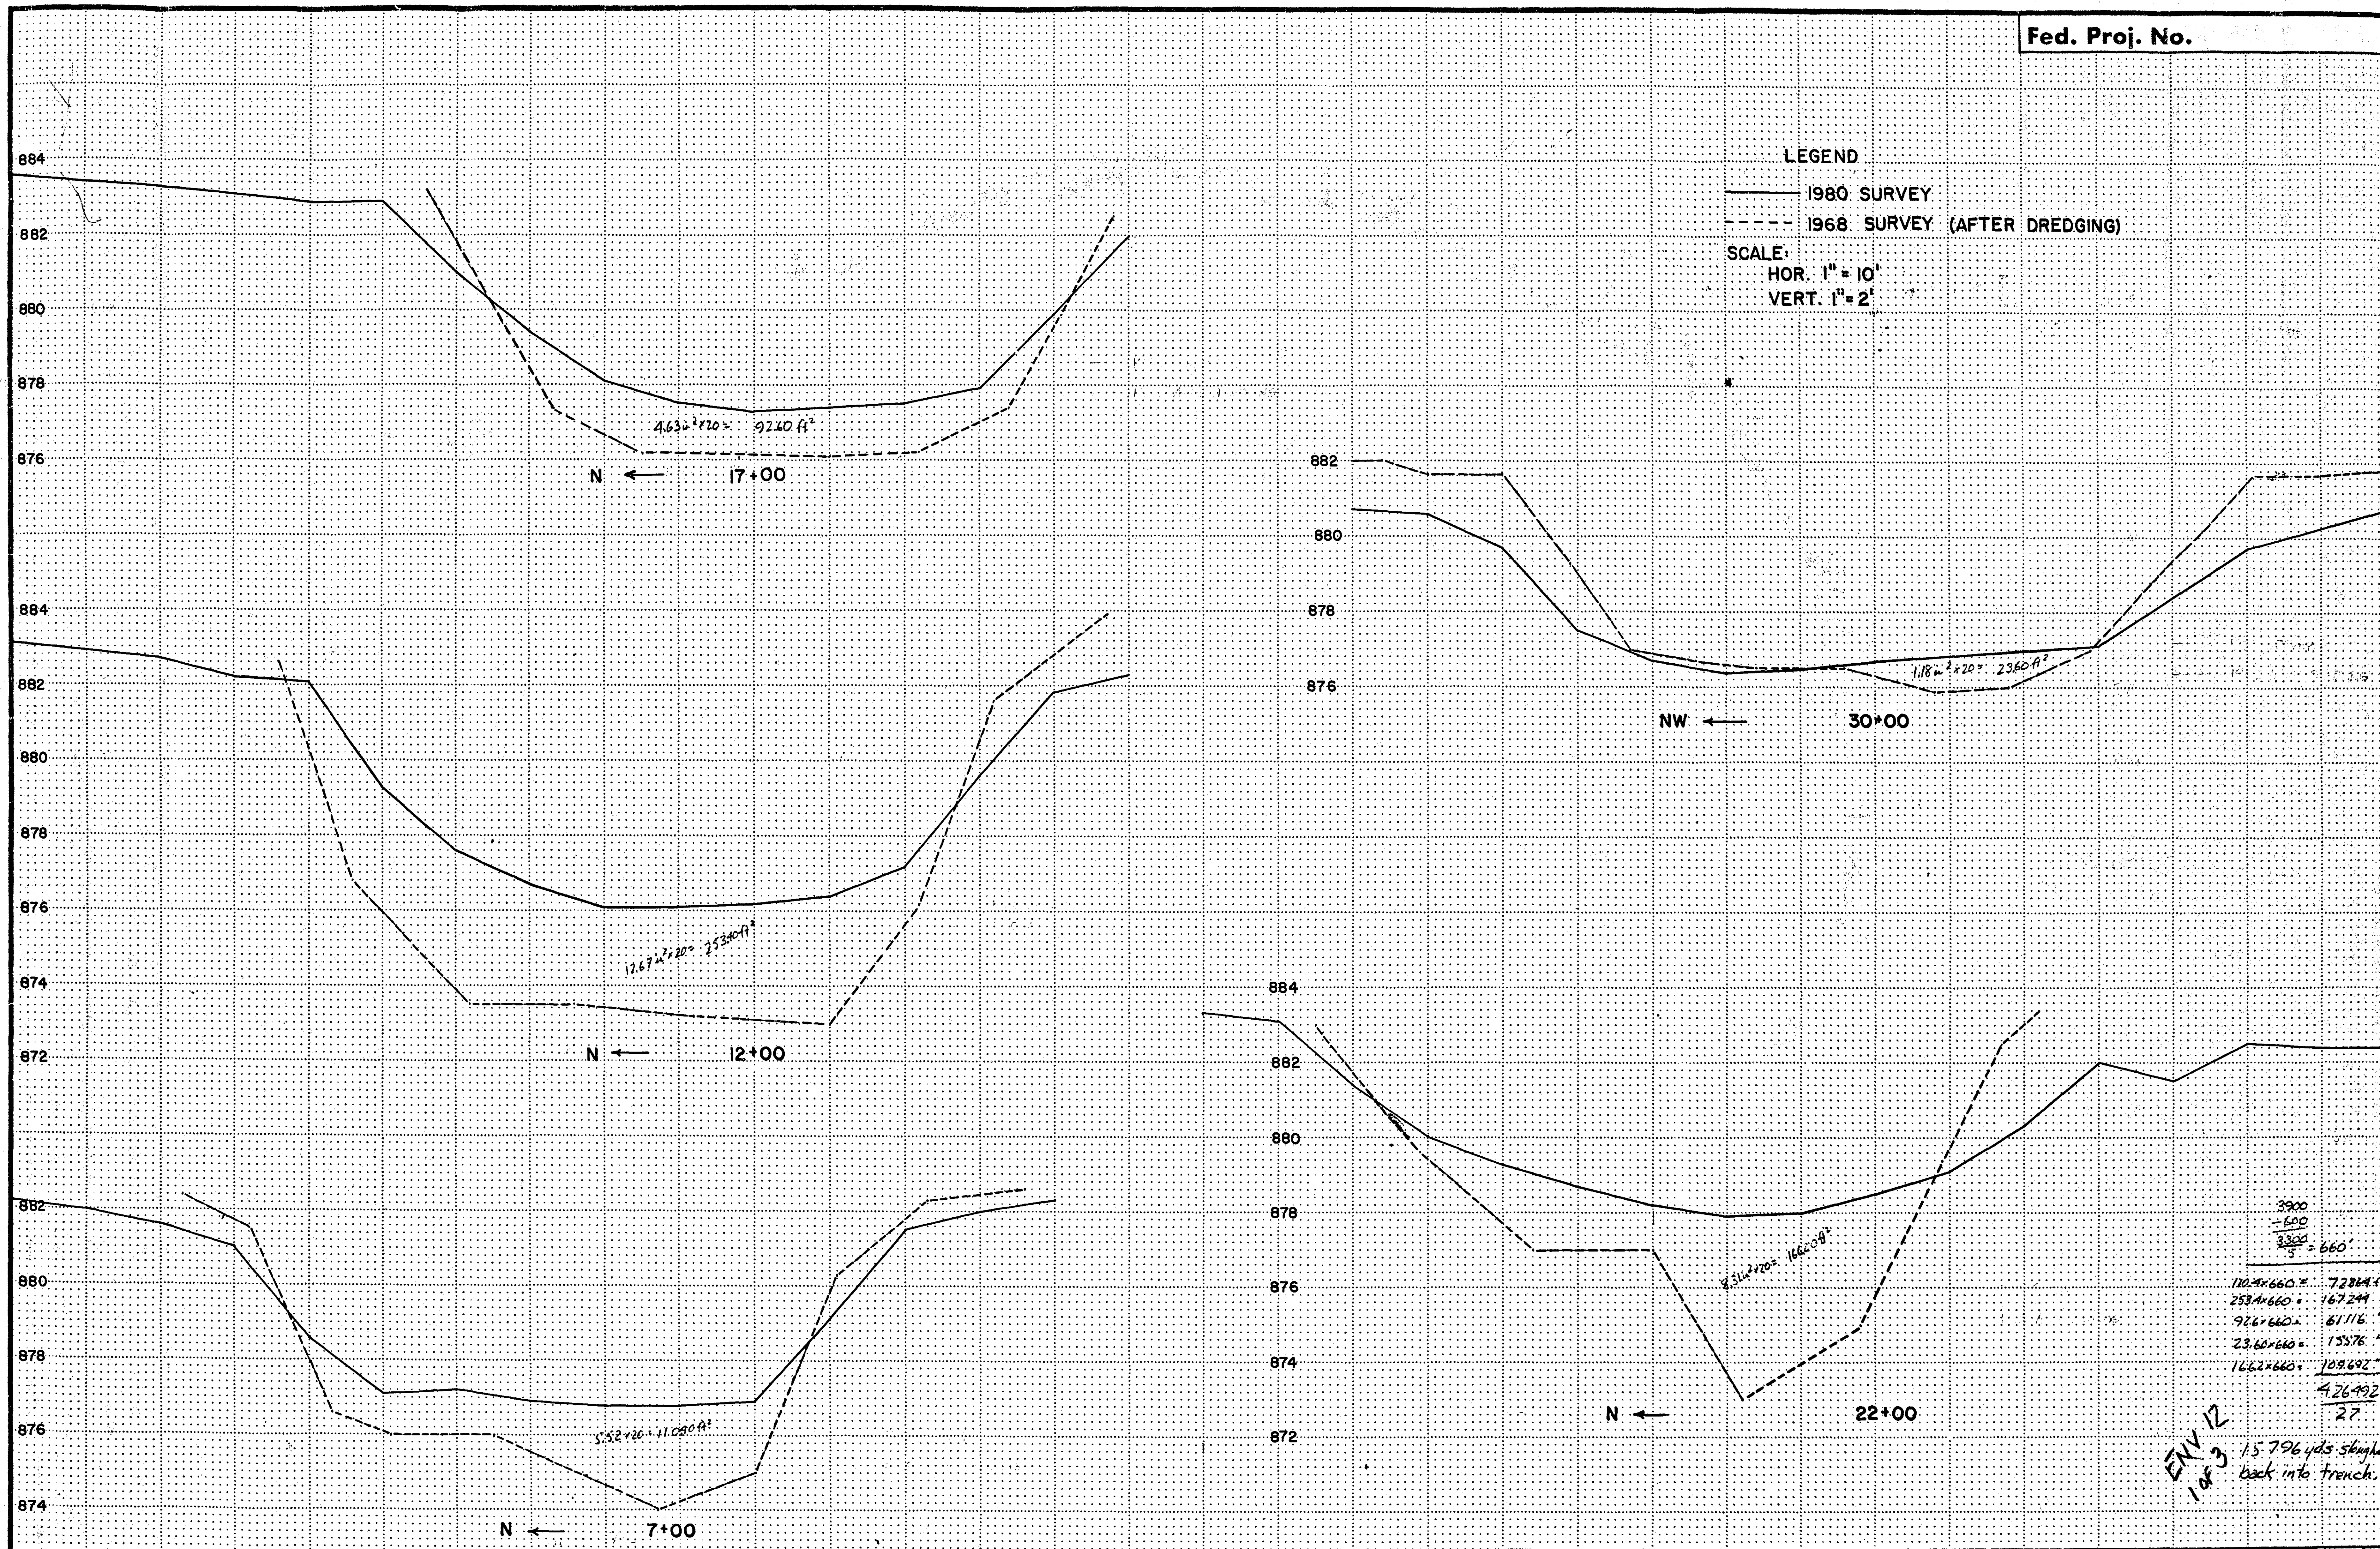

3900
- 600
3300
5 = 660'
170.4 x 660 = 72864 ft ²
253.4 x 660 = 167244 "
92.6 x 660 = 61116 "
23.6 x 660 = 15576 "
166.2 x 660 = 109692 "
426492
27

ENV 12
1 of 3
15,796 yds skoughed
back into trench.

LEGEND
 — 1980 SURVEY
 - - - 1968 SURVEY (AFTER DREDGING)
 SCALE:
 HOR. 1" = 10'
 VERT. 1" = 2'

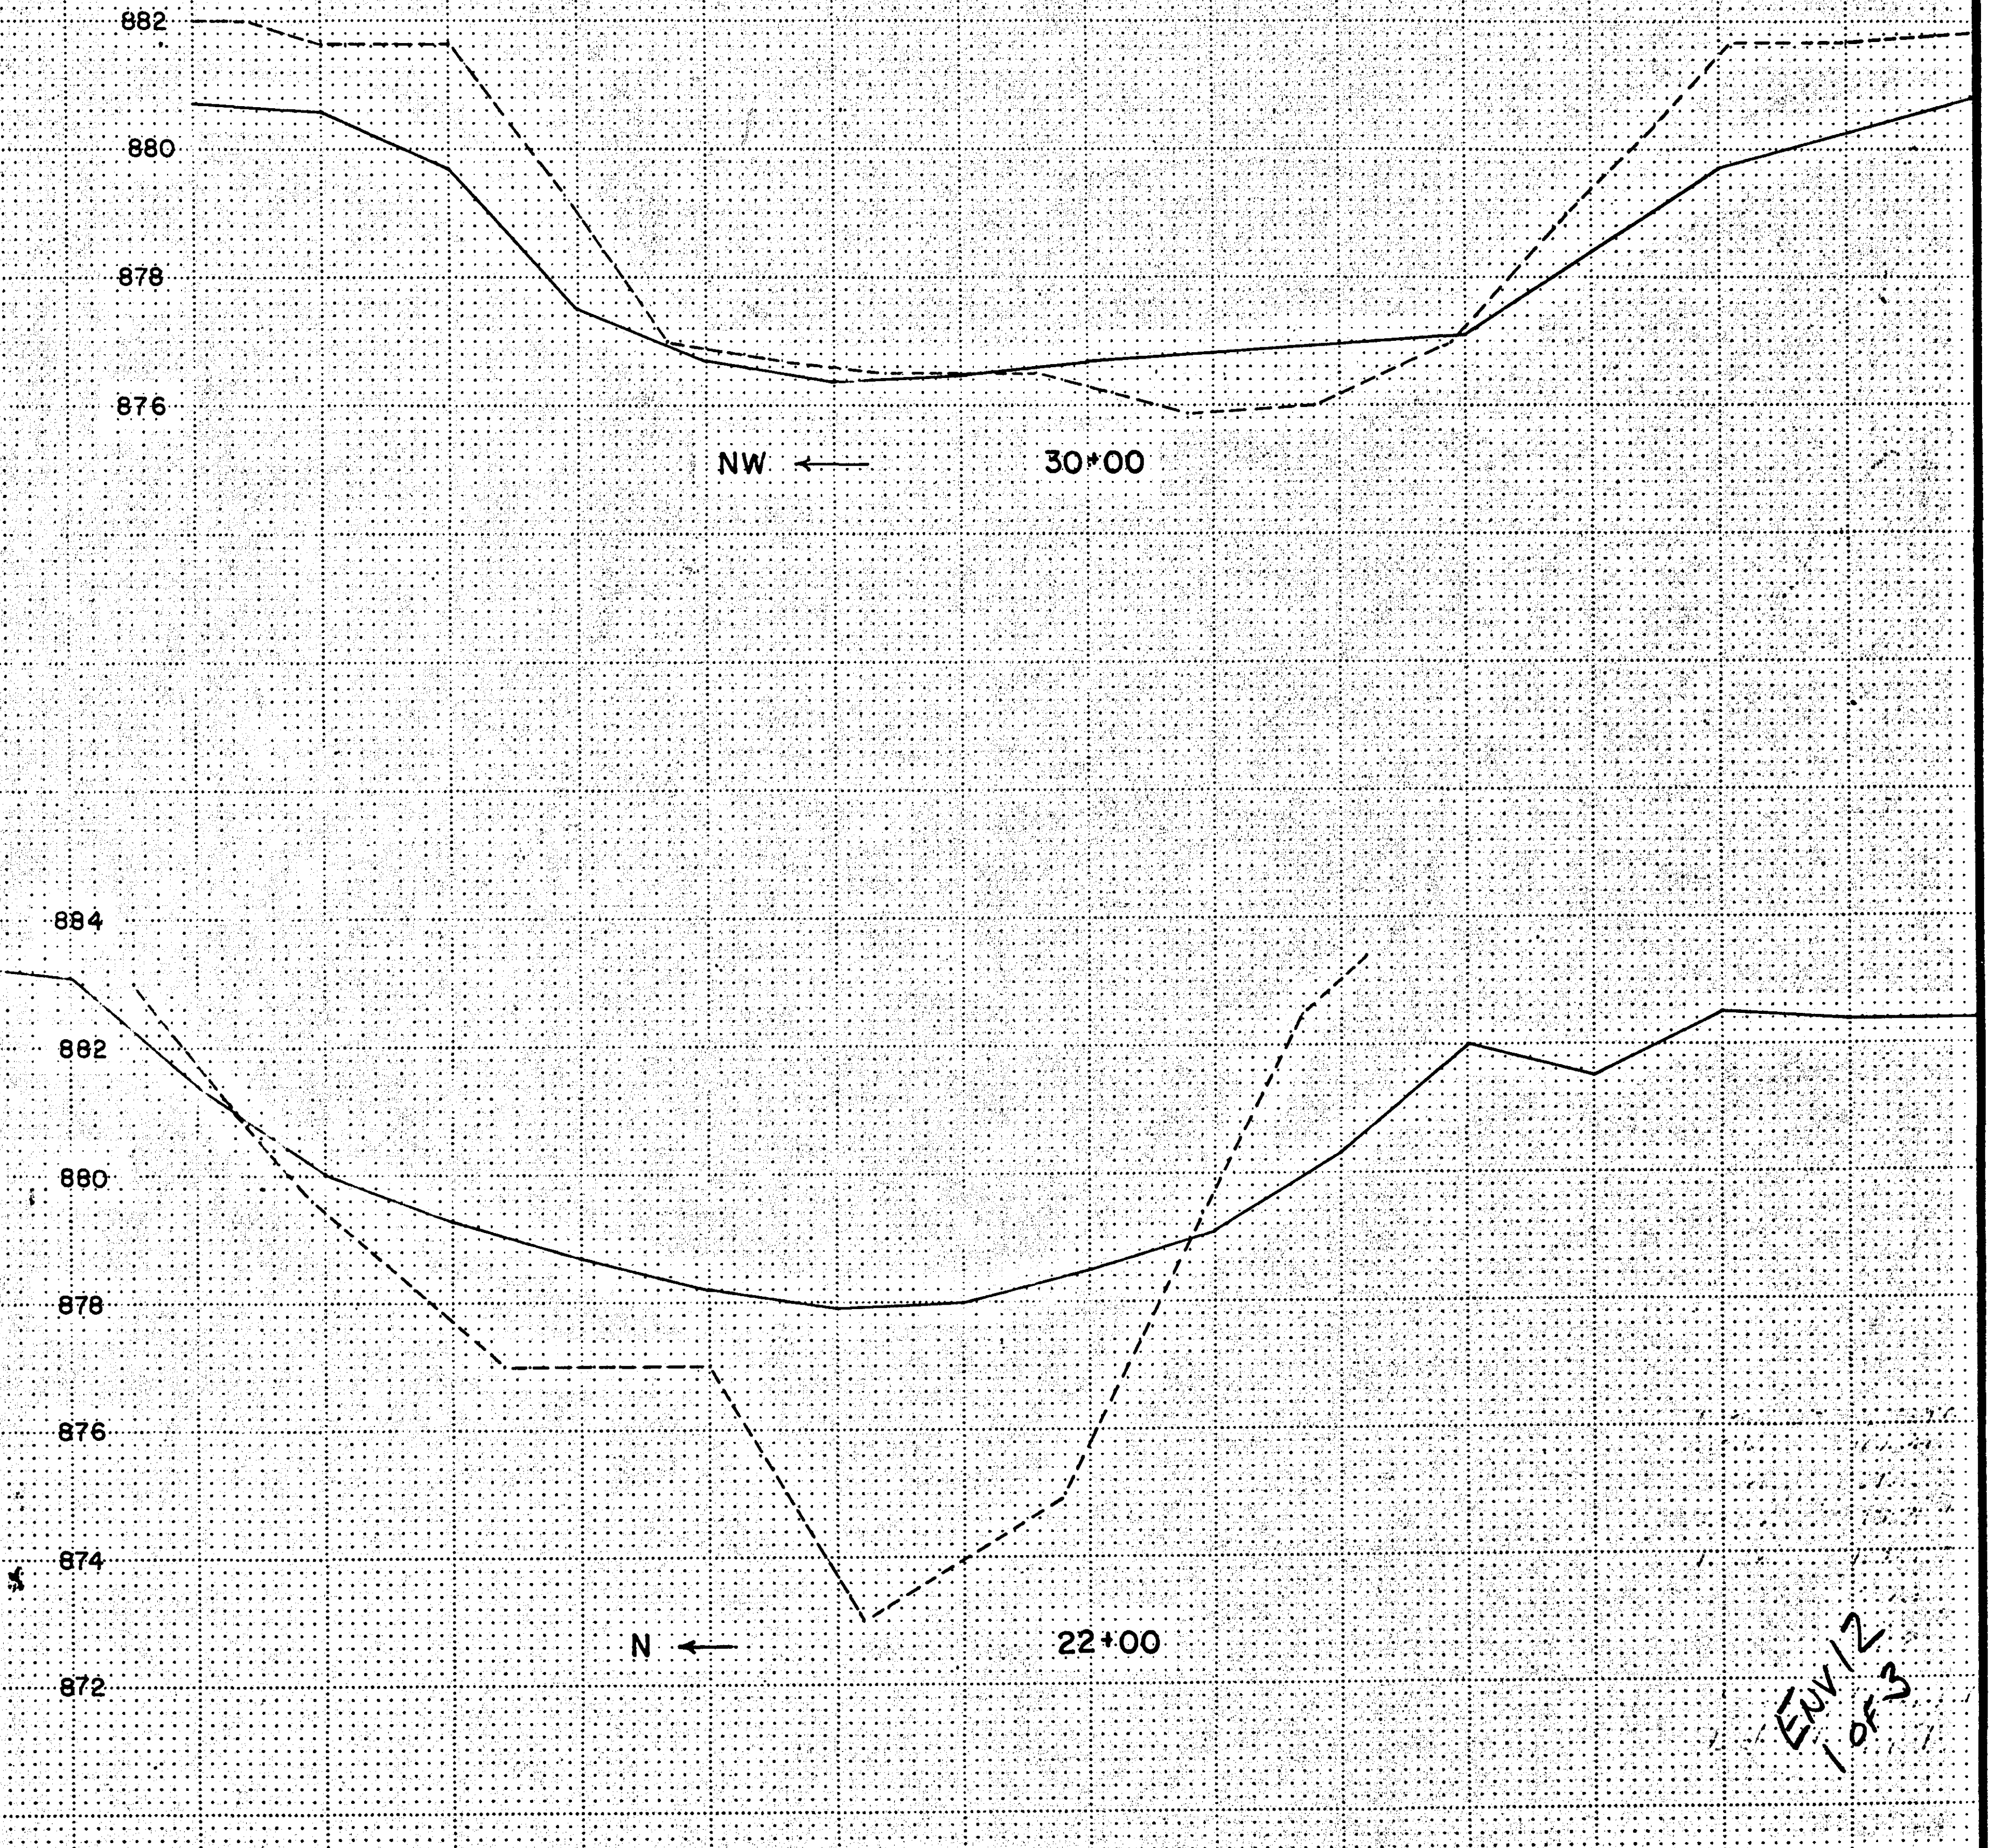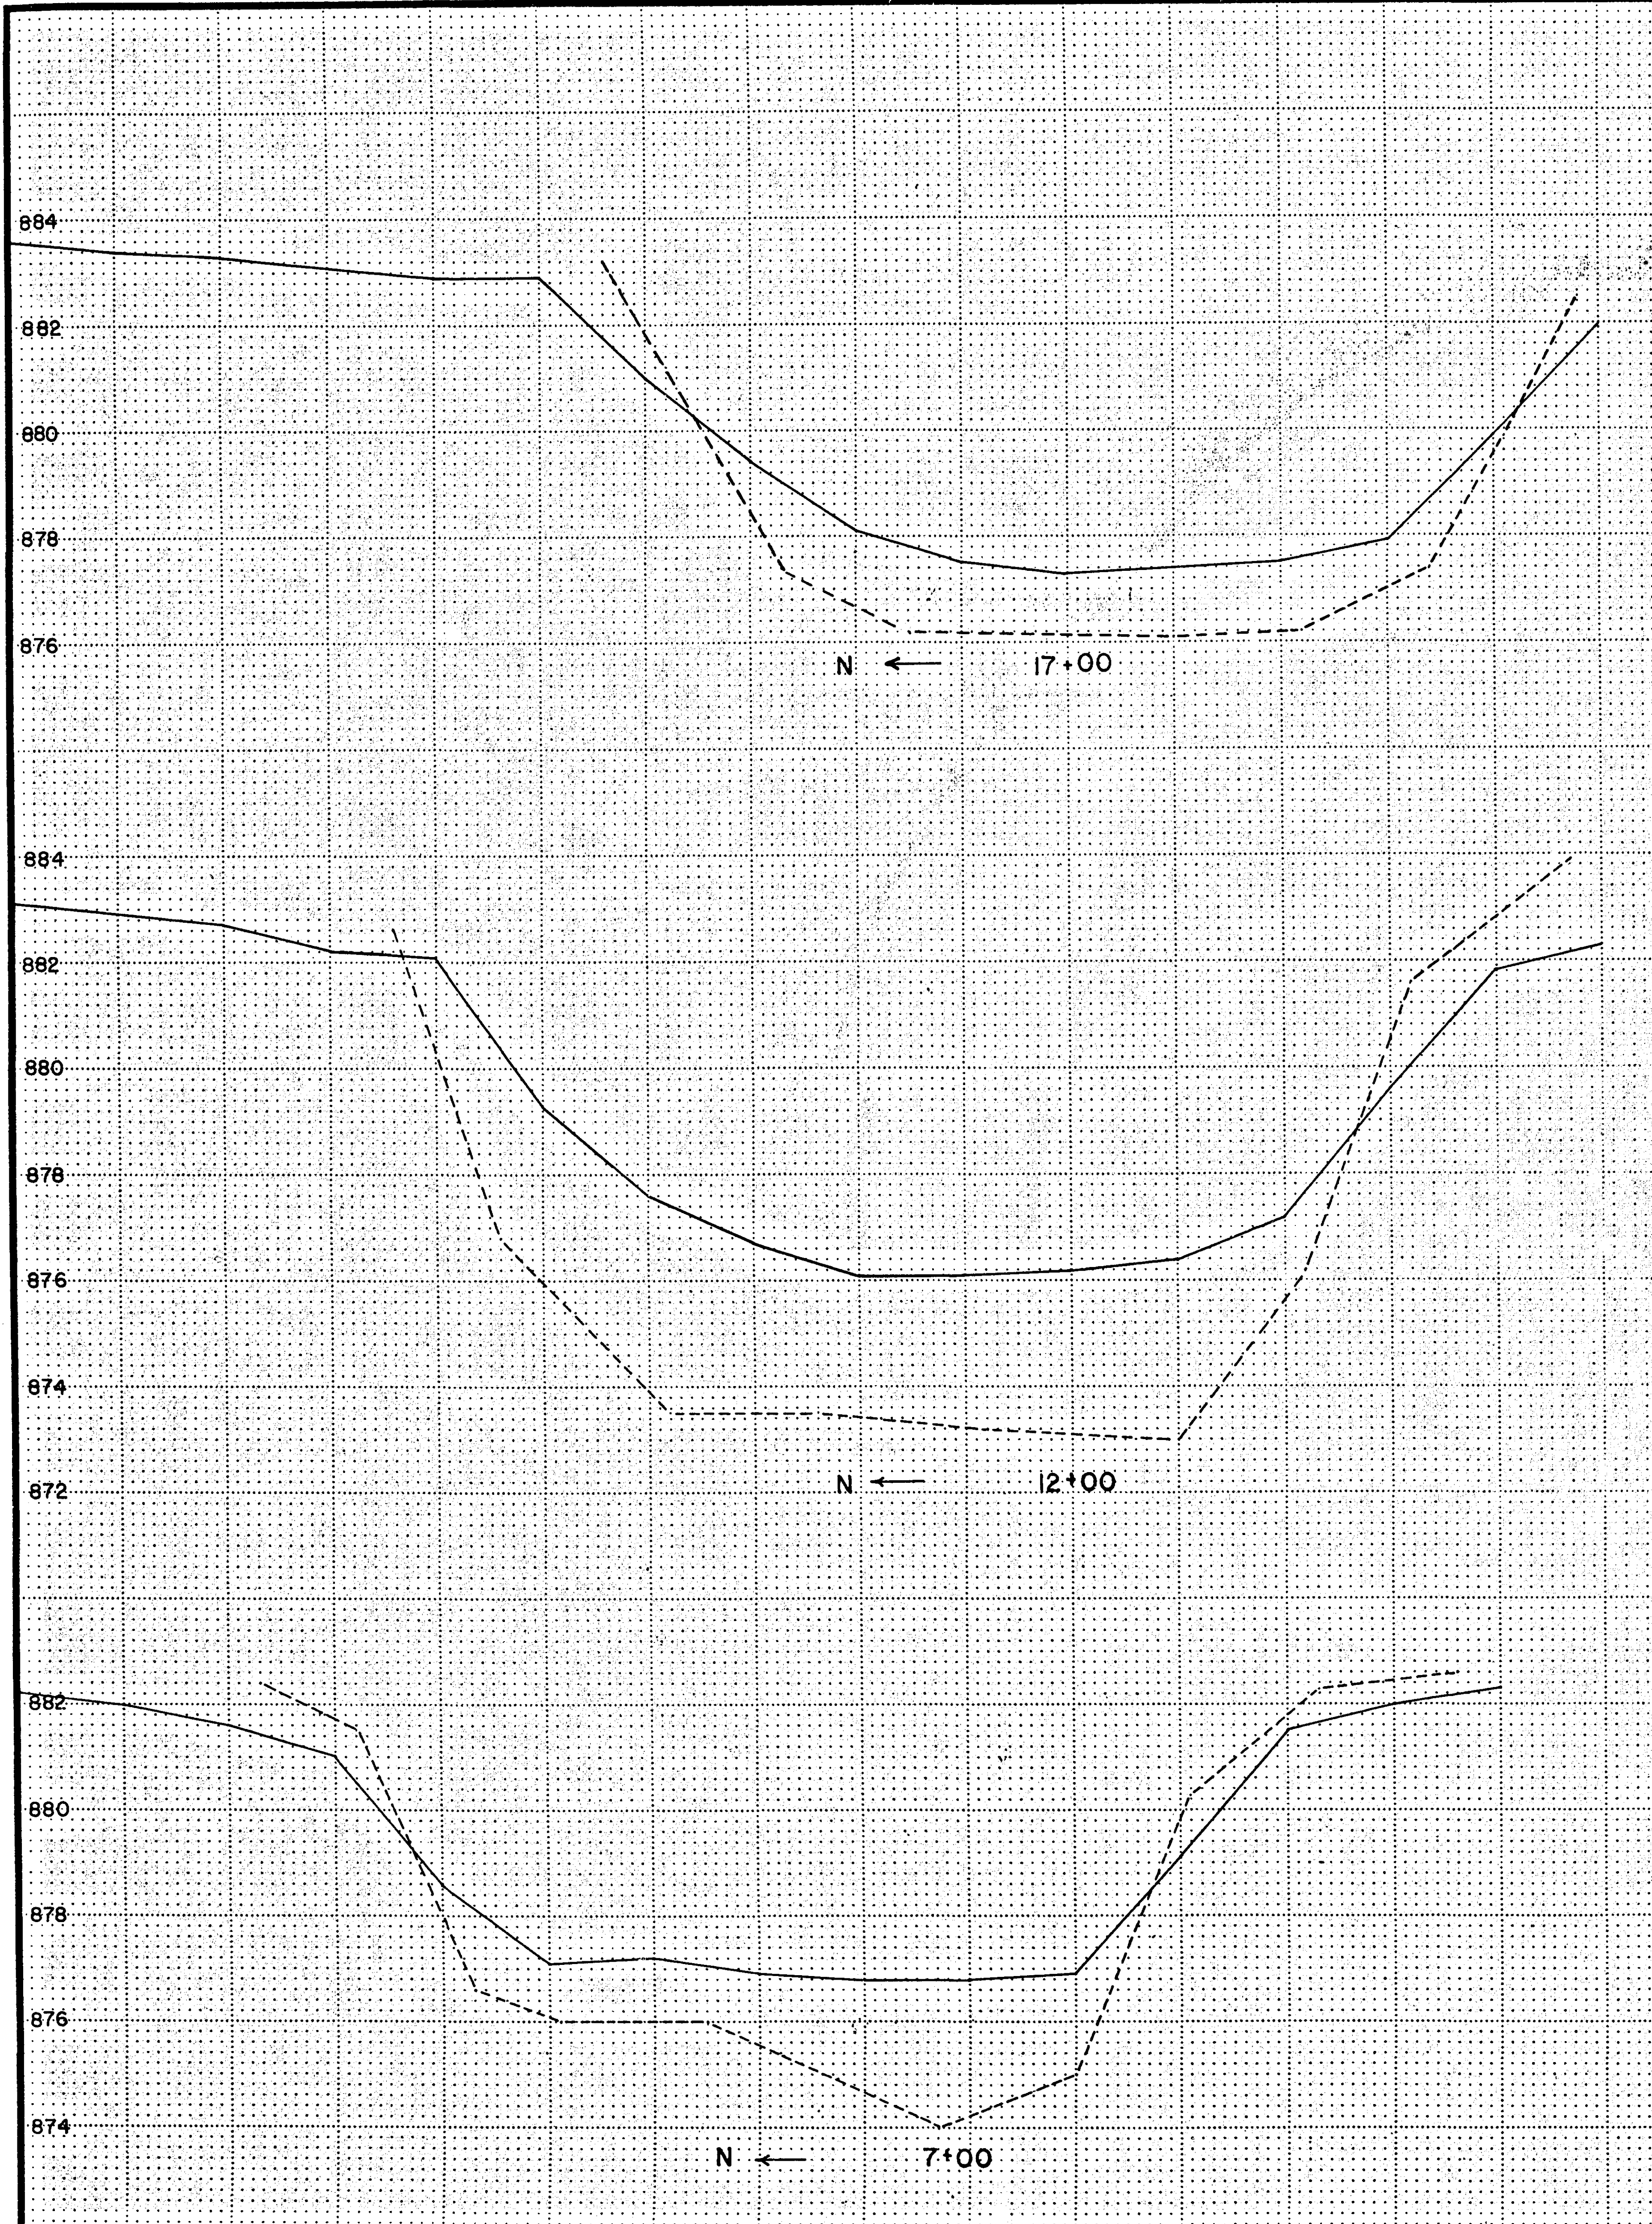

EW 12
1 of 3