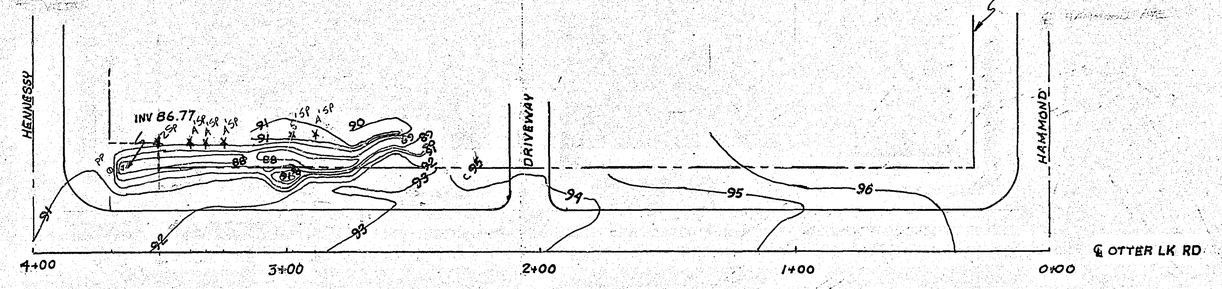

SCALE 1" = 30'

N

OTTER LAKE RD & HENNESSEY CT. (Drainage Survey) **Sheet No. 1 of 1 Sheets**

1990 KR & DB ENV. 36