


**ESTIMATED QUANTITIES**

PARKING LOT	1080 SY
BIT. CURB	455 LF
BIT. PATH	40 SY
FLOATING SILT FENCE	110 LF
SILT FENCE HEAVY DUTY	164 LF
4" WHITE PAINTED STRIPE	400 LF
3" CLASS V	90 CY
1-1/2" BIT. BASE	93 TON
1-1/2" BIT. WEAR	93 TON
CLASS II RIP RAP	1 CY
GRANULAR FILTER	0.5 CY
GEOTEXTILE FABRIC TYPE III	4 SY

ELEVATIONS SHOWN ARE TO TOP OF BITUMINOUS  
 PLANKS AND HARDWARE AVAILABLE AT RAMSEY CO. DEPT. OF PARKS  
 DIMENSIONS TO FACE OF CURB  
 RIP RAP AND GRANULAR FILTER SHALL MEET SPEC. 3601  
 RIP RAP SHALL BE 8"x4.5" AND INSTALLED PER STD. PLATE  
 GEOTEXTILE FABRIC SHALL MEET SPEC. 3733

**BENCH MARK**  
 MN/DOT DISC BRIDGE 9345  
 IN SE COR OF SOUTH FRONTAGE RD BRIDGE 9345.  
 OVER ISLAND LAKE CREEK, 956.394 ELEVATION

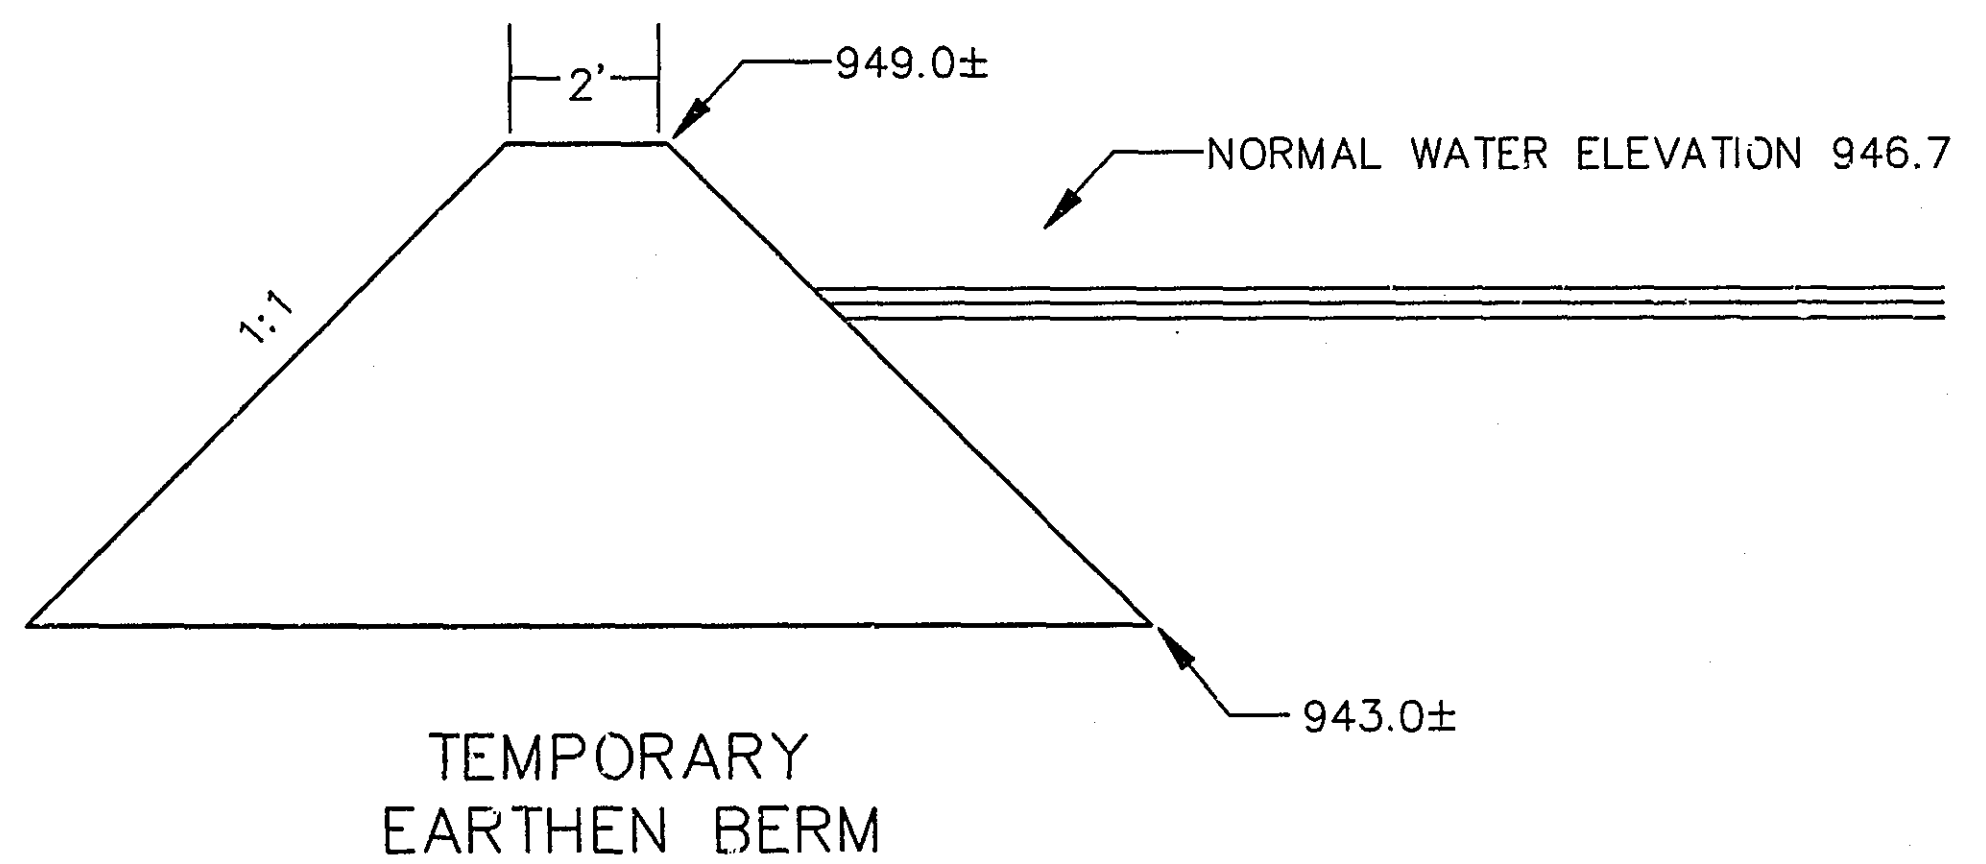

NOTE: TEMPORARY EARTHEN BERM SHALL BE CONSTRUCTED FOR DE-WATERING PURPOSES. THE BERM SHALL BE REMOVED UPON COMPLETION OF CONSTRUCTION. THE EXACT LOCATION SHALL BE DETERMINED IN THE FIELD. (ESTIMATED 195 C.Y.)

CONSTRUCTED 10/96 BY  
 RAMSEY COUNTY MAINT. DEPT.  
 STAKED BY CONSTRUCTION  
 SURVEY CREW  
 Bob Johnson  
 12-96

G:\DWGS\PARKS\ISLANDLK\PARKLOT 4/3/96

REVISED 5-24-96 B.J. & K.L.

ENV 40