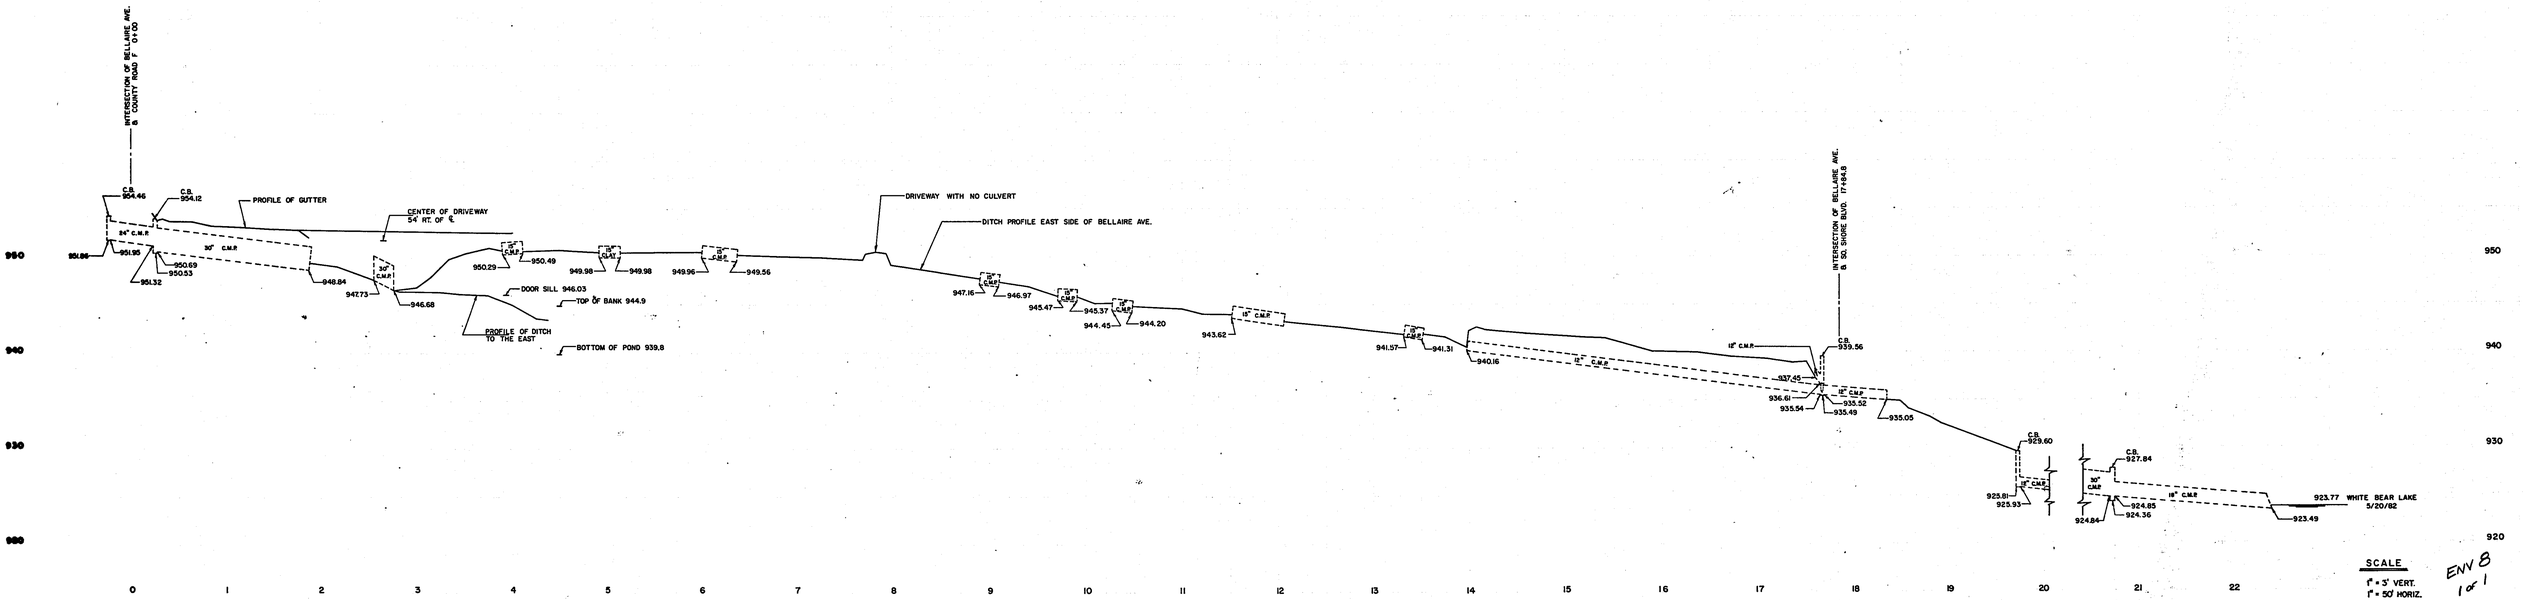

SCALE
1" = 5' VERT.
1" = 50' HORIZ.

ENV 8
1 of 1


