


**OFFICE OF COUNTY ENGINEER
RAMSEY COUNTY
MINN.**

PAUL N. COATES

COUNTY ENGINEER

SCALE ~ 1 in. = 50 ft. O Indicates angle points.
Surveyed by Robert Holterhoff. H.R.Petersen ~ del.
DEC. 1, 1925.

DEC. 1, 1925.

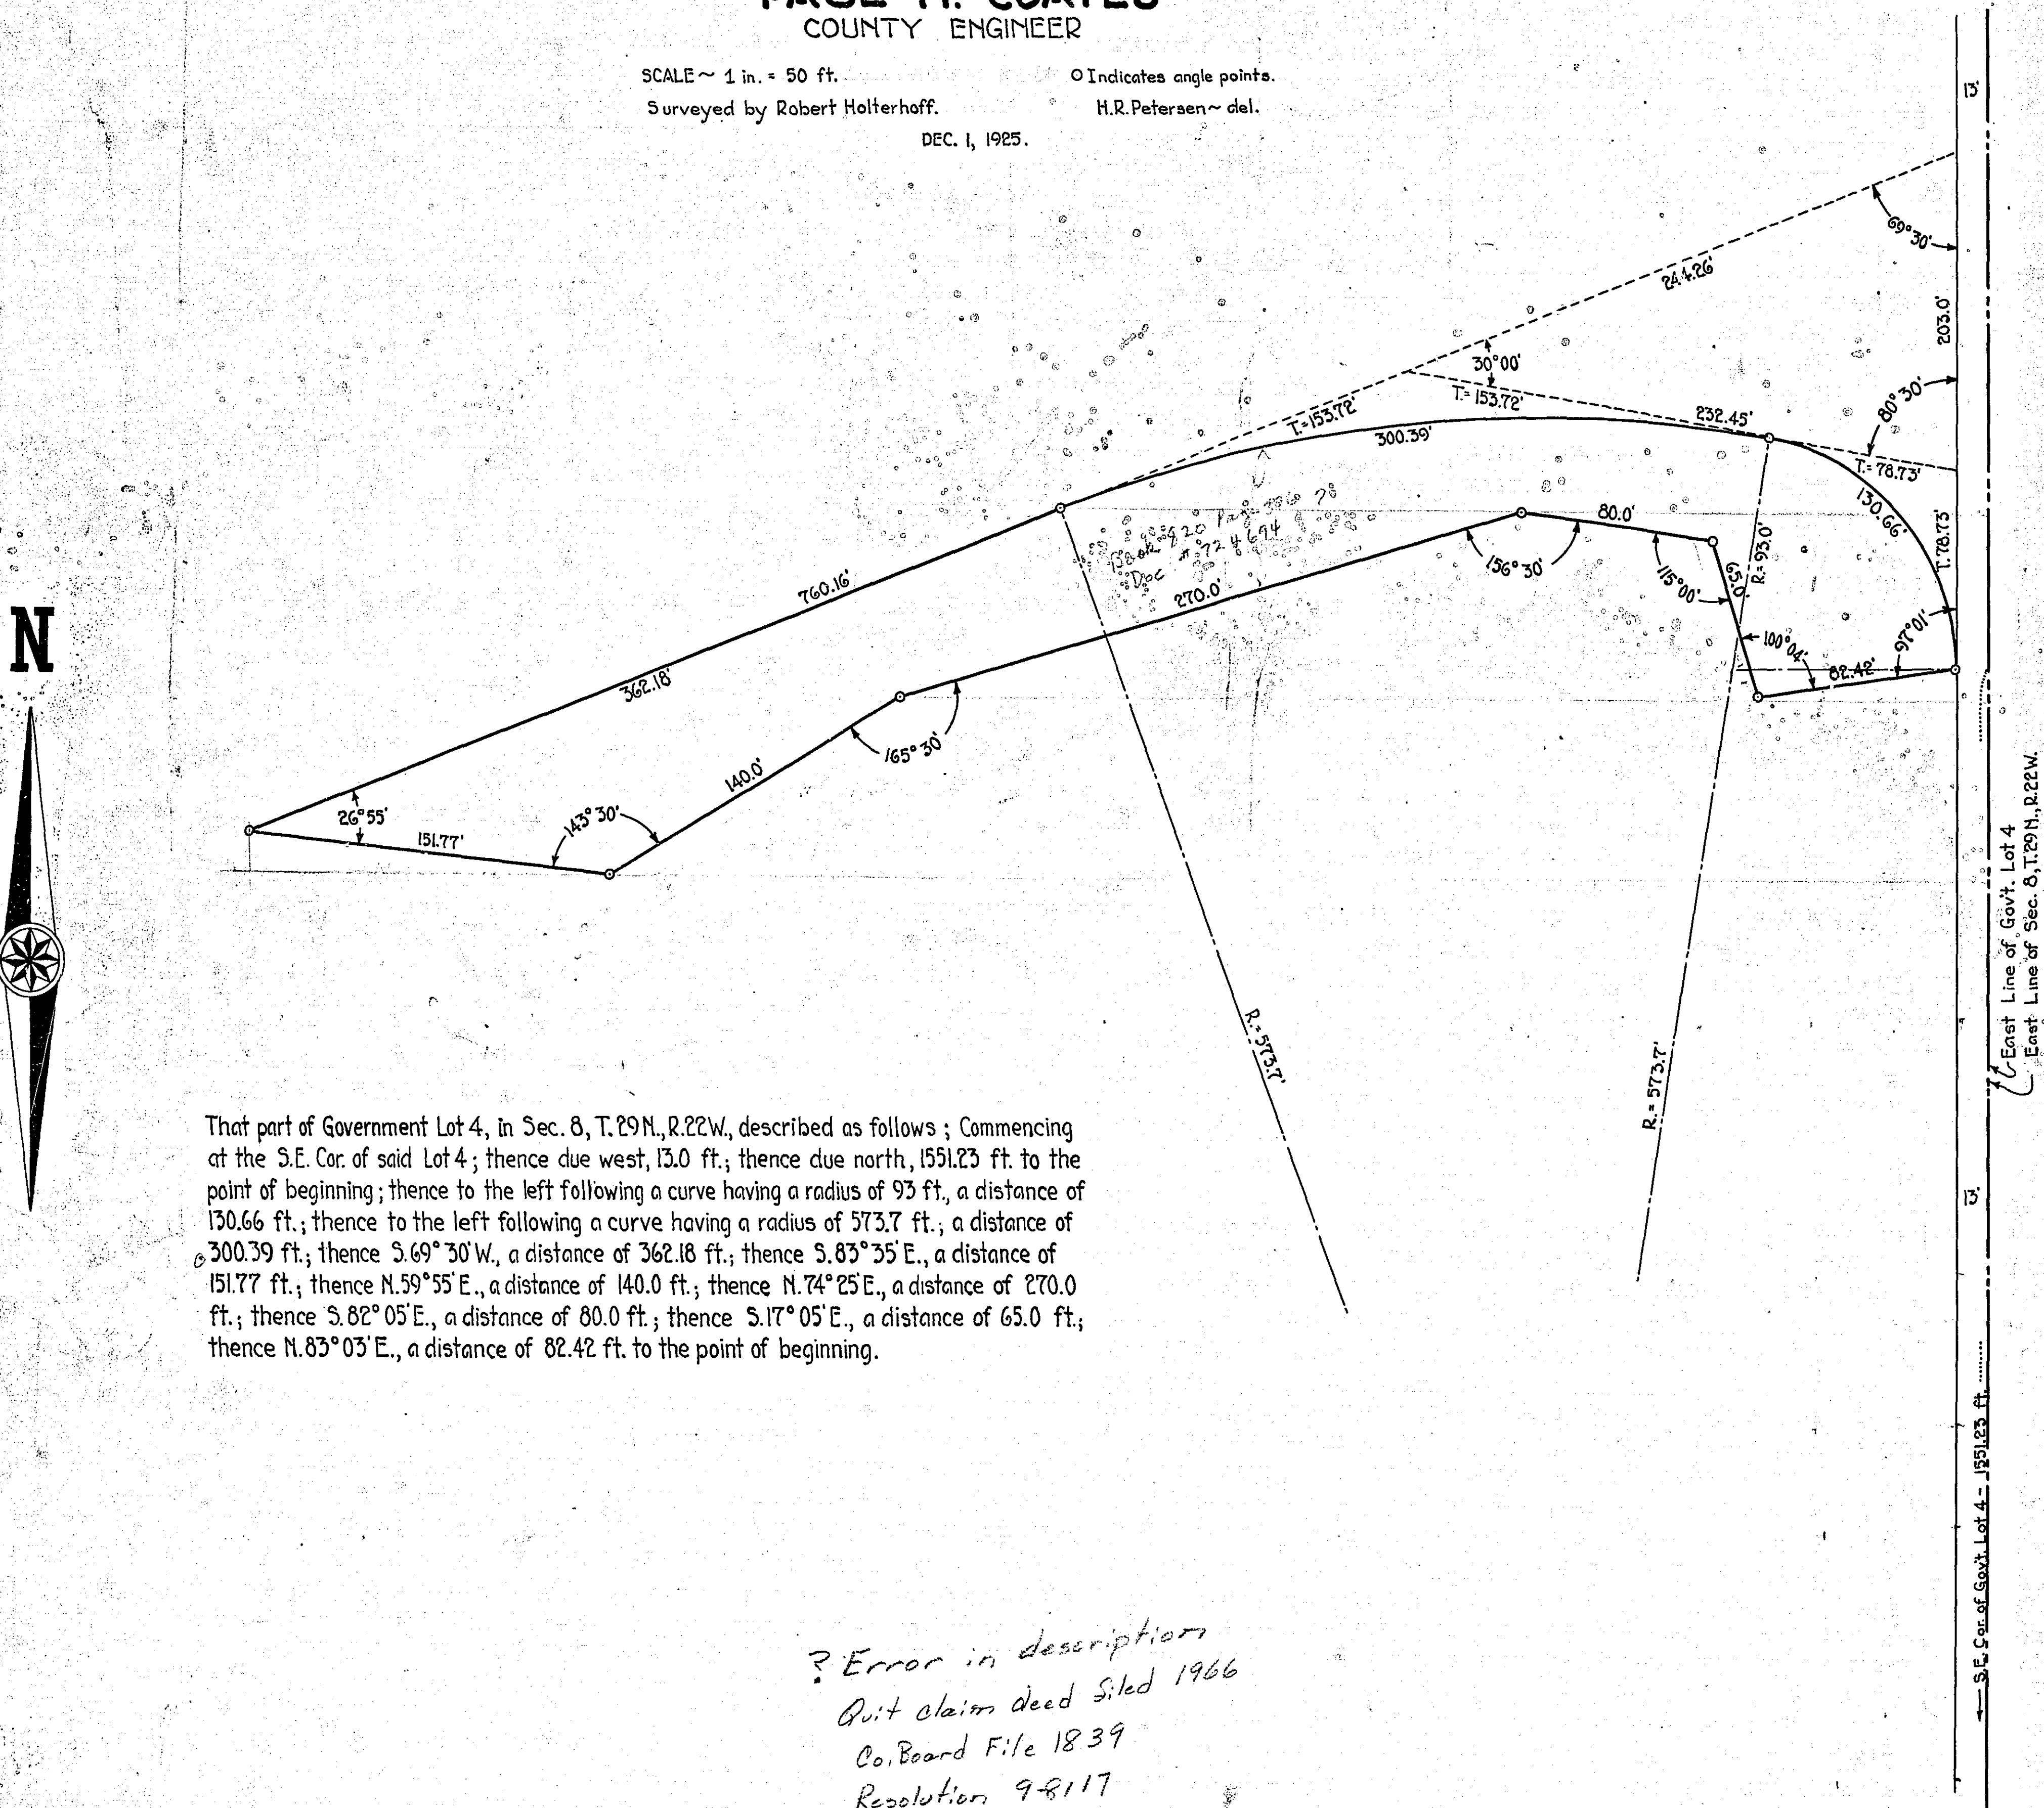

That part of Government Lot 4, in Sec. 8, T. 29 N., R. 22 W., described as follows; Commencing at the S.E. Cor. of said Lot 4; thence due west, 13.0 ft.; thence due north, 1551.23 ft. to the point of beginning; thence to the left following a curve having a radius of 93 ft., a distance of 130.66 ft.; thence to the left following a curve having a radius of 573.7 ft., a distance of 300.39 ft.; thence $S.69^{\circ}30'W.$, a distance of 362.18 ft.; thence $S.83^{\circ}35'E.$, a distance of 151.77 ft.; thence $N.59^{\circ}55'E.$, a distance of 140.0 ft.; thence $N.74^{\circ}25'E.$, a distance of 270.0 ft.; thence $S.82^{\circ}05'E.$, a distance of 80.0 ft.; thence $S.17^{\circ}05'E.$, a distance of 65.0 ft.; thence $N.83^{\circ}03'E.$, a distance of 82.42 ft. to the point of beginning.

? Error in description
Quit claim deed filed 1966
Co. Board File 1839
Resolution 9-8117

Lake Gervais Peninsula

MICROFILMED
RAMSEY CO. ENGR.

R-301