

R-427


MICROFILMED  
RAMSEY CO. ENGR.

PRINTED IN U.S.A.  
ON 100% RAG PAPER MADE IN U.S.A.

Perfect CROSS-SECTION 10" x 10" x 1" INCH  
EUGENE DIETZGEN Co.

PRINTED IN U.S.A.  
ON 100% RAG PAPER MADE IN U.S.A.

Perfect CROSS-SECTION 10" x 10" x 1" INCH  
EUGENE DIETZGEN Co.

 


10 - 10 - 1 INCH  
GEN Co.

PRINTED IN U.S.A.  
ON 100% RAG PAPER MADE IN U.S.A.

CHROSS SECTION 10 - 10 - 1 INCH  
EUGENE DIETZGEN Co.

PRINTED IN U.S.A.  
ON 100% RAG PAPER MADE IN U.S.A.

CHROSS SECTION 10 - 10 - 1 INCH  
EUGENE DIETZGEN Co.

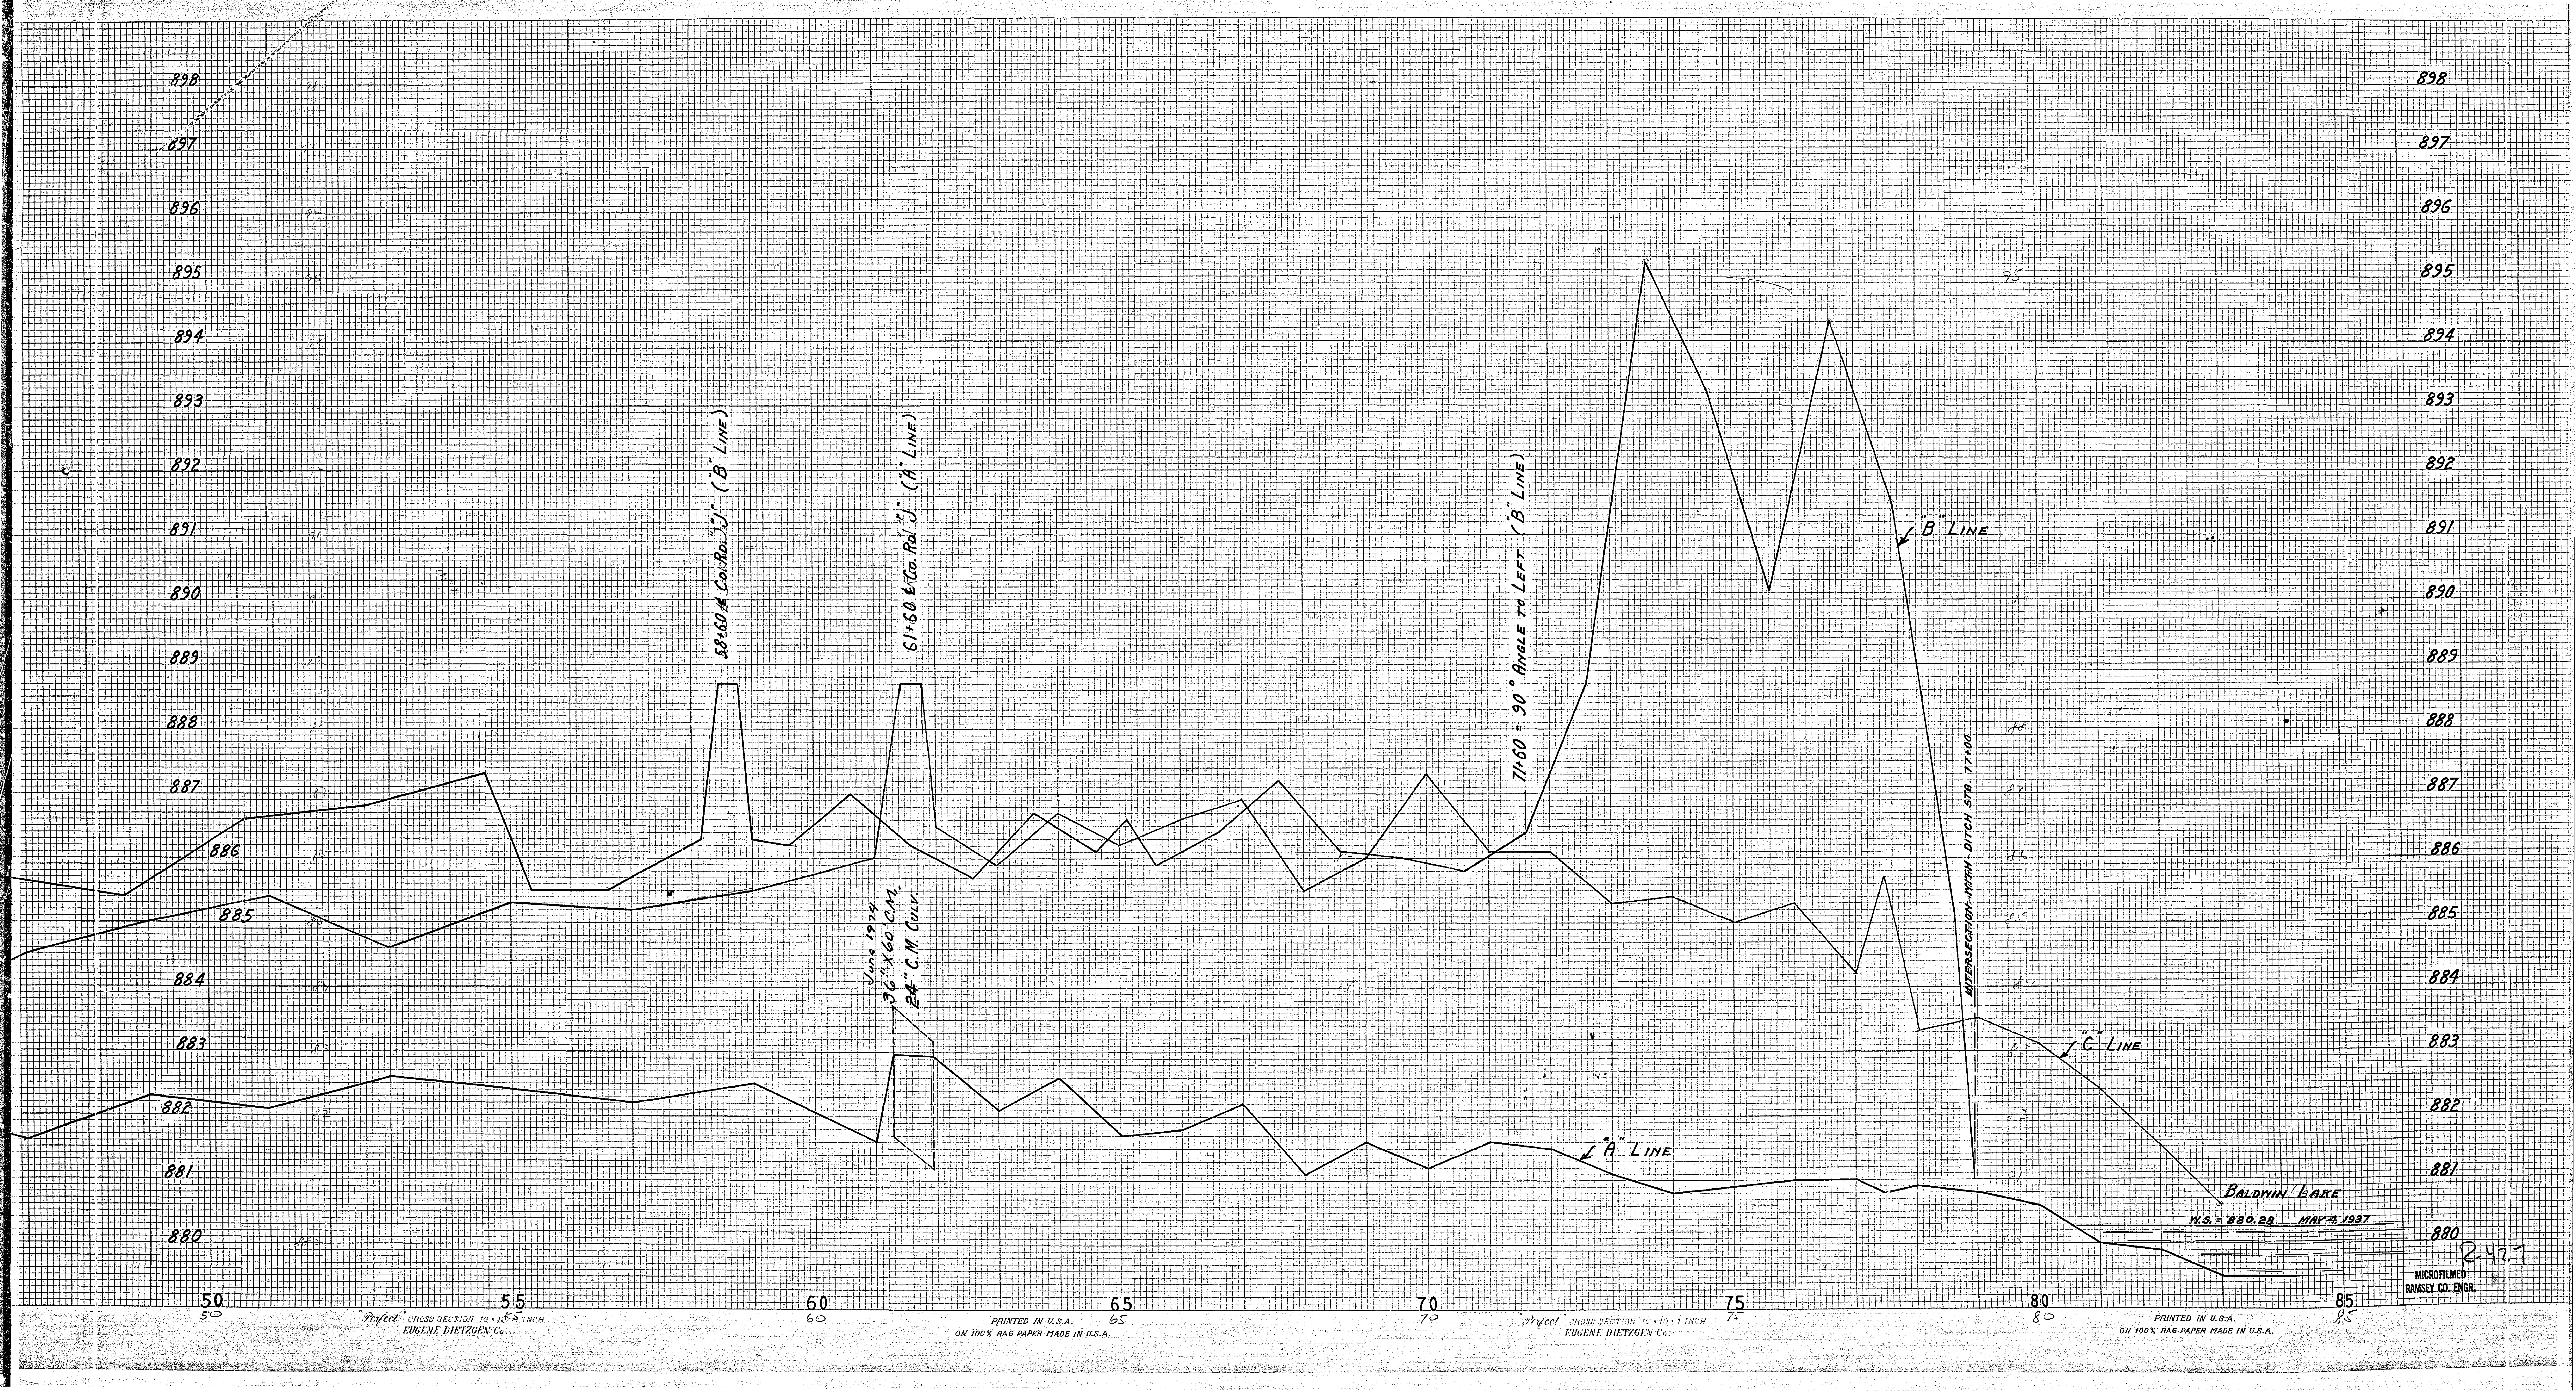

898  
897  
896  
895  
894  
893  
892  
891  
890  
889  
888  
887  
886  
885  
884  
883  
882  
881  
880

898  
897  
896  
895  
894  
893  
892  
891  
890  
889  
888  
887  
886  
885  
884  
883  
882  
881  
880

50

55

60

65

70

75

80

85

Perfect CROSS SECTION 10 - 10 1/2 INCH  
EUGENE DIETZGEN Co.

PRINTED IN U.S.A.  
ON 100% RAG PAPER MADE IN U.S.A.

Perfect CROSS SECTION 10 - 10 1/2 INCH  
EUGENE DIETZGEN Co.

PRINTED IN U.S.A.  
ON 100% RAG PAPER MADE IN U.S.A.

MICROFILMED  
RAMSEY CO. ENGR.

2-427

58+60 # Co. Rd. J (B LINE)

61+60 # Co. Rd. J (A LINE)

June 1974  
36" X 60 C.M.  
24" C.M. CUR.

71+60 = 90° ANGLE TO LEFT (B LINE)

B LINE

C LINE

A LINE

BALDWIN LAKE

H.S. = 880.28 MAY 4, 1937

INTERSECTION WITH DITCH STA. 77+00