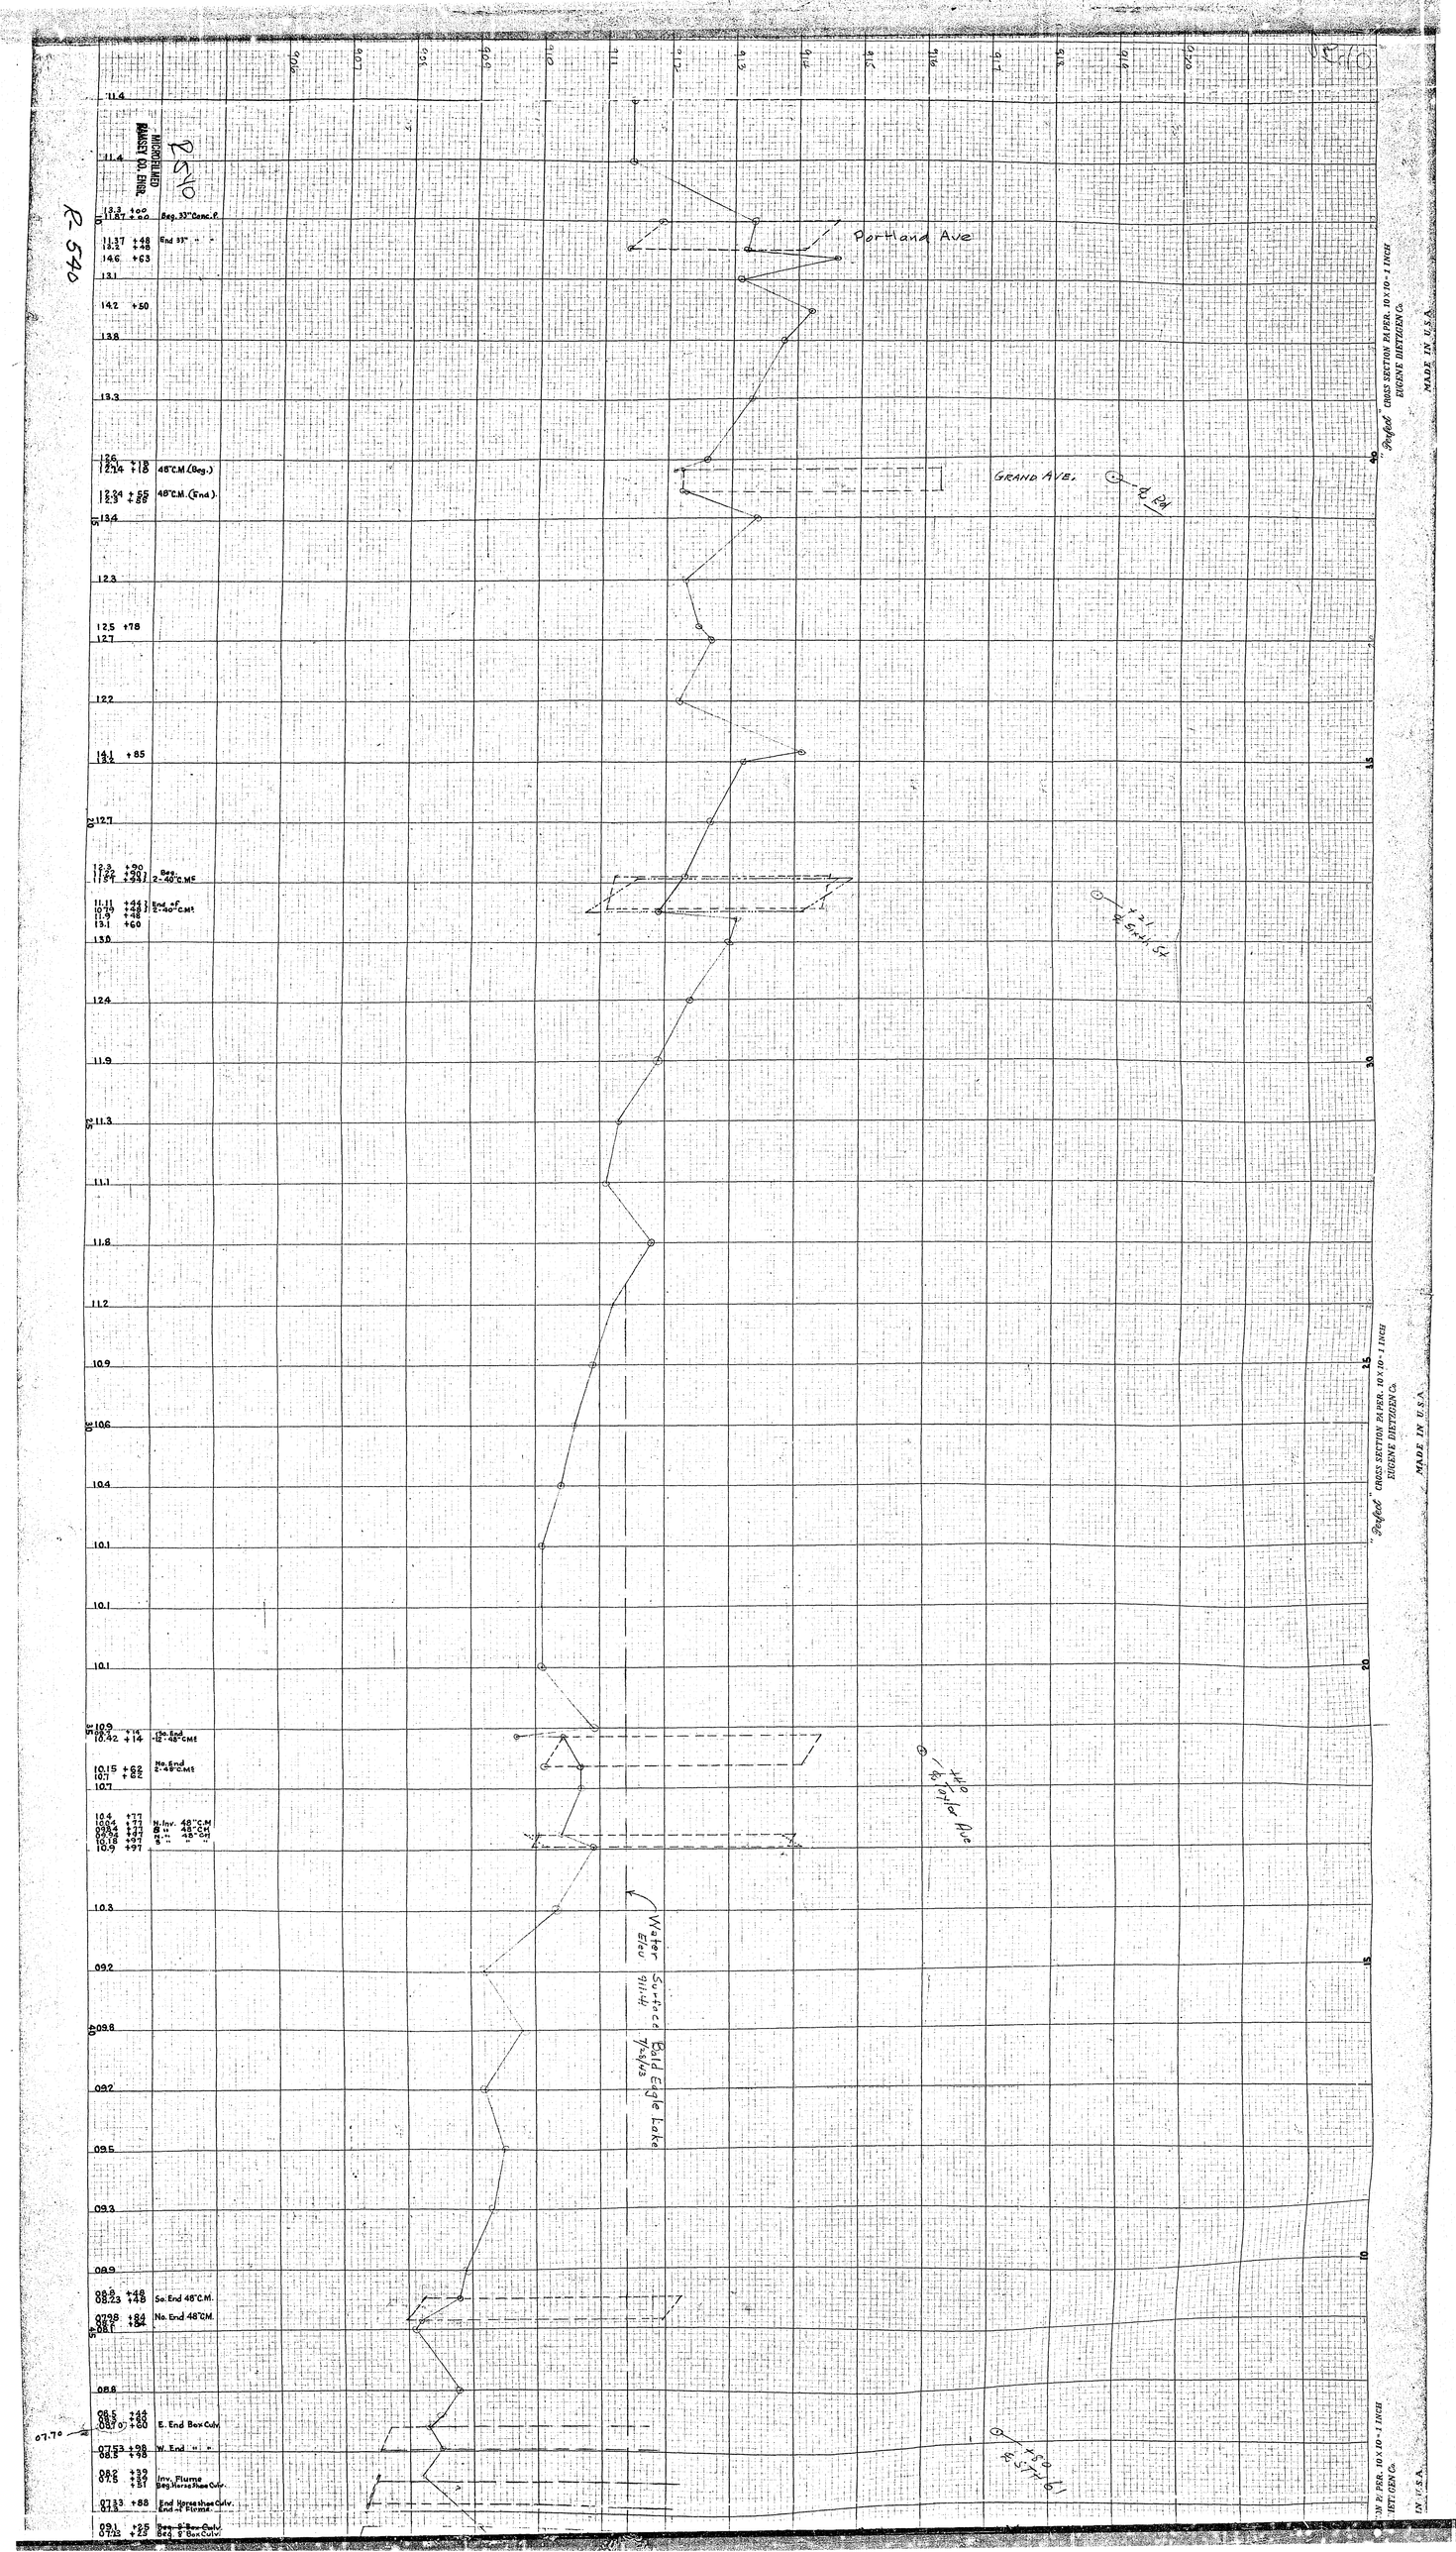
R-540
Portland Ave
GRAND AVE.
Water Surface Bald Eagle Lake 9/11/48
Beg. 33° Conc. P.
End 33° " "
48"CM (Beg.)
48"CM. (End.)
Beg. 2-40"C.M.P.
End of 2-40"C.M.P.
So. End 2-48"CMP
No. End 2-48"C.M.P.
W. Inv. 48"C.M.
E. " 48"C.M.
So. End 48"C.M.
No. End 48"C.M.
E. End Box Culv.
W. End " "
Inv. Flume
Beg. Horse Shoe Culv.
End Horse Shoe Culv.
End of Flume
Beg. 8'Box Culv.
End 8'Box Culv.
07.70
Perfect CROSS SECTION PAPER. 10 X 10 - 1 INCH
EUGENE DIETZGEN Co.
MADE IN U.S.A.

"Dietzgen" CROSS SECTION PAPER. 10 X 10 = 1 INCH
EUGENE DIETZGEN Co.
MADE IN U.S.A.

"Dietzgen" CROSS SECTION PAPER. 10 X 10 = 1 INCH
EUGENE DIETZGEN Co.
MADE IN U.S.A.

Water Surface Bald Eagle Lake
Elev. 911.4ft 7/25/13

Profile
JUDICAL DITCH #1
from Portland Ave & Sixth St. to Bald Eagle

R-540

MICROFILM
RAMSEY CO.