

Profile Showing Portion of Ditch 16

as Redesigned and Constructed by the St. Paul Water Works.

Survey - November 7th 1925.
OFFICE OF RAMSEY COUNTY
ENGINEER.

Original Elevations
180.0

179.0

178.0

177.0

176.0

175.0

174.0

173.0

MICROFILMED
SEY. CO. ENGR.

P 578

40

45

50

55


60

65

70

75

80

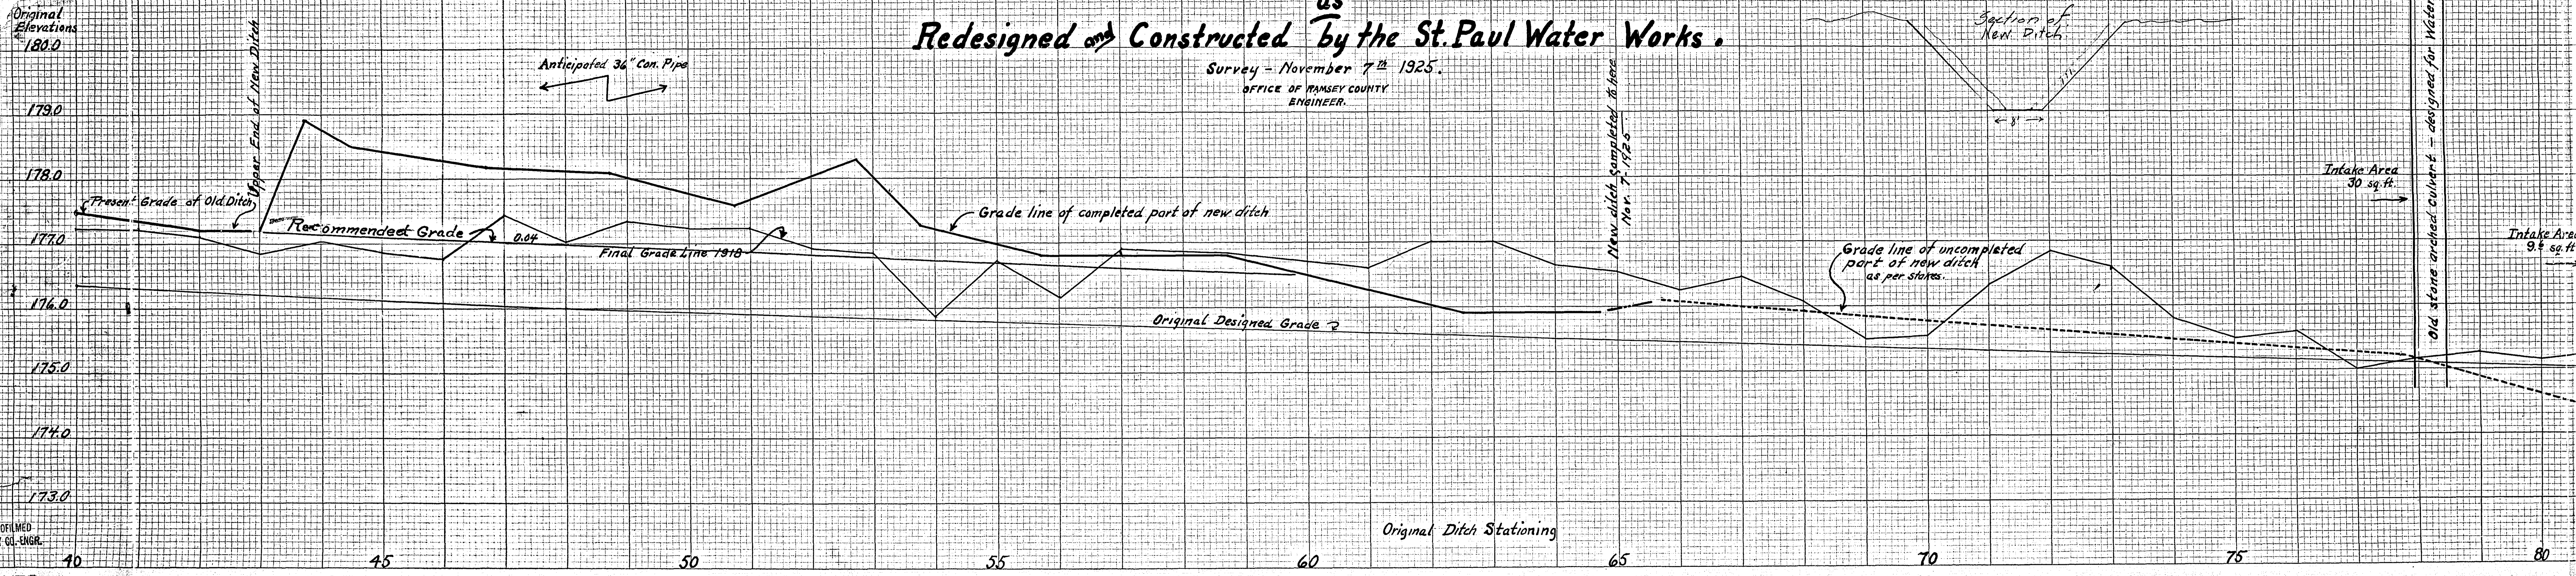

Centerville Road

Old stone arched culvert - designed for Waterway

Intake Area 9.6 sq. ft.

Intake Area 30 sq. ft.

Grade line of uncompleted part of new ditch as per stakes.

Grade line of completed part of new ditch

Final Grade Line 1918

Recommended Grade

0.04

Anticipated 36" Con. Pipe

Section of New Ditch

8'


New ditch completed to here Nov. 7, 1925

Original Designed Grade

Original Ditch Stationing

Profile Showing Portion of Ditch 16 as Redesigned and Constructed by the St. Paul Water Works.

Survey - November 7th 1925.
OFFICE OF RAMSEY COUNTY
ENGINEER.

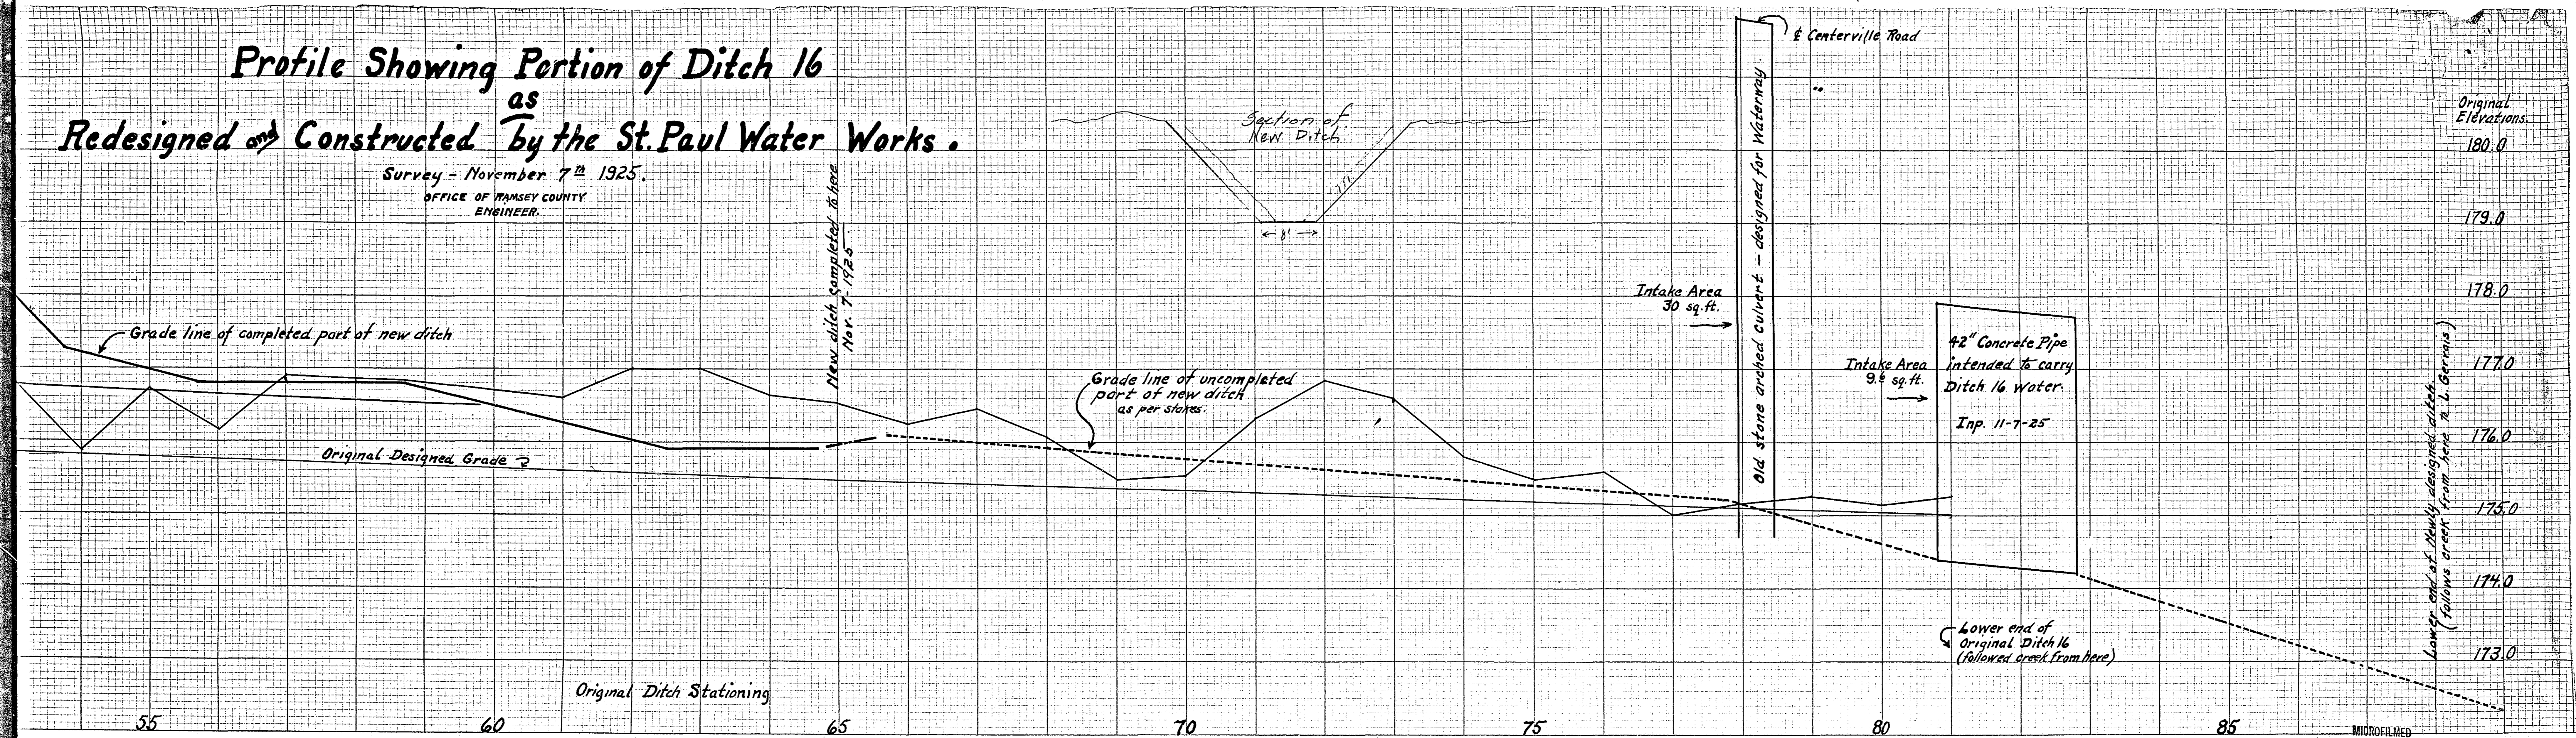

Lower end of Newly designed ditch
(follows creek from here to L. Garra's)

MICROFILMED
RAMSEY CO. ENGR
R 578