
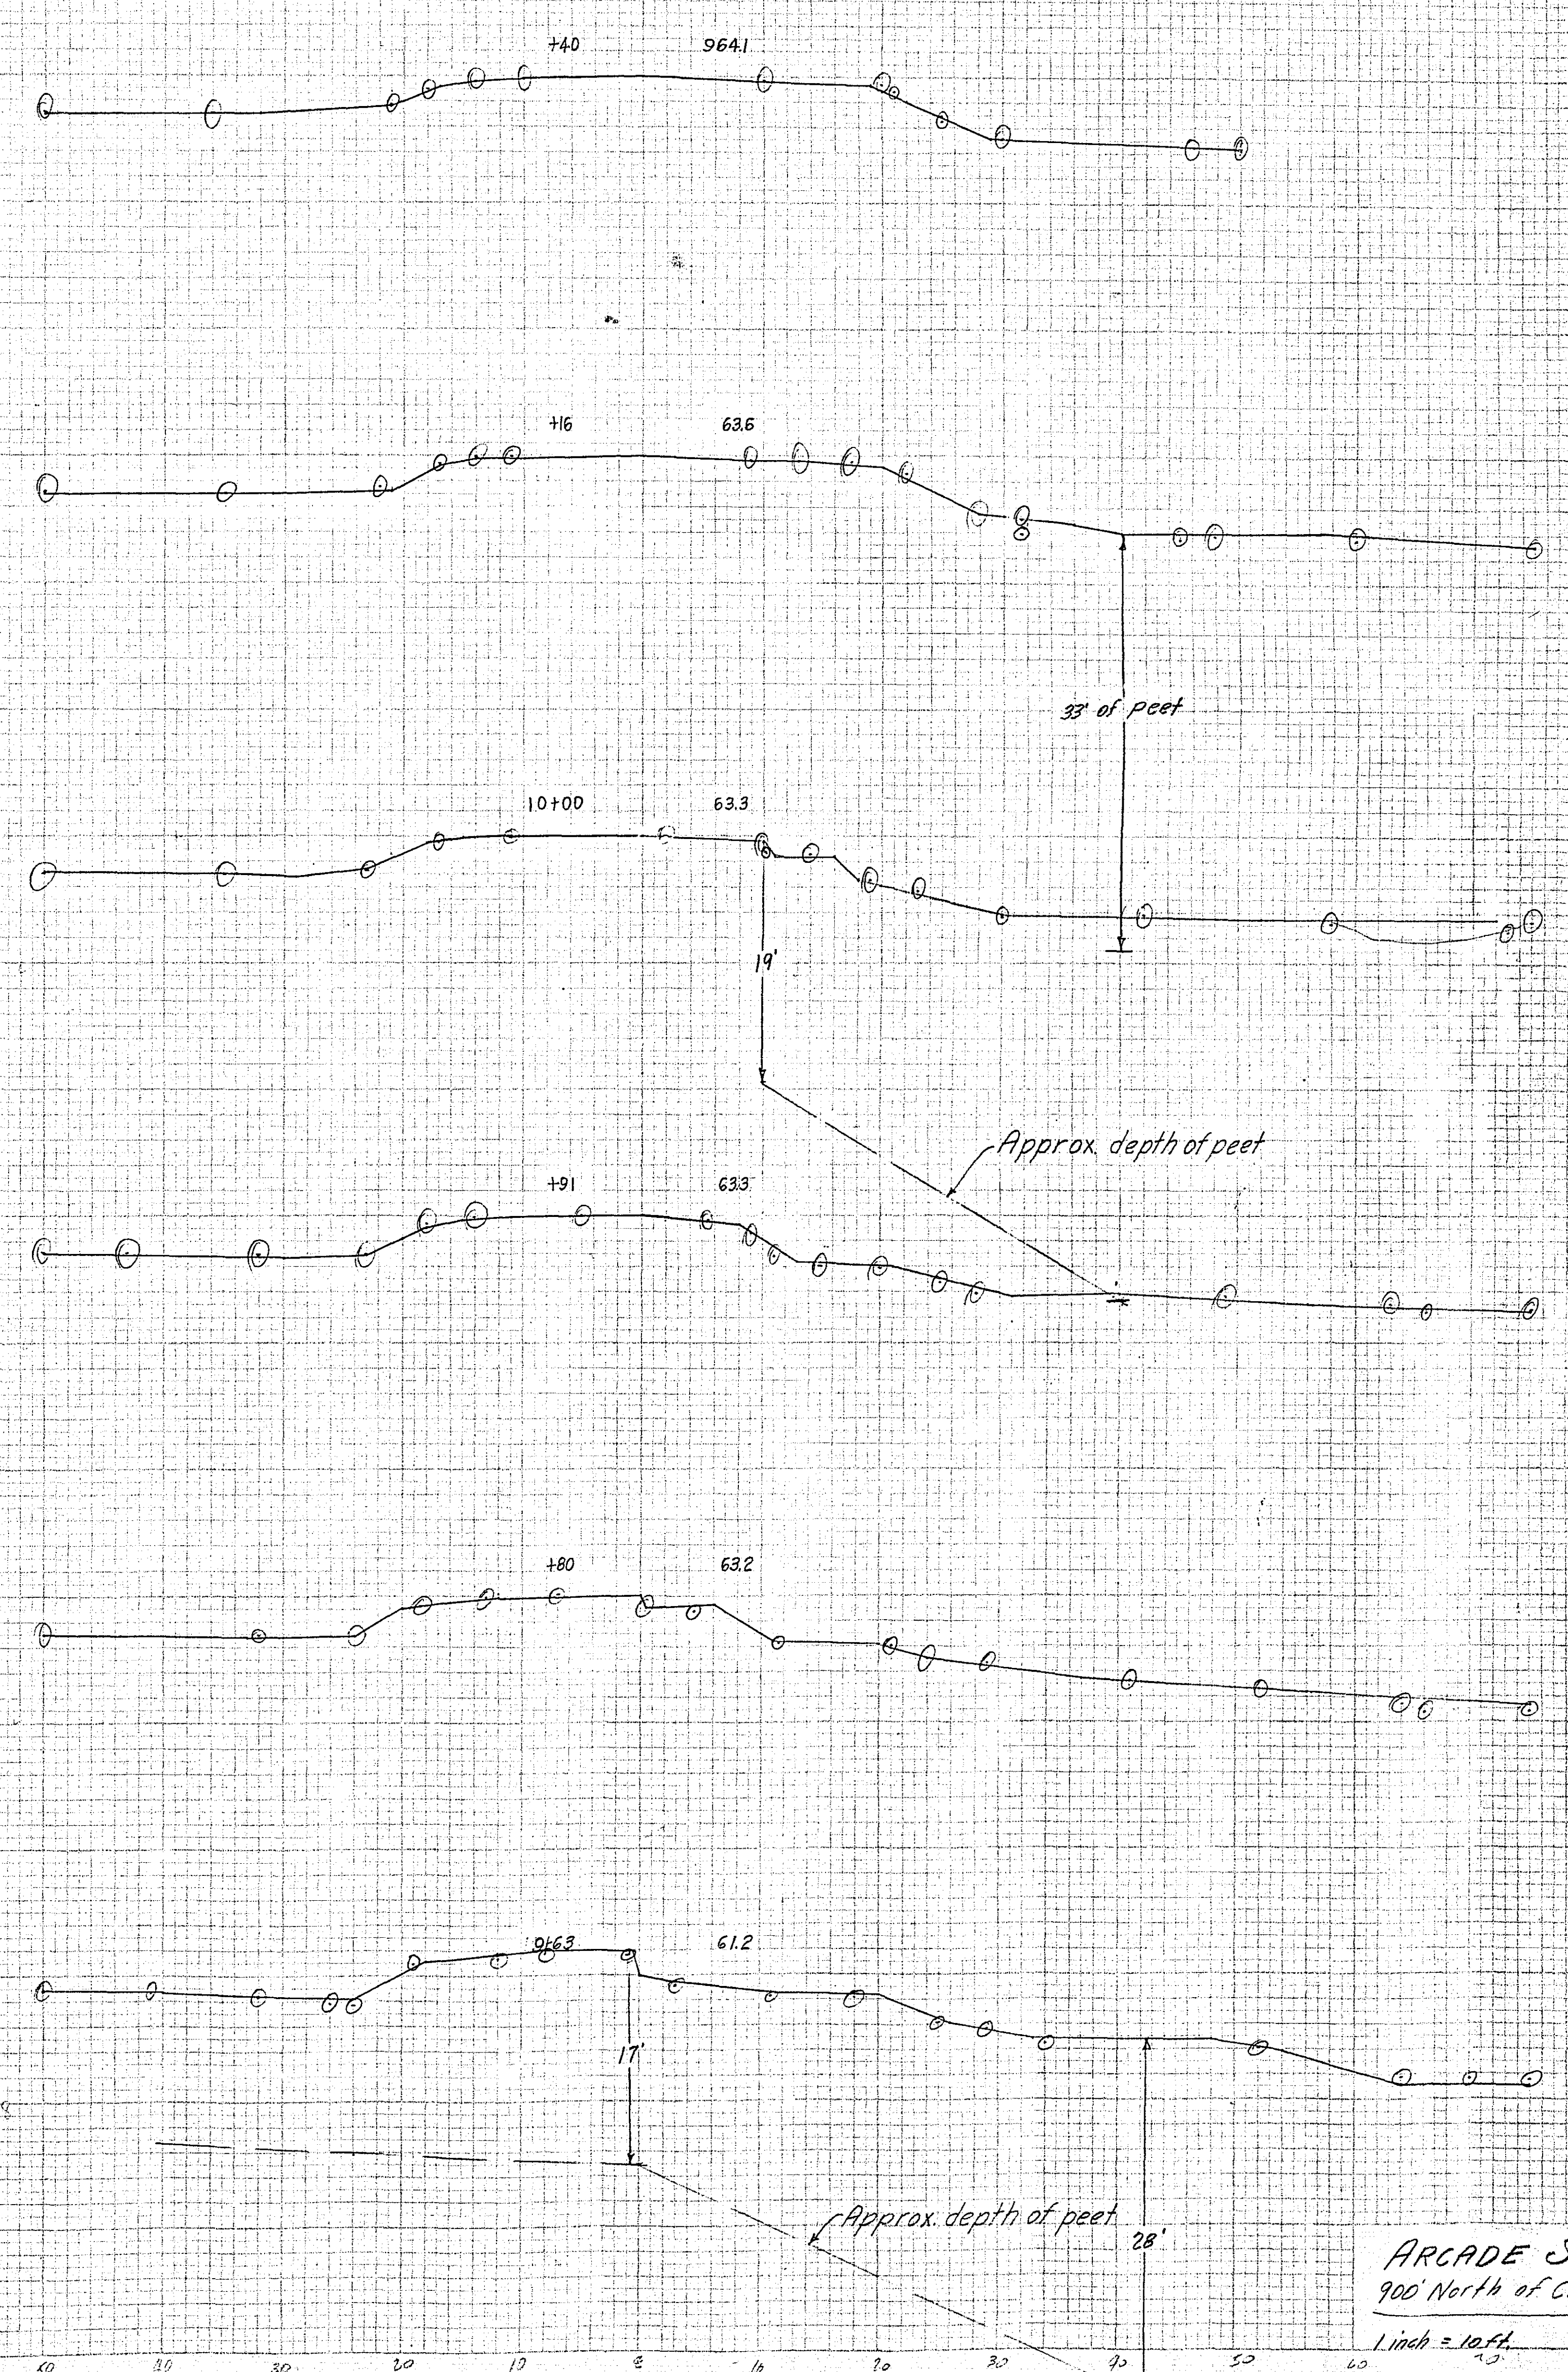


NO.	DATE
1	1/25/46
2	
3	
4	
5	
6	
7	
8	
9	
10	

NO.	DATE
1	1/25/46
2	
3	
4	
5	
6	
7	
8	
9	
10	

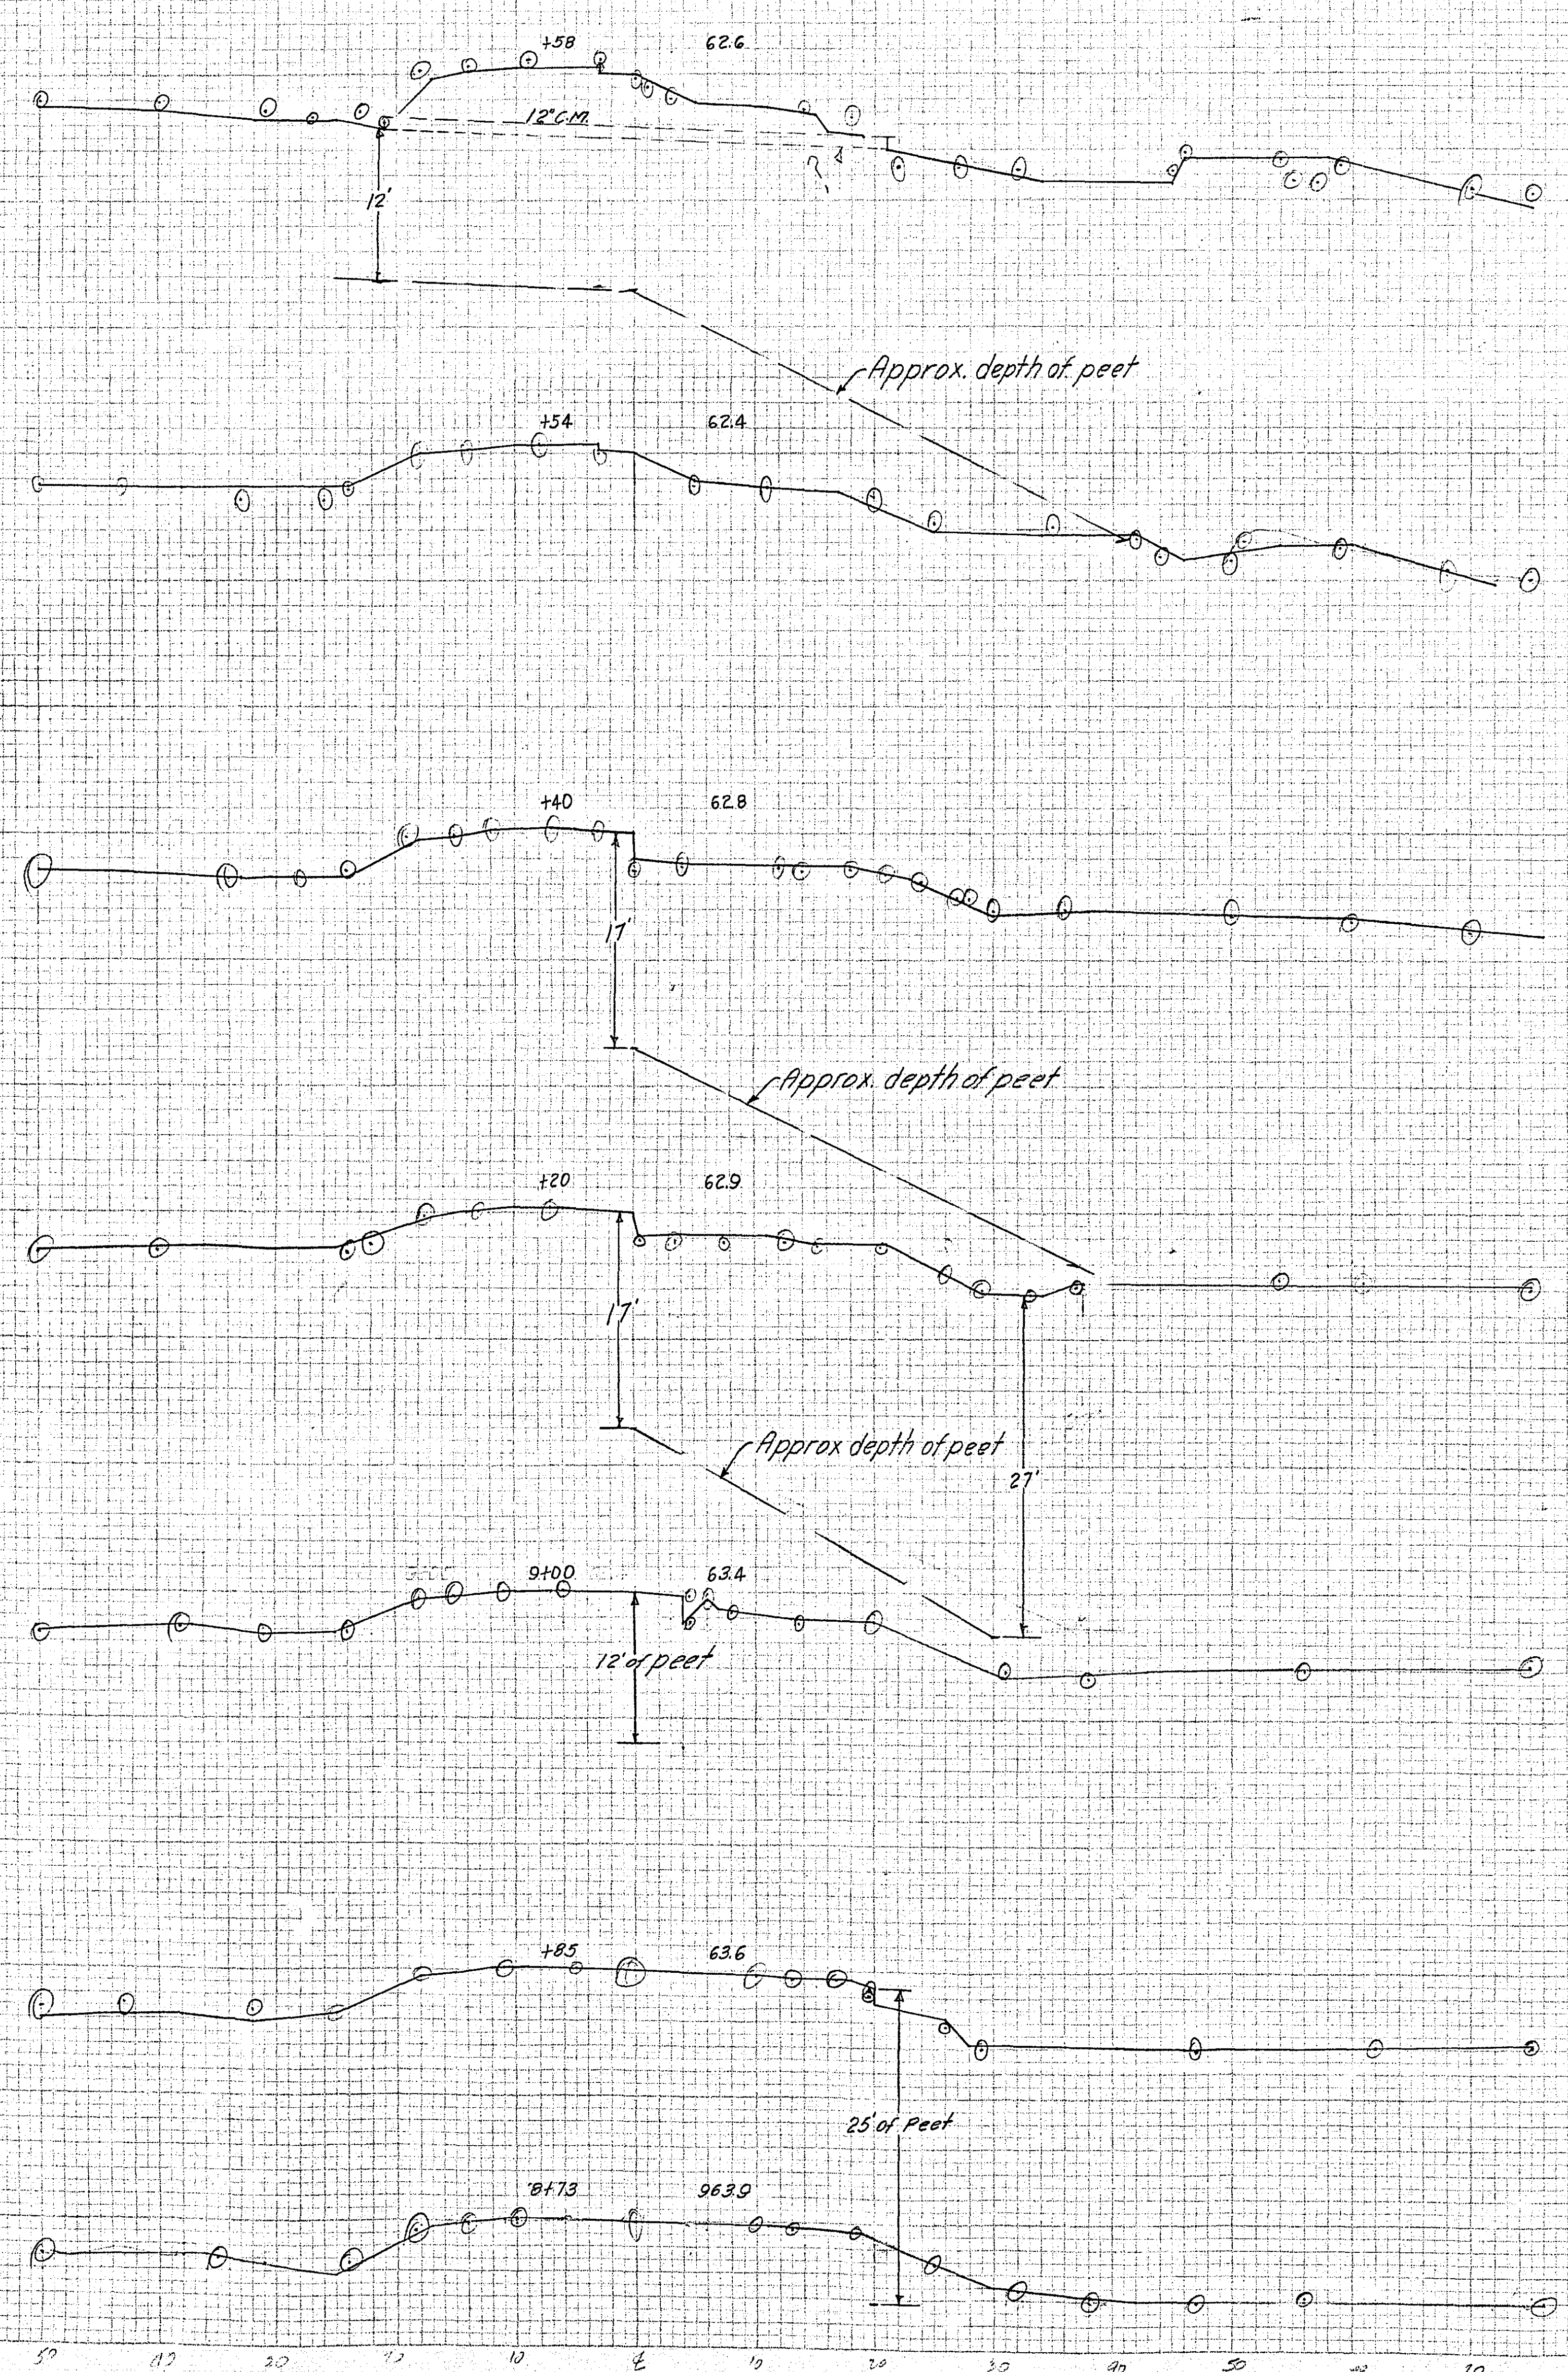

ARCADE ST
900' North of Co. Rd. 19 1/2"
1946
1 inch = 10 ft.

E-111