



BOY'S FARM PROPERTY

SCALE 1" = 300'

MICROFILMED
RAMSEY CO. ENGR.

R-694

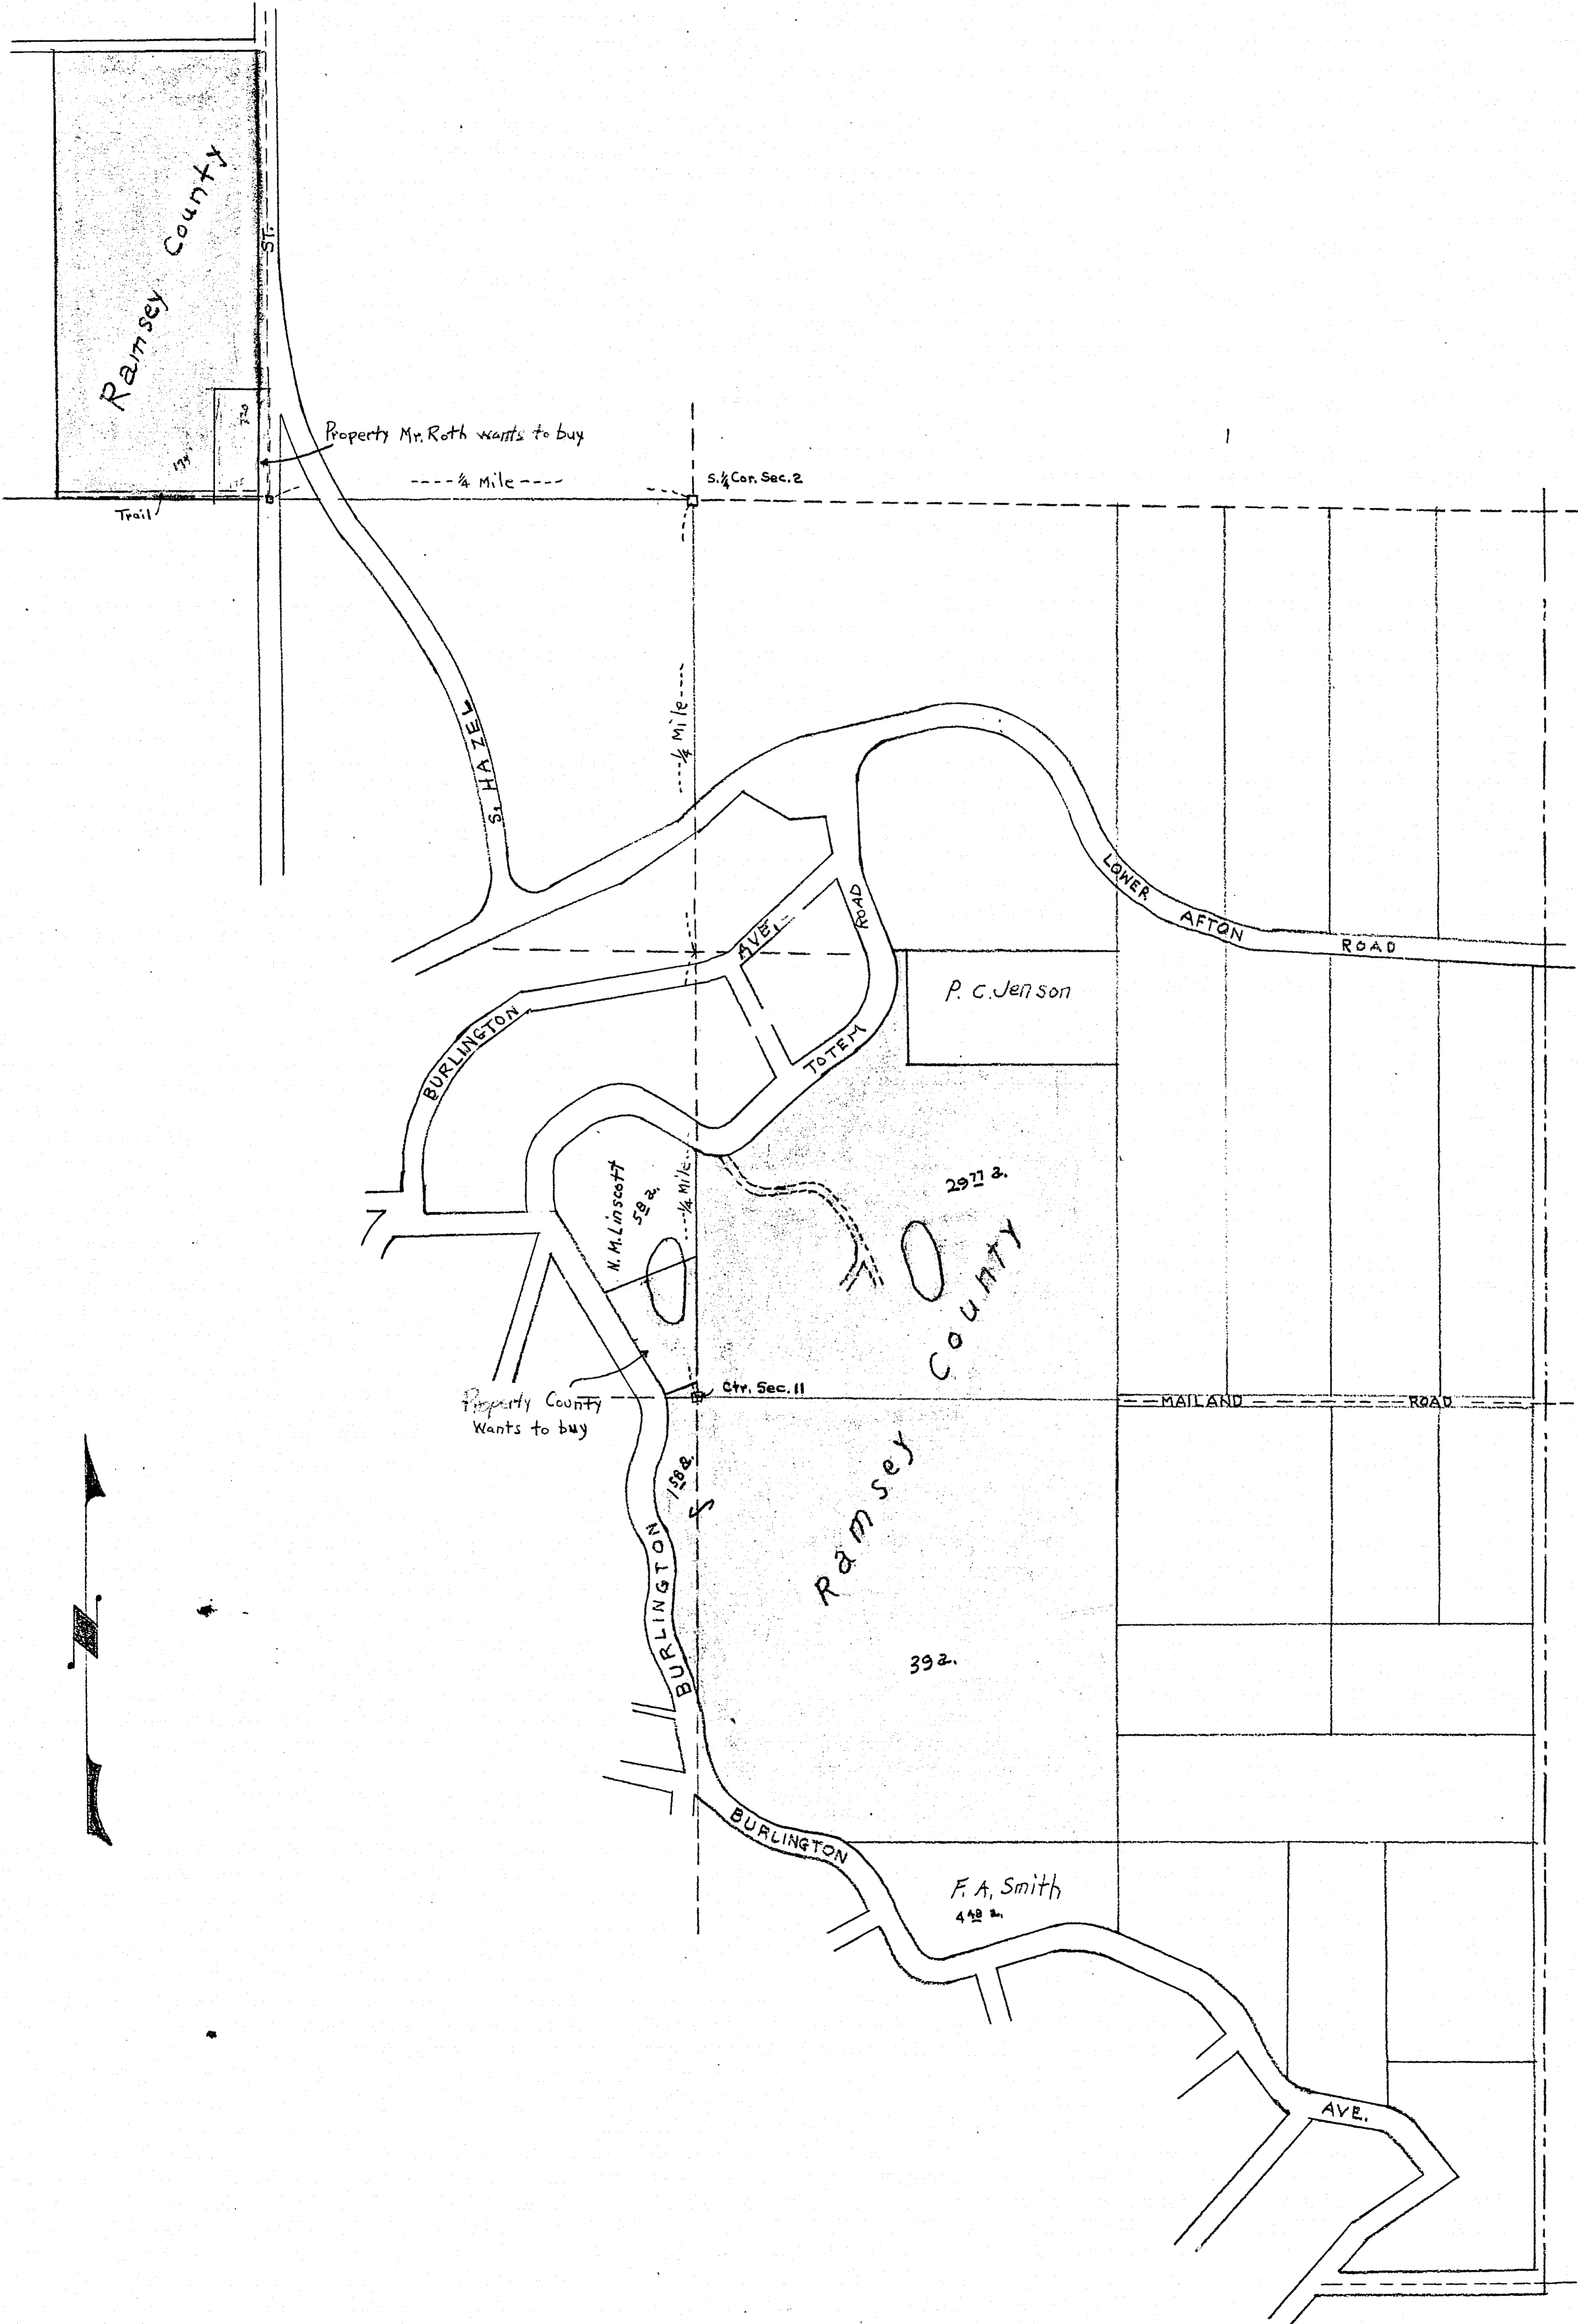

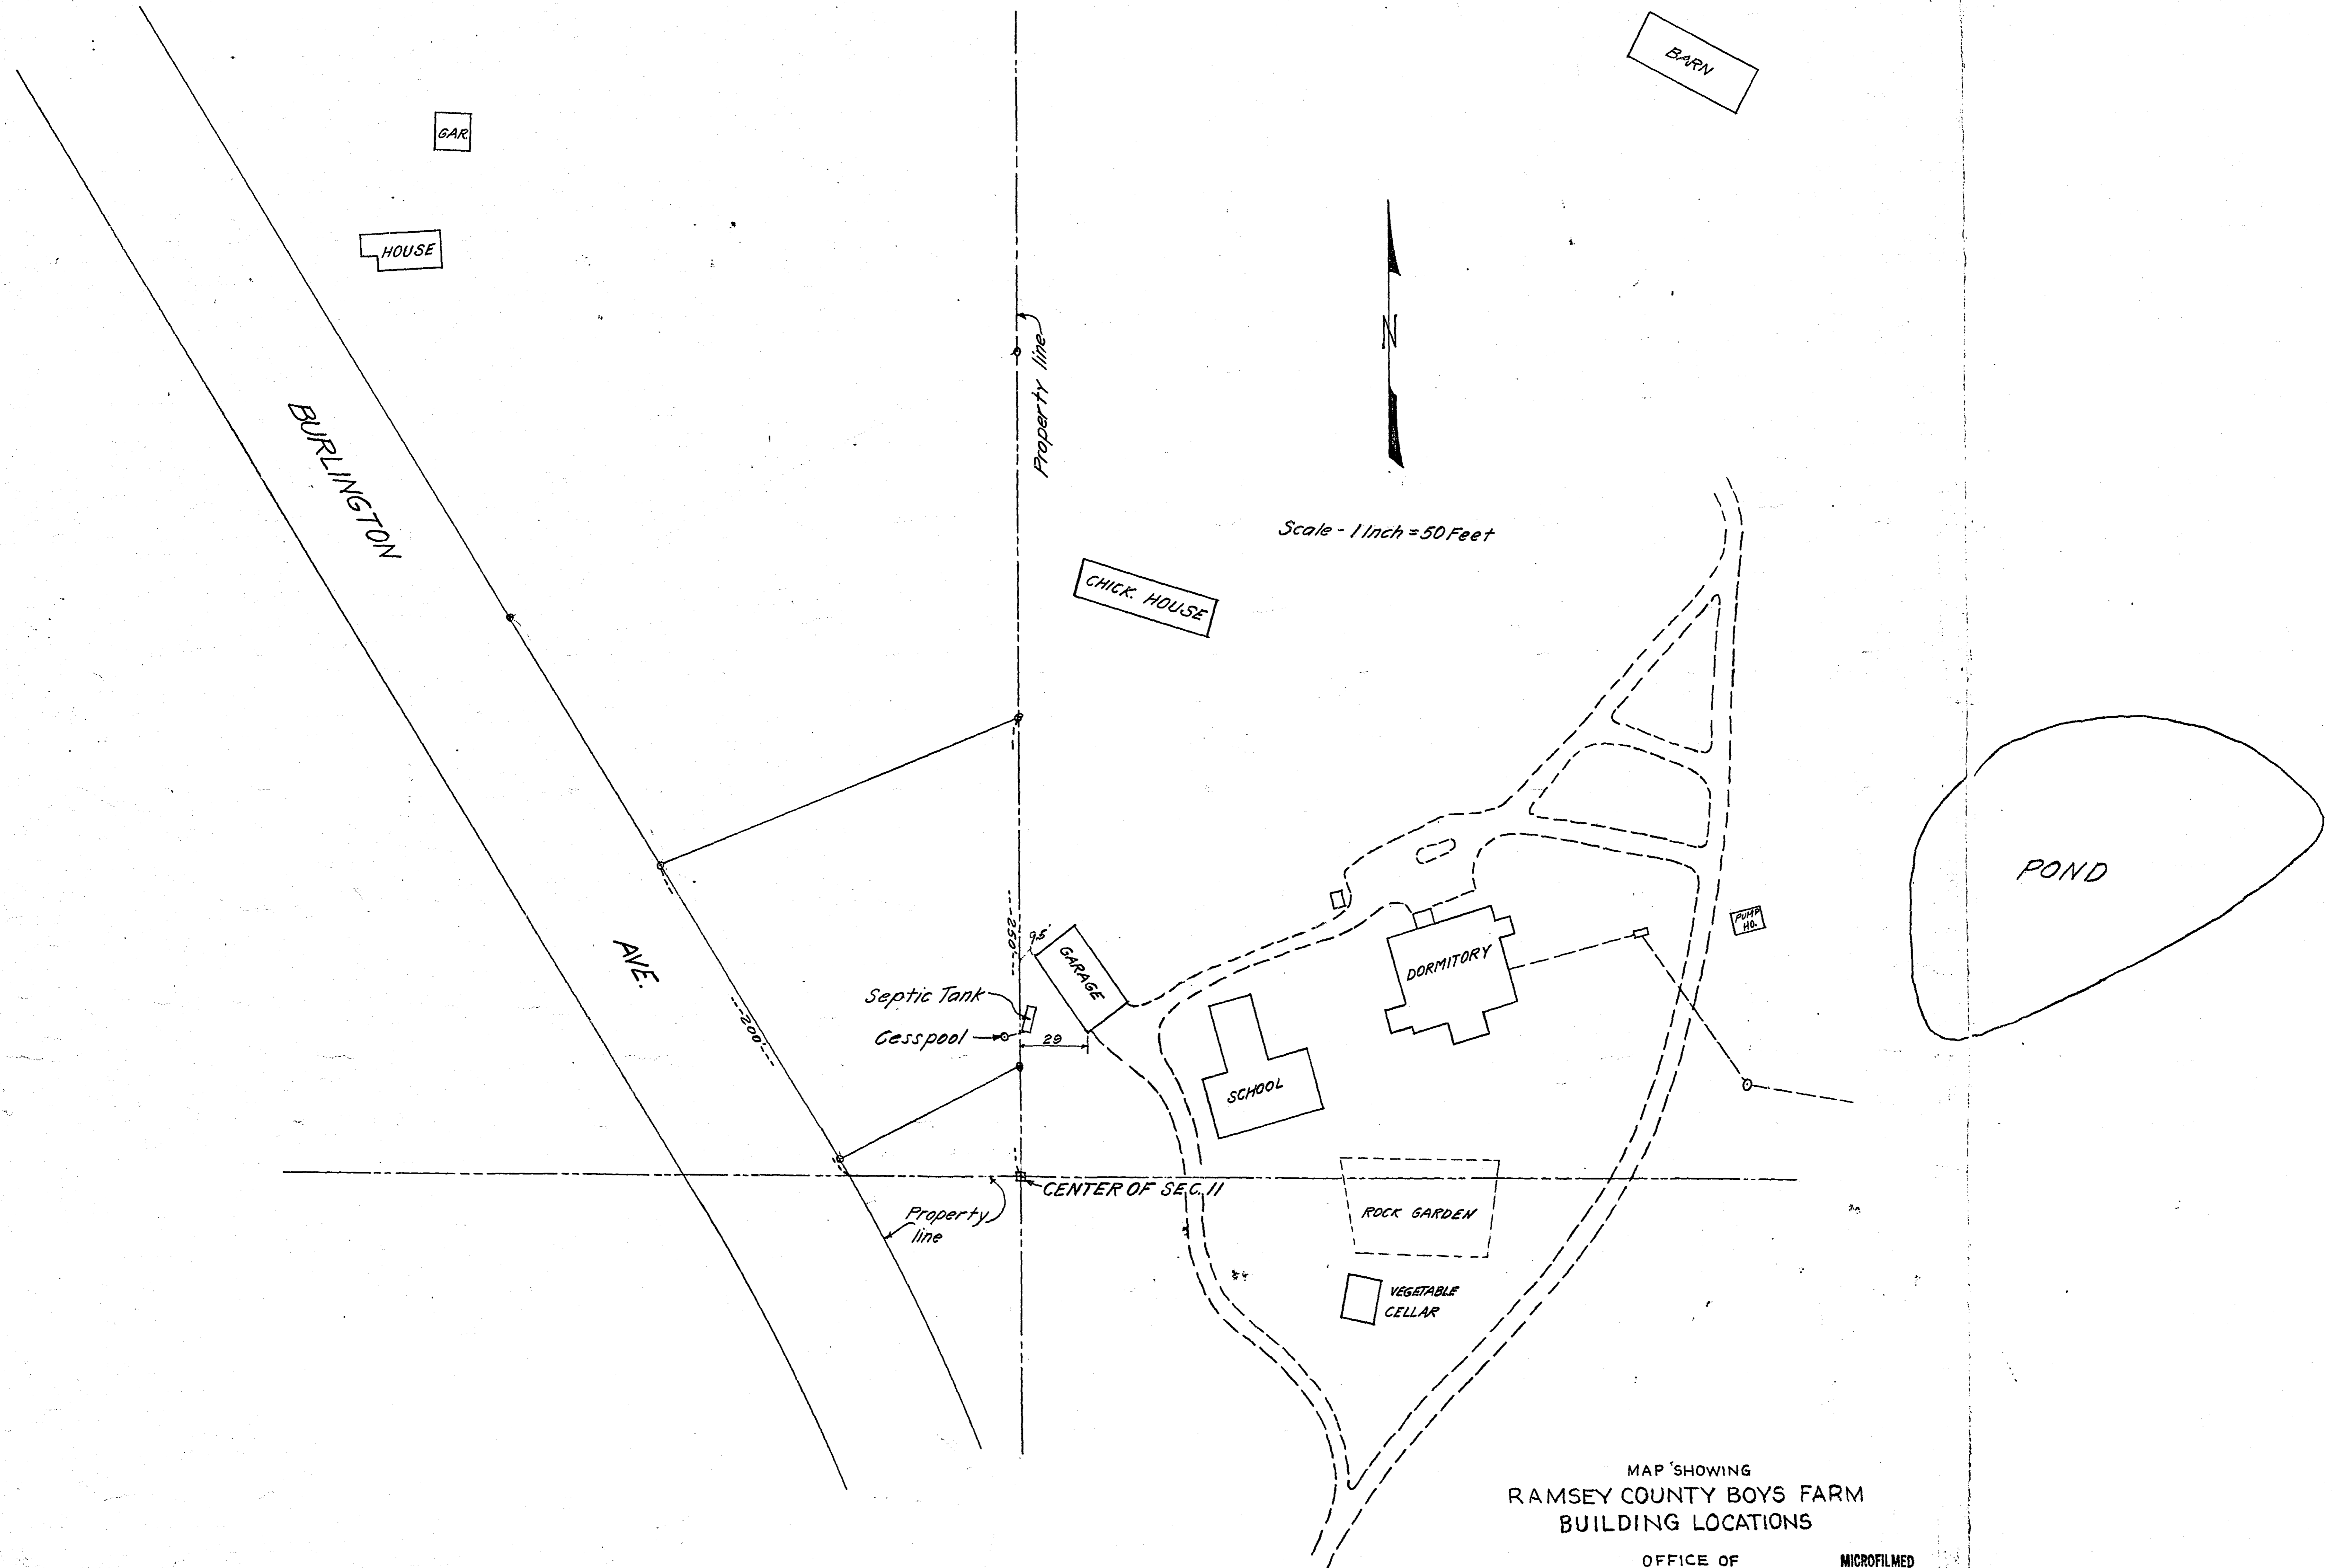

MAP SHOWING
 RAMSEY COUNTY BOYS FARM
 BUILDING LOCATIONS

OFFICE OF
 RAMSEY COUNTY SURVEYOR HARRY S. BRONSON
 MICROFILMED RAMSEY CO. ENGR.


2.

100
 408

BOY'S FARM PROPERTY

SCALE 1" = 300'

P-694

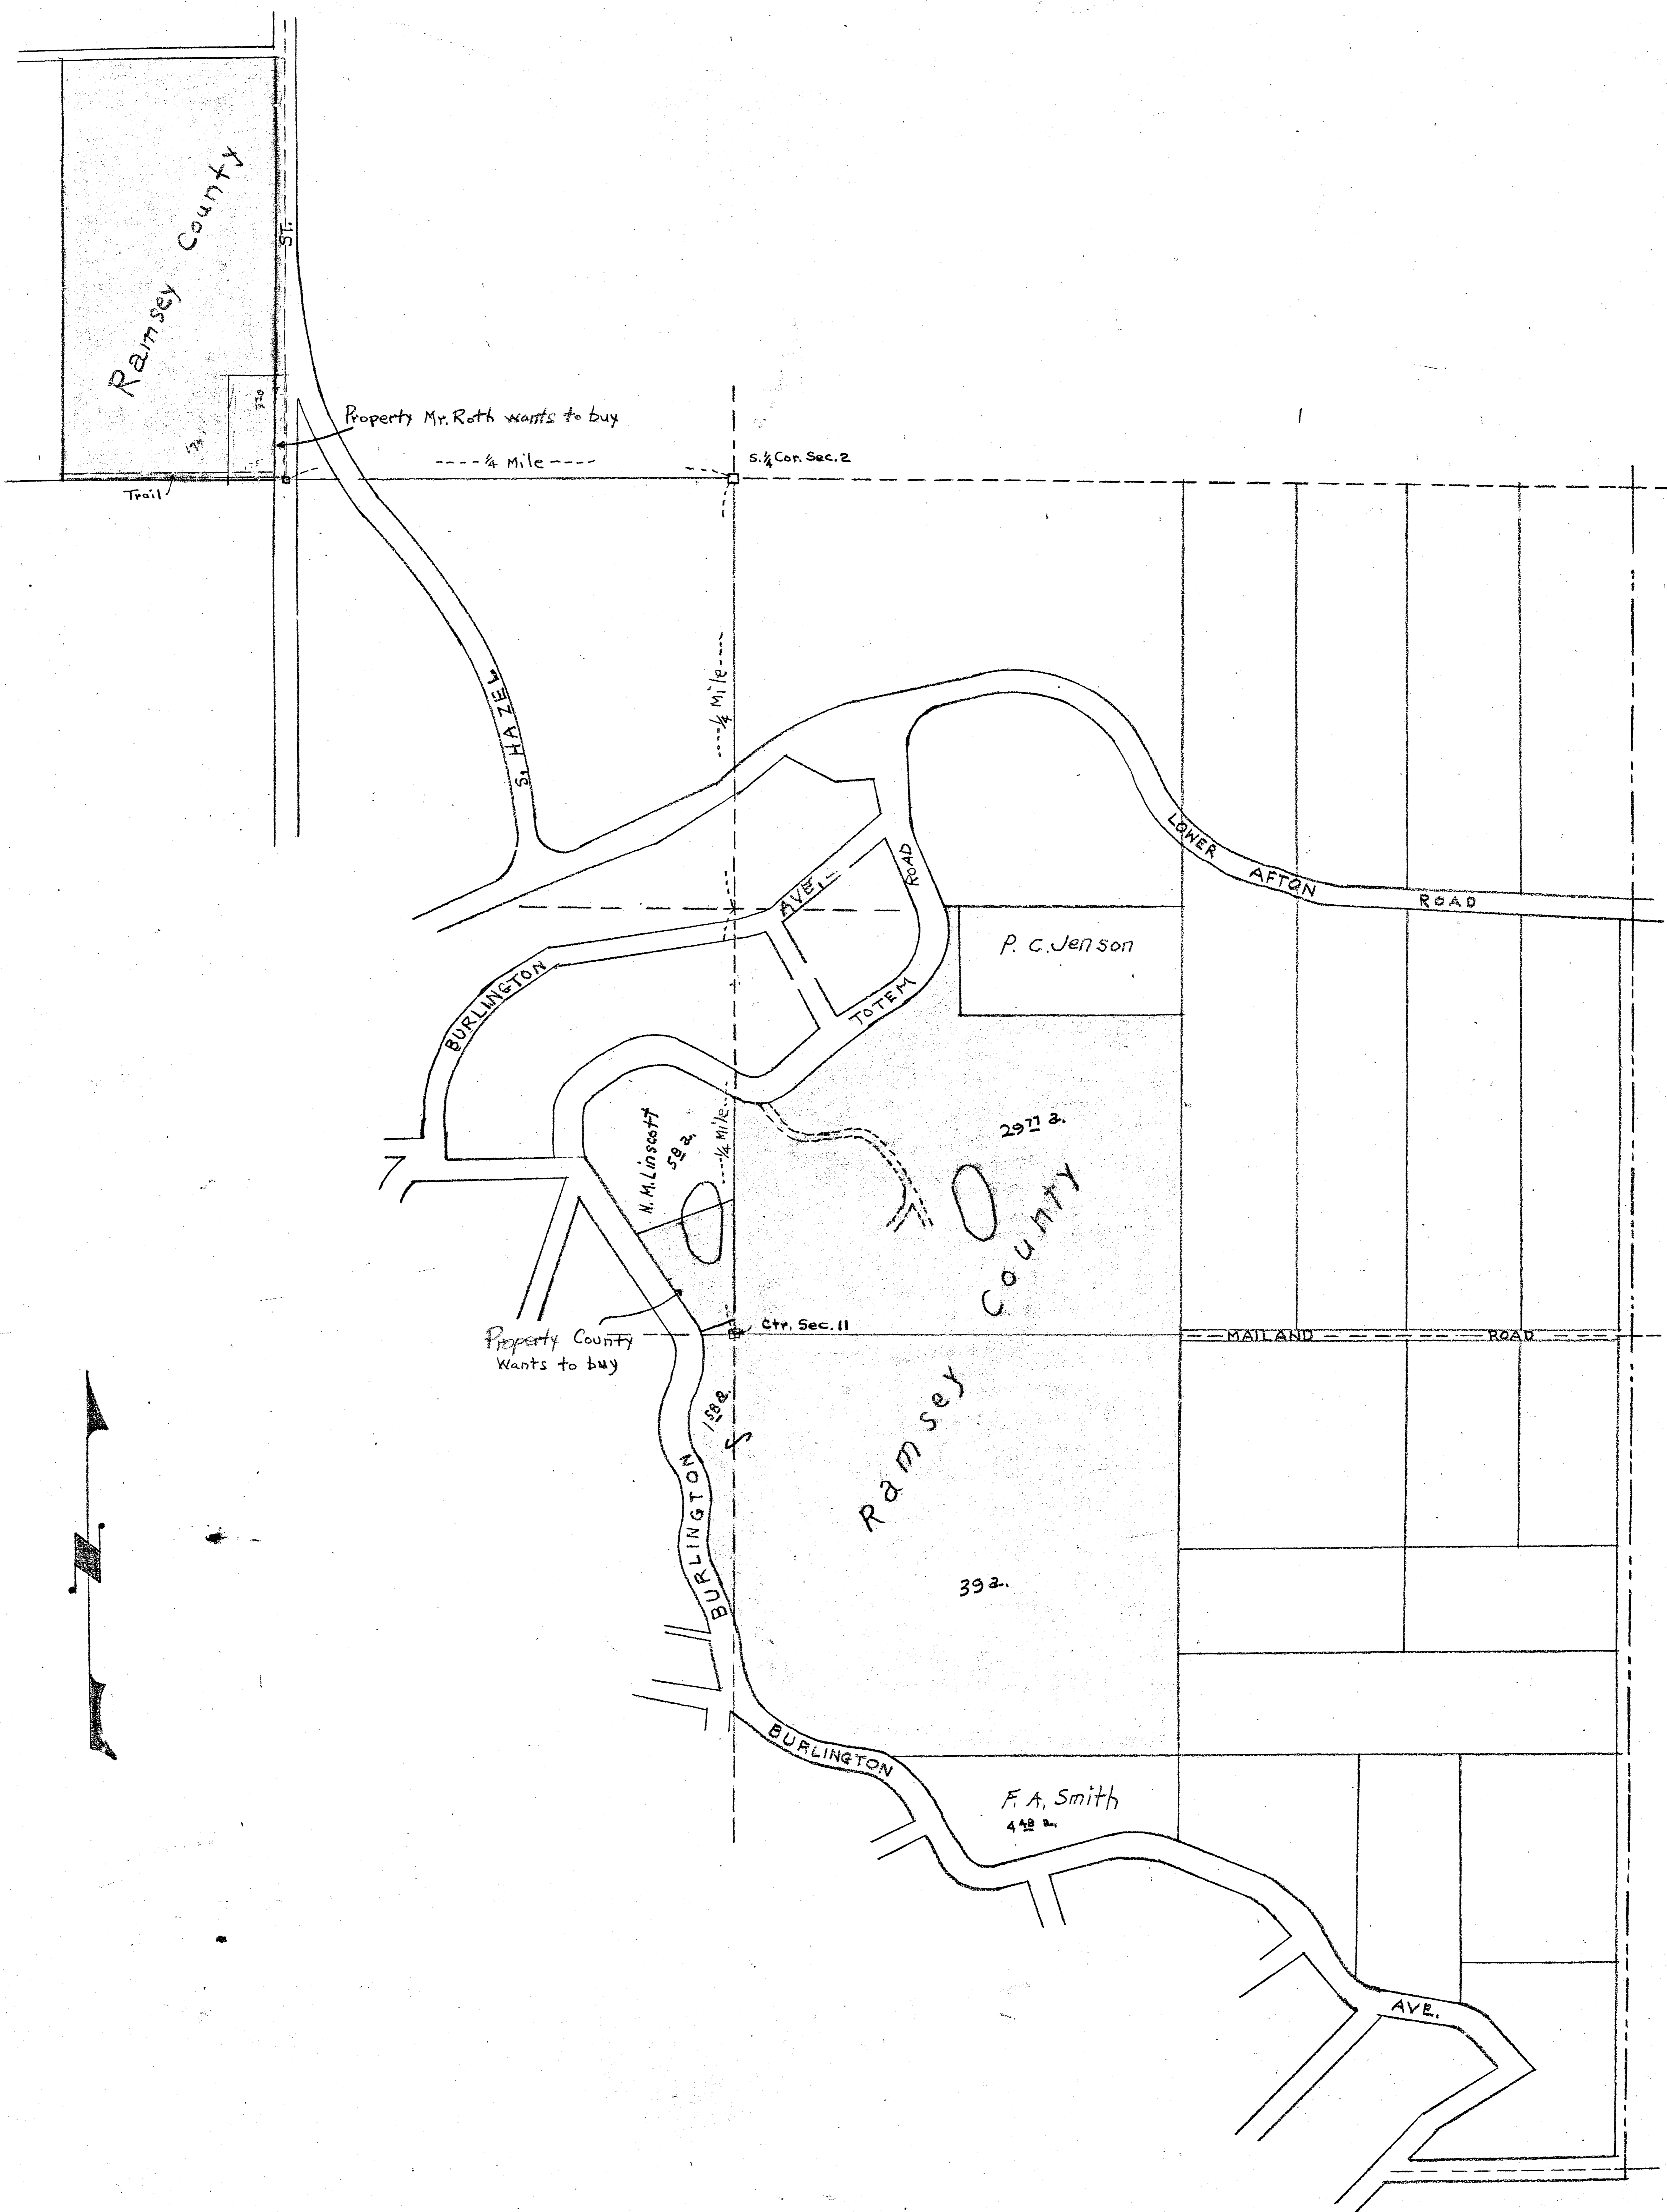


R-P-694

R-P-694

BOY'S FARM PROPERTY


SCALE 1" = 300'

P-694

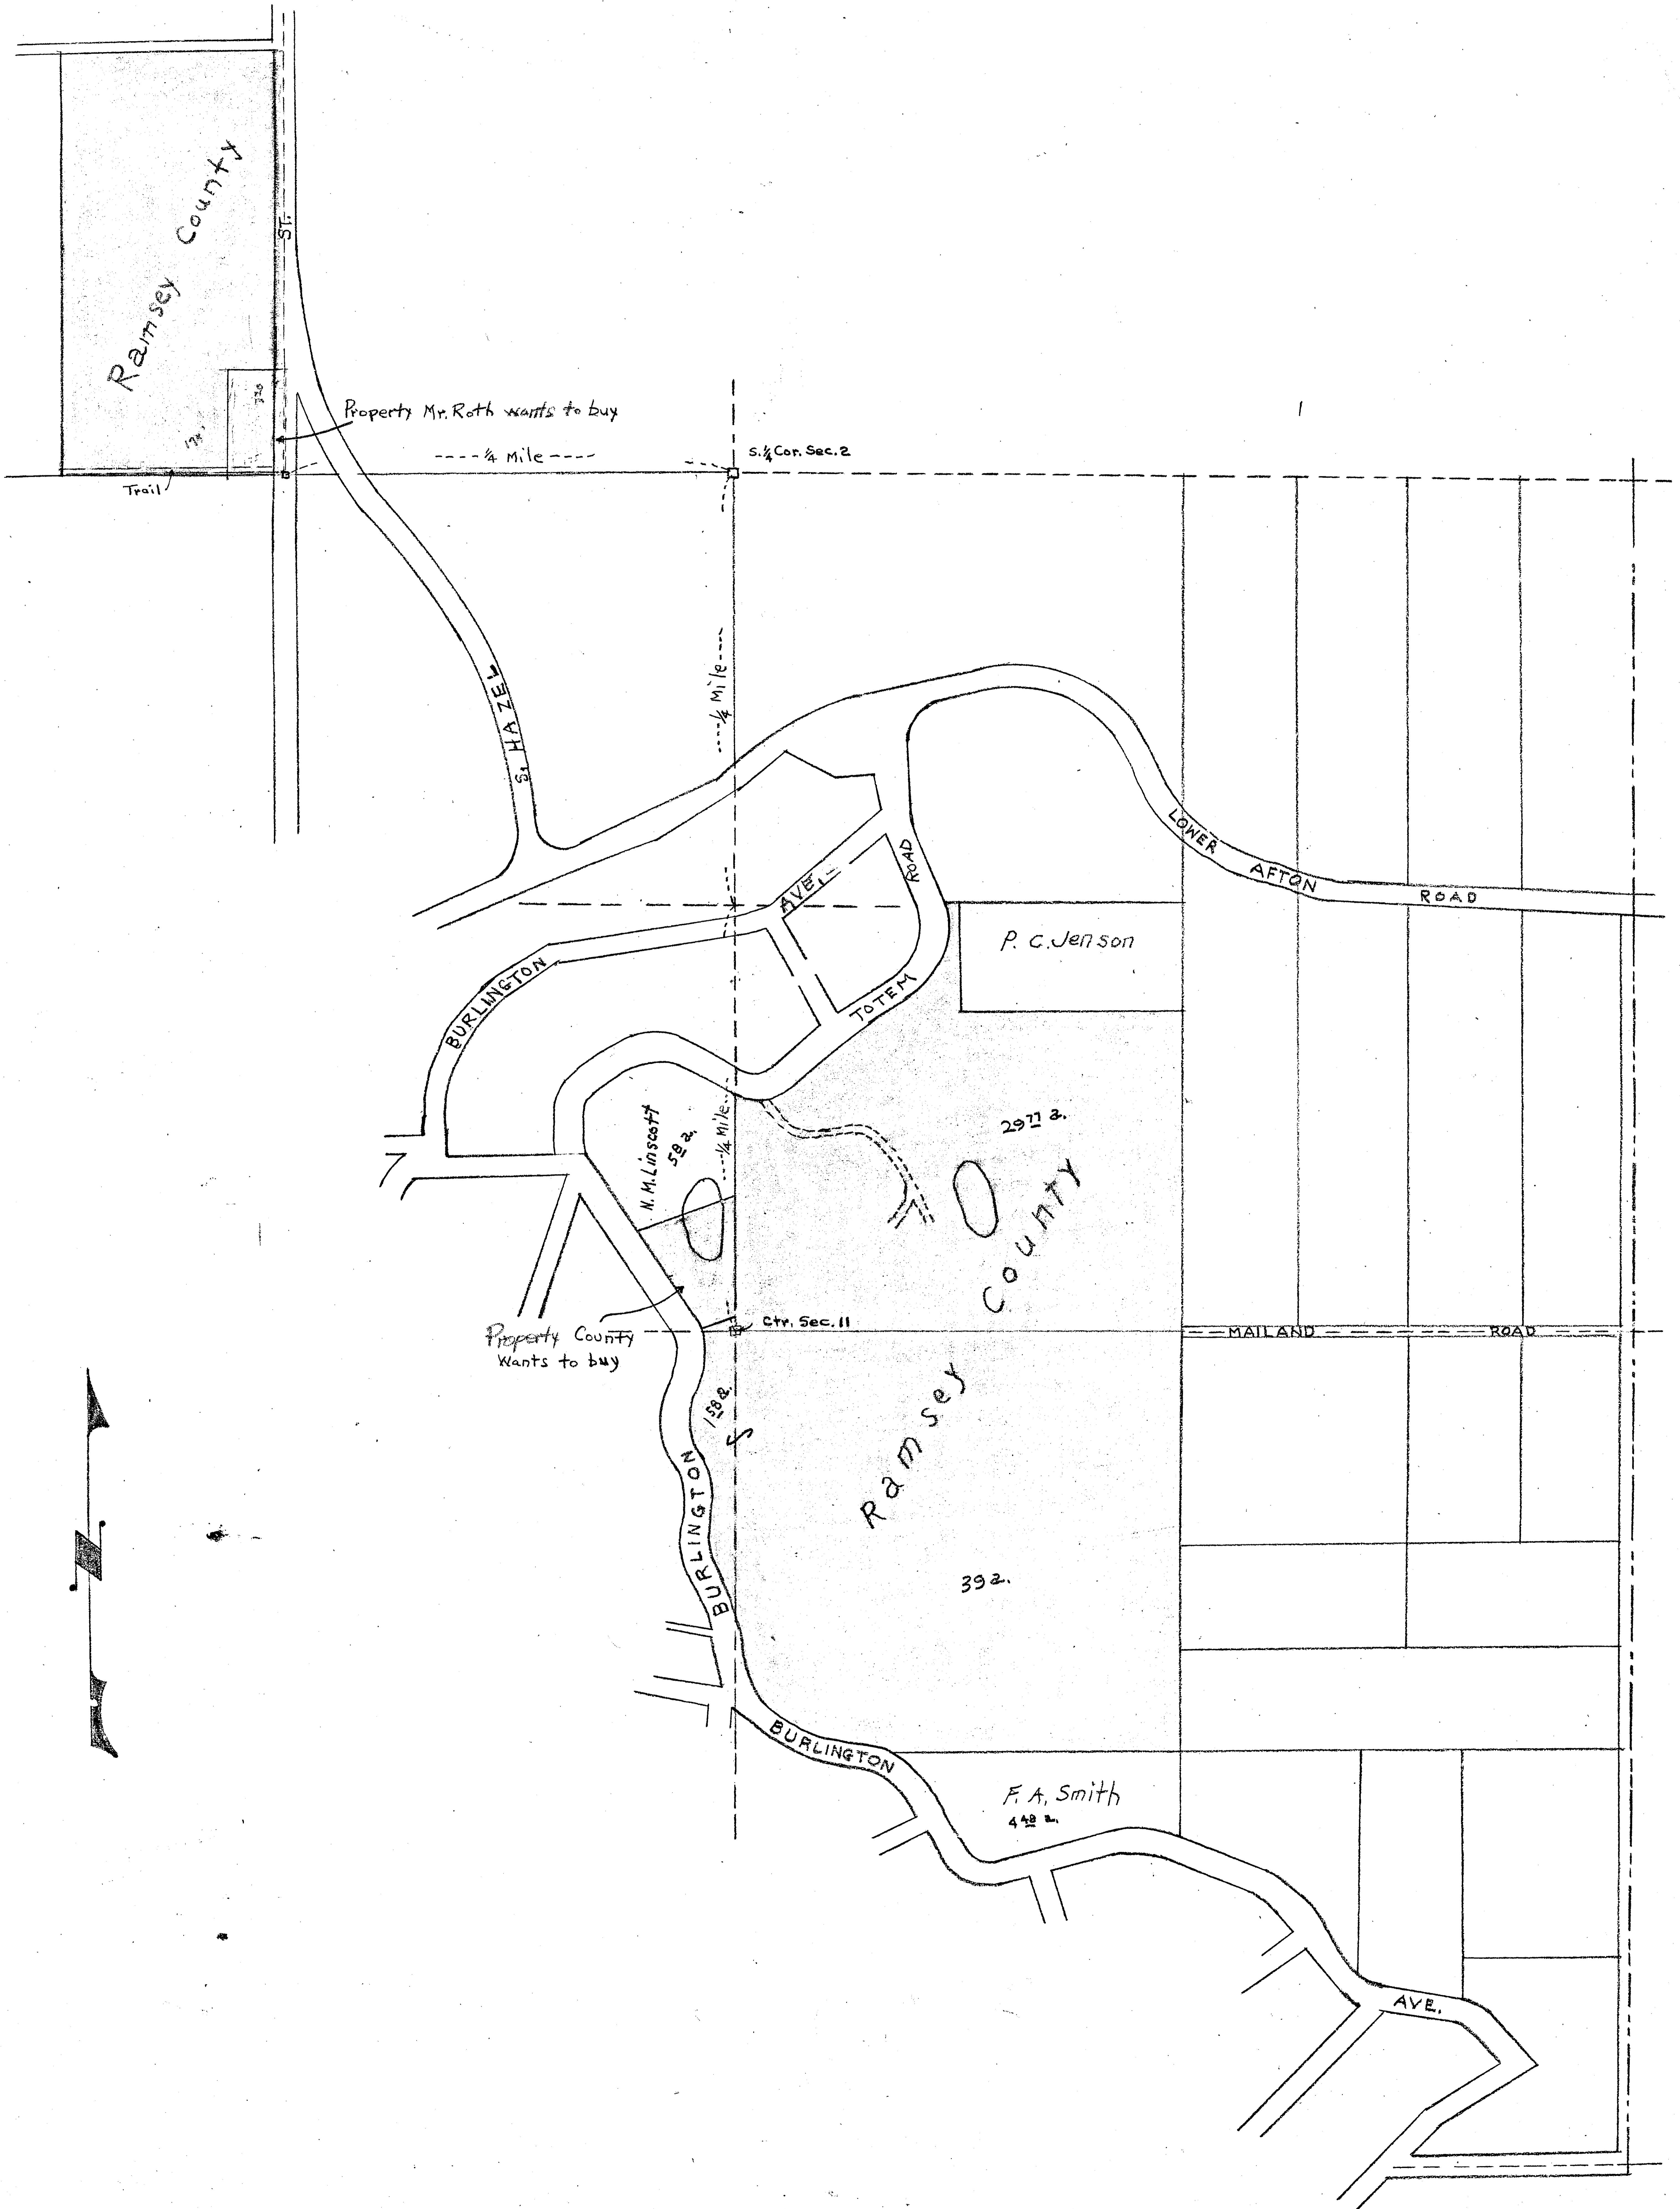

R-694

R-694

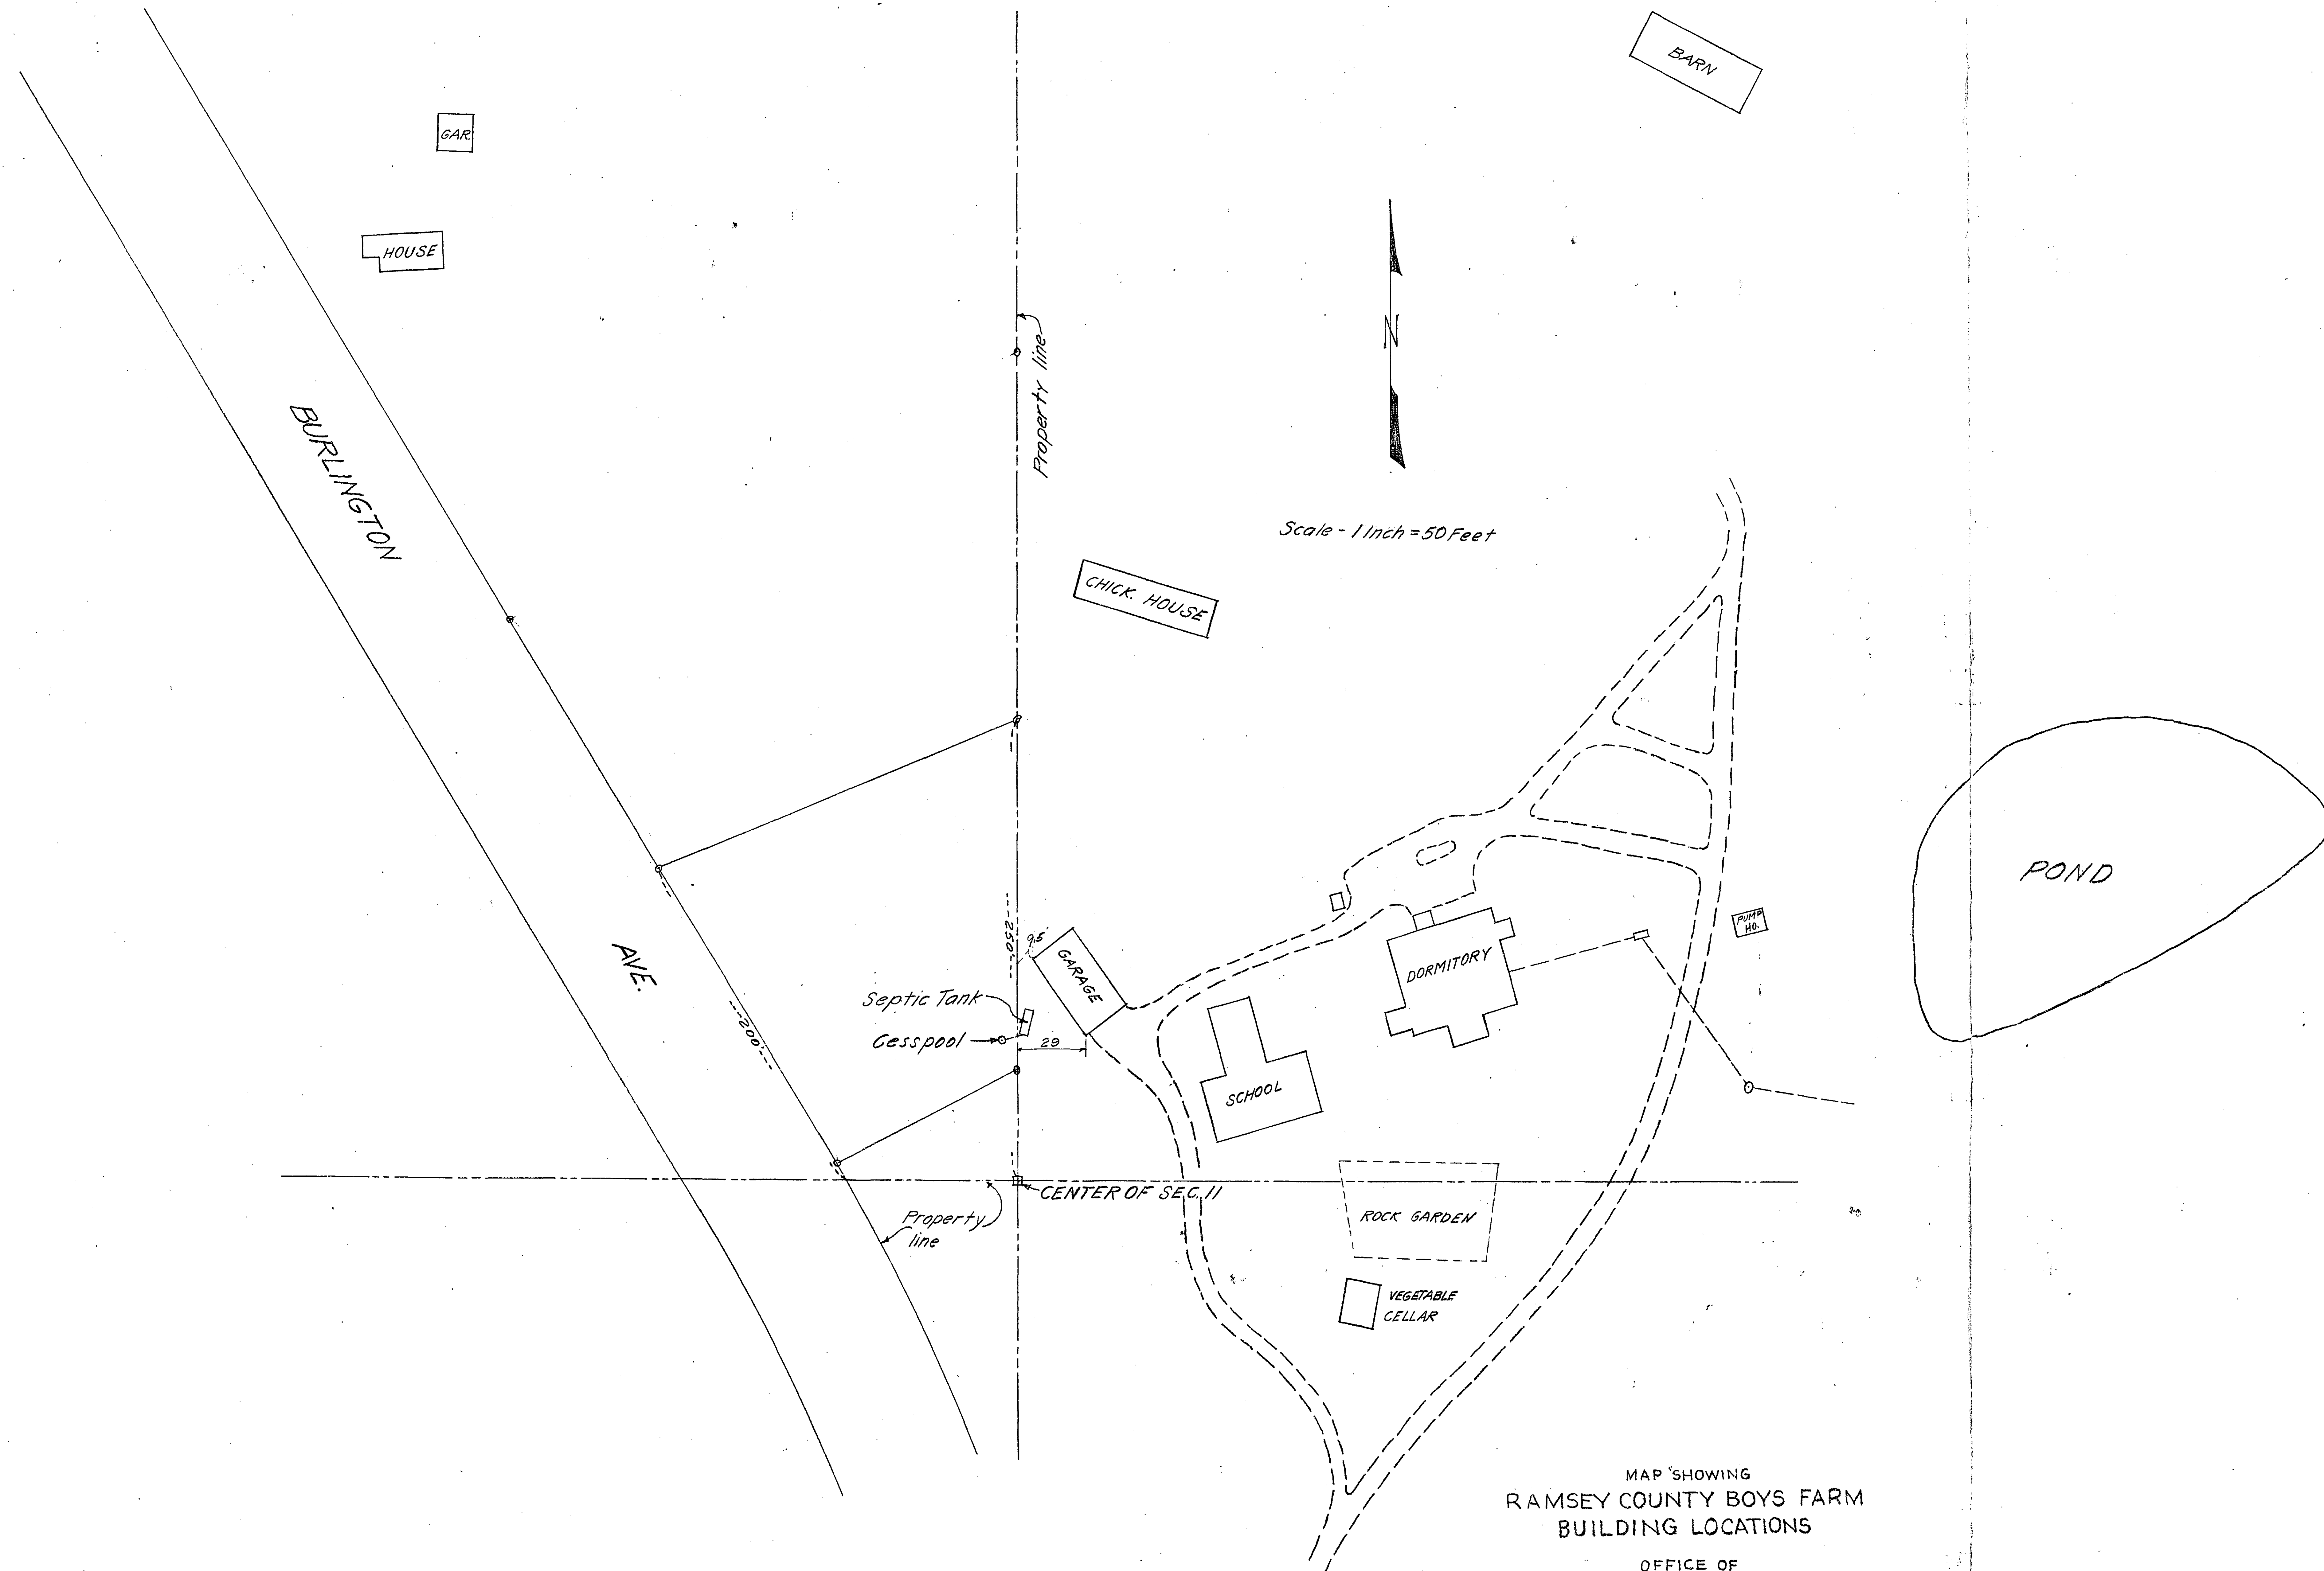

MAP SHOWING
 RAMSEY COUNTY BOYS FARM
 BUILDING LOCATIONS
 OFFICE OF
 RAMSEY COUNTY SURVEYOR
 HARRY S. BRONSON