LIST OF ACCOMPANYING DRAWINGS
TITLE
NO.
DATE APPROVED
APPROVED BY
E.W. BY
CHECKED BY
TRACED BY
DRAWN BY
ISSUE NO.
DATE APPROVED
APPROVED BY
E.W. BY

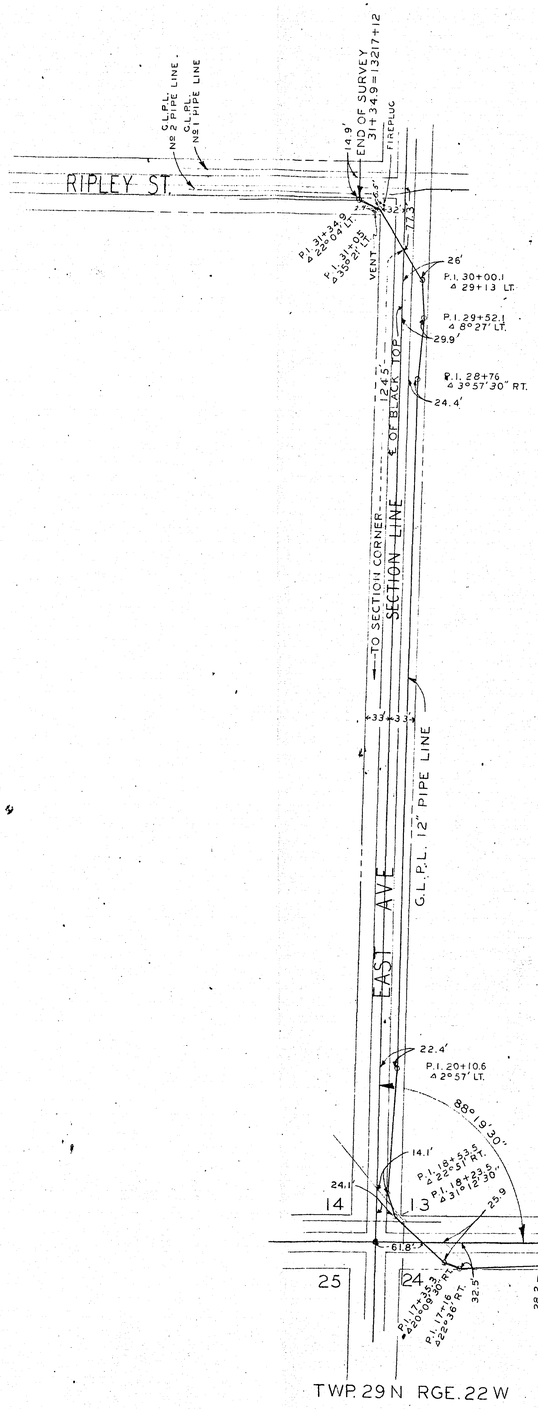

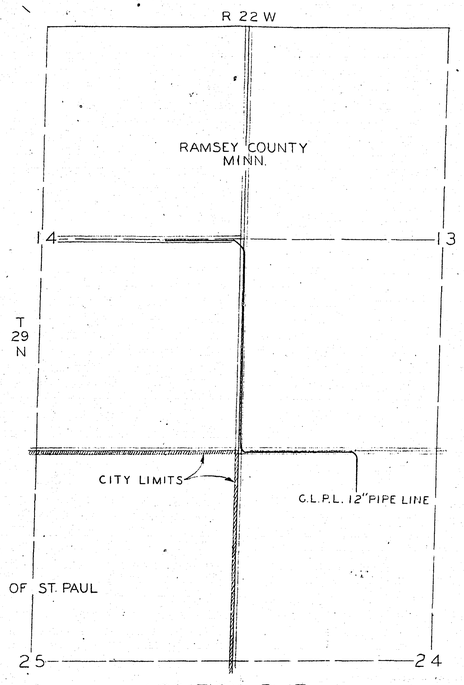

LOCATION PLAT

TRACT 3295-X-2

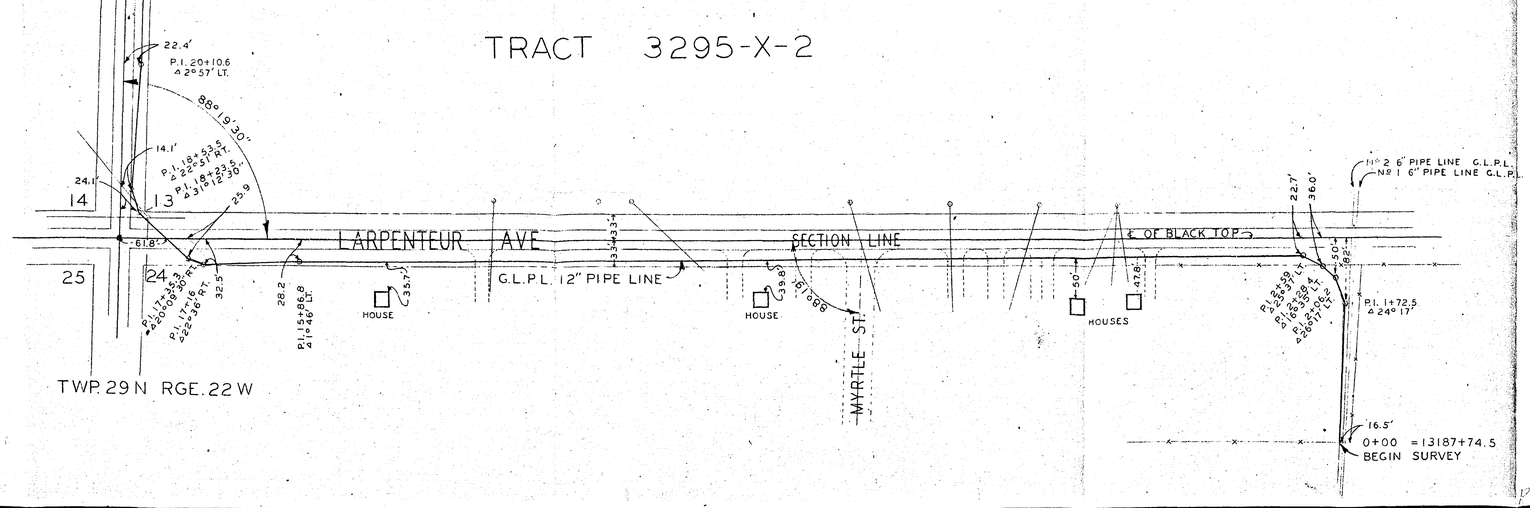

TWP. 29 N RGE. 22 W

GREAT LAKES PIPE LINE COMPANY
KANSAS CITY, MISSOURI

LOCATION OF 12" PIPE LINE IN
SECT. 24, 13 & 14 TWP 29 N RGE 22 W
RAMSEY CO. MINN. NEAR ST. PAUL

Approved

Scale 1" = 100'

V-708

S-5048-1