


SAVE

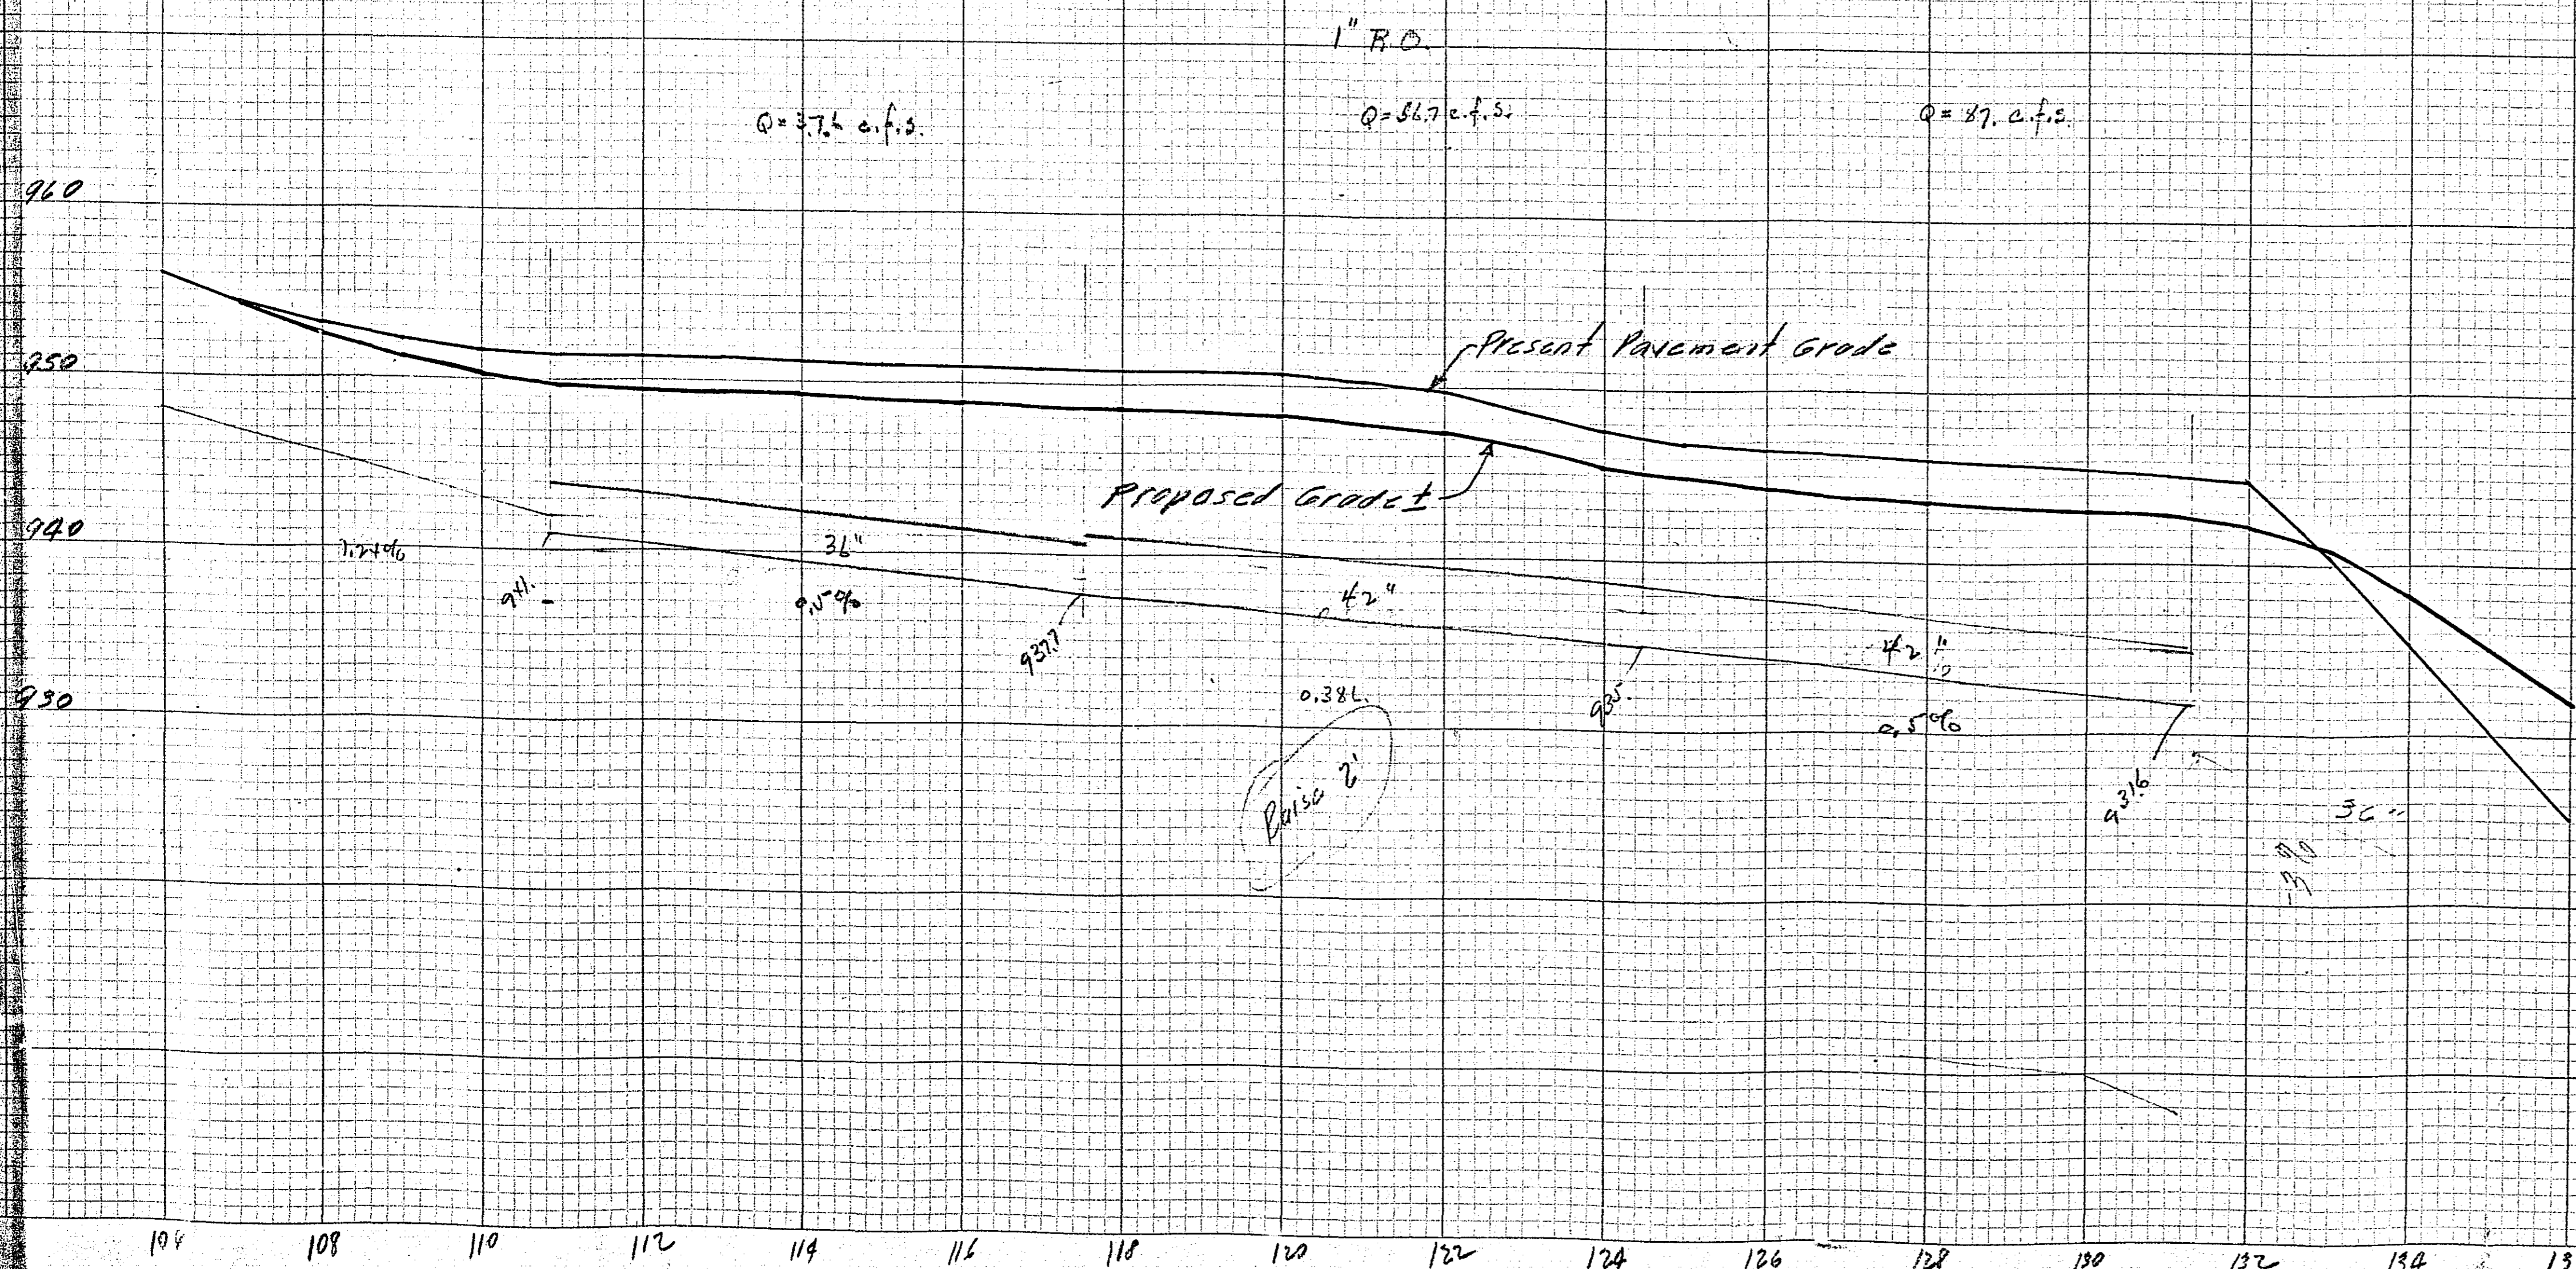

SAVE

LARPENTEUR AVE.
 Proposal Sewer to take from
 Harbison Ave.