



20X F3/3

PROFILE OF DITCH NO. 7
BRANCH "A"

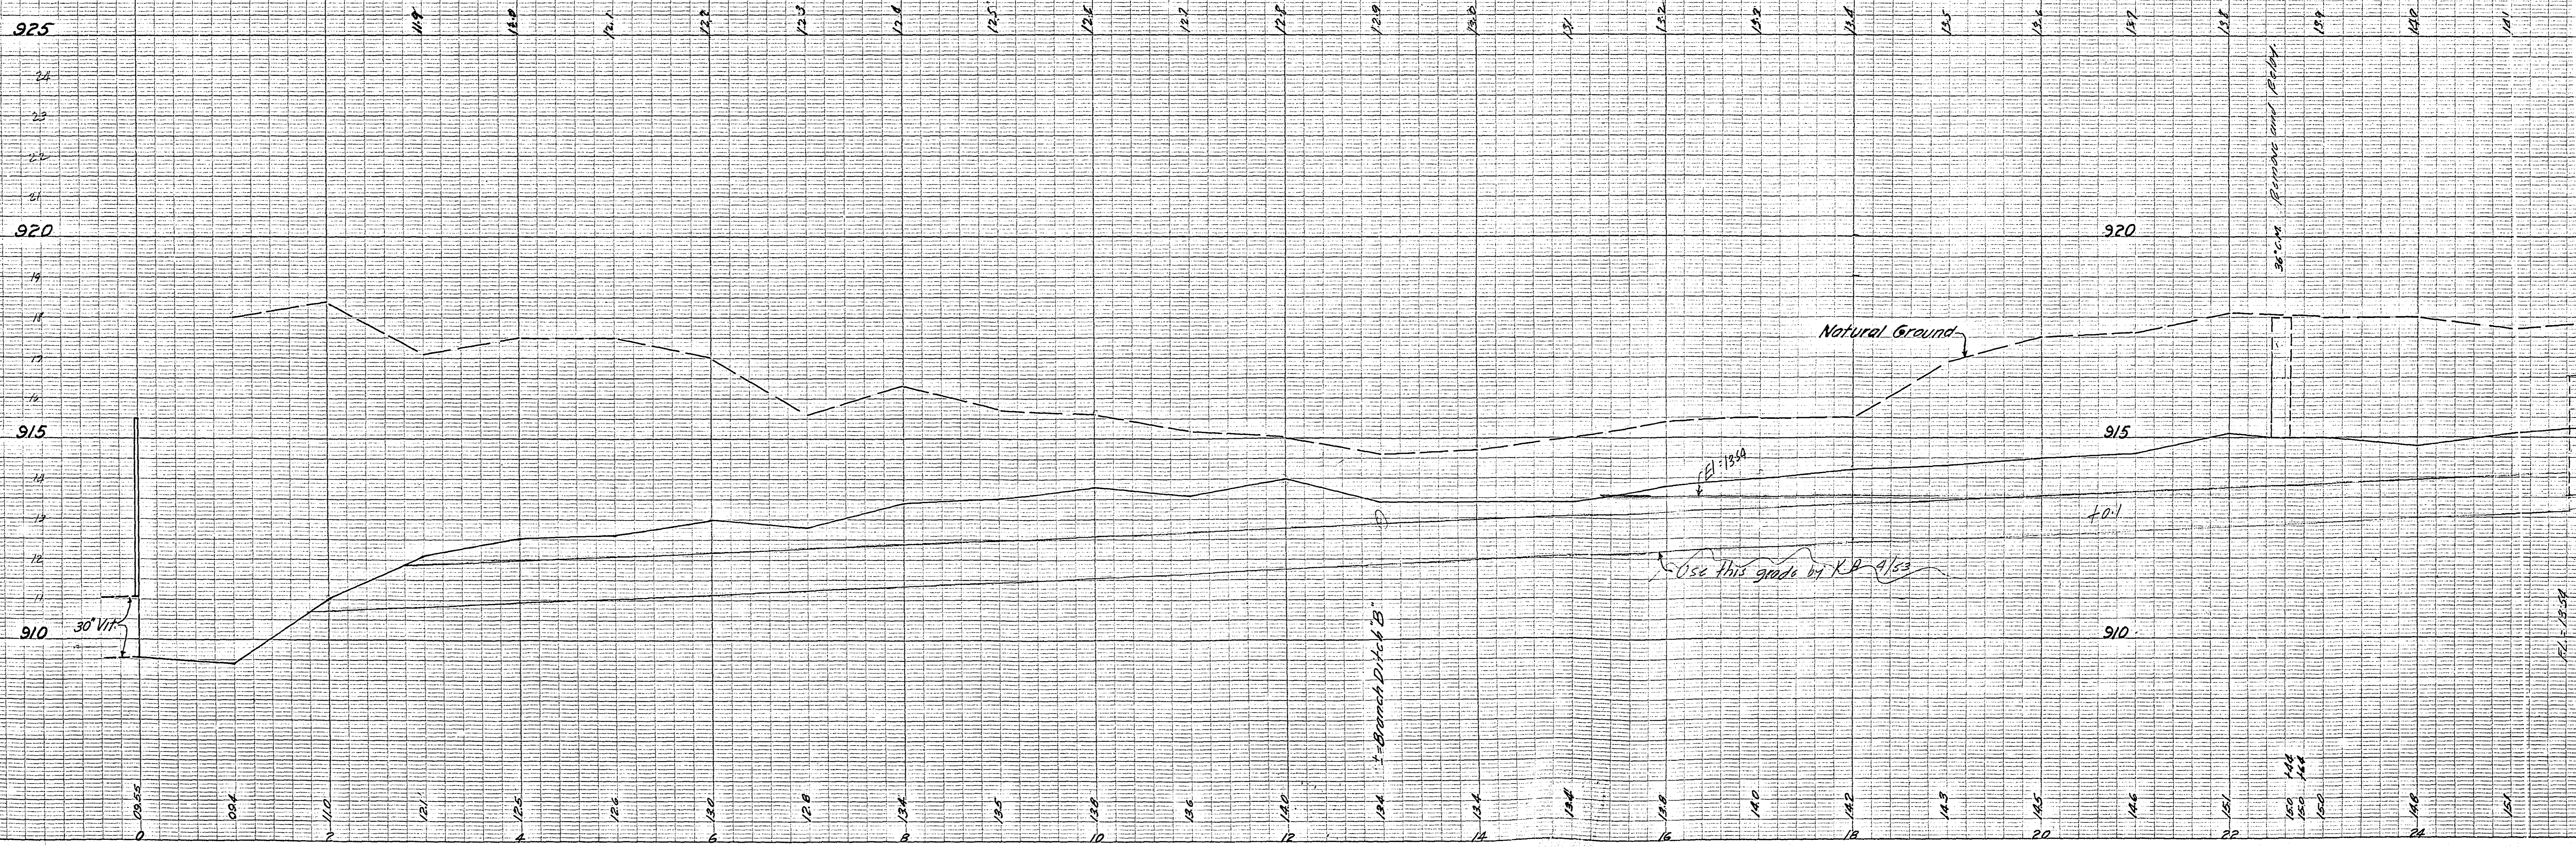

PROFILE OF DITCH NO 7
BRANCH 'A'

20X F2/3

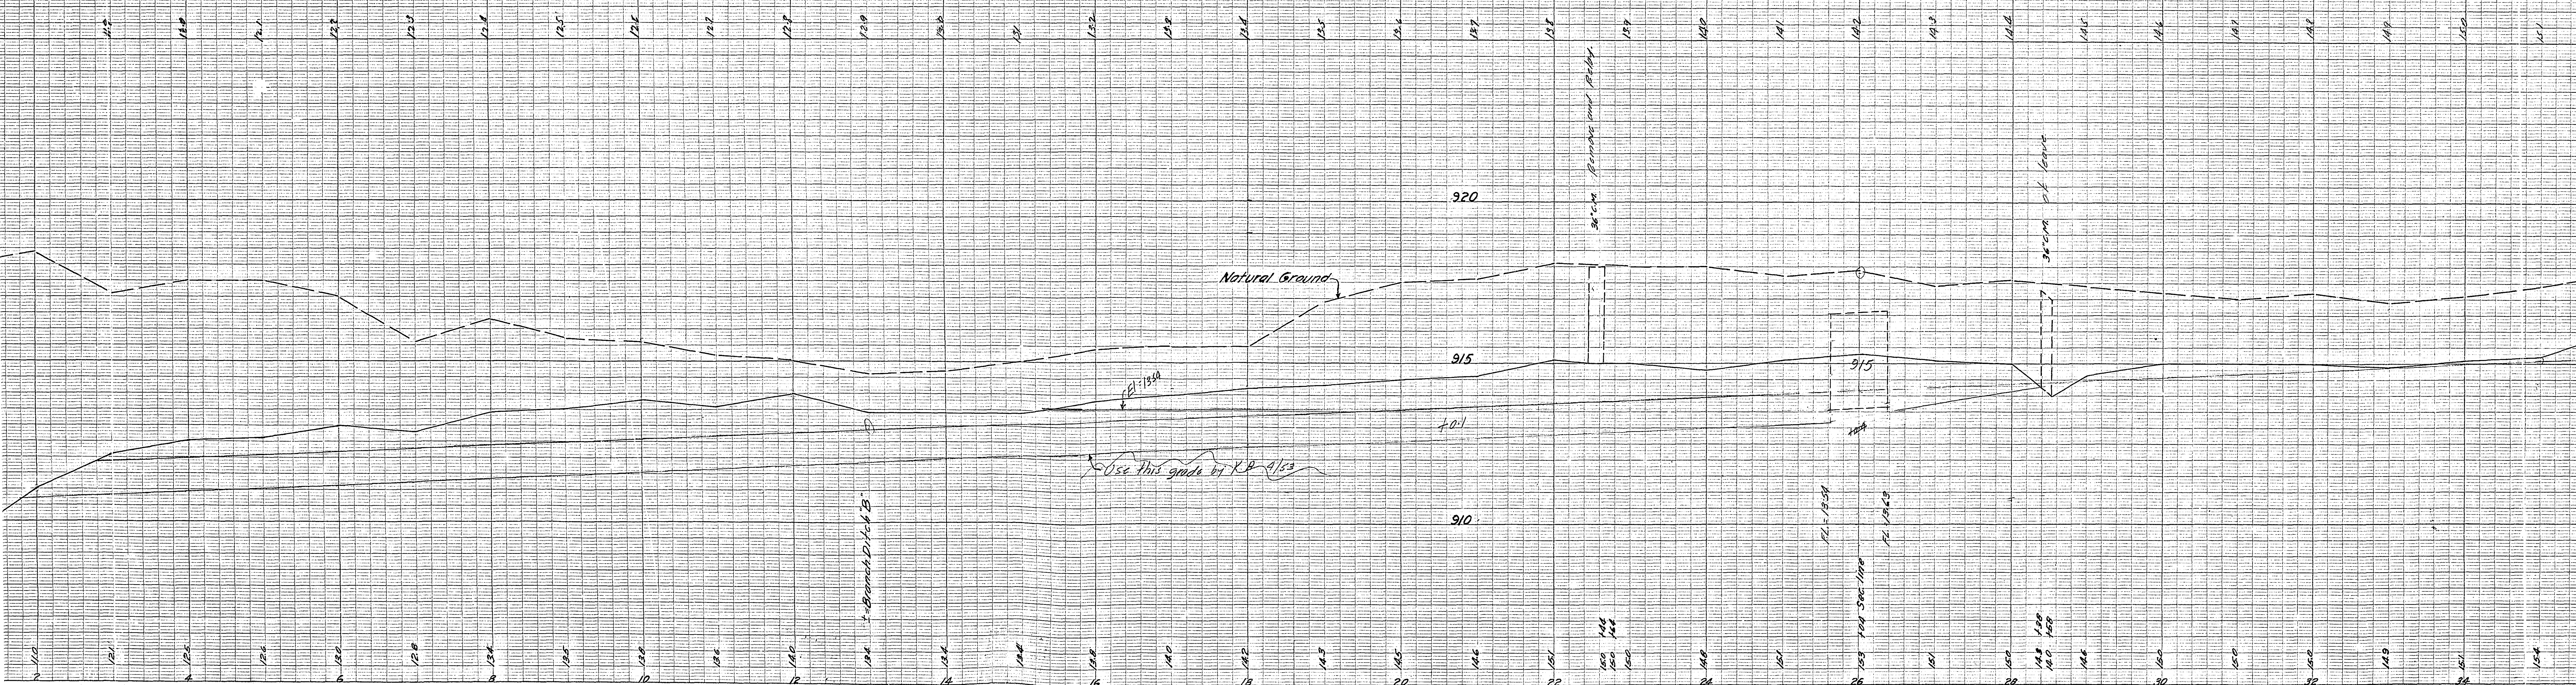

R-740

3 1/2" x 5" PROFILE
PLATE A
EUGENE DIETZGEN CO.

R-740

3 1/2" x 5" PROFILE
PLATE A
EUGENE DIETZGEN CO.

20X F-1/3

