

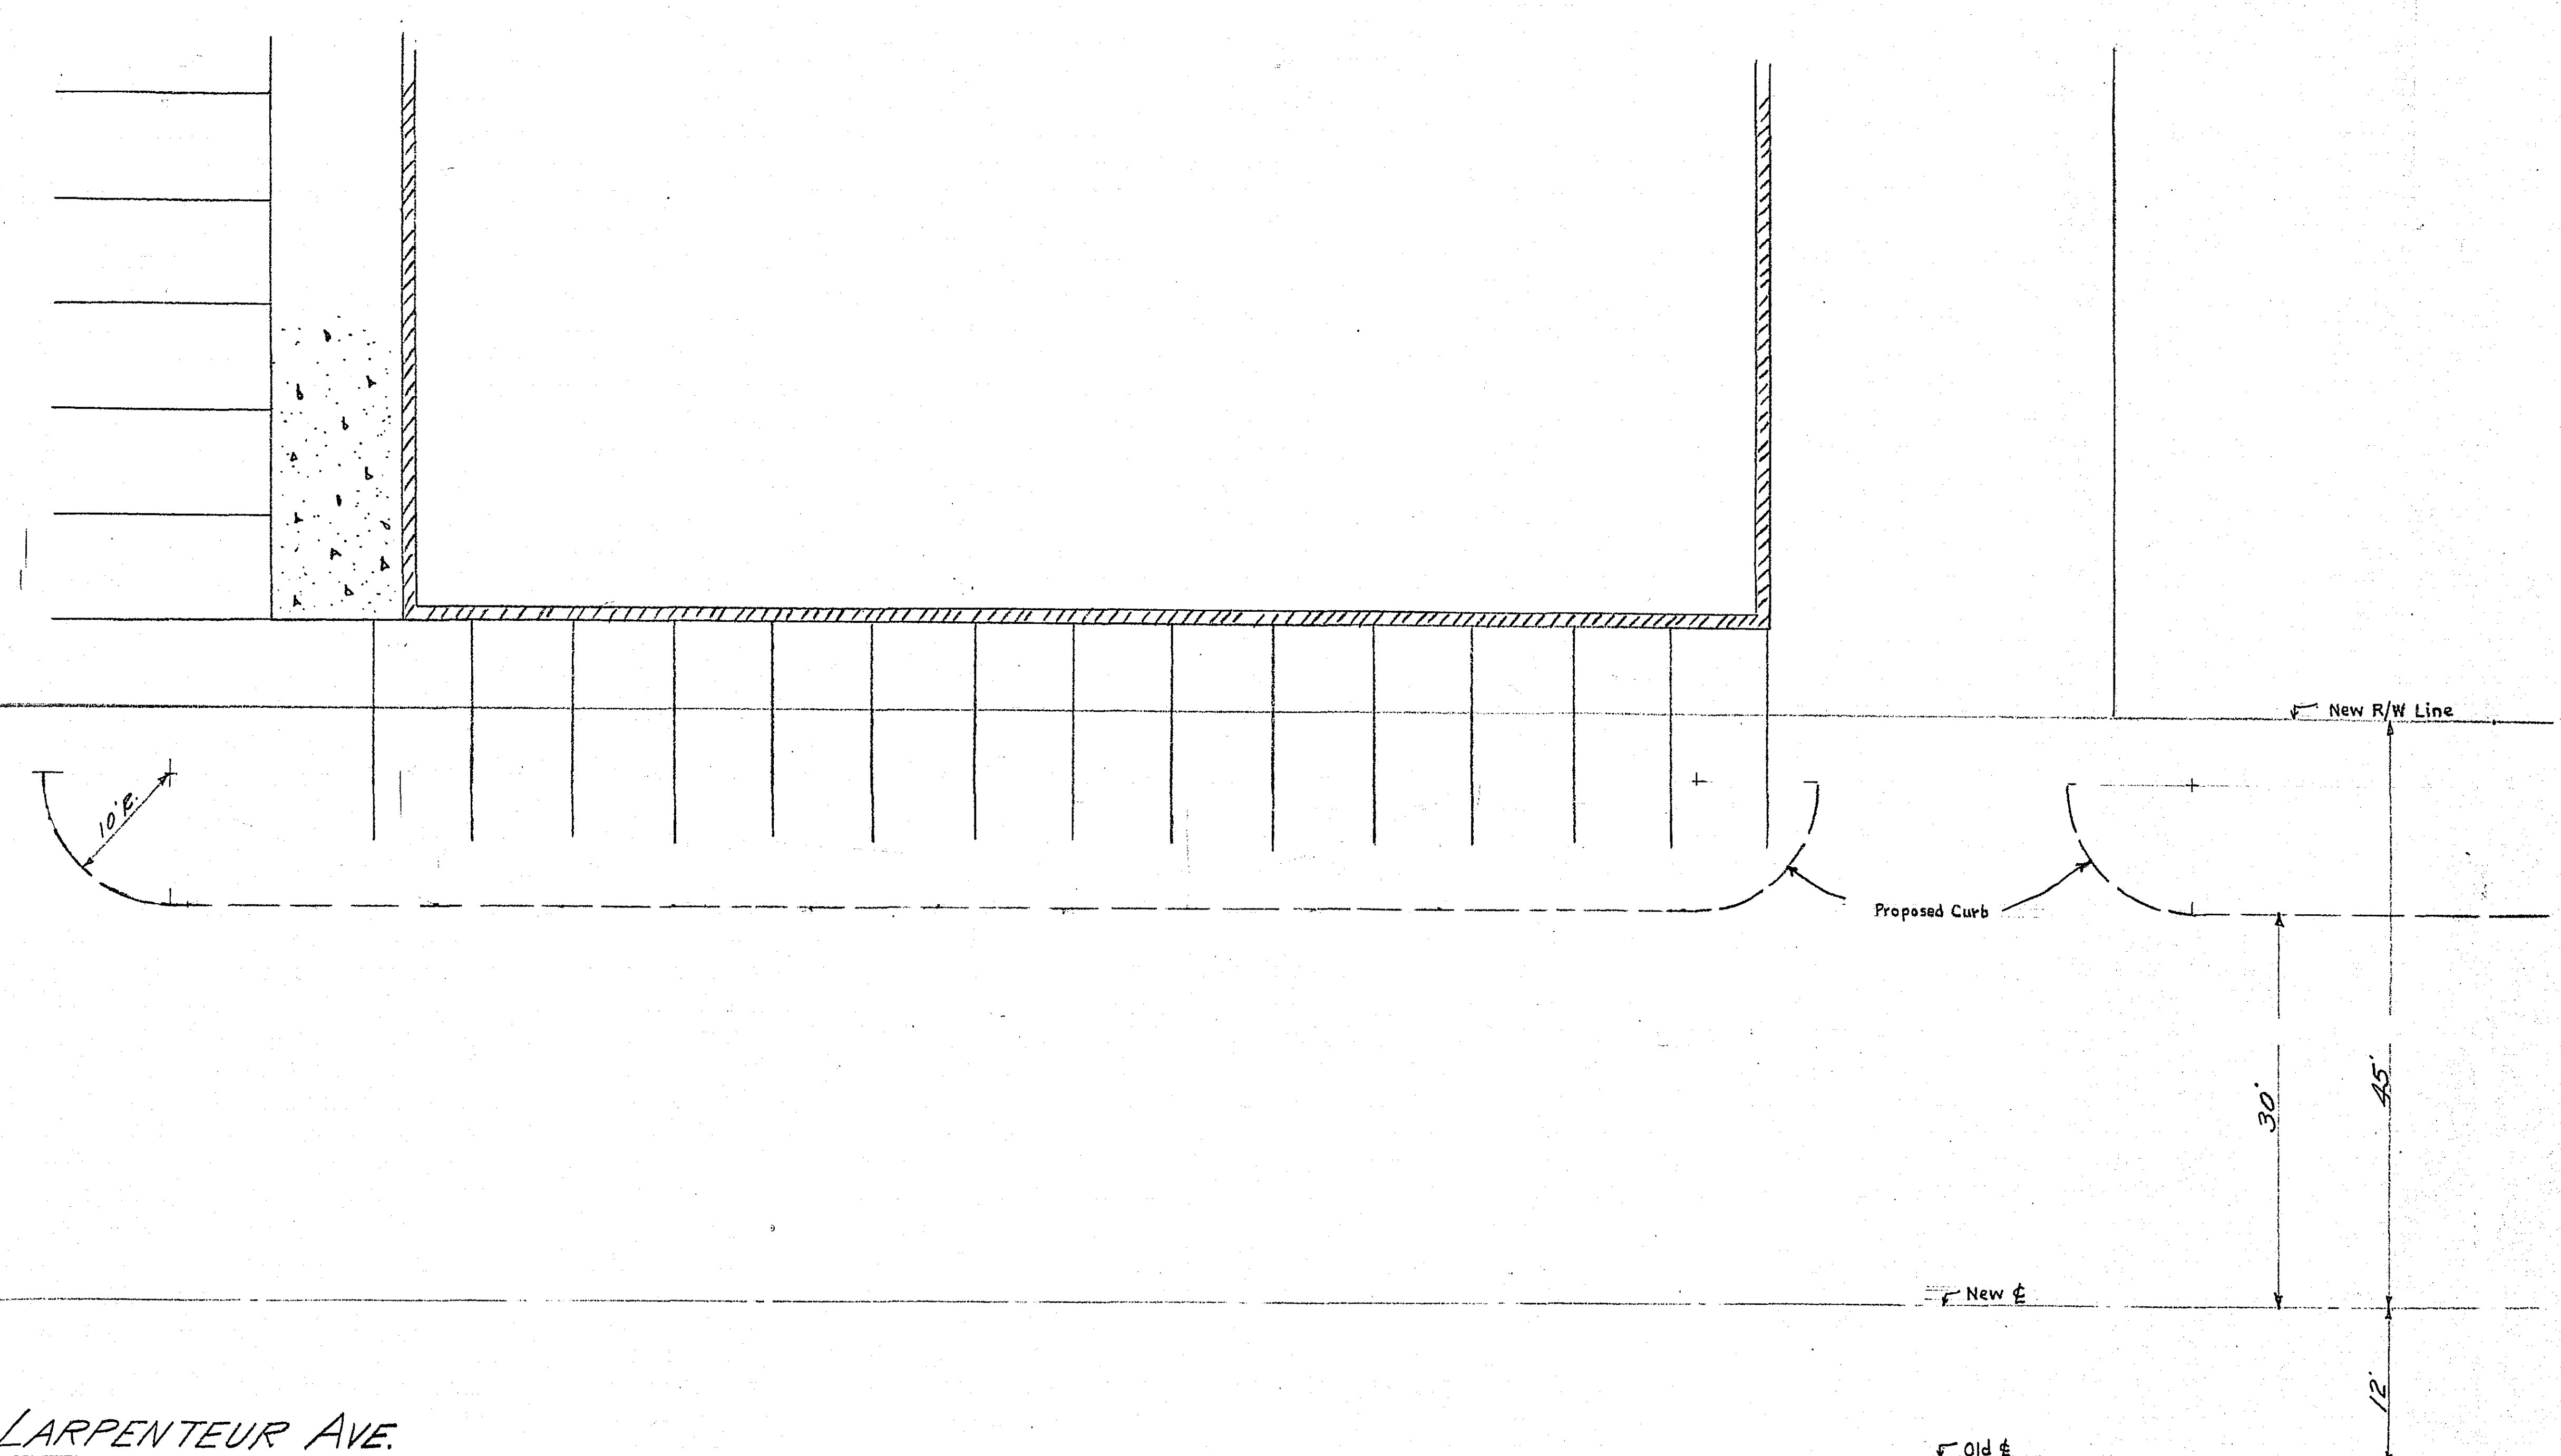


Section Line 2 LEXINGTON AVE.

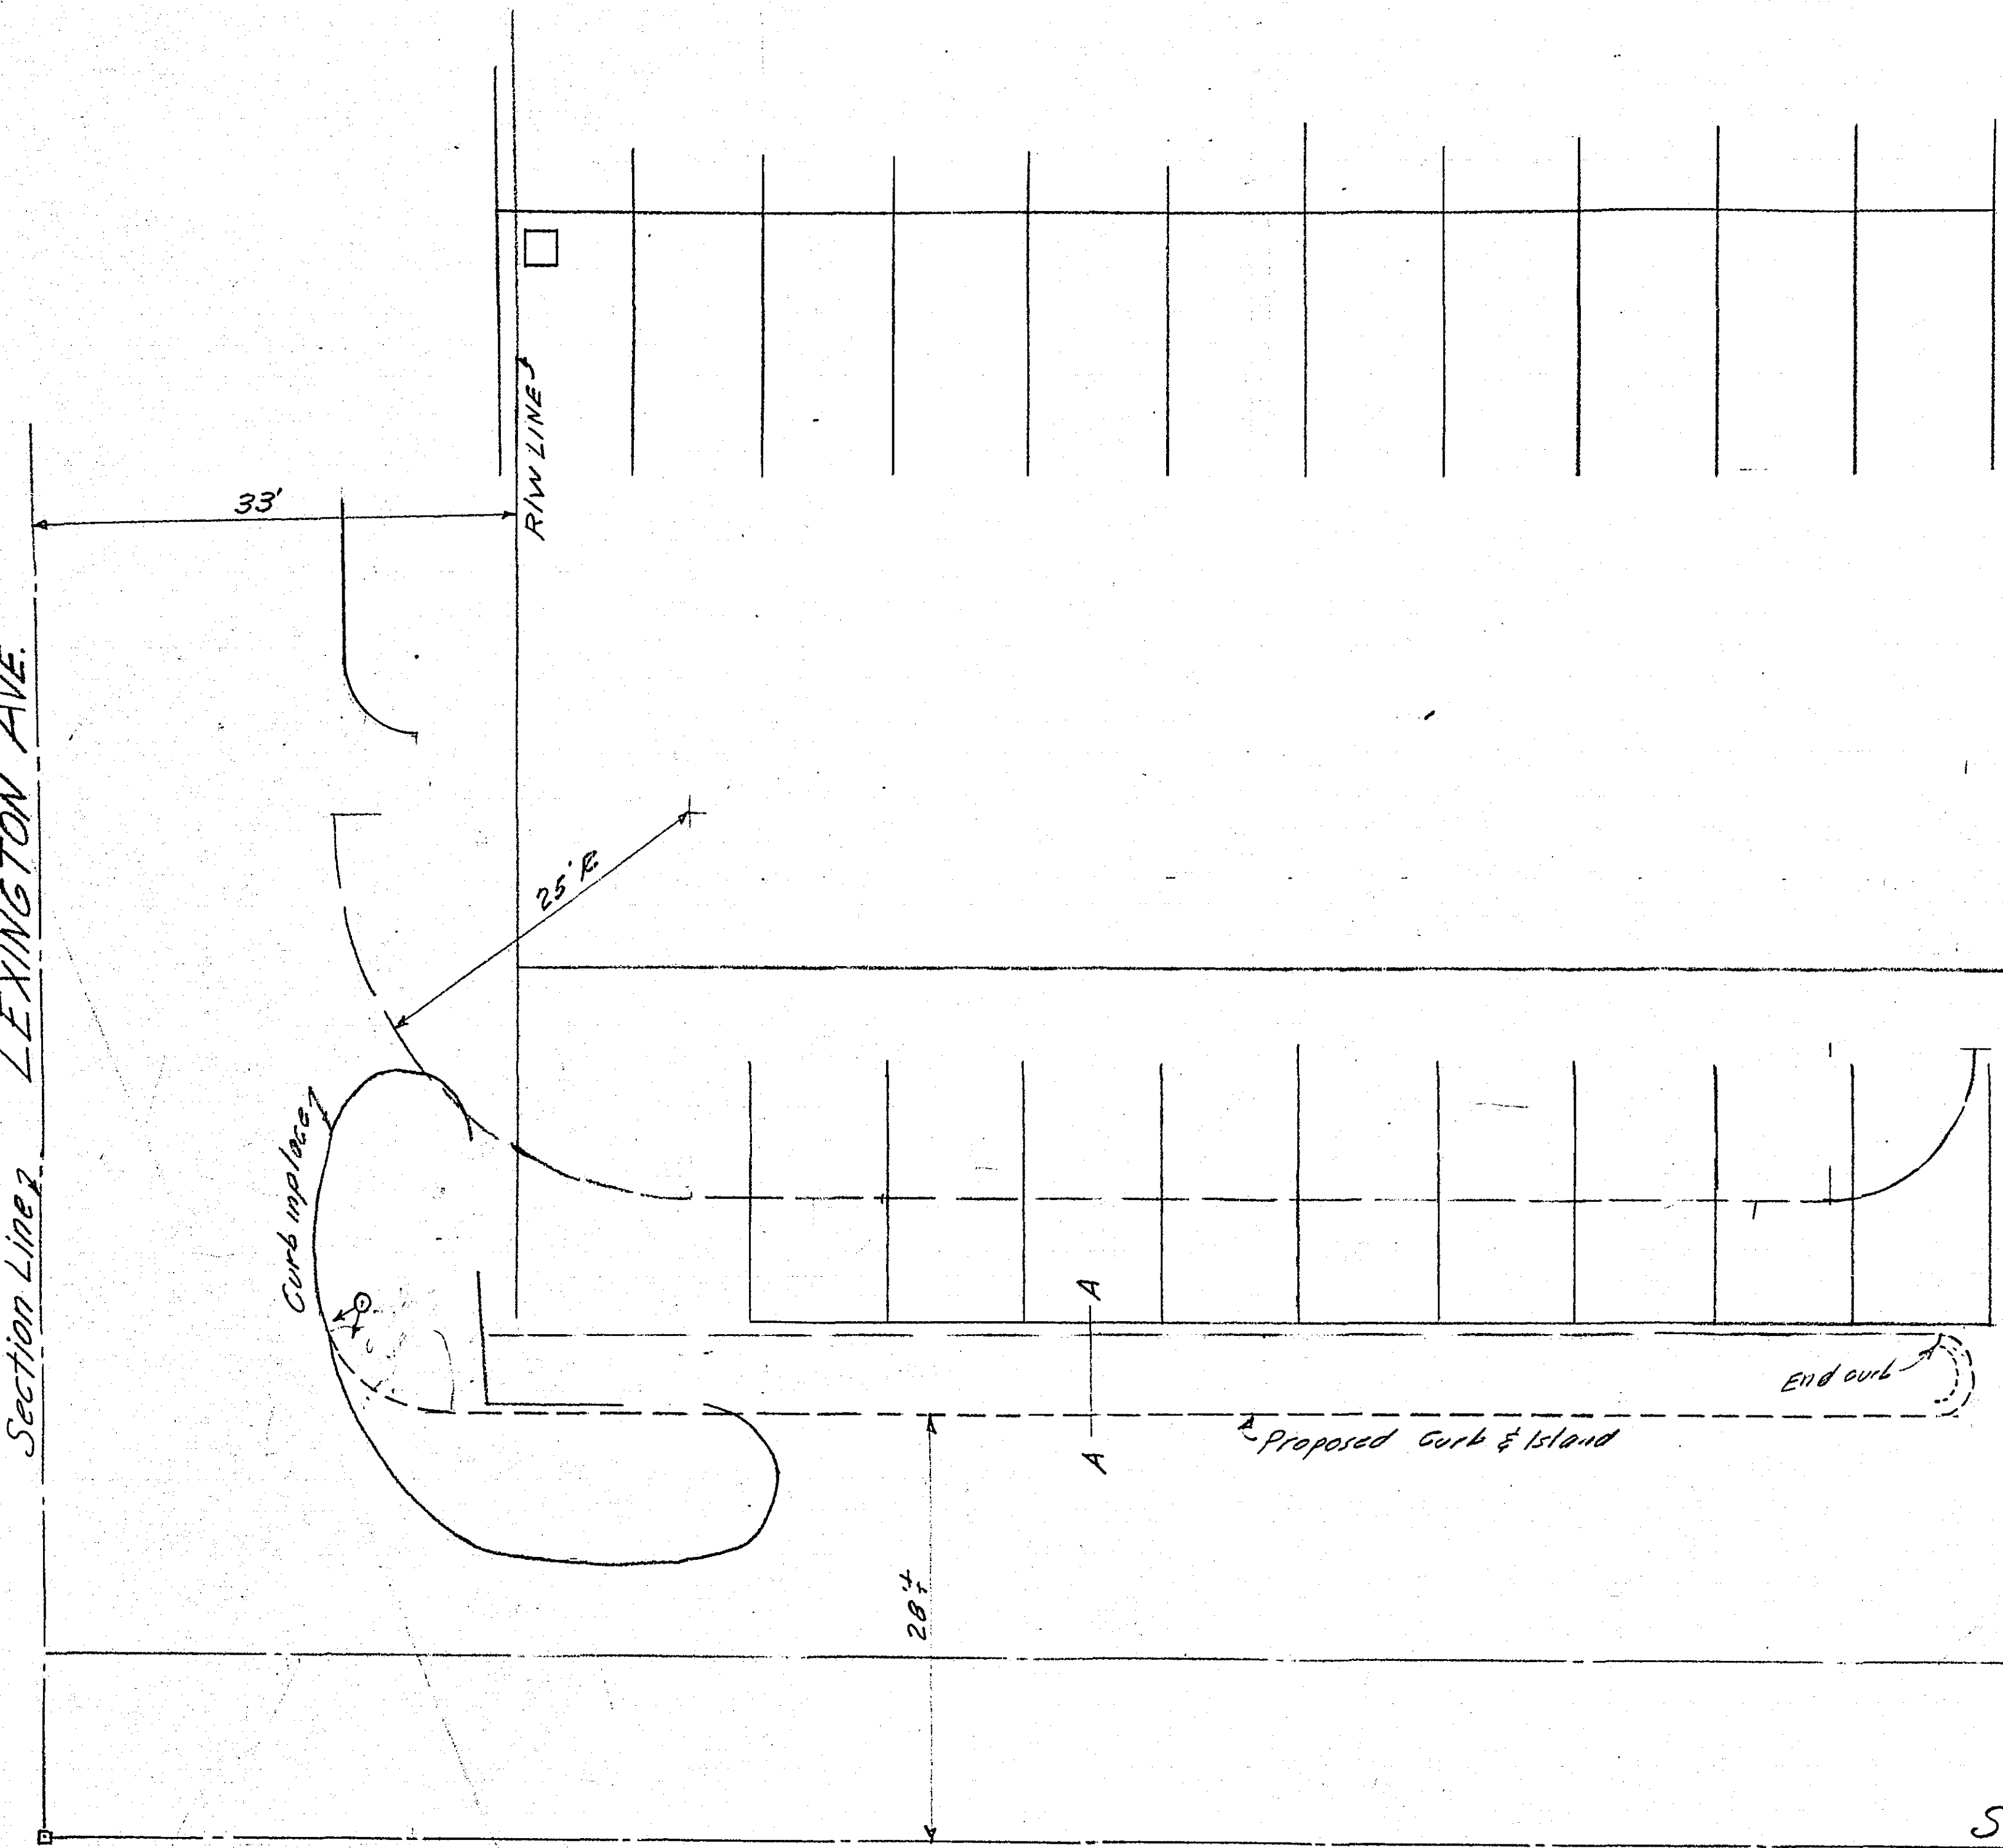


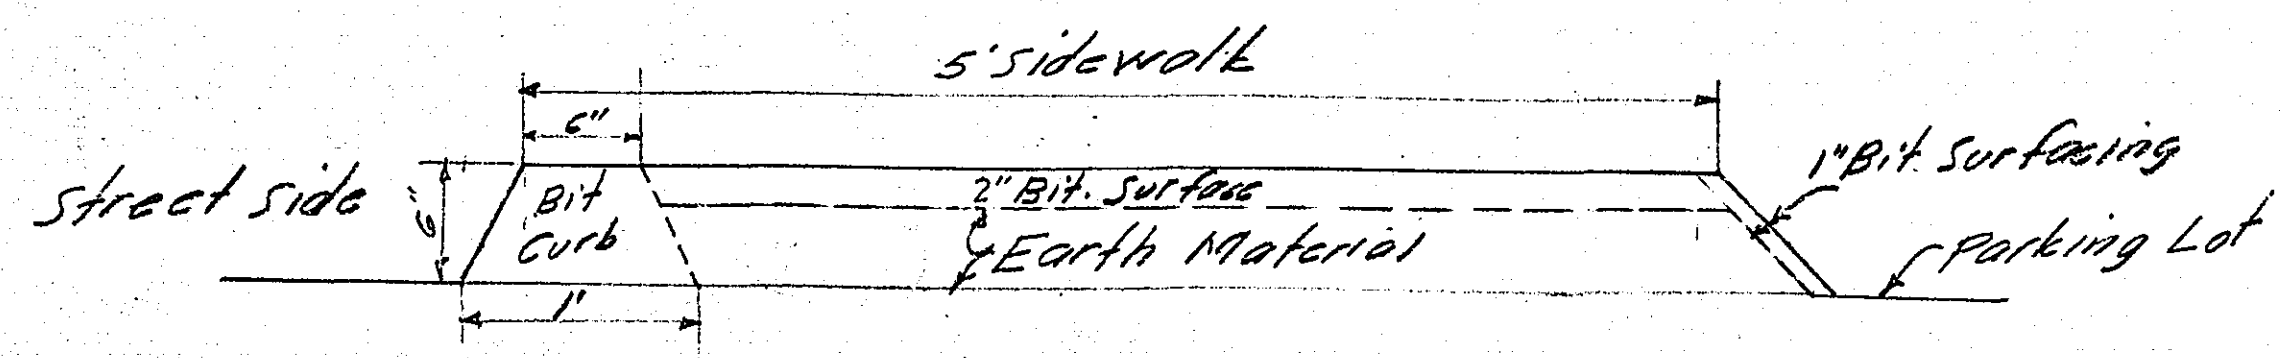

OFFICE OF  
 RAMSEY COUNTY ENGINEER  
 HARRY S. BRONSON

**PARKING LAYOUT**  
 AT  

DEC. 1953 SCALE 1/4" = 10'

Larp. Ave.  
 R/W Map  
 P-754







