

S.W. COR.
N.E. 1/4

1/4 - 1/4 LINE

NORTH PROPERTY LINE



JOY ROAD

0 2 3 4 5

ENTRANCE

ENTRANCE

ELEVATIONS

994.9 95.5 93.8
94.0 93.8
93.5 93.5
93.0 93.5
91.4 92.2
88.6 92.2
88.6 88.6

APPROX. LOCATION
PROPOSED SHELTER

TREES & BRUSH

WOODS

TOILETS

HAND PUMP

PARKING LOT

NORMAL W.S. ELEV. 988.50
W.S. ELEV. 988.60 , 5/9/62

SILVER

LAKE (E)

PLOT PLAN FOR PARK SHELTER - SILVER LAKE (E)

RAMSEY COUNTY ENGINEERING DEPT.


SCALE: 1" = 50'

6/7/62

BY: M.D.K.

R-817

R-817

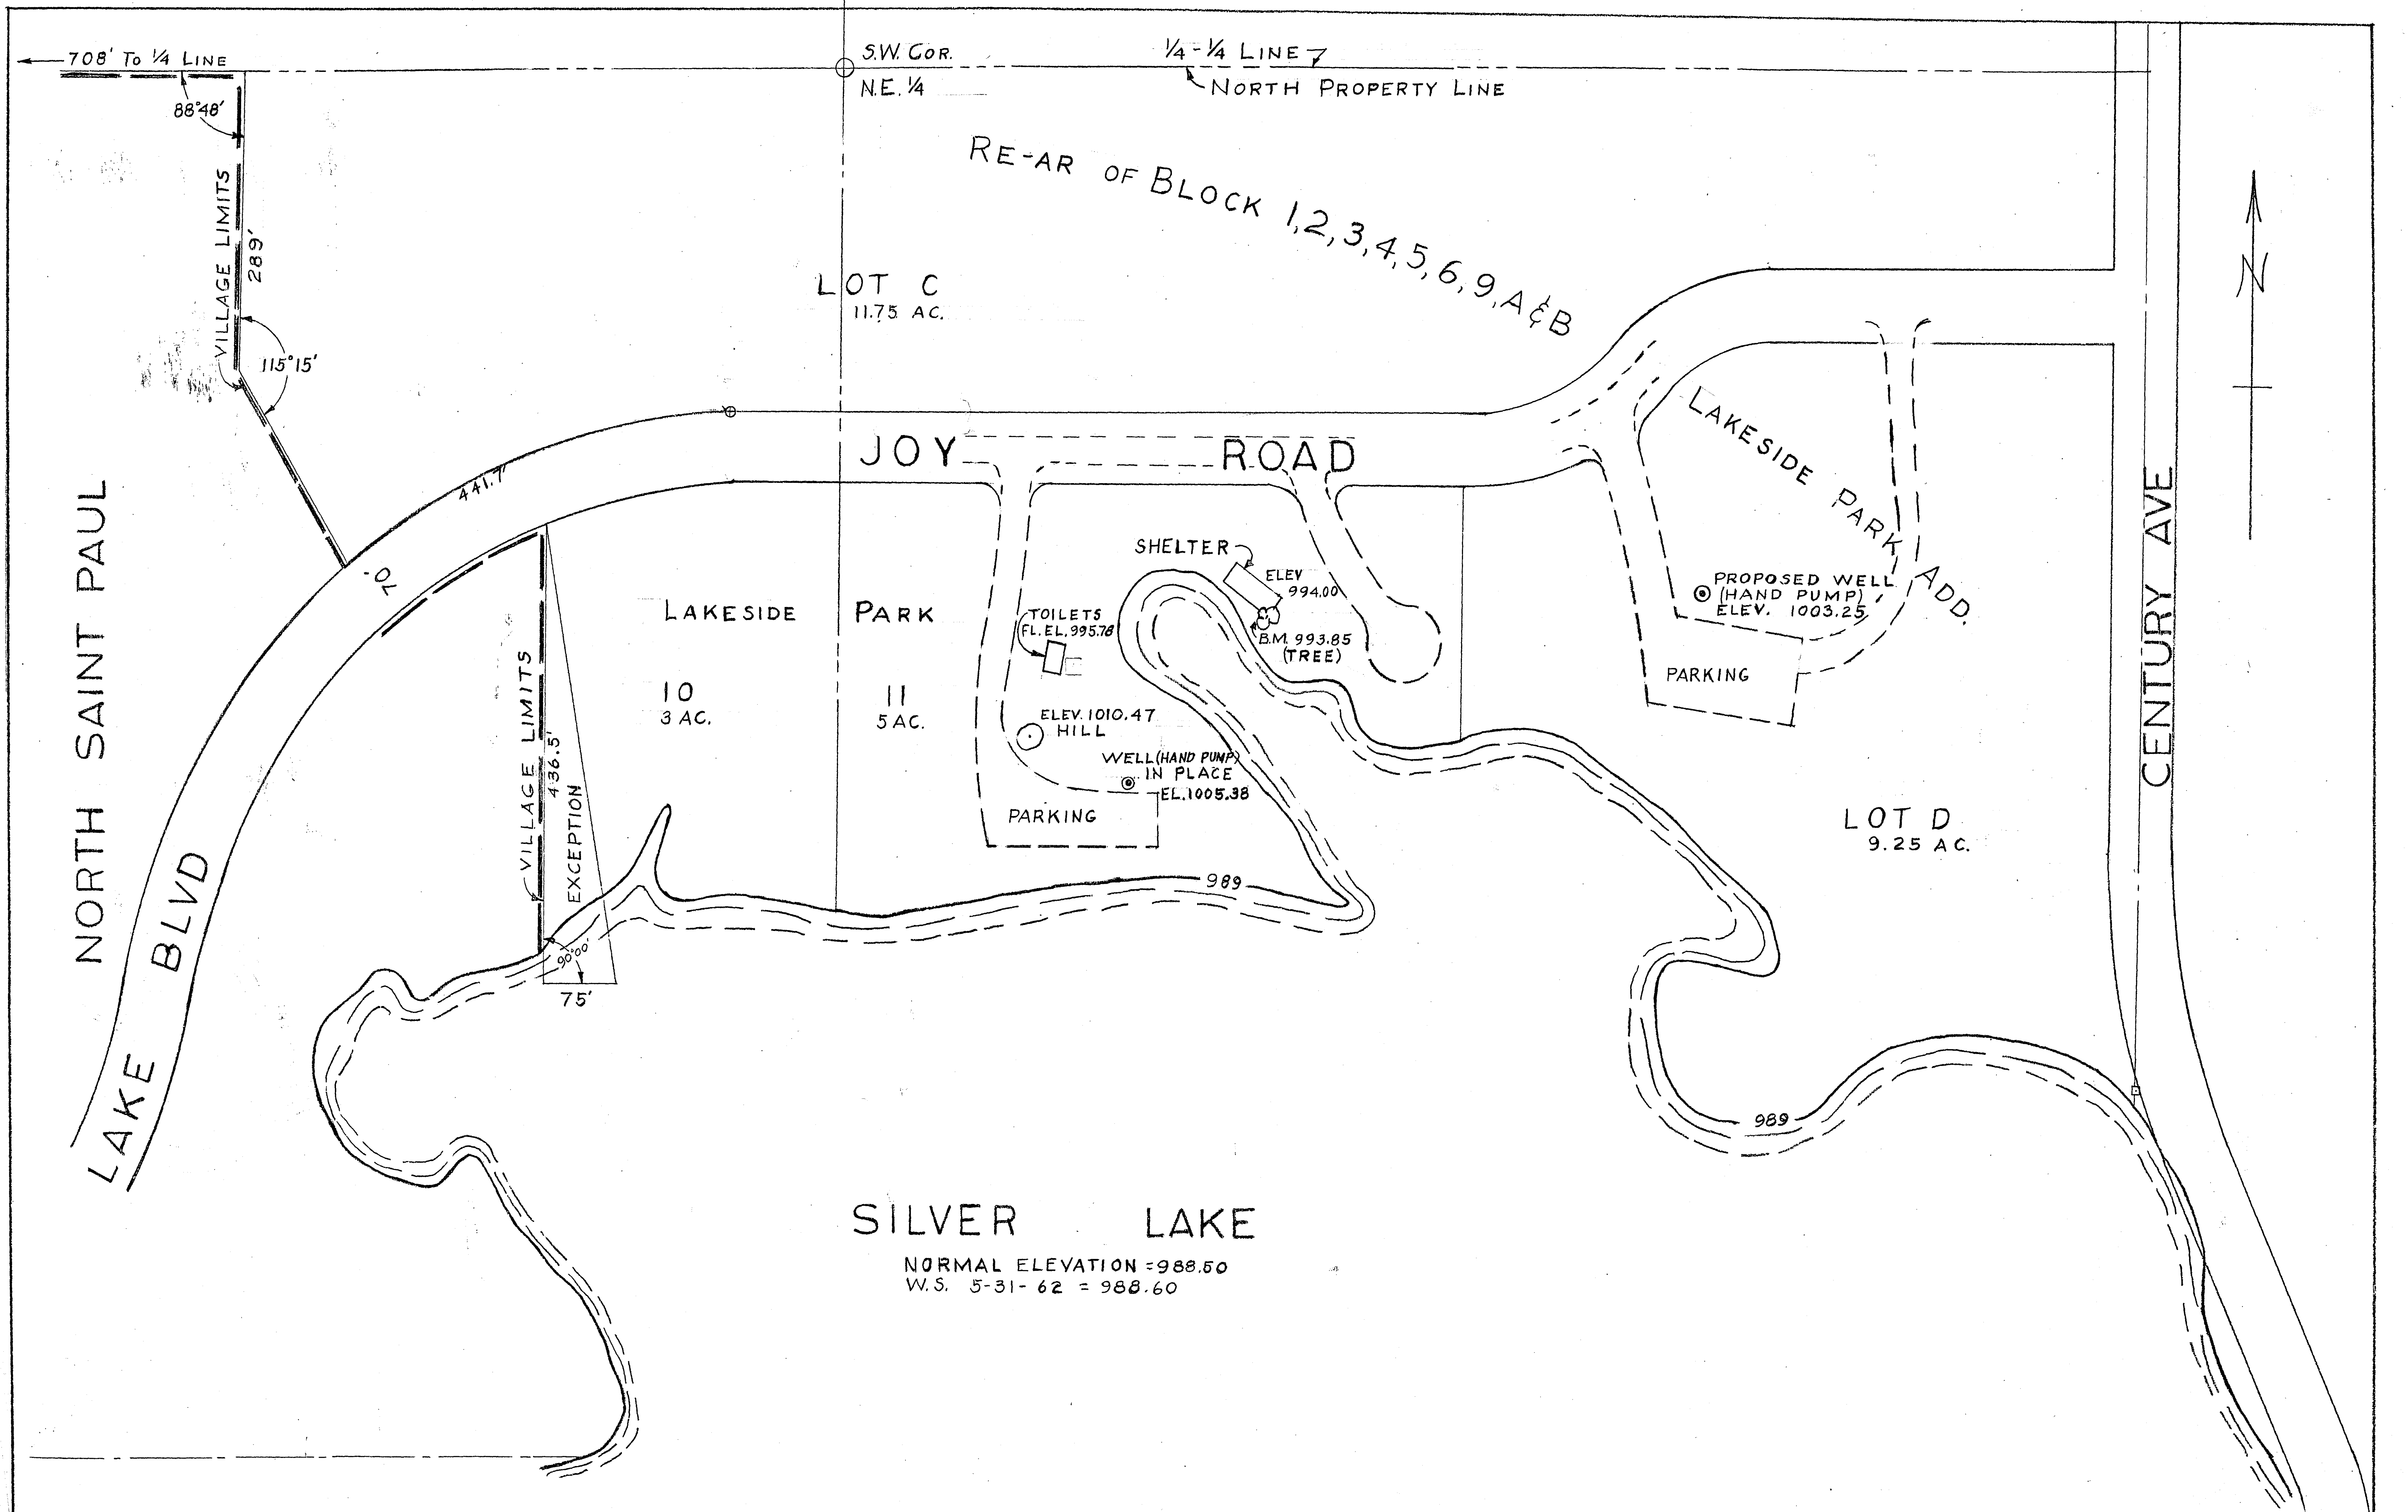

SILVER LAKE
 NORMAL ELEVATION = 988.50
 W.S. 5-31-62 = 988.60

HAND PUMP LOCATION
 JOY PARK
 RAMSEY COUNTY ENGINEERING DEPT.
 SCALE: 1" = 100'
 6-12-64 DWN. BY G.H.J.

V-81