




PLAN
SCALE: 1" = 1'-0"

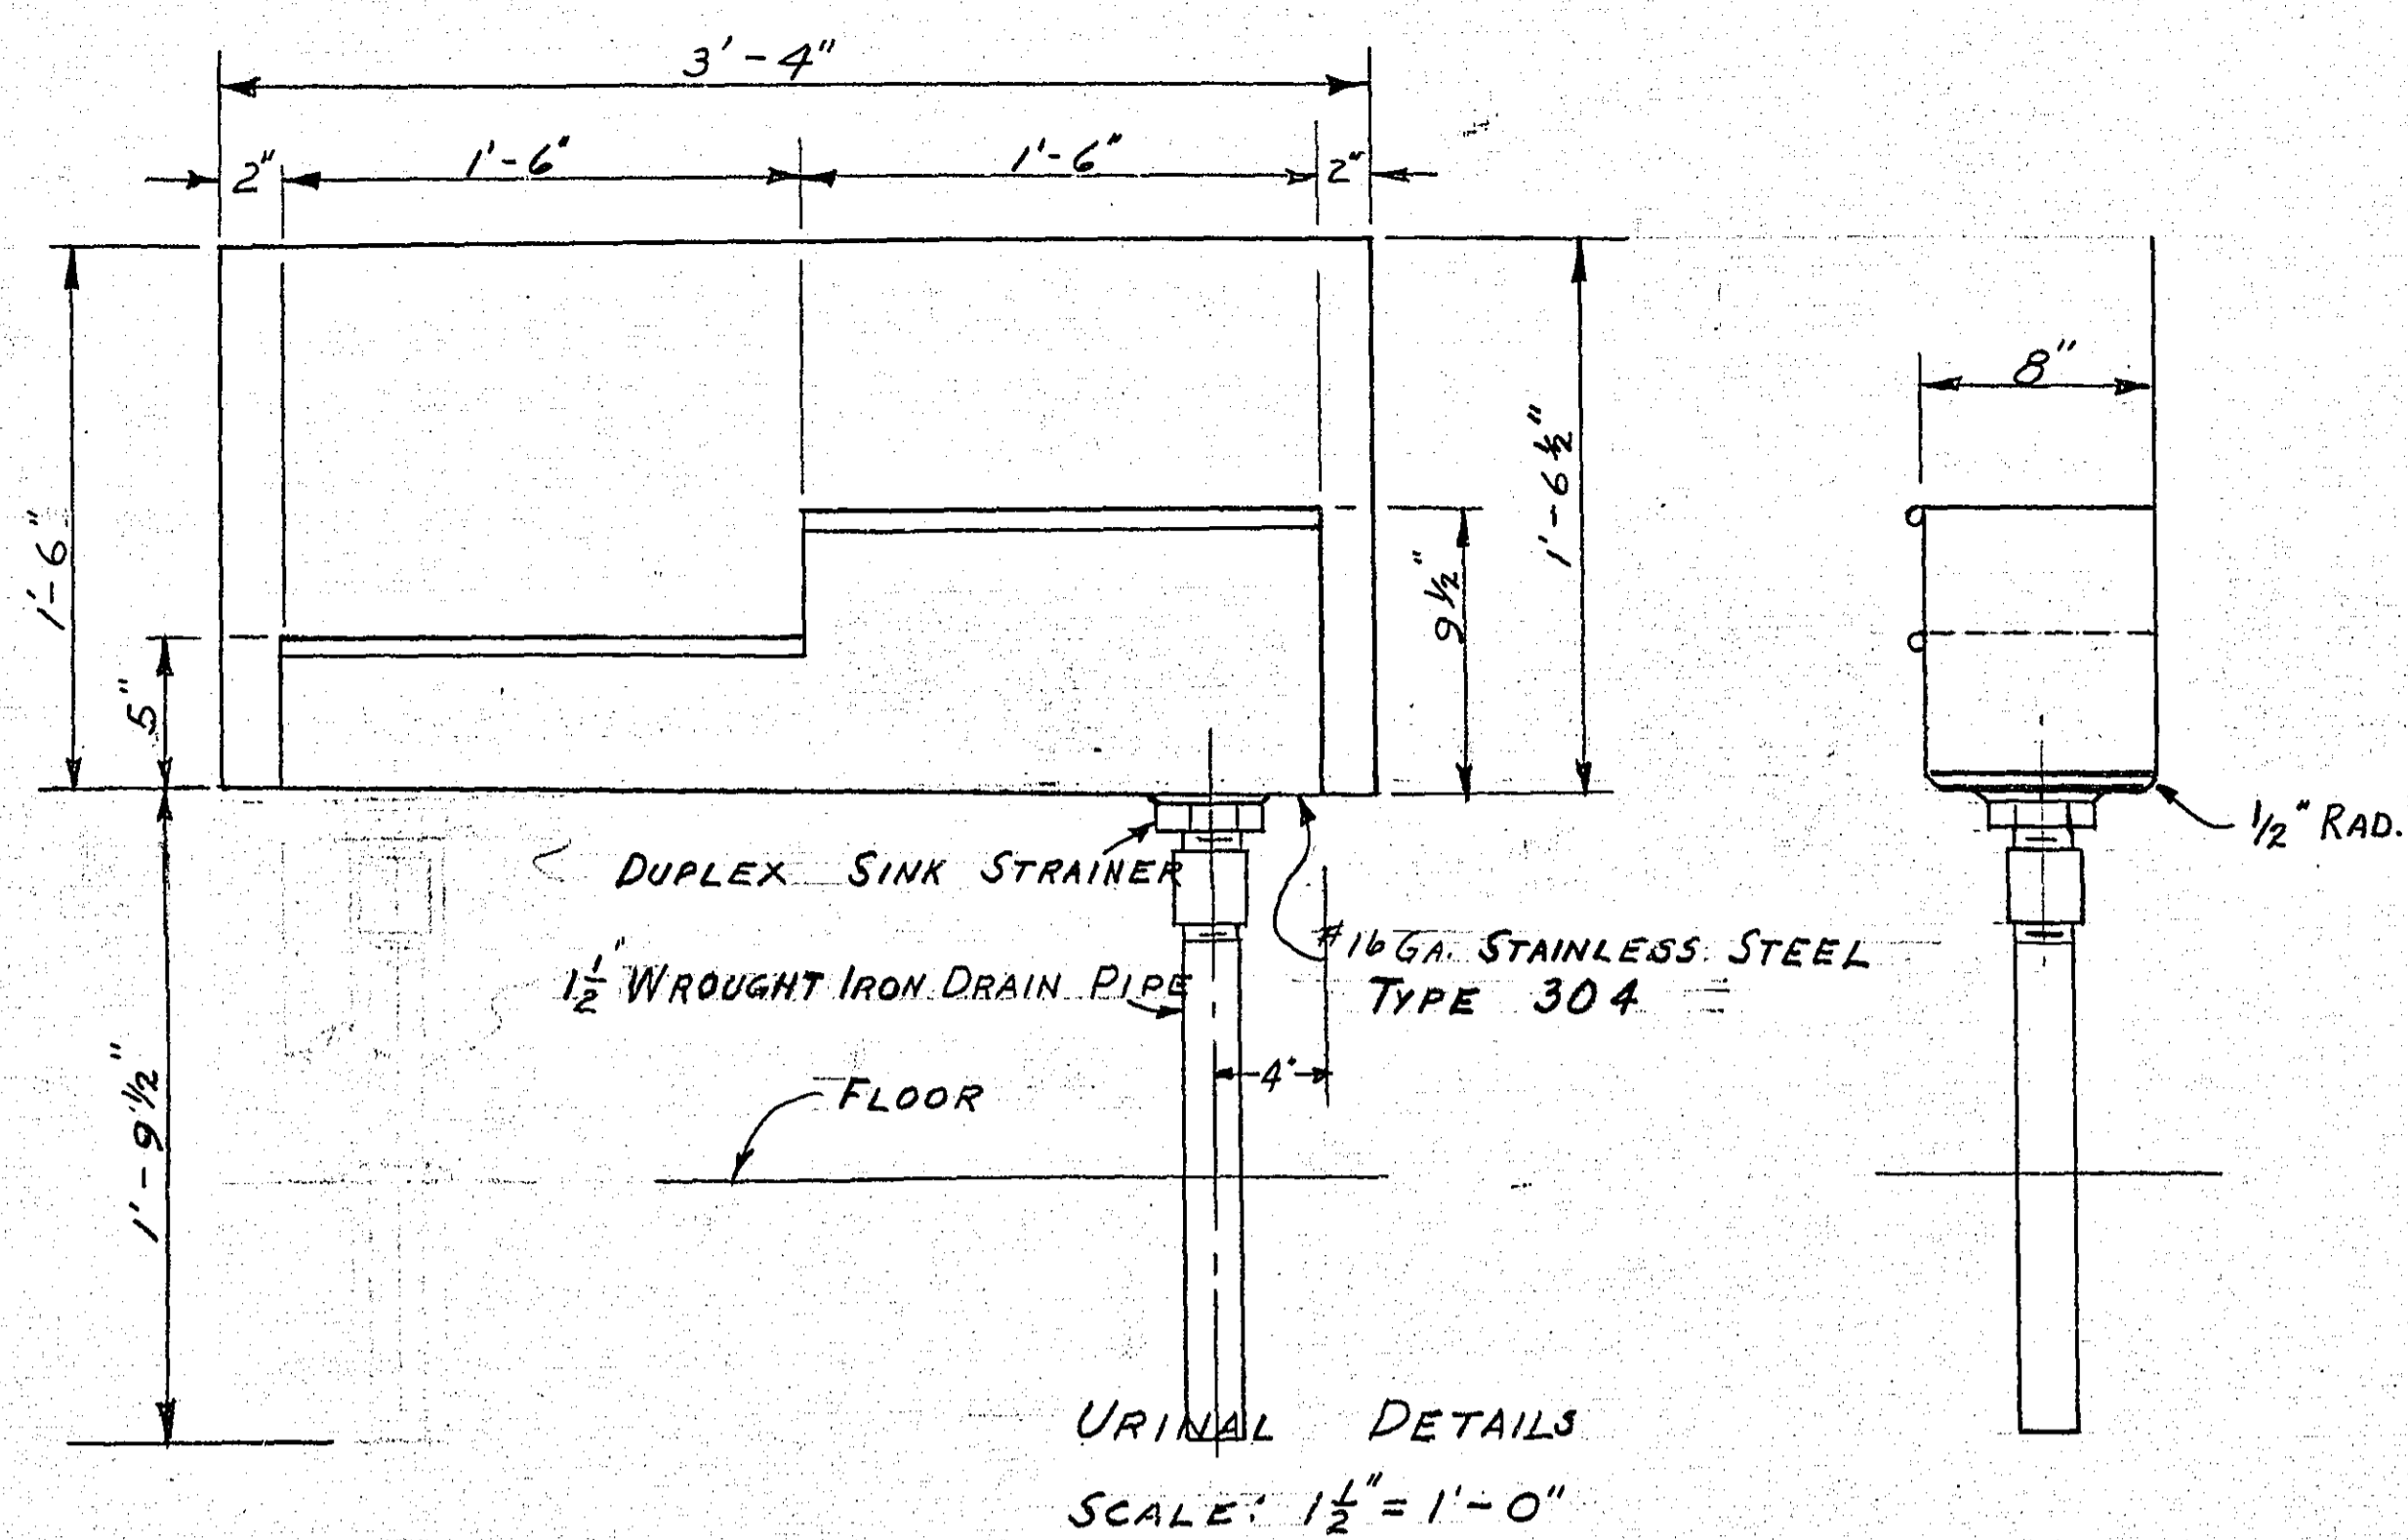

SCALE: 1 1/2" = 1'-0"

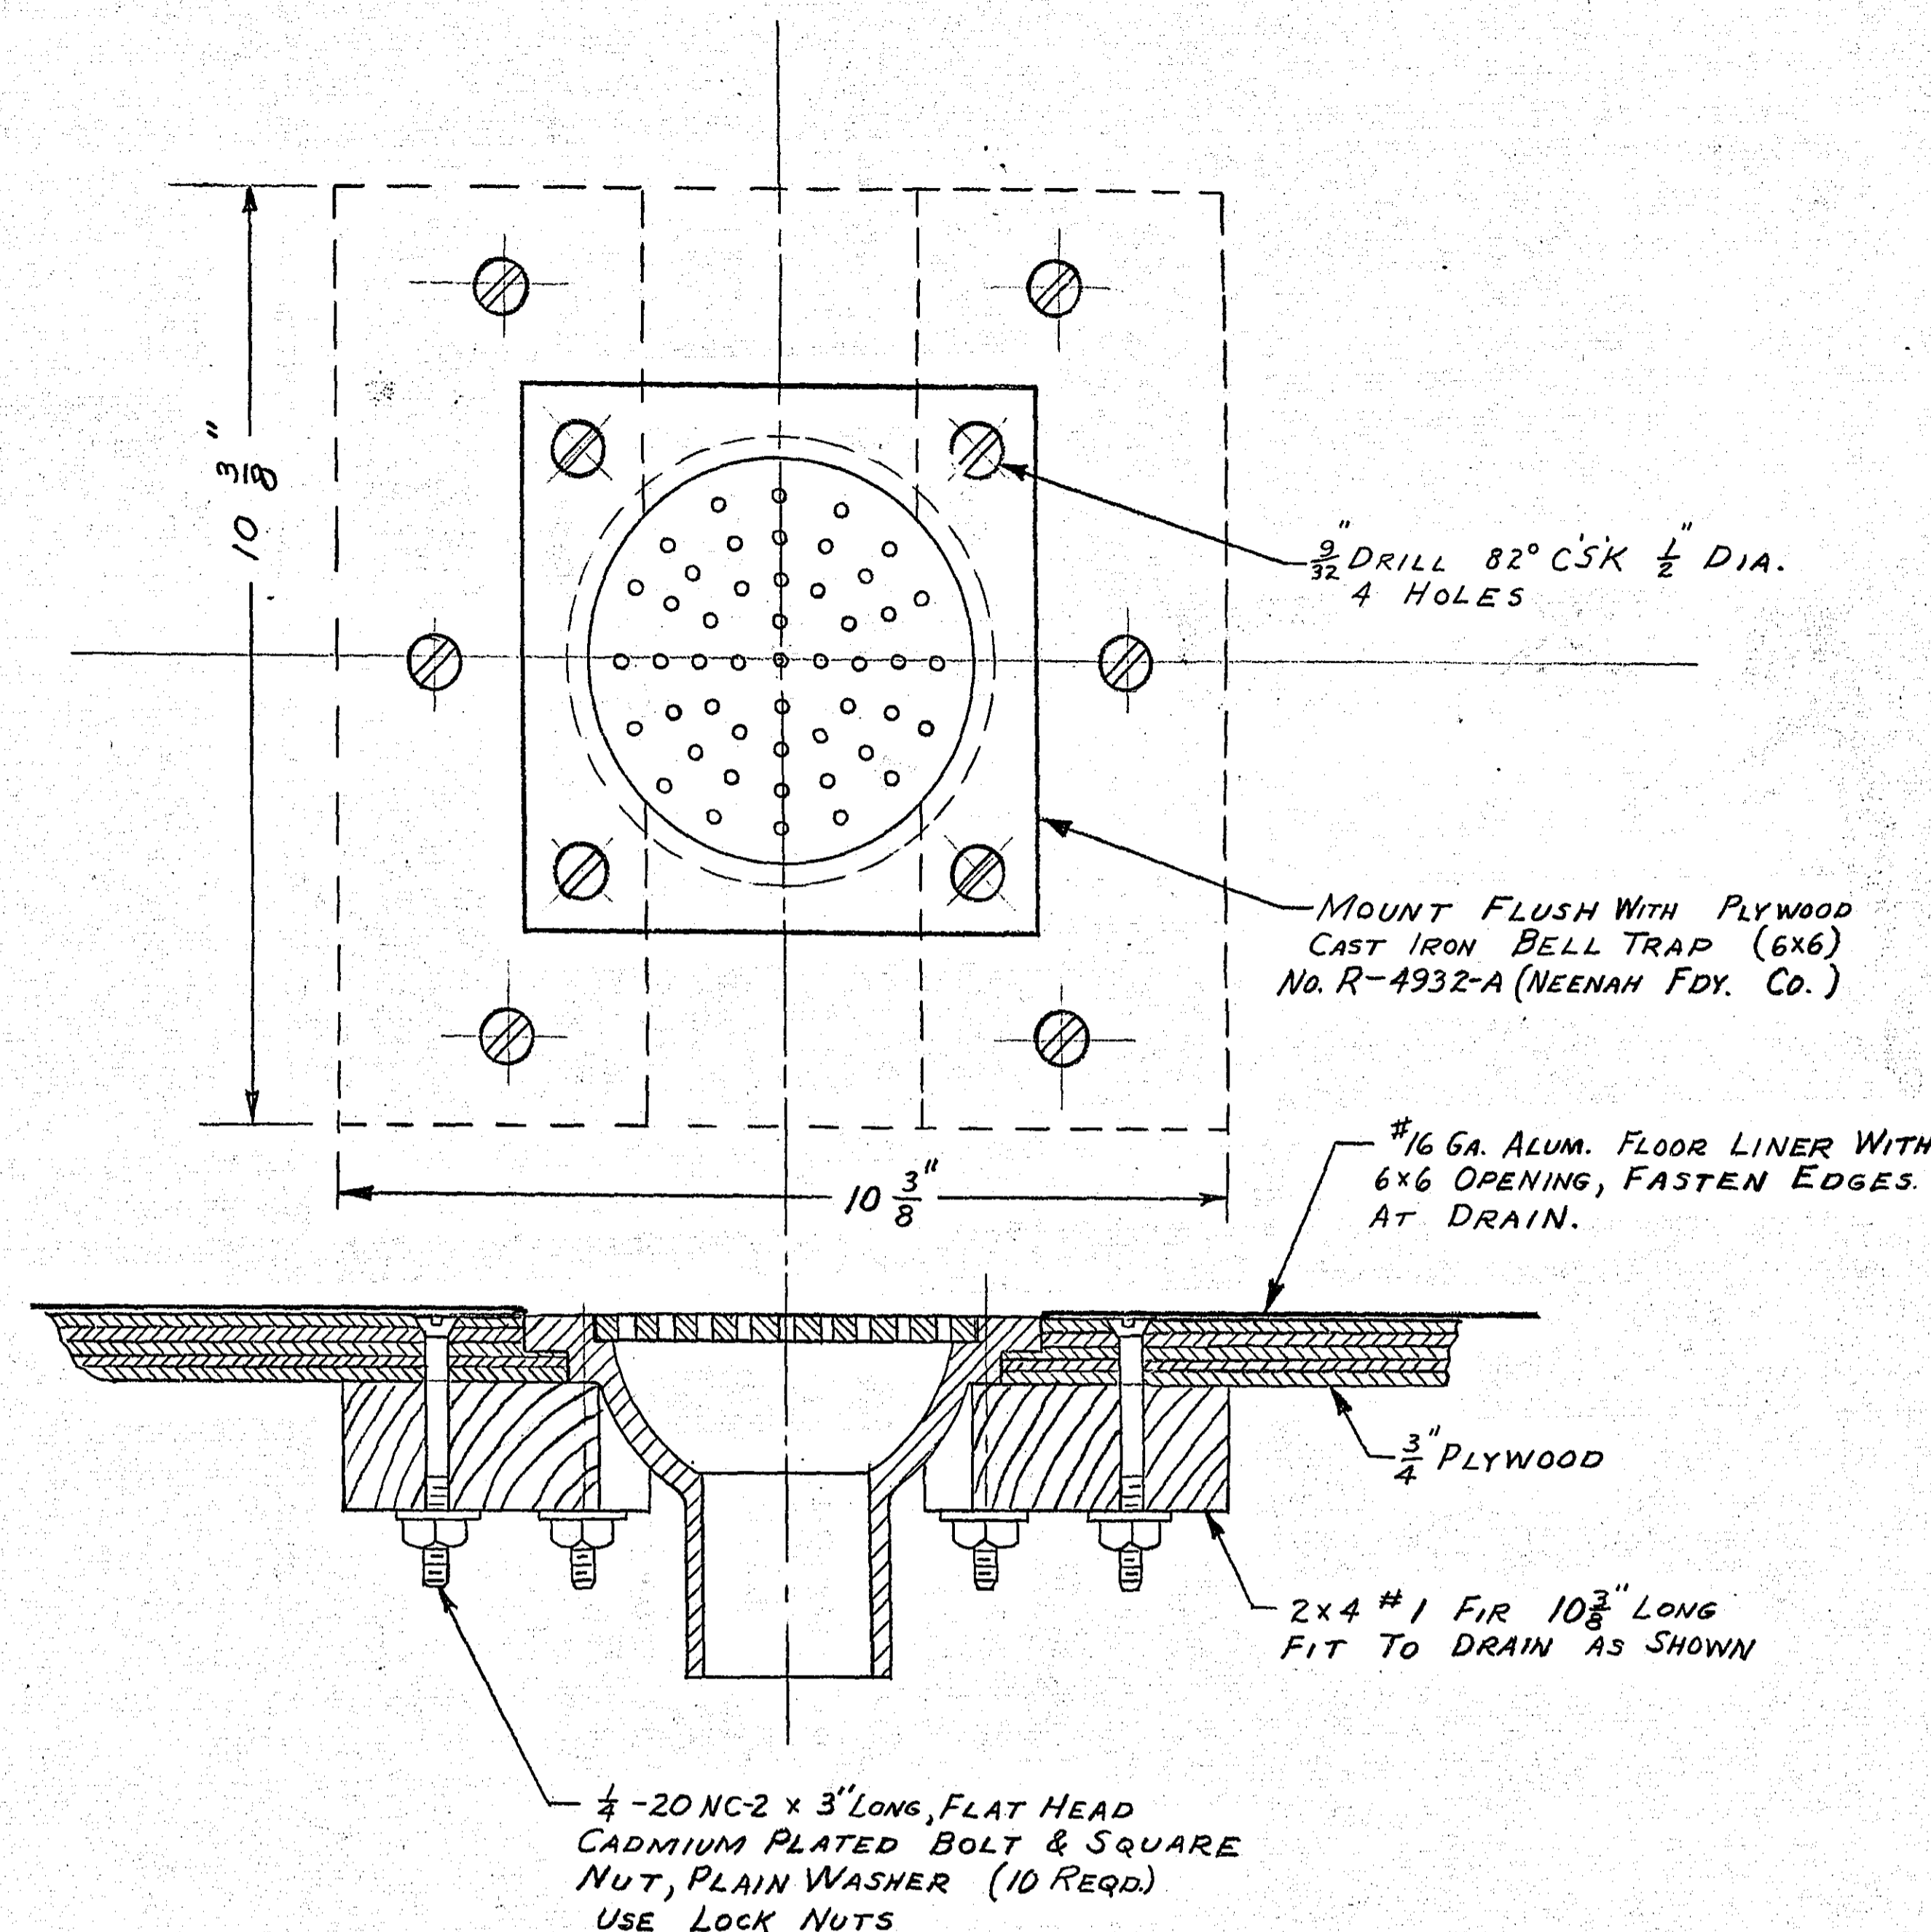


FLOOR DRAIN DETAILS
SCALE: 1/2" SIZE

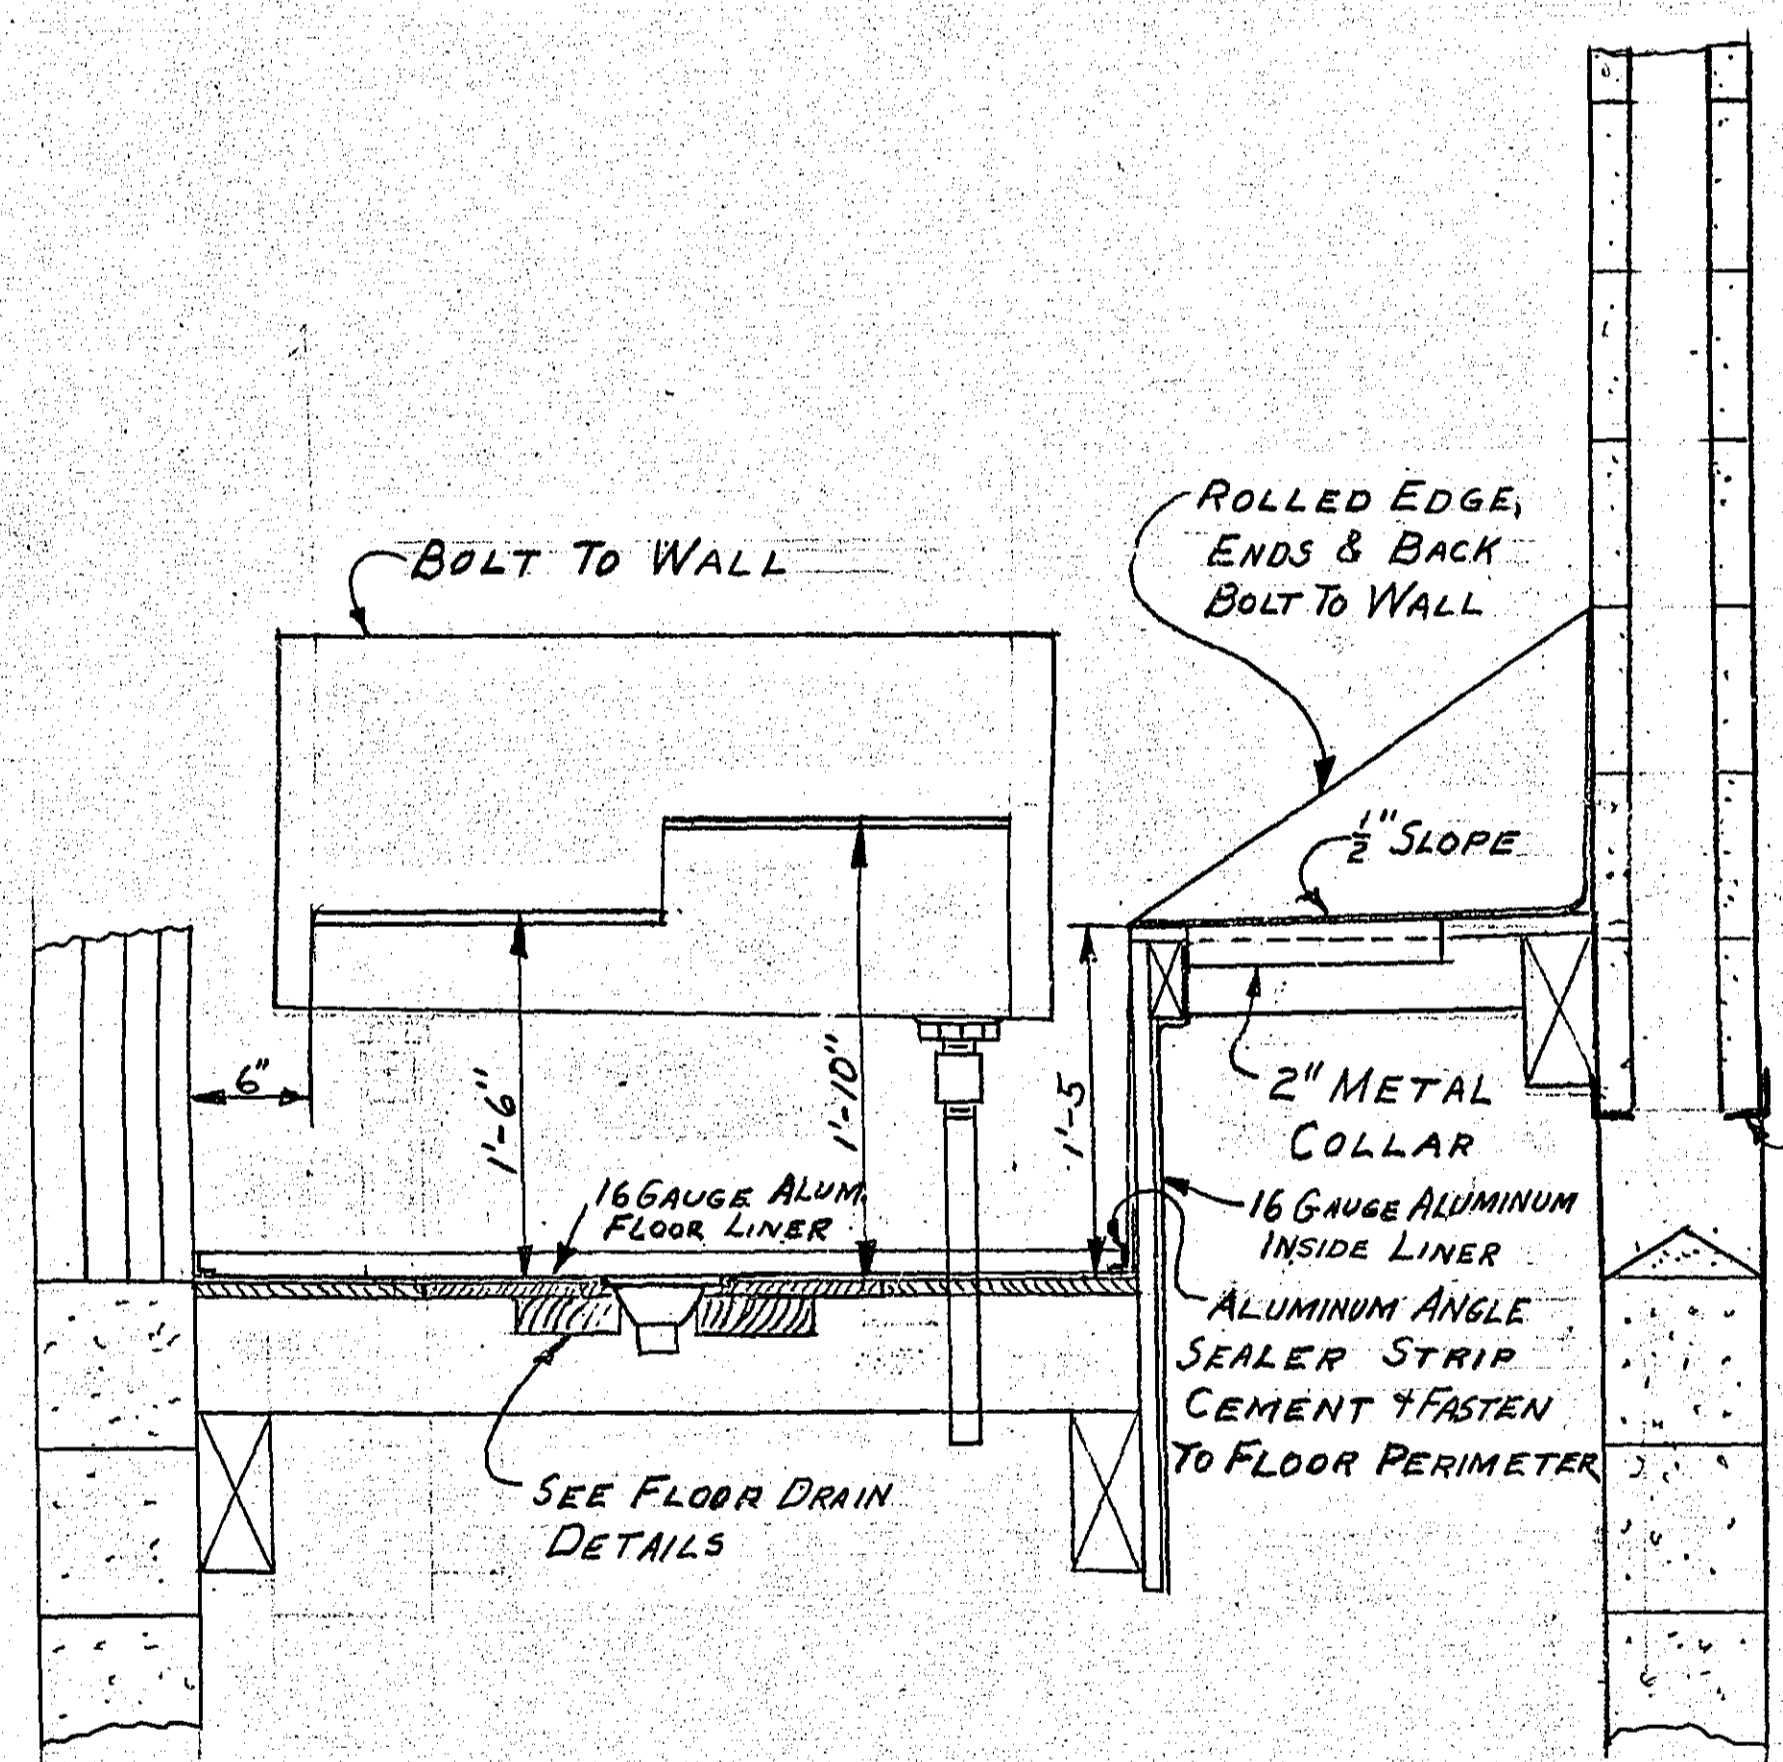

SECTION A-A

NOTE: #16 GAUGE ALUMINUM SEAT & FLOOR LINER TO BE INSTALLED IN TWO SECTIONS AS SHOWN IN DETAIL A-A

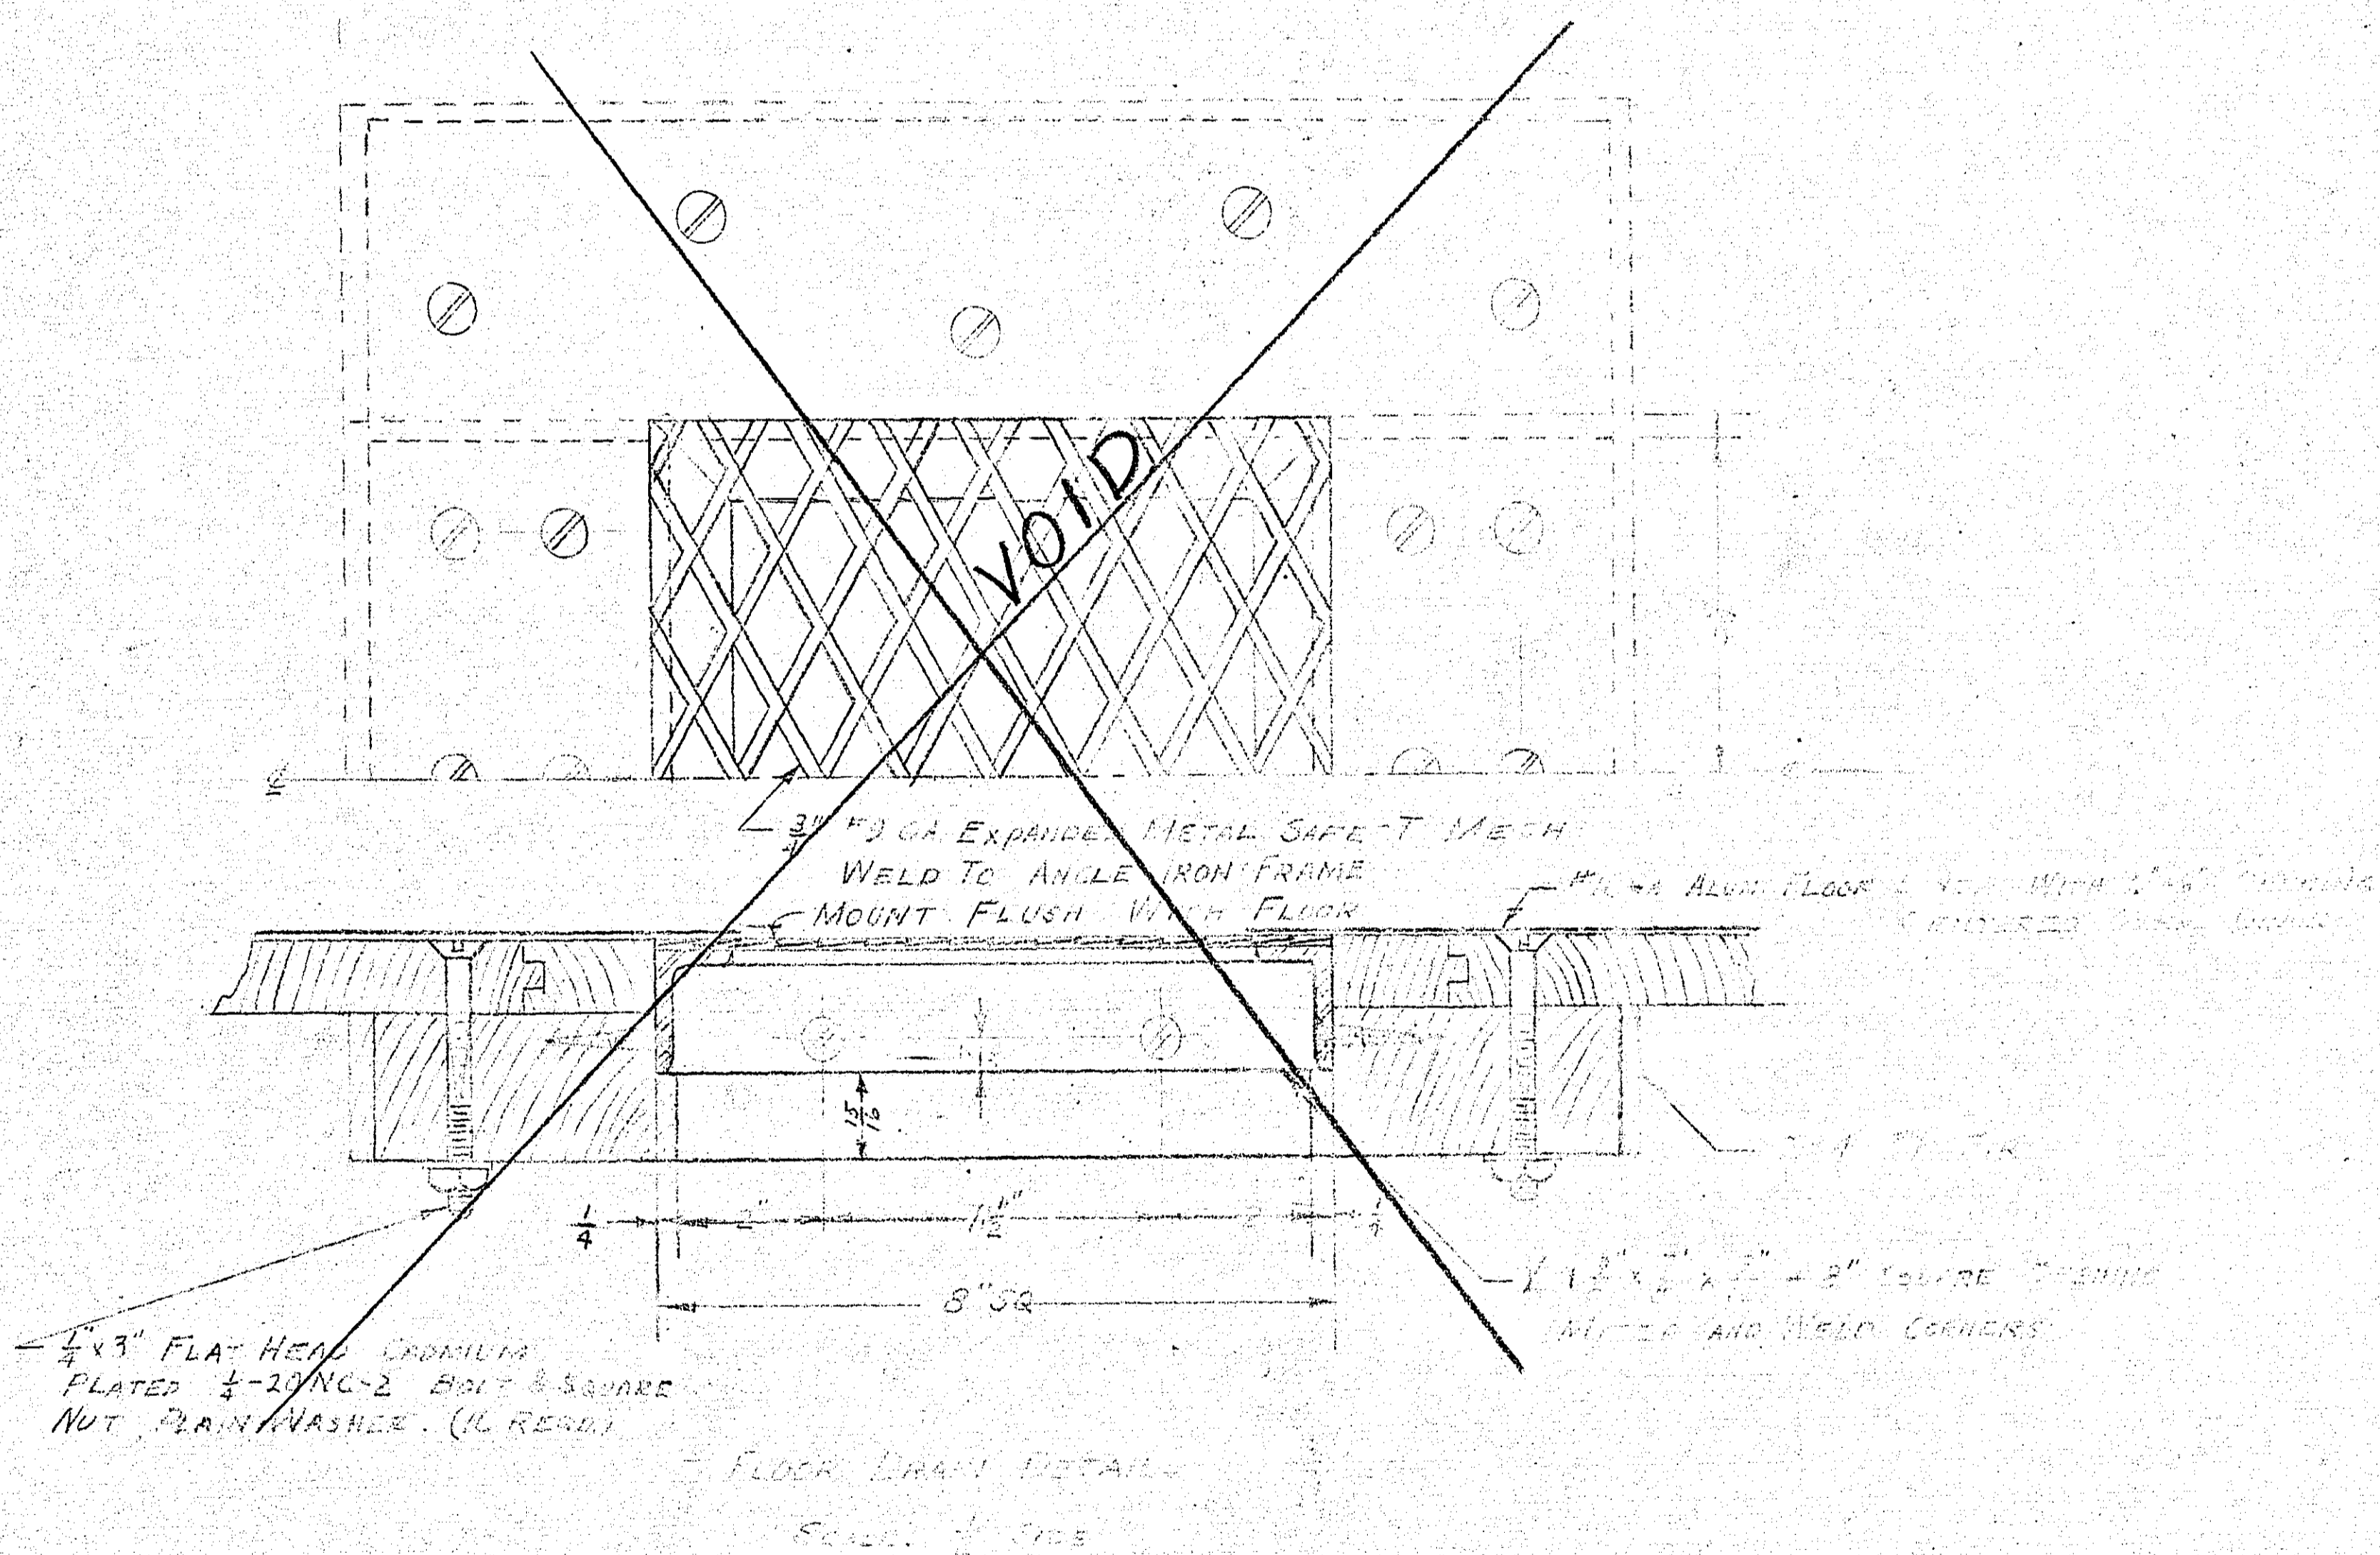

FLOOR DRAIN DETAILS
SCALE: 1/2" SIZE

R-822