

NEG. 8
~~MARTHA SCHLOZER CARL E~~


NEG. 58
GIOVANNI CINCOTTA



NEG. 7 STATE OF MINNESOTA
NEG. 8 MARTHA SCHLOZER, CARL F. SCHLOZER & WILLIAM C. SCHLOZER FRANK I. & JUNE W. CINCOTTA
NEG. 9 RICHARD A. & ETTA JAMES
NEG. 10 ROBERT F. & RUBY C. MEMURRAY
NEG. 11 ANTHONY J. & TEOFILA WOLCZYNSKI
NEG. 12 ALBERTINE SCHWARTZ
NEG. 13 THE KING PIG COMPANY
NEG. 14 JACOB GINGOLD & BESSIE GINGOLD R.E. LEE

NEG. 57A & 57B FRANK I. CINCOTTA & JUNE W. CINCOTTA
NEG. 58 GIOVANNI CINCOTTA
NEG. 59 EDGAR GAHLER & IDELLA GAHLER
NEG. 60 JOE POTTER
NEG. 61 HERBERT H. BALLER & EVELYN C. BALLER
NEG. 62 DONALD A. BALLER & MARIE BALLER
NEG. 63 PAUL ANTHONY WRISKY & MARCELLA E. WRISKY WILLIAM R. BROAD
NEG. 64 MICHAEL KERIN & FRANCIS M. KERIN

NEG. 65 ROBERT P. KNUTSON & WAVE KNUTSON
NEG. 66 HENRY J. WELSCH & EDITH WELSCH

 

Dist. Court File # 277798

20X F-2/2

Final
Print this portion only 10/6/53
1 only

NEG. 1
TEMPLE OF AARON CONGREGATION

NEG. 2
ERNEST STUBER, HERMAN STUBER & JOHN STUBER

NEG. 3
RAYMOND A. GERKEN & HELEN J. GERKEN

NEG. 4
HENRY R. LINDER

NEG. 5
WALTER LINDER & PETER J. LINDER

NEG. 6
STATE OF MINNESOTA

NEG. 7
STATE OF MINNESOTA

NEG. 8
MARTHA SCHLOZER, CARL F. SCHLOZER & WILLIAM E. SCHLOZER
FRANK I. & JUNE W. CINCOTTA

NEG. 9
RICHARD A. & ETTA J. JACOBSON

NEG. 51
TRUSTEES GERMAN EVANGELICAL LUTHERAN ST. JOHN CONGREGATION
TRUSTEES GERMAN EVANGELICAL LUTHERAN TRINITY CHURCH

NEG. 52
JESSIE H. JACKSON

NEG. 53
KENNETH P. WALTERS & ALICE H. WALTERS

NEG. 54
VERONICA JABLONSKI
PAUL C. PETERSEN

NEG. 55
LAURA MARIE CASAW


NEG. 56
PAUL DAGGETT

NEG. 57A & 57B
FRANK I. CINCOTTA & JUNE W. CINCOTTA

NEG. 58
GIOVANNI CINCOTTA

NEG. 59
EDGAR GAHLER & IDELLA GAHLER

NEG. 60
JOE POTTER

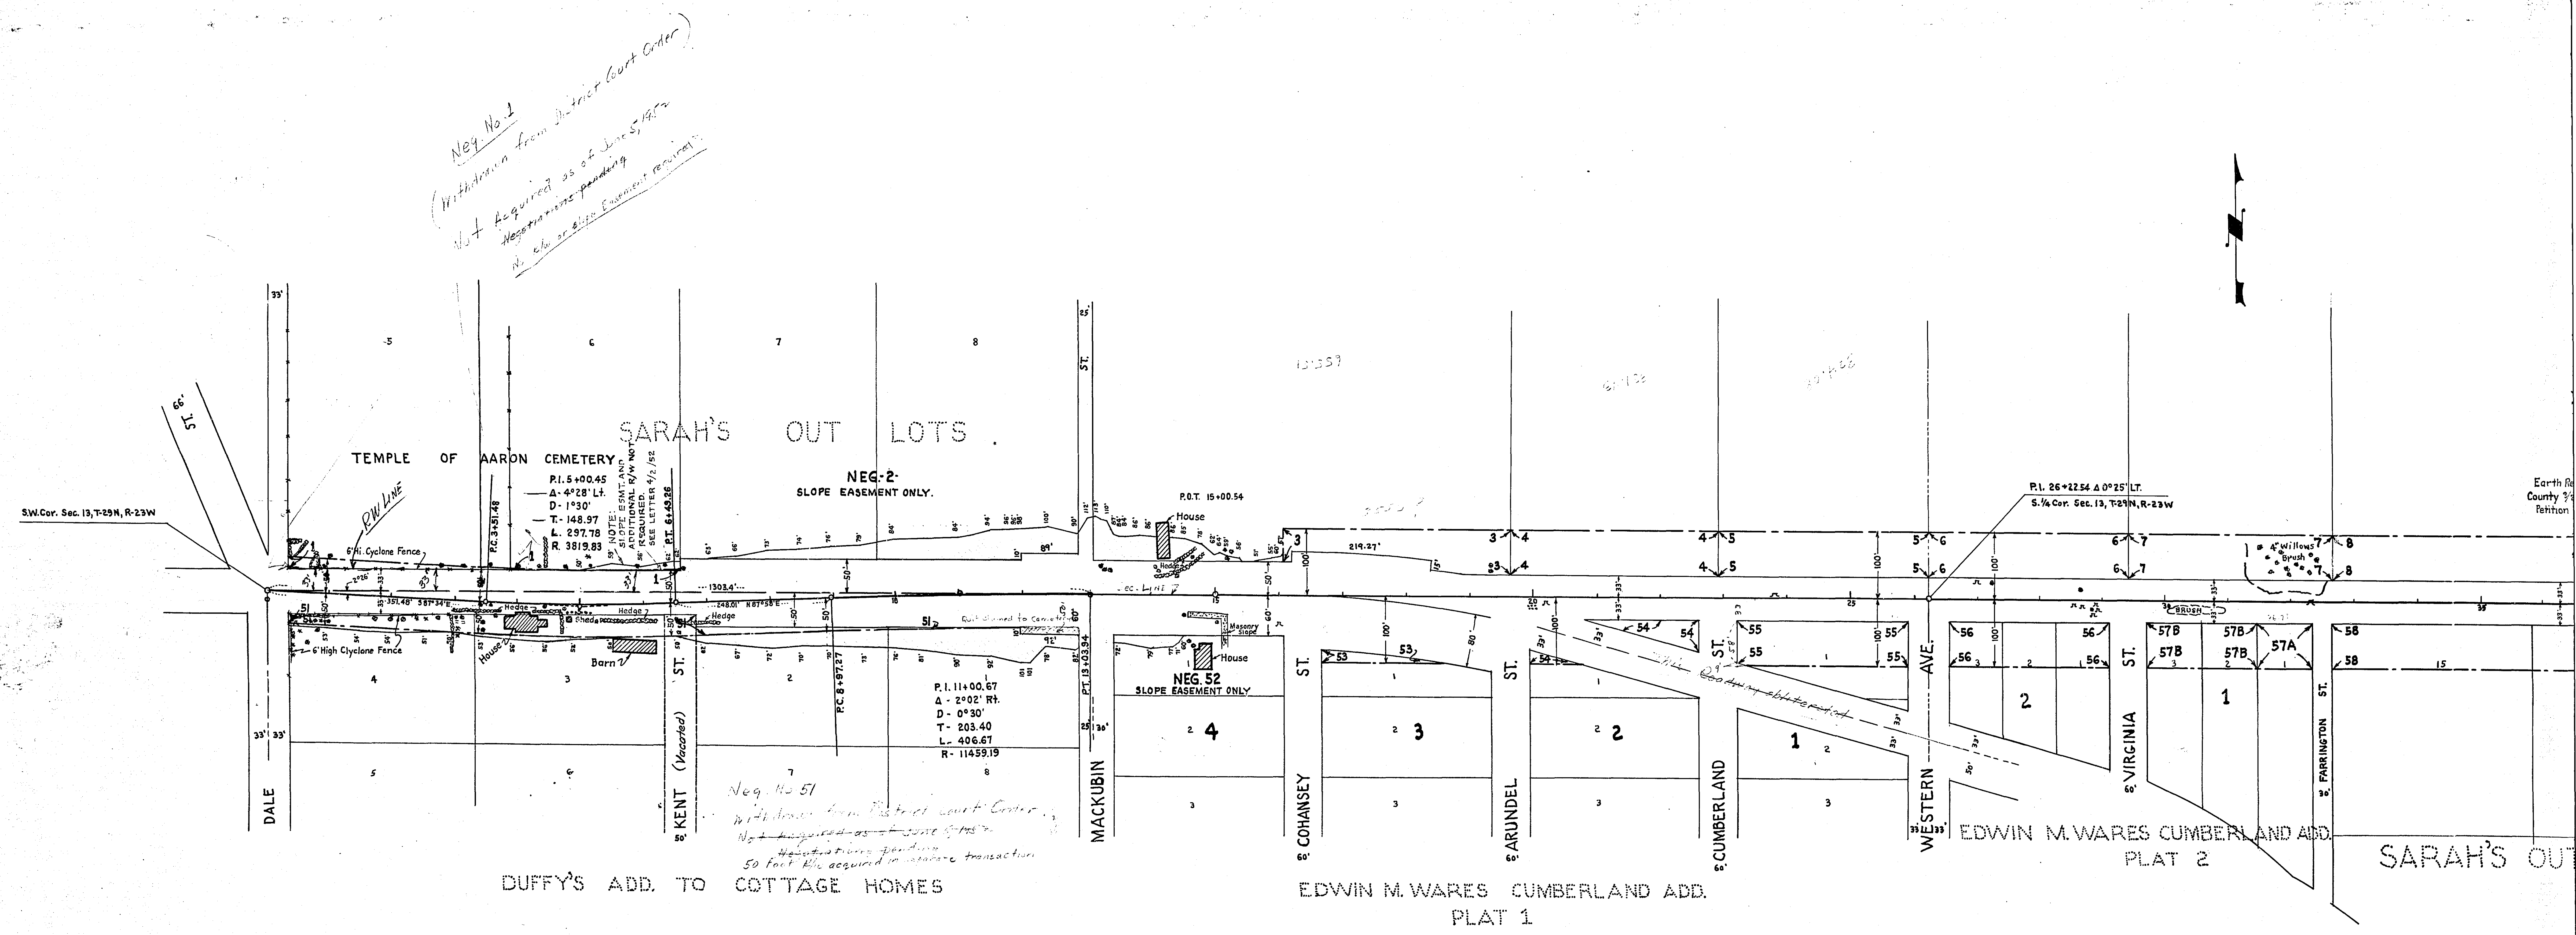

OFFICE OF RAMSEY COUNTY ENGINEER
RIGHT OF WAY MAP
CO. PROJ. 52-50E
LARPENTEUR AVE.
FROM DALE ST. TO RICE ST.
MICROFILMED
RAMSEY CO. ENGR.

LEGEND
[Symbol] DENOTES ADDITIONAL RIGHT OF WAY
[Symbol] " SLOPE EASEMENT
[Symbol] " TEMPORARY BORROW PIT

END OF PRINT

