

TRACT NO. 1
E. H. WILLMUS PROPERTIES, INC.

TRACT NO. 2
INDIANHEAD TRUCK LINE, INC.

TRACT NO. 3
CHARLES T. ENGEL
GRETCHEN M. ENGEL

TRACT NO. 4
FRANK J. LINDIG, JR.
DOROTHY E. LINDIG

TRACT NO. 5
ACTON CONSTRUCTION
COMPANY, INC.

TRACT NO. 6
THE RAMSEY
ENGINEERING COMPANY

TRACT NO. 7
MACK HOTELS, INC.

TRACT NO. 8
GLUEK BREWING COMPANY

TRACT NO. 9
MEADOWS MINNESOTA
TERMINAL CORP.

TRACT
GLUEK B.

P.I. 59+34.55
Δ 11° 06' LT.
D 2° 12.4'
T 252.32'
L 503.02'
R 2596.68'

TWIN

VIEW

CLEVELAND AVENUE



MOUNT RIDGE ROAD

PRIOR AVENUE

FAIRVIEW AVENUE

P.I. 71+20.09
Δ 8° 33'
D 2° 00'
T 214.16'
L 427.50'
R 2864.93'

P.I. 78+80.11
Δ 5° 36'
D 4° 00'
T 70.01'
L 140.00'
R 1432.69'

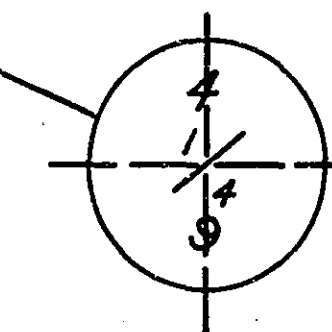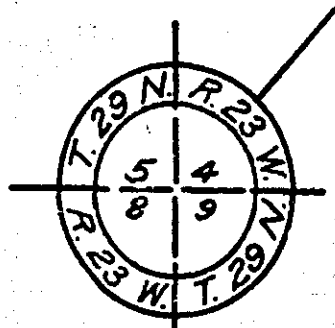

R/W Map
Co. Rd. "C"
Cleveland to Snelling

MICROFILMED
RAMSEY CO. ENGR.

NOTE

The Village of Roseville
did not follow this acquisition 100%
They acquired 14 feet addi-
along the North right of way
of Co. Rd. C. with no &
in their transactions.
In construction
shifted 7' for
purposes
of

TRACT NO. 8
GLUEK BREWING COMPANY

TRACT NO. 9
MEADOWS MINNESOTA
TERMINAL CORP.

TRACT NO. 10
GLUEK BREWING COMPANY

TRACT NO. 11
INTERSTATE PROPERTIES, INC.

TRACT NO. 12
GLUEK BREWING COMPANY

TRACT NO. 4
FRANK J. LINDIG, JR.
DOROTHY E. LINDIG

TRACT NO. 13
GLUEK BREWING COMPANY


TRACT NO. 5
ON CONSTRUCTION
PANY, INC.

TRACT NO. 6
THE RAMSEY
ENGINEERING COMPANY

TRACT NO. 7
HACK HOTELS, INC.

FAIRVIEW AVENUE

SNELLING AVENUE

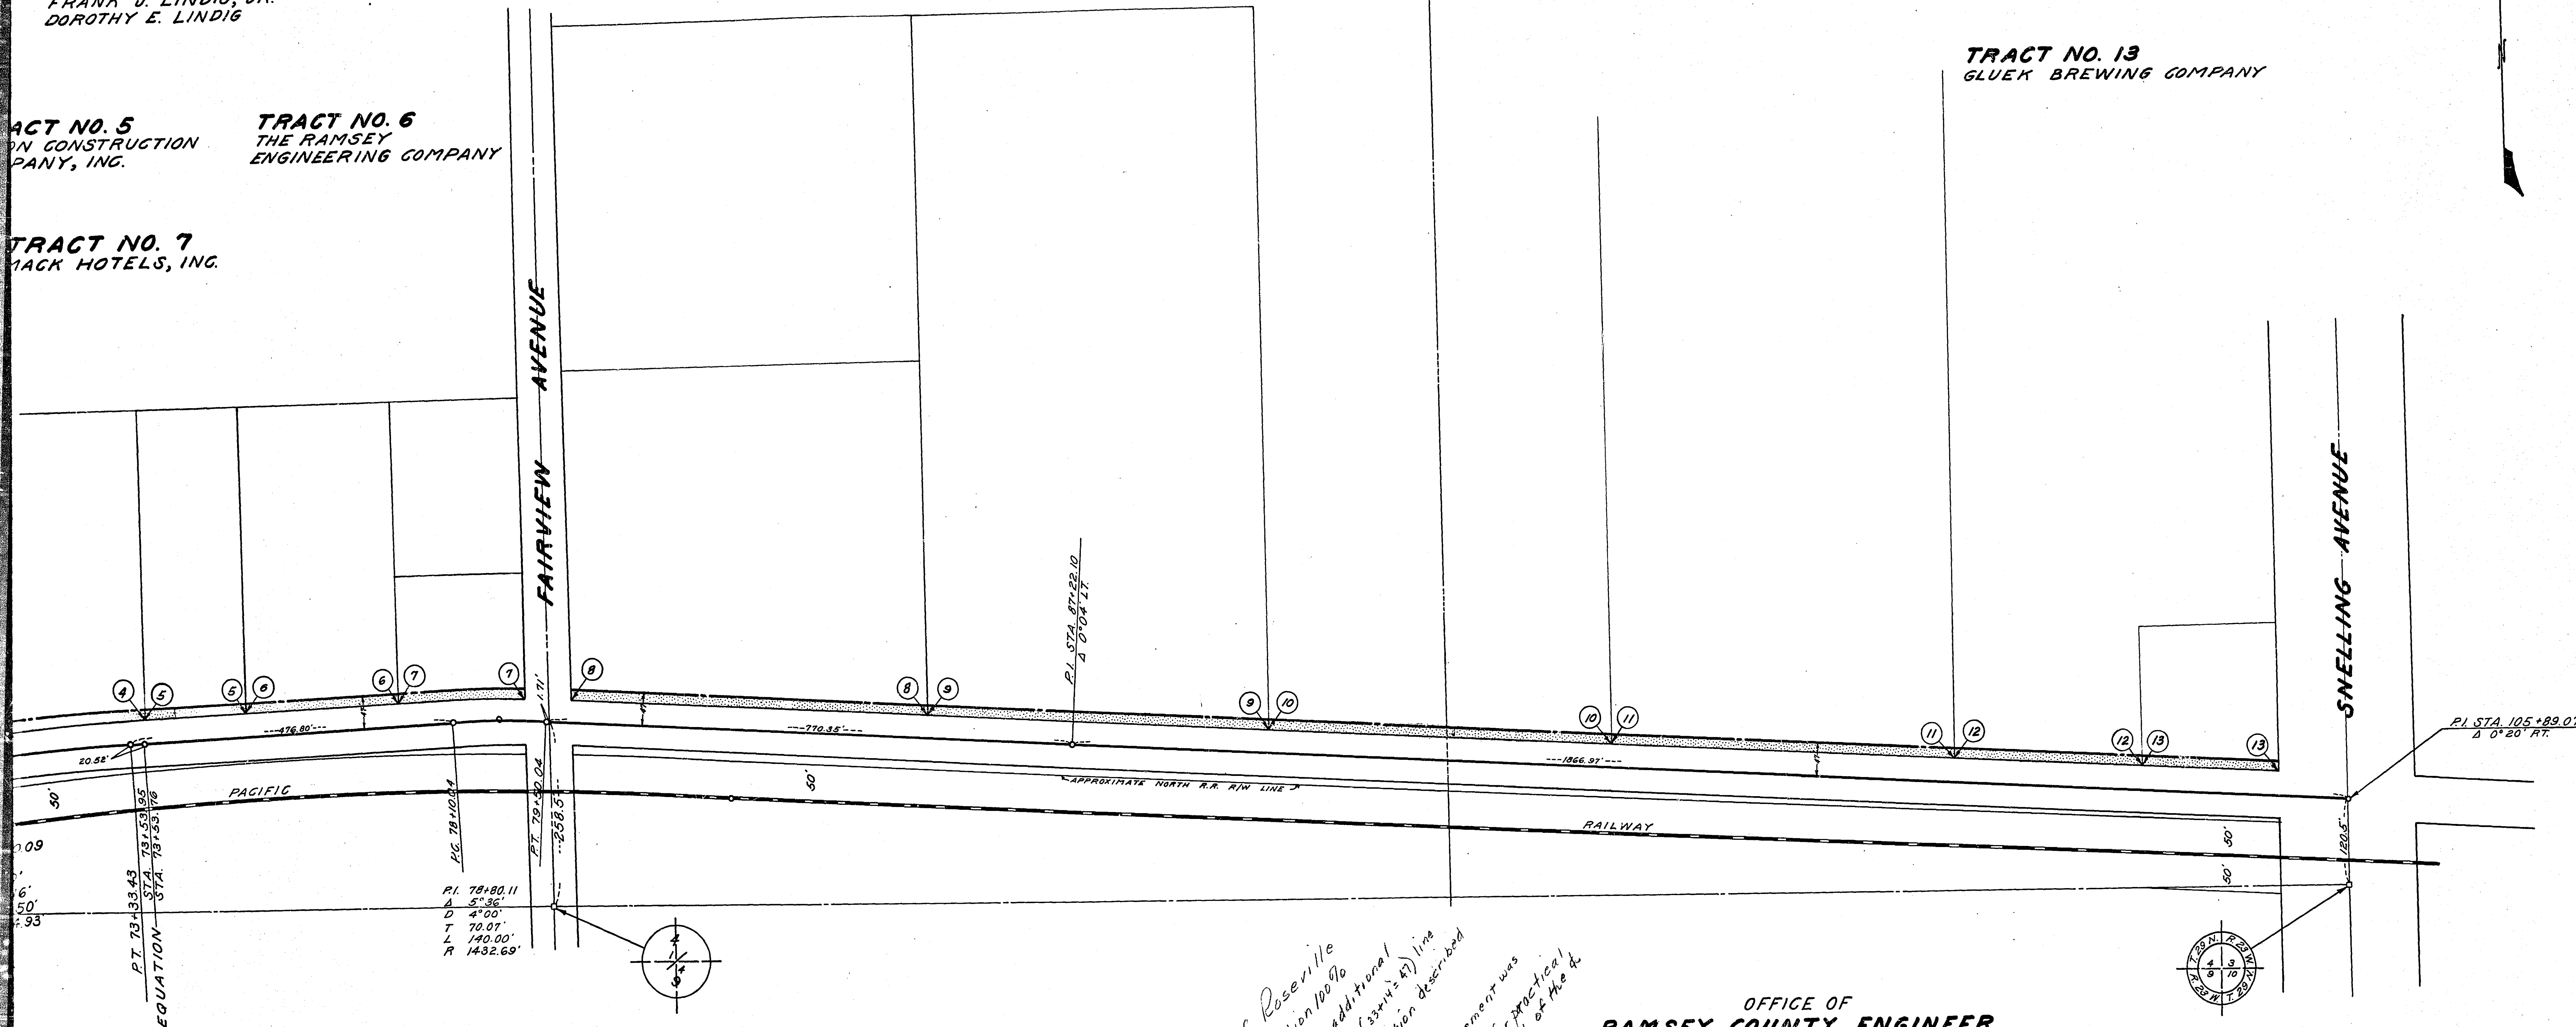

NOTE
The Village of Roseville did not follow this acquisition 100% along the North right of way (exit=4) line of Co. Rd. C, with no description in their transactions. In construction the & show so that for practical purposes the North R/W line is 40' north of the & of pavement.

OFFICE OF
RAMSEY COUNTY ENGINEER

RIGHT OF WAY MAP
COUNTY ROAD "C"
FROM CLEVELAND AVENUE TO SNELLING AVENUE
OCTOBER, 1962
SCALE: 1" = 100'

MICROFILMED
RAMSEY CO. ENGR.

F.A.S.(U) 62-623-03