
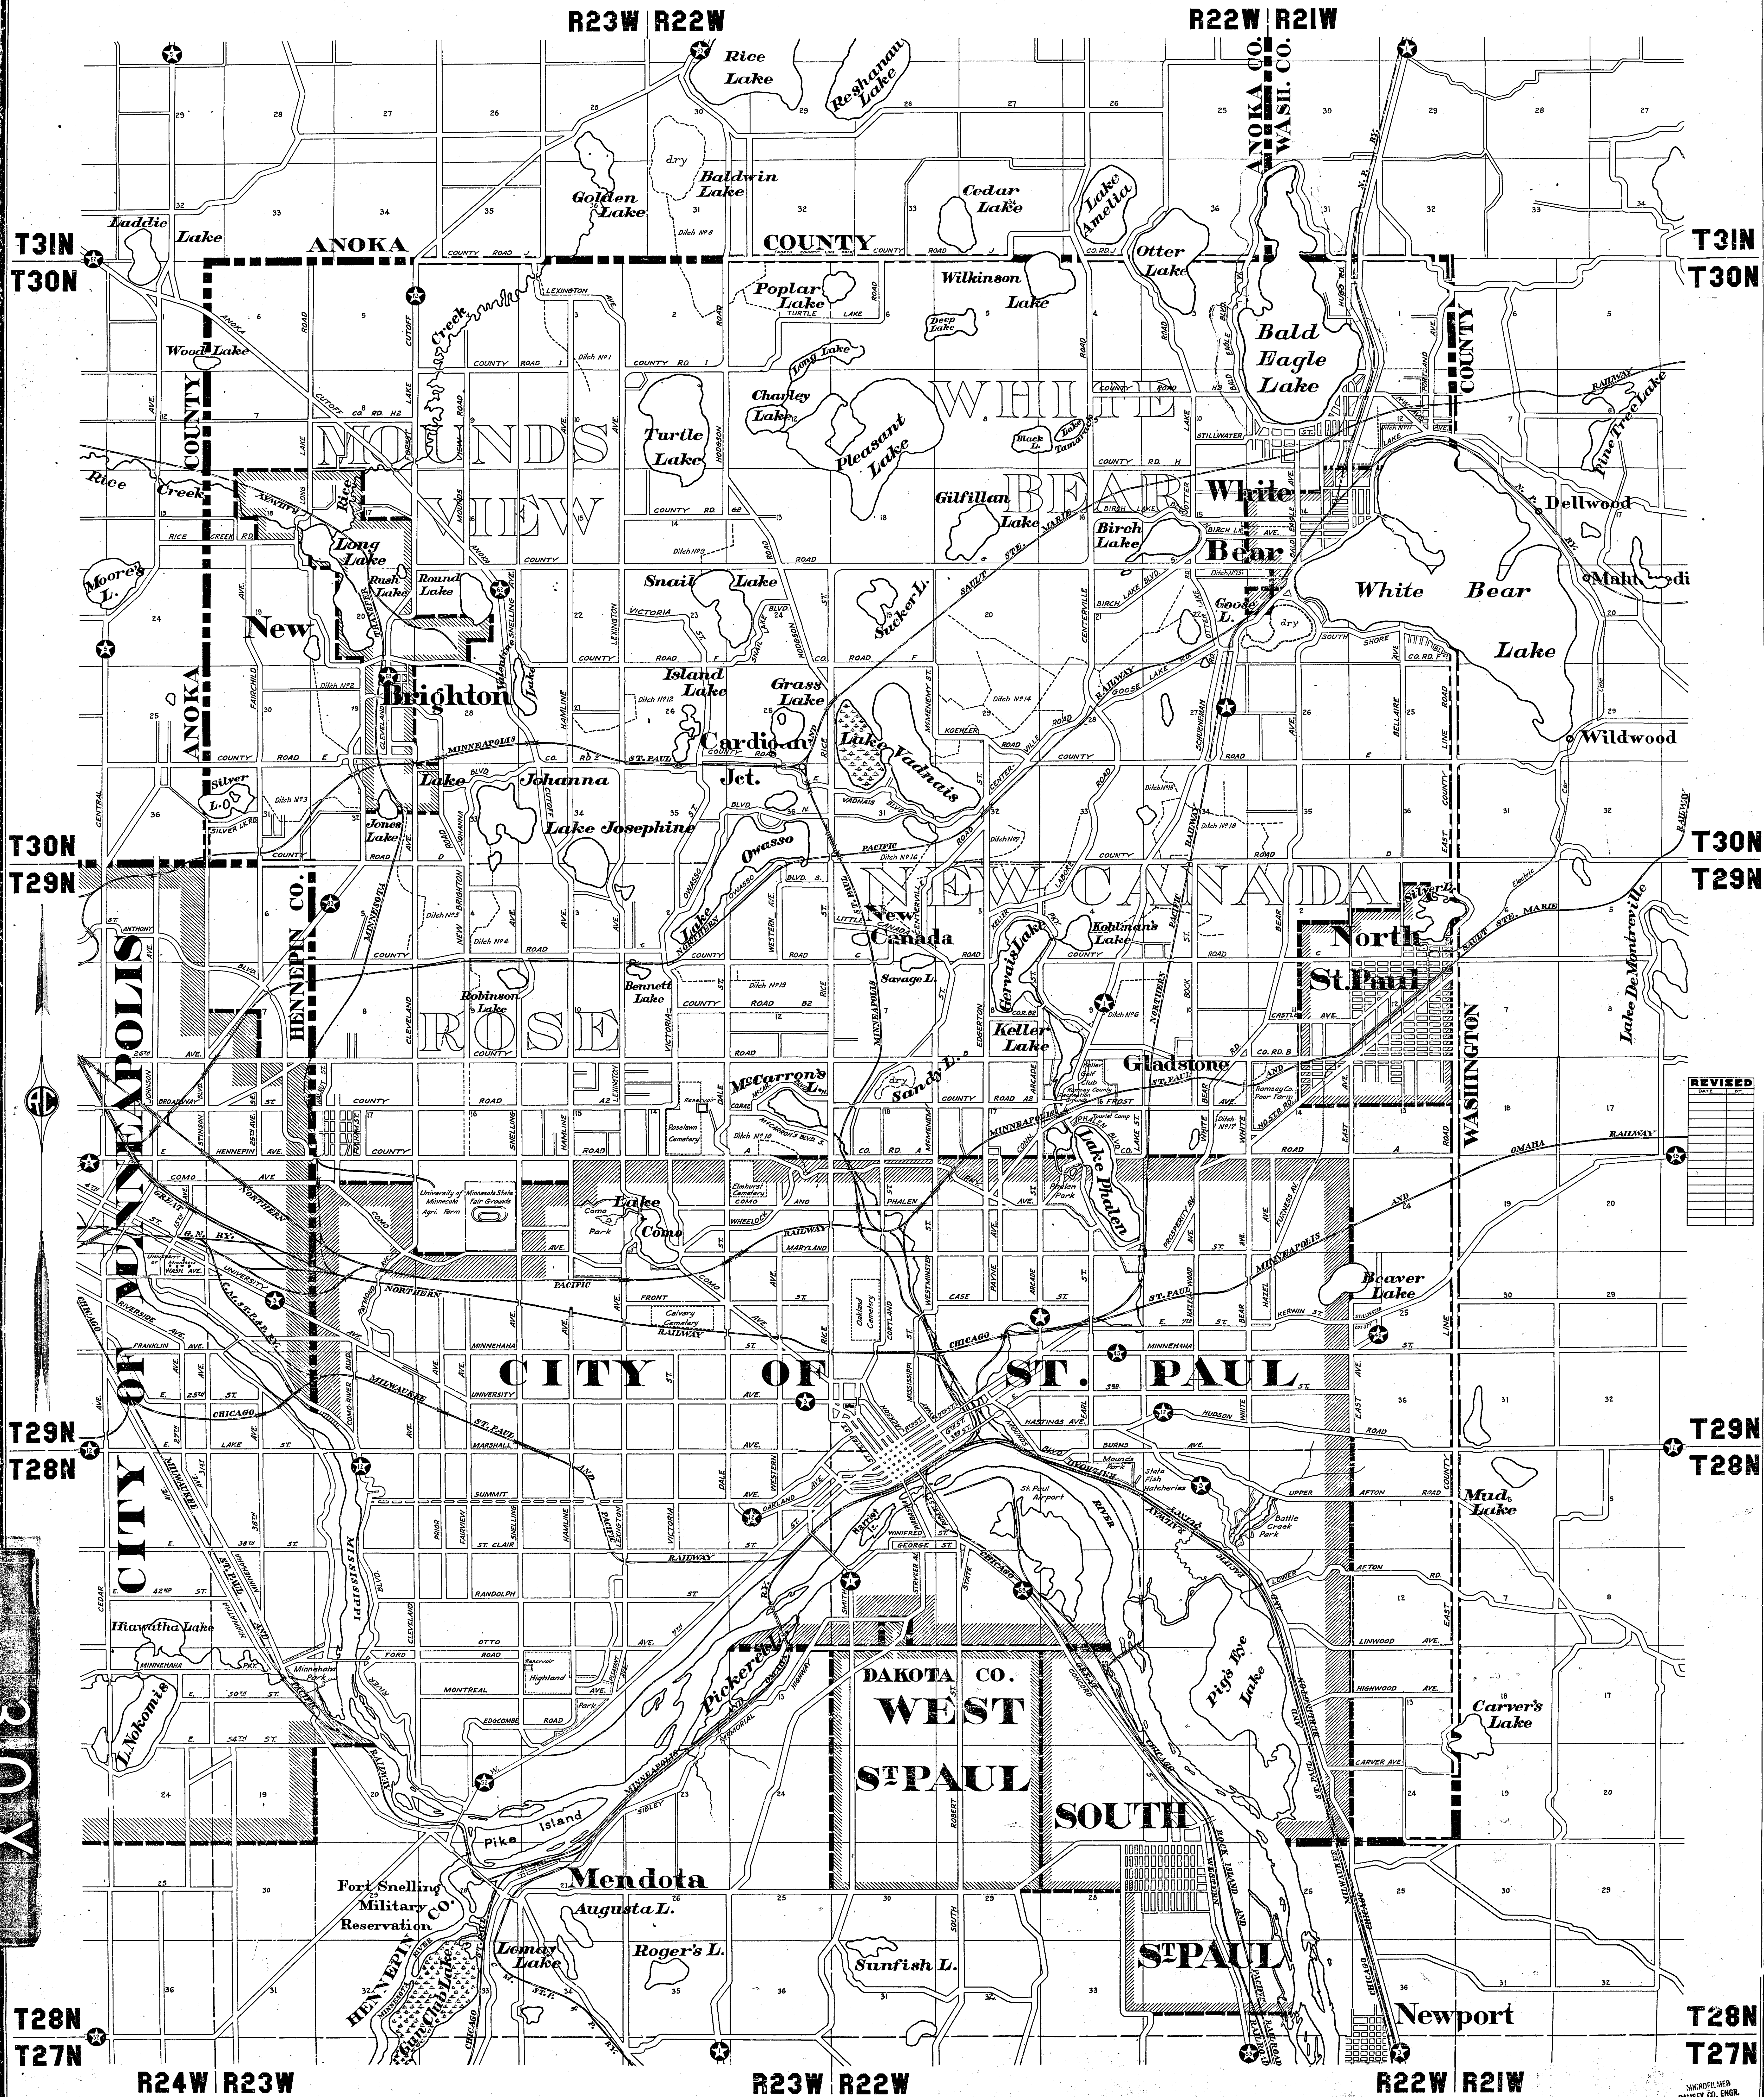


HIGHWAY MAP

OFFICE OF COUNTY ENGINEER,
ST. PAUL ~ MINN.

PAUL N. COATES
COUNTY ENGINEER.

JAN. 1, 1933


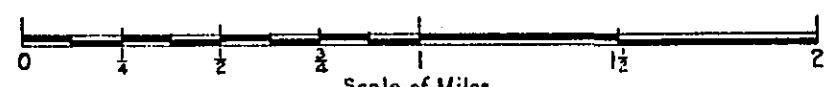


REVISED
DATE
BY
ST

NEWLY LAMINATED
RANSLEY CO. ENGR.

R.C.

MICROFILMED
RAMSEY CO. ENGR

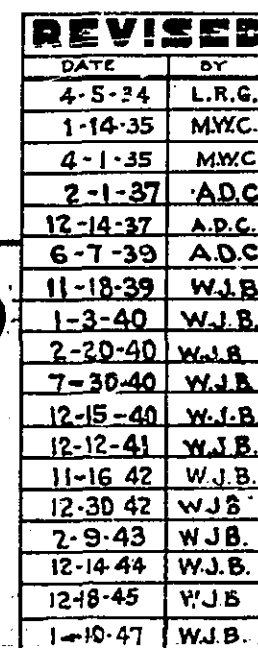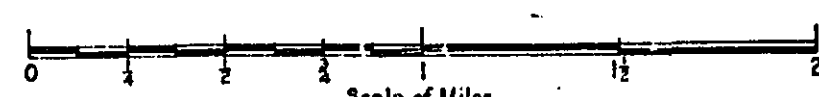

**MICROFILMED
RAMSEY CO. ENG**

RAMSEY COUNTY

HIGHWAY MAP

OFFICE OF COUNTY ENGINEER

ST. PAUL - MINN.

HARRY S. BRONSON
COUNTY ENGINEER

Scale of Miles

R23W R22W

R22W R21W

