

30X

LEGEND












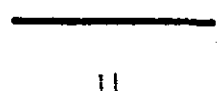
-  ASSUMED 1980 FREEWAY AND EXPRESSWAY SYSTEM
-  ASSUMED PRIMARY STREET SYSTEM
-  EXISTING STREETS TO BE RETAINED
-  PLATTED STREETS (UN-OPENED) OR SUGGESTED NEW STREETS
-  EXISTING AND PROPOSED PARK ROADWAYS AND PARKWAYS
-  BRIDGES
-  ASSUMED 1980 NON-RESIDENTIAL LAND USE (FROM LAND USE PLAN)
-  ASSUMED 1980 RESIDENTIAL LAND USE
-  EXISTING AND PROPOSED PROPERTY LINES OF PUBLIC SITES
-  EXISTING SITES TO BE ABANDONED
-  SCHEMATIC SYMBOL FOR FORESTED AREAS IN LARGE PARKS

CHART 4 PROPOSED RECREATION PLAN FOR STUDY AREA (THAT PART OF COUNTY SOUTH OF T.H. 12 AND EAST OF T.H. 61) RAMSEY COUNTY, 1960

-  RESIDENTIAL LAND USE (PLAN)
-  NON-RESIDENTIAL LAND USE (PLAN)
-  AREA FOR PUBLIC RECREATION USE (PLAN)
-  SCHEMATIC SYMBOL FOR FOREST AREA
-  EXISTING STREETS (OPEN)
-  STREETS (PLATTED OR PLANNED)
-  PARK ROADWAY (PLAN)
-  ASSUMED FREEWAYS AND EXPRESSWAYS
-  ELEMENTARY SCHOOL (EXISTING OR PLANNED)
-  JUNIOR HIGH SCHOOL (EXISTING OR PLANNED)
-  NEIGHBORHOOD PLAYGROUND (EXISTING OR PLANNED)
-  ATHLETIC FIELD (EXISTING OR PLANNED)
-  PARCEL NUMBER (SEE TEXT)

1 NORTH 1/4 1/2 MILE ST. PAUL PLANNING BOARD MARCH, 1960

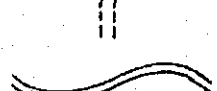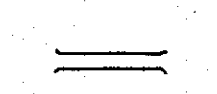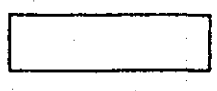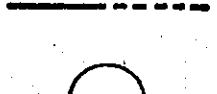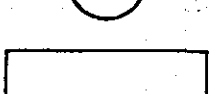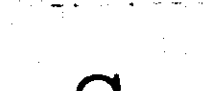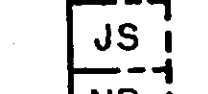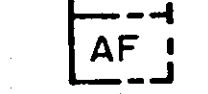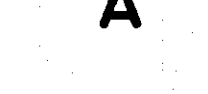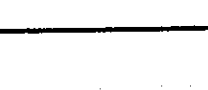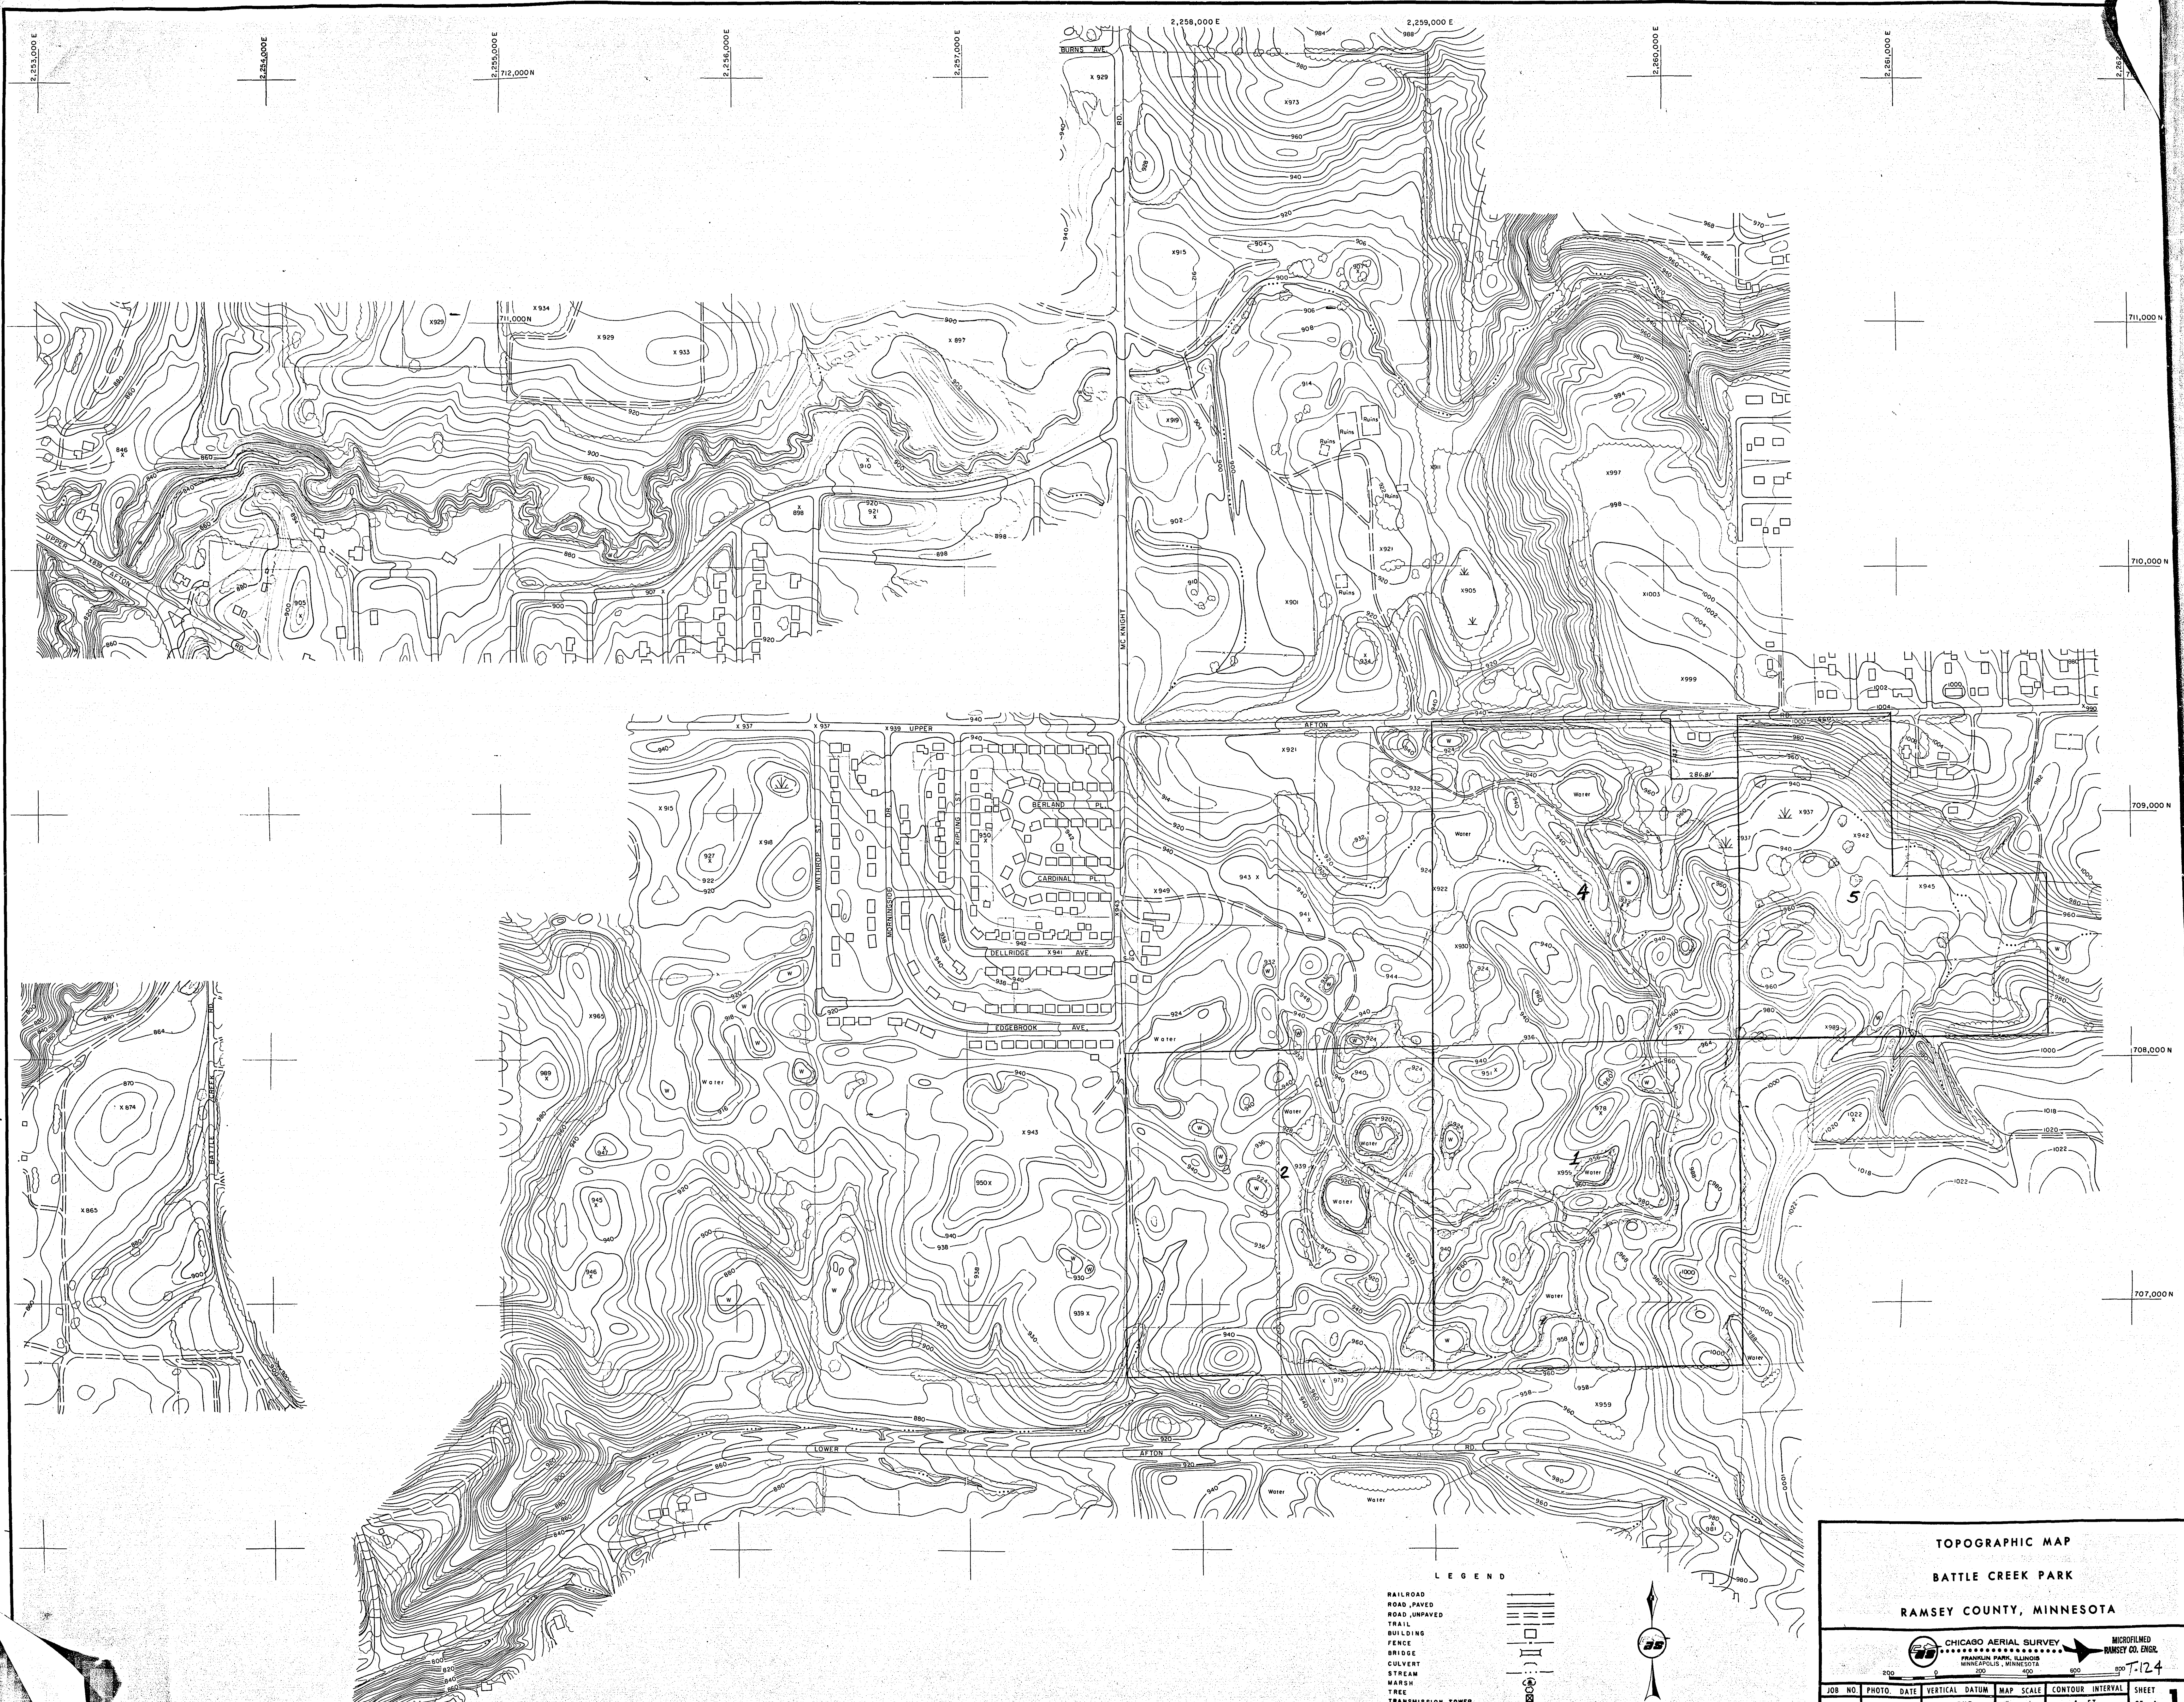


TOPOGRAPHIC MAP
BATTLE CREEK PARK
RAMSEY COUNTY, MINNESOTA

CHICAGO AERIAL SURVEY
MINNEAPOLIS, MINNESOTA

RAMSEY CO. ENGR.
MINNEAPOLIS, MINNESOTA

JOB NO. 6082 PHOTO. DATE APRIL 1964 VERTICAL DATUM CLIENT MAP SCALE 1"=200' CONTOUR INTERVAL 2' SUPP. SHEET 1 OF 1


BATTLE CREEK PARK

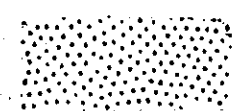 PRESENT CITY PROPERTY
 PRESENT COUNTY PROPERTY

Aug. 1965

MICROFILMED
RAMSEY CO. ENGR.

T-124

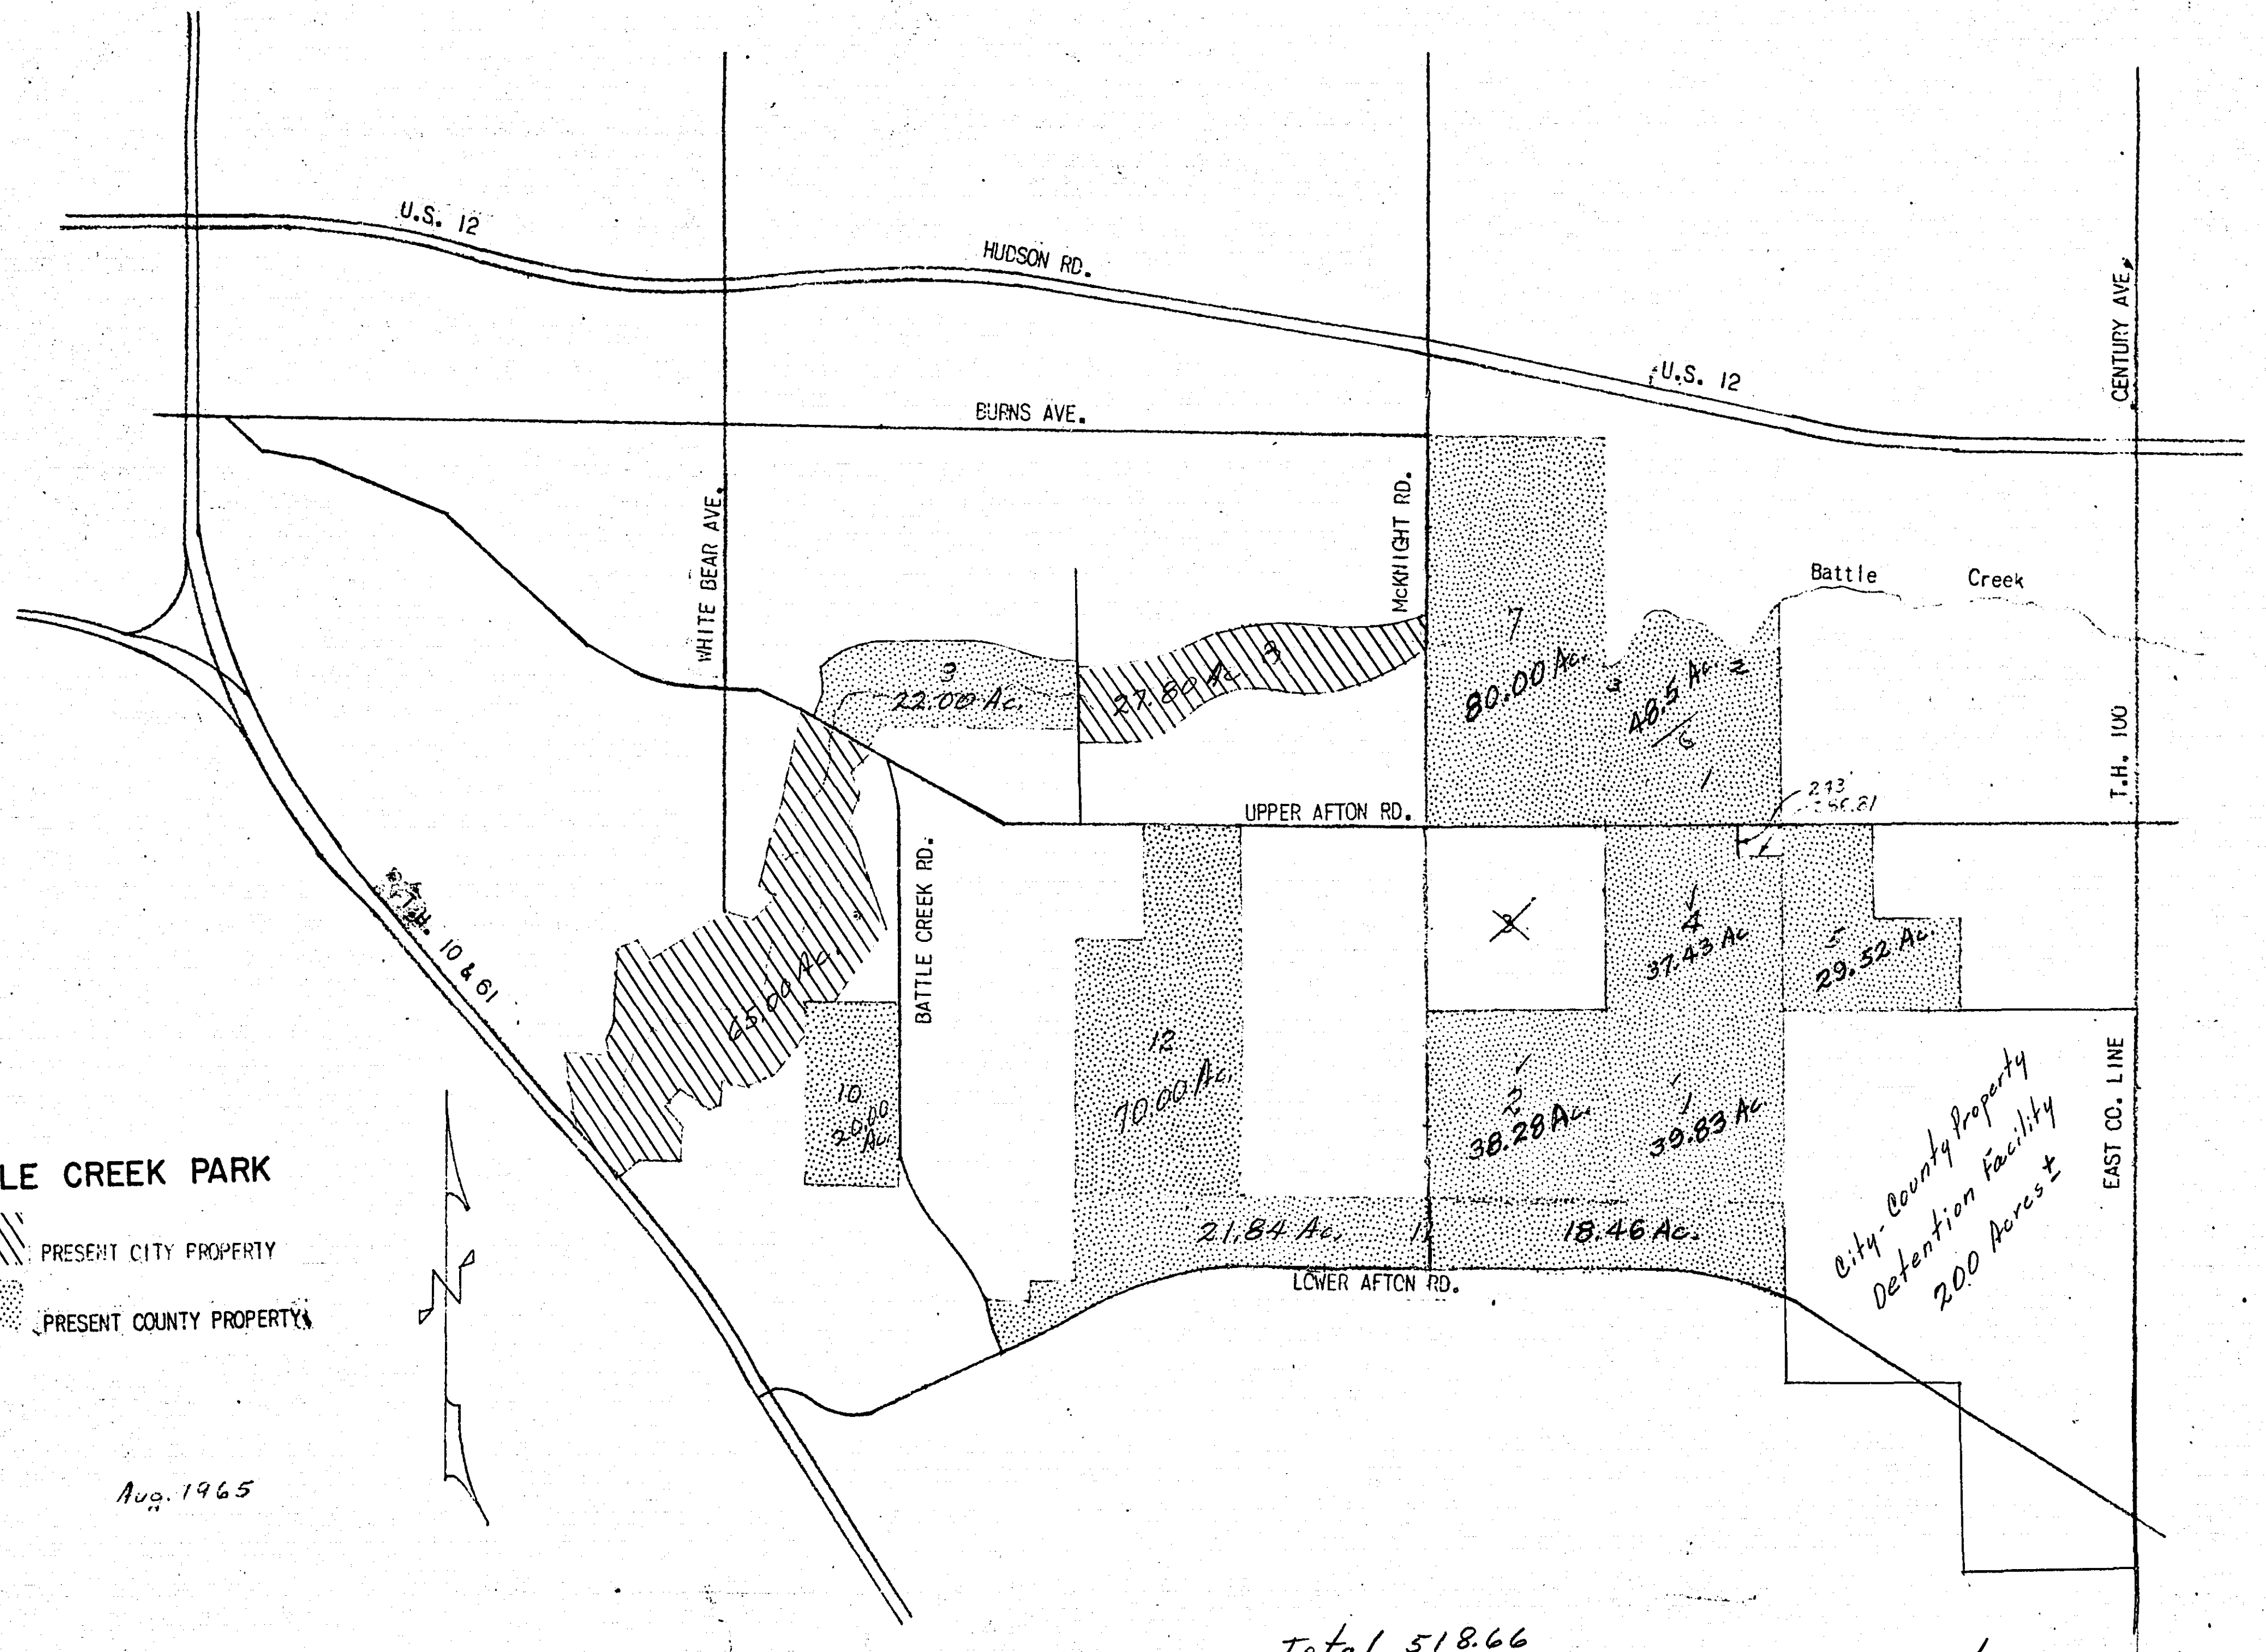


Total 518.66

File Copy!

N.W. 1/4, Sec. 2-28-22

OFFICE OF
RAMSEY COUNTY ENGINEER
 HARRY S. BRONSON
 LAND ACQUISITION
BATTLE CREEK PARK
 NOVEMBER 1959 SCALE: 1"=100'

PARCEL	2B	1.12 ACRES	
PARCEL	2C	14.31 ACRES	14.56
PARCEL	2D	4.76 ACRES	
PARCEL	2E	0.83 ACRES	
		21.27 ACRES	

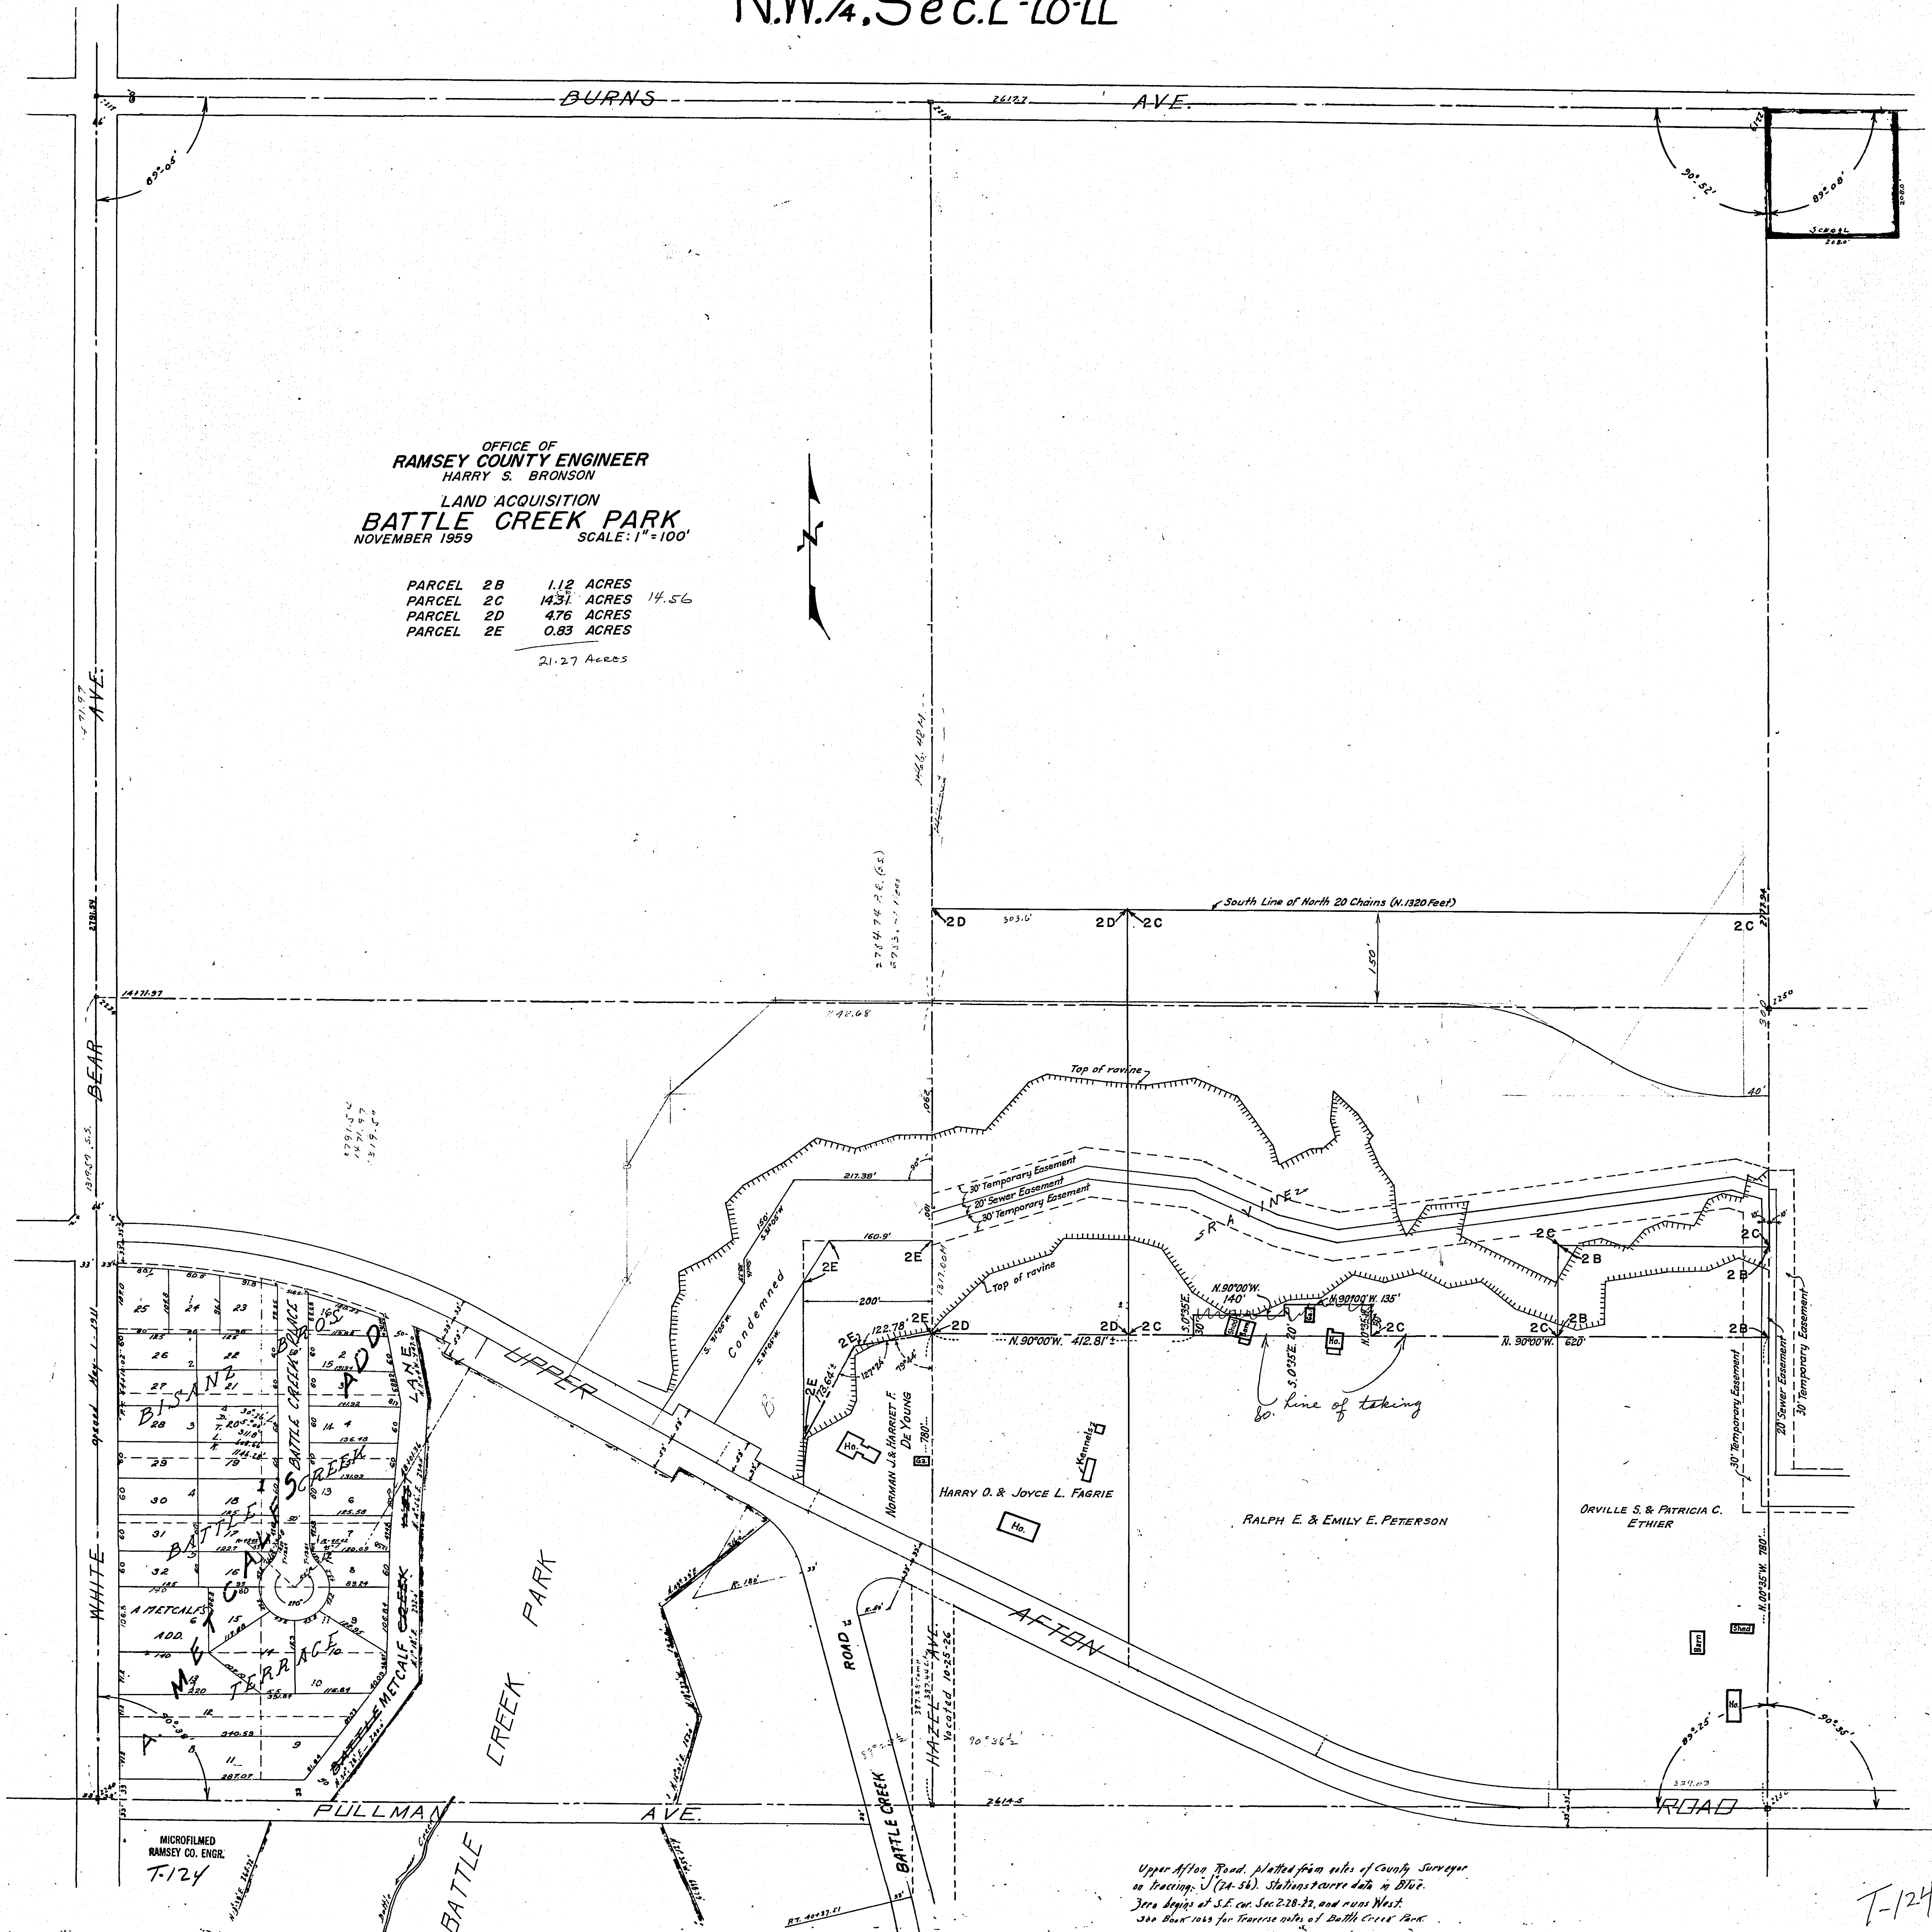

Upper Afton Road, Platted from notes of County Surveyor
 on tracing (24-56). Station curve data in Blue.
 Zero begins at S.E. cor. Sec. 28-22, and runs West.
 See Book 1063 for Traverse notes of Battle Creek Park.

T-124

N.W. 1/4 SECTION 2, T.28 N., R.22 W.



