
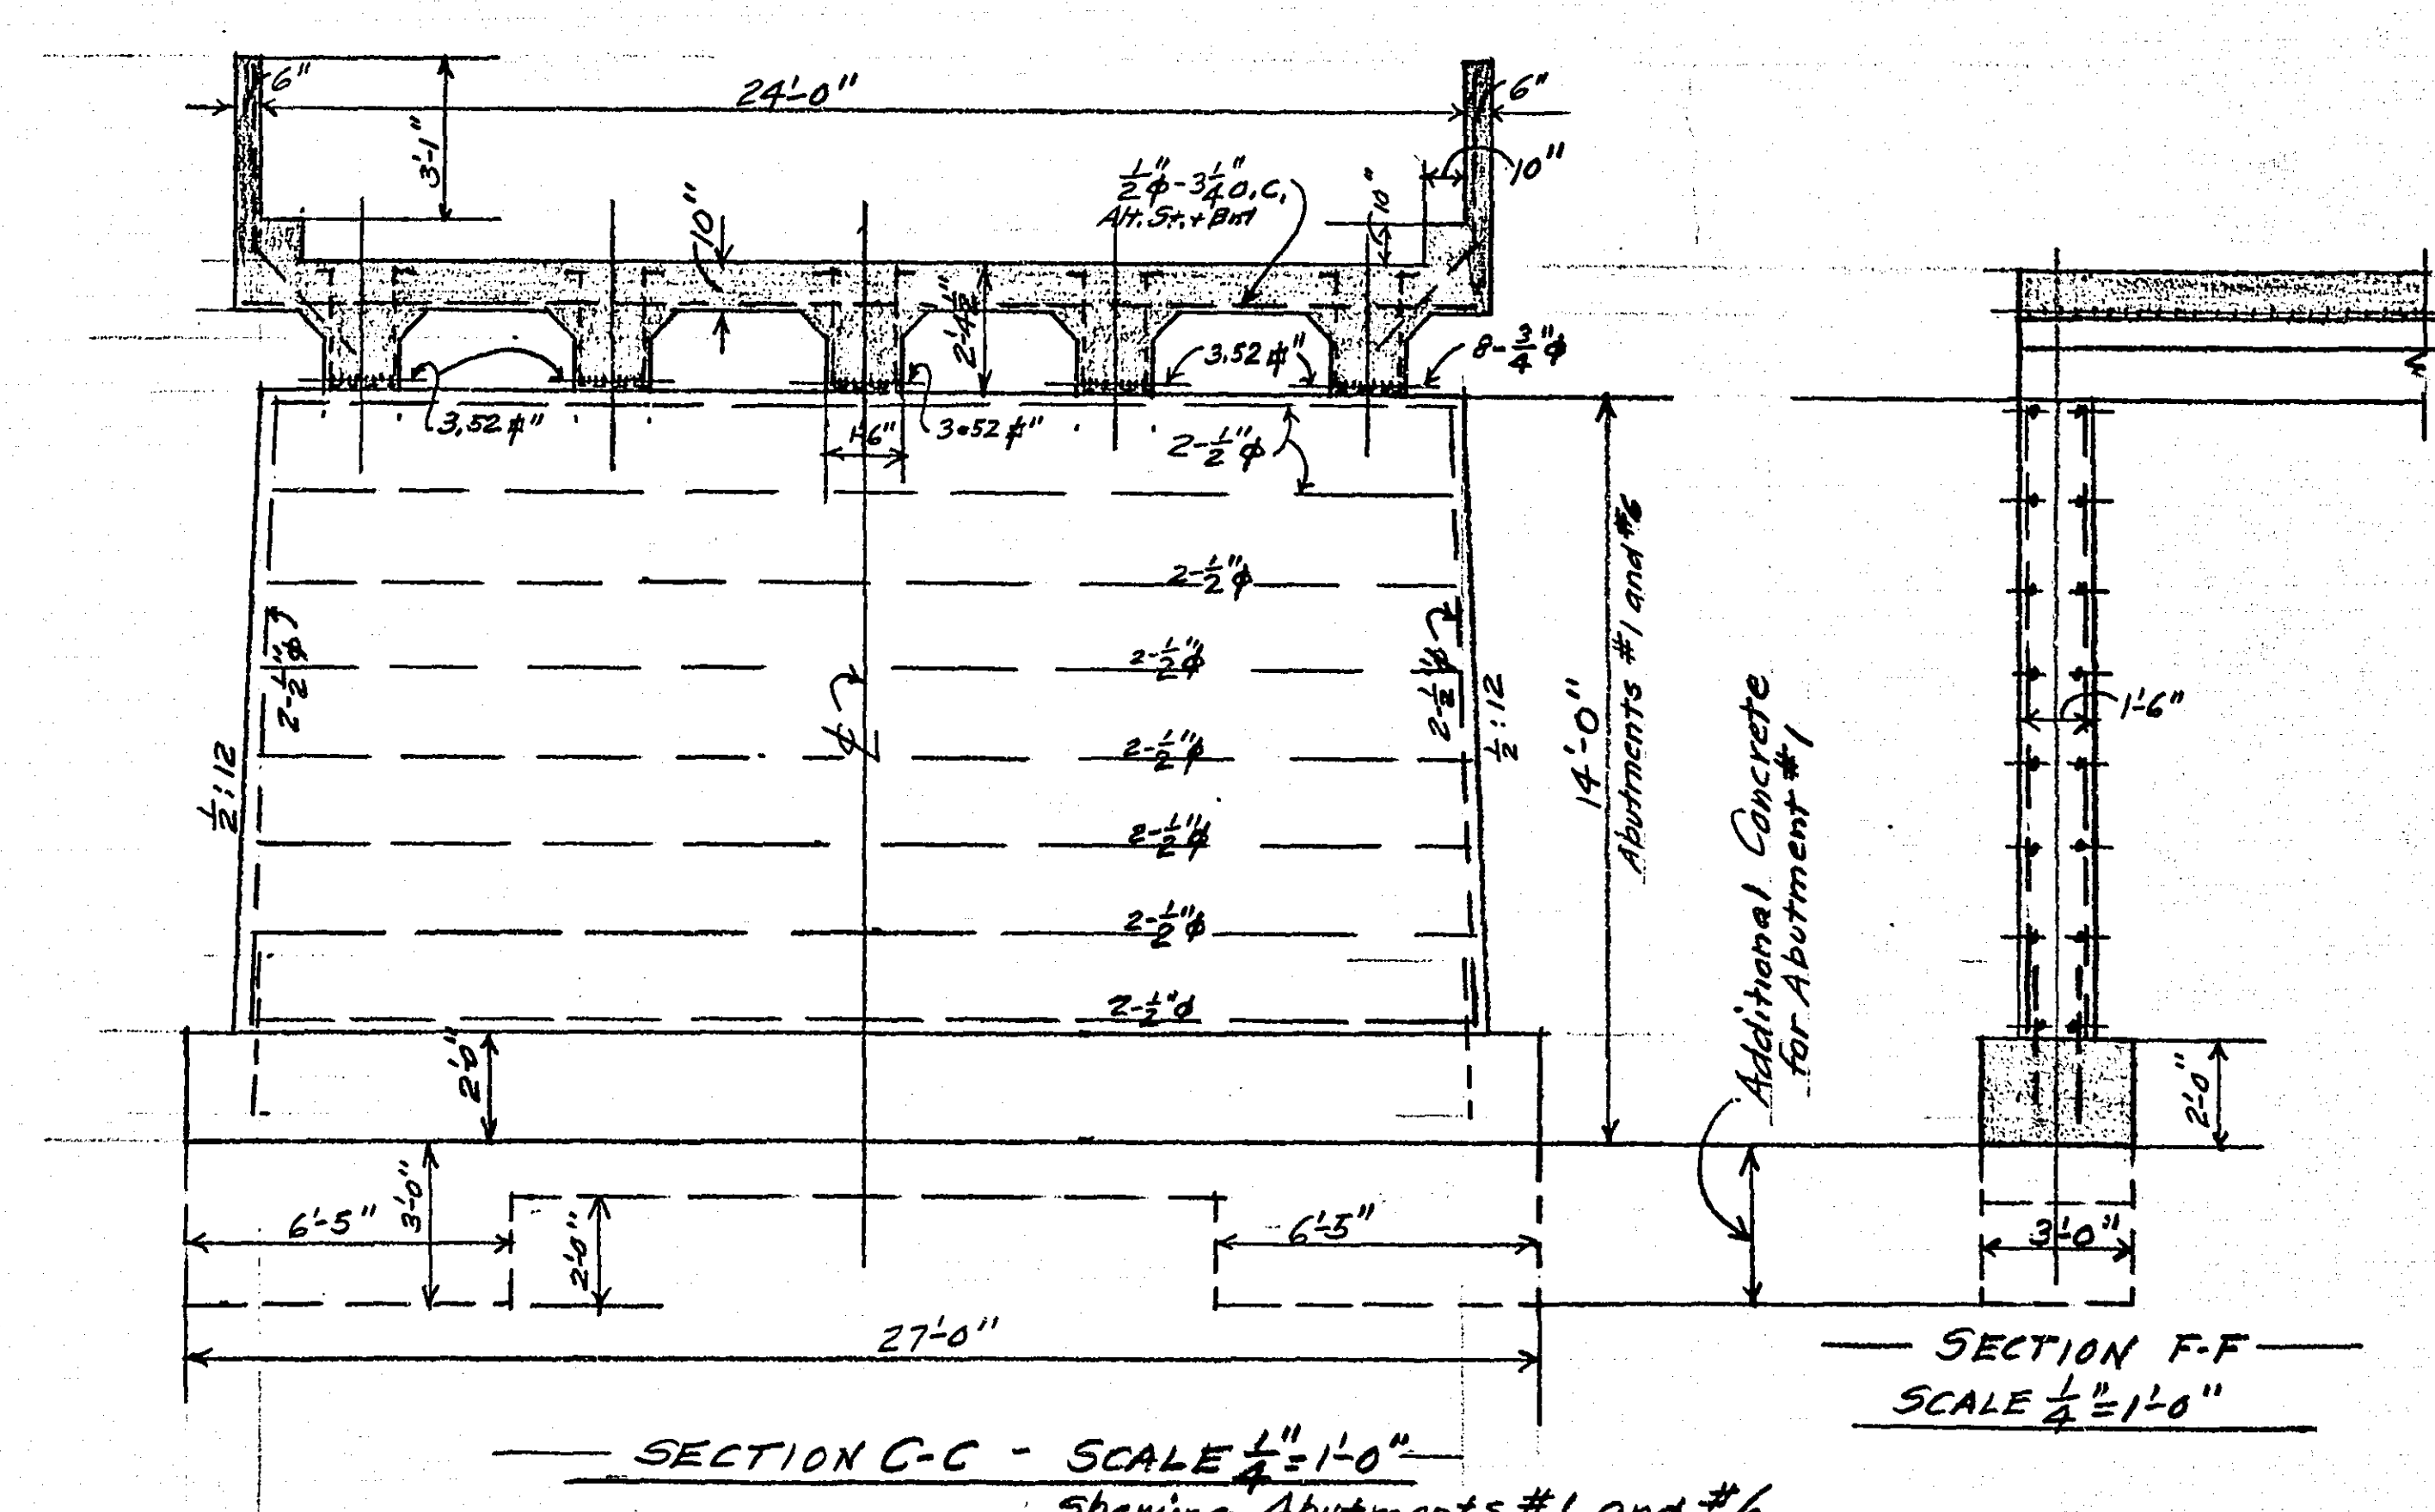
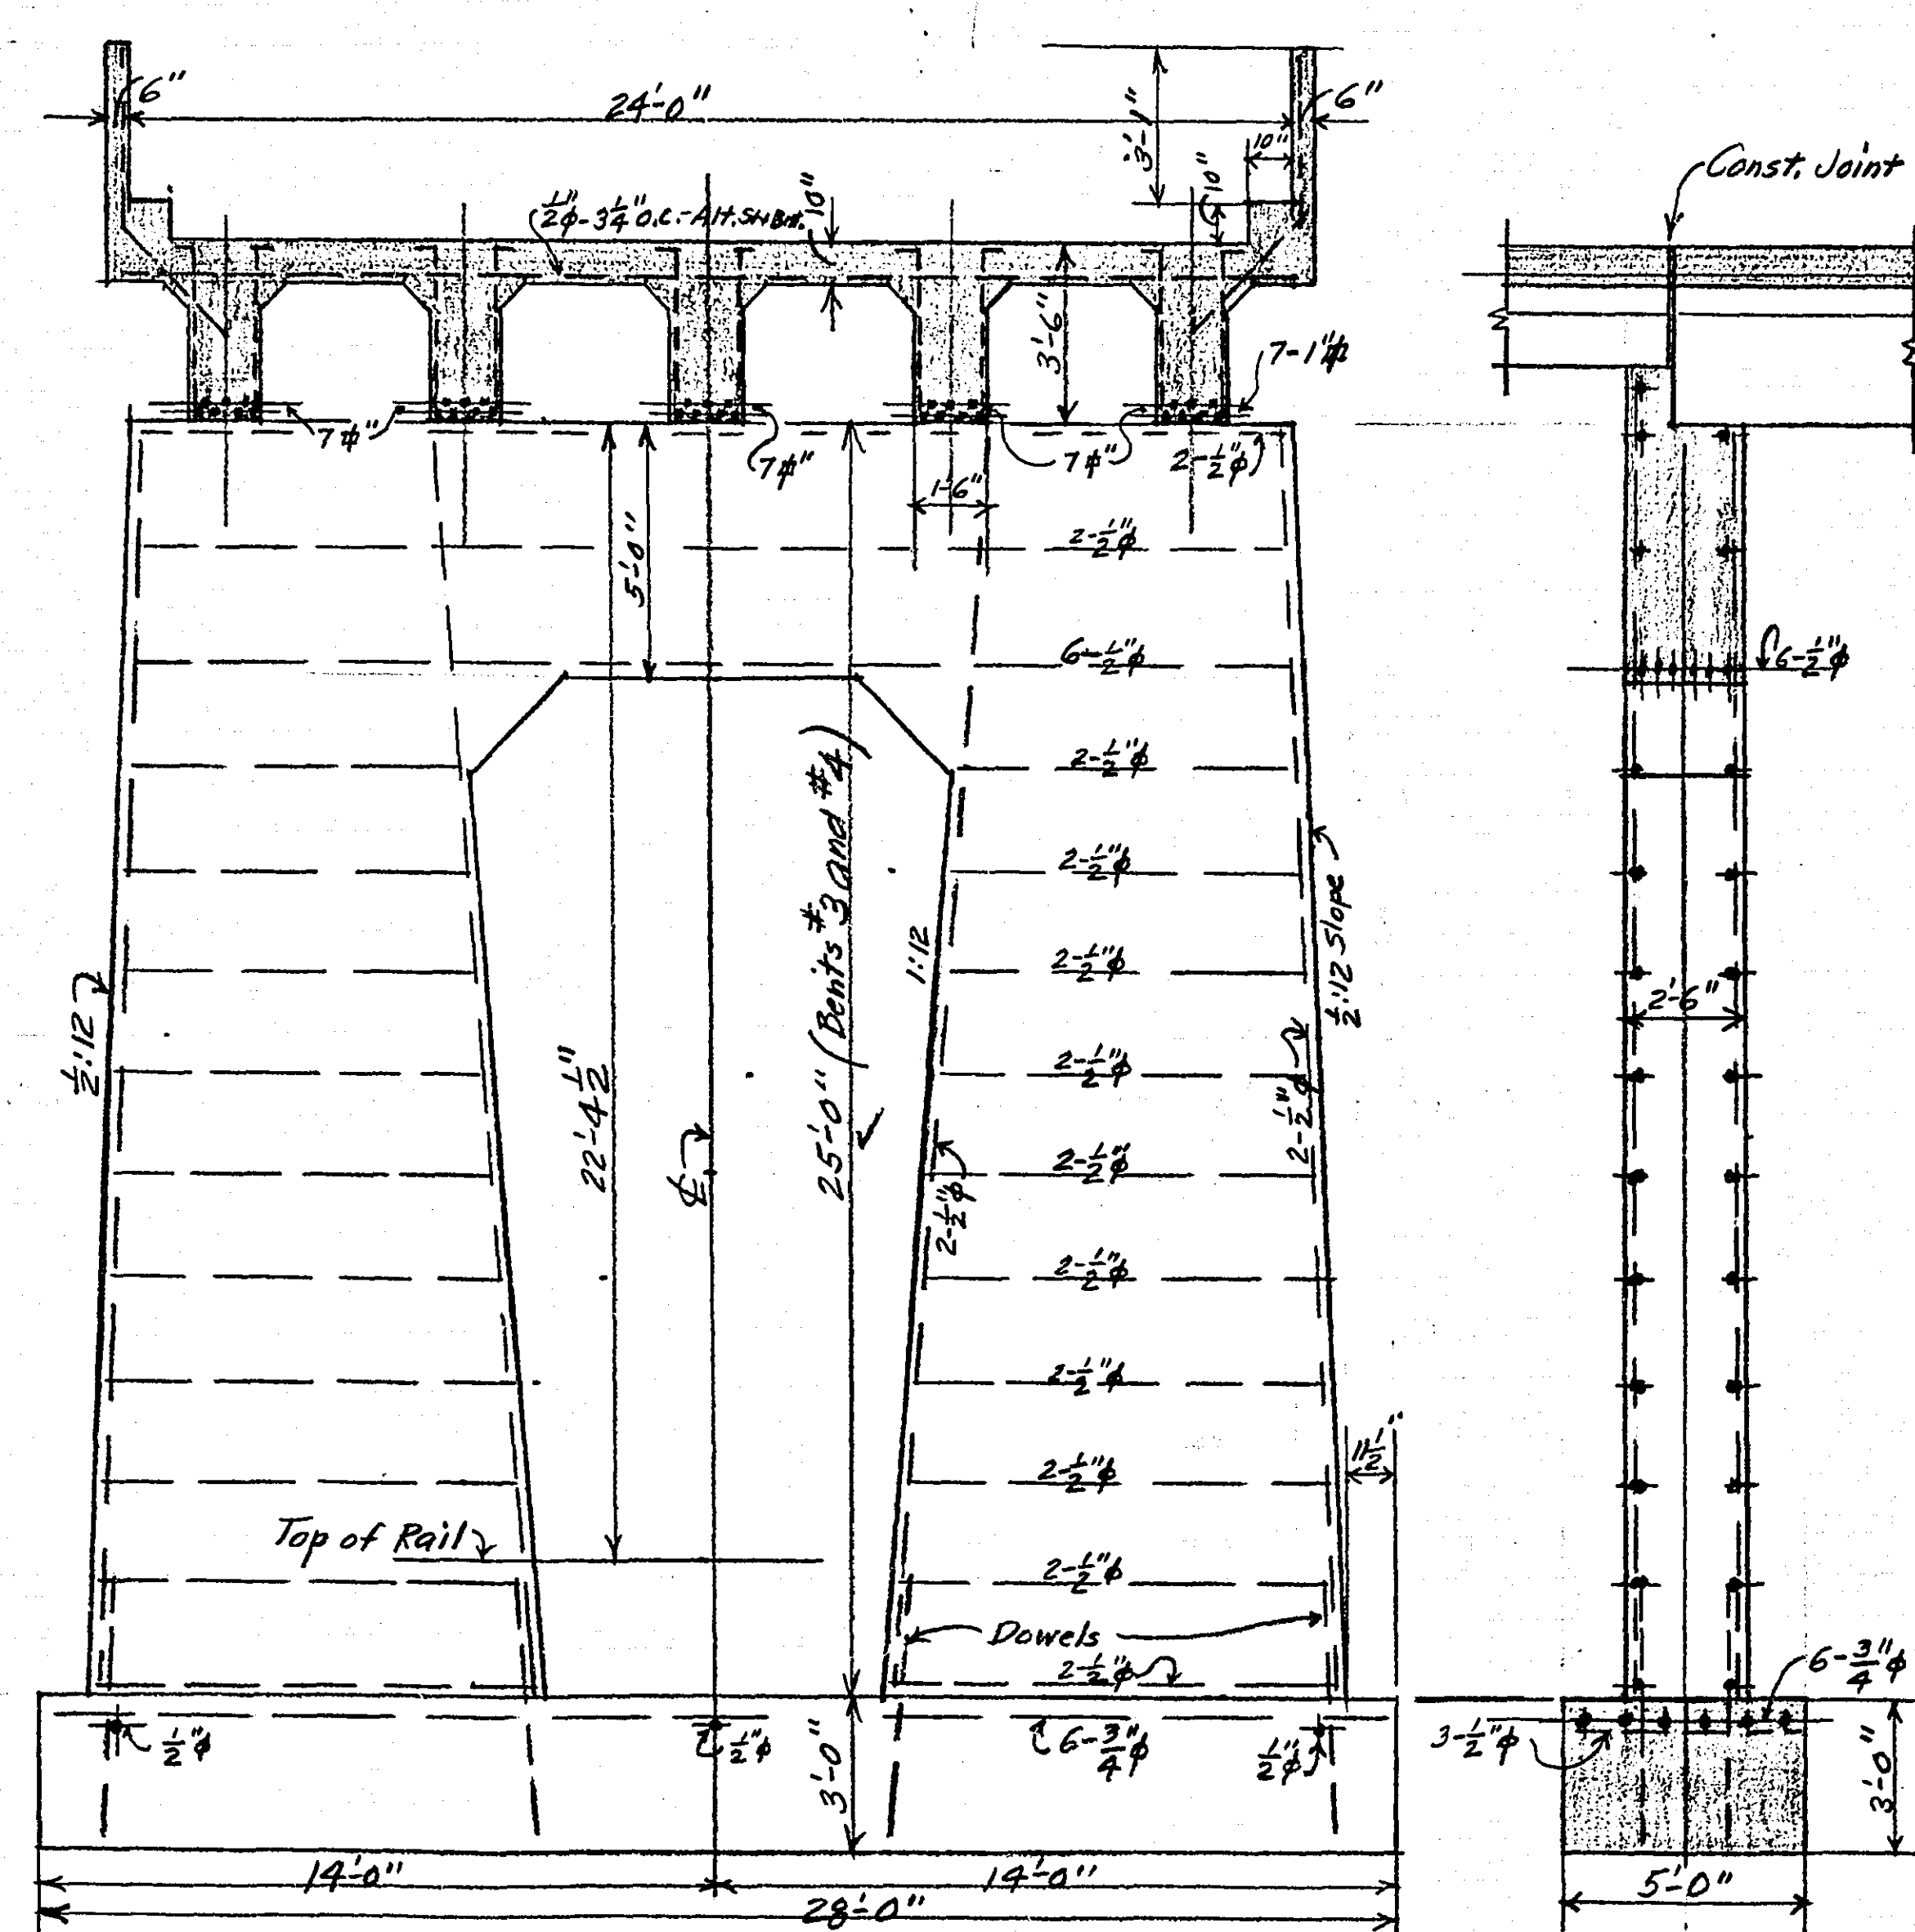
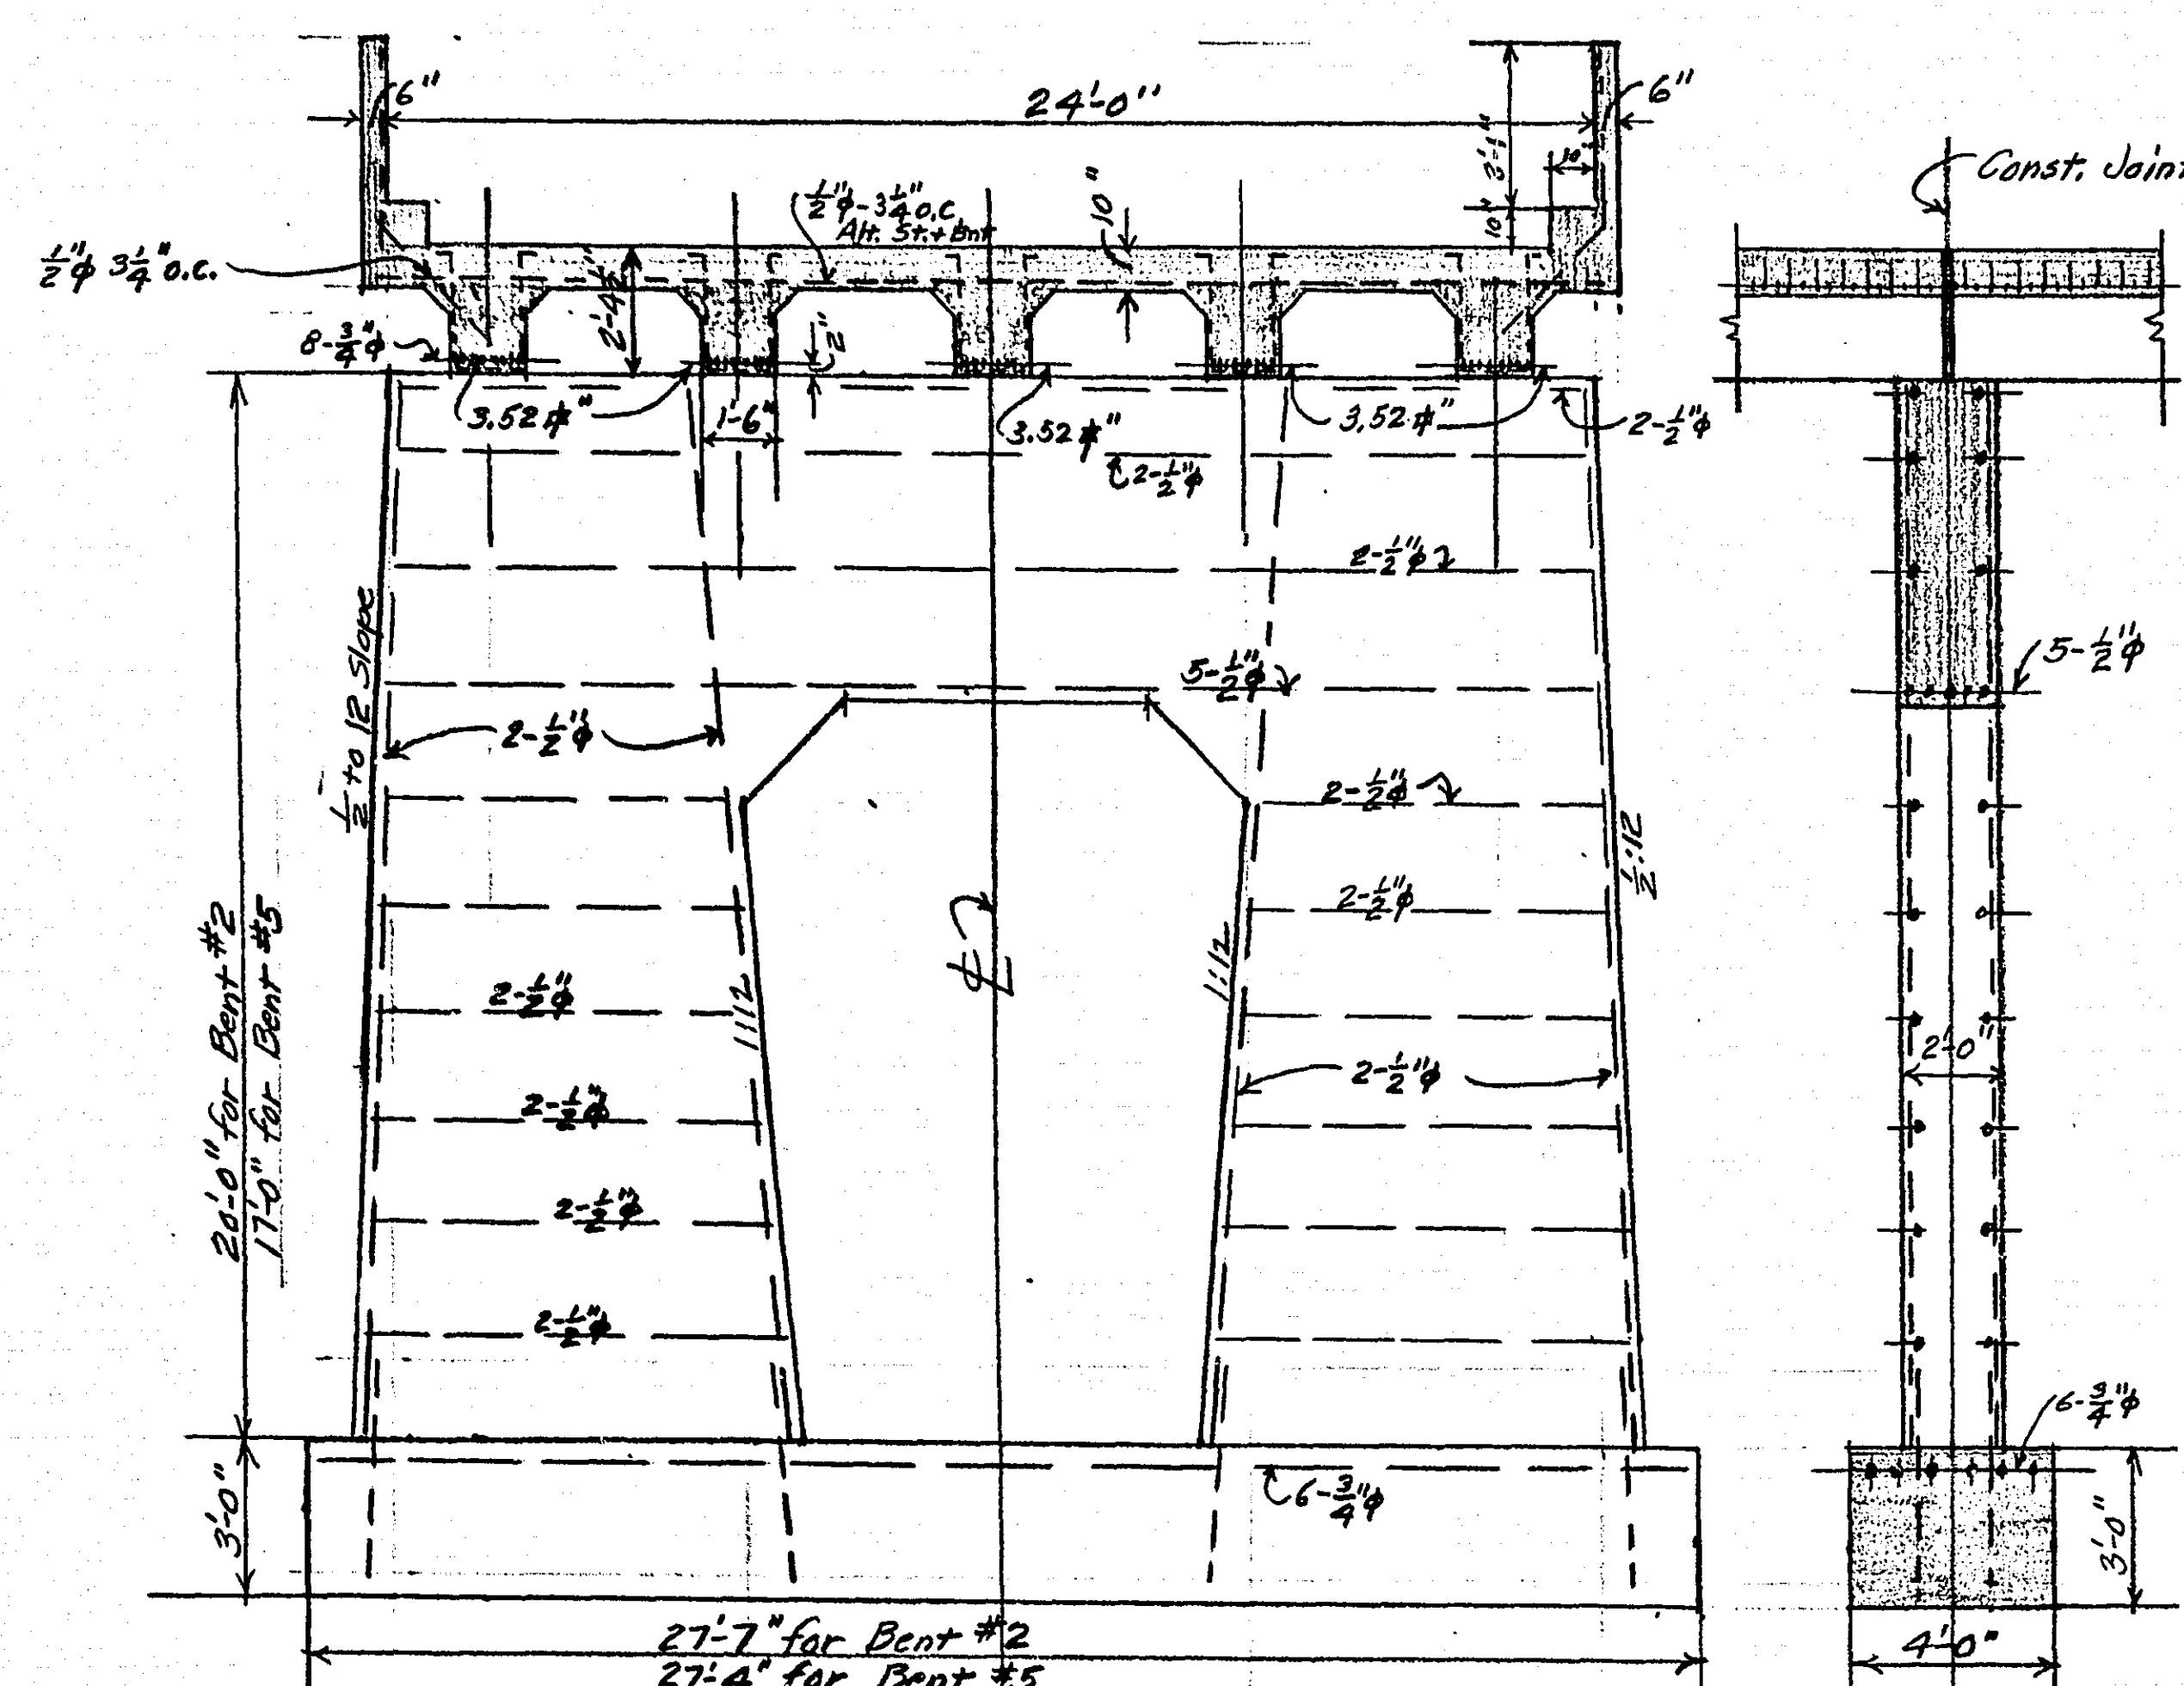


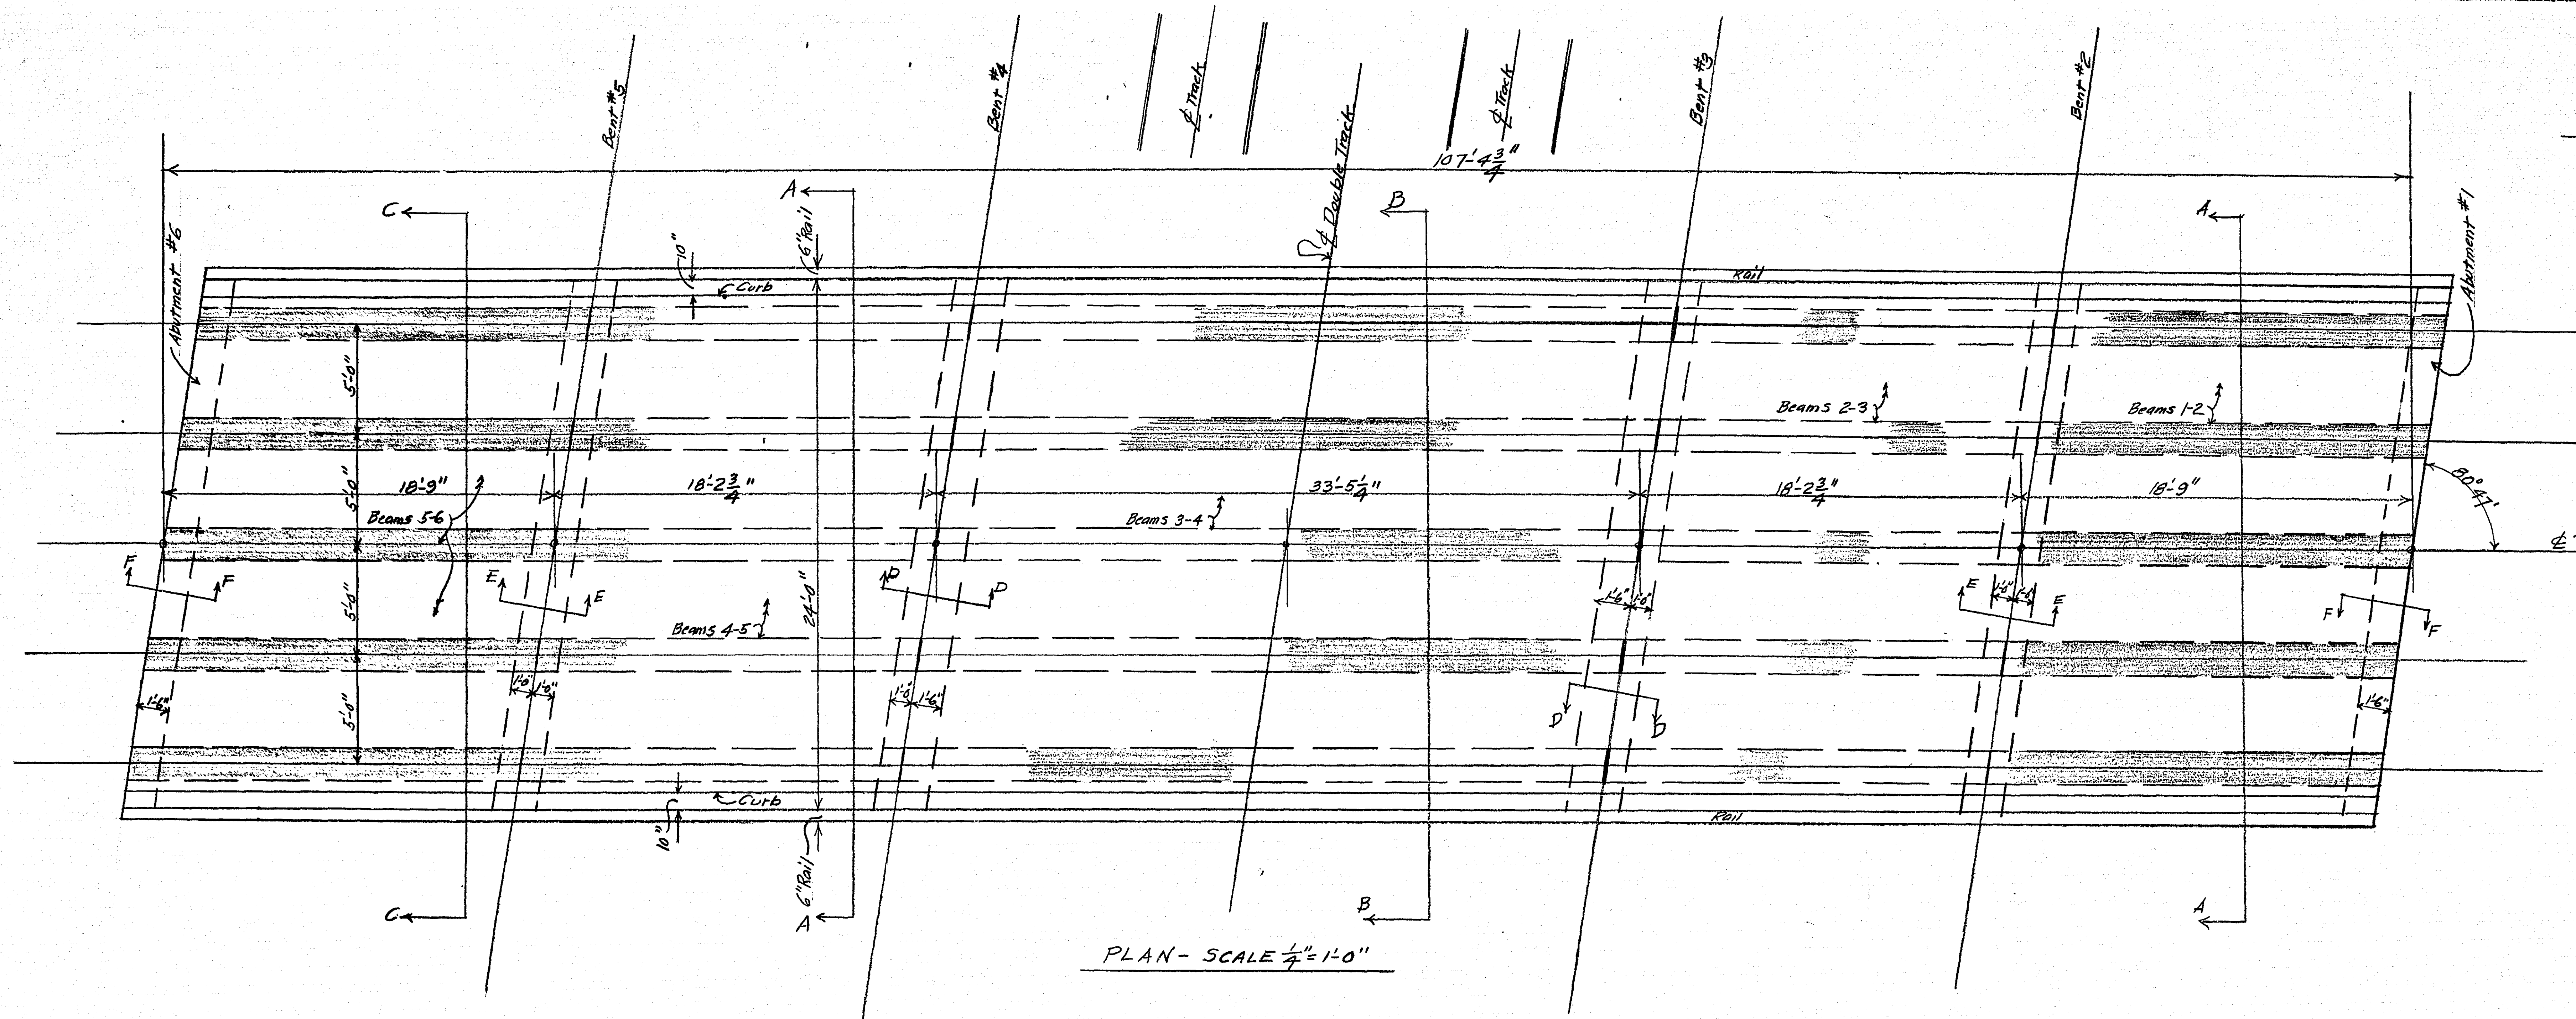

Note: Bridge covered by plans, sections and details on this sheet was designed by the Bridge Engineer's Office of the Northern Pacific Railway in the year 1919 and built in the same year. Thus as of 1958 it is forty (40) years old. Examinations made in 1958 show it to be in perfect condition and suitable for many more years of service.

Note re Reinforcement:
Beams 1-2, 2-3, 4-5 and 5-6. 20 beams thus. Reinforced by 8-3/4" bars, 4 of which are straight and 4 of which are bent up for diagonal tension. 14-3/8" stirrups. 18"x28 1/2" Tee Beams. Simple Span.
Beams 3-4. 5 Beams thus. Reinforced by 7-1" bars, 4 of which are straight and 3 of which are bent up for diagonal tension. 22-3/8" stirrups. 16"x42" Tee Beams. Simple Span.
Slab 10" thick reinforced across beams with 3/8" bars 3 1/2" o.c. alt. straight and bent up at quarter points between beams. 1/2" temperature bars running lengthwise, parallel to beams.
Footings, Bents and Abutments. See Details on this Sheet.

Note re Concrete:
For Footings and Bents, 1-3-5 Mix.
For Beams and Slabs, 1-2-4 Mix.

Basis of Calculations: 20 Ton Tractor with 1/2 load on rear axle. Axles 10'-0" center to center or a live load of 100* per ft. No impact.
(1913)
Steel in tension 16000* per ft.
Concrete in Compression 600* per ft.
" " Bearing 400* per ft.
" " Shear 50* per ft.

Note: All Plans, Sections and Details on this Sheet show Present Construction of Bridge as of the Year 1958.

HIGHWAY BRIDGE
CARRYING COUNTY ROAD "C" OVER DOUBLE
TRACKAGE OF THE NORTHERN PACIFIC
RAILWAY, 7 MILE EAST OF S.T.H. #61.
Dec. 1958.
Office of County Engineer.
- Raymond Brown
County Engineer, Del.

