



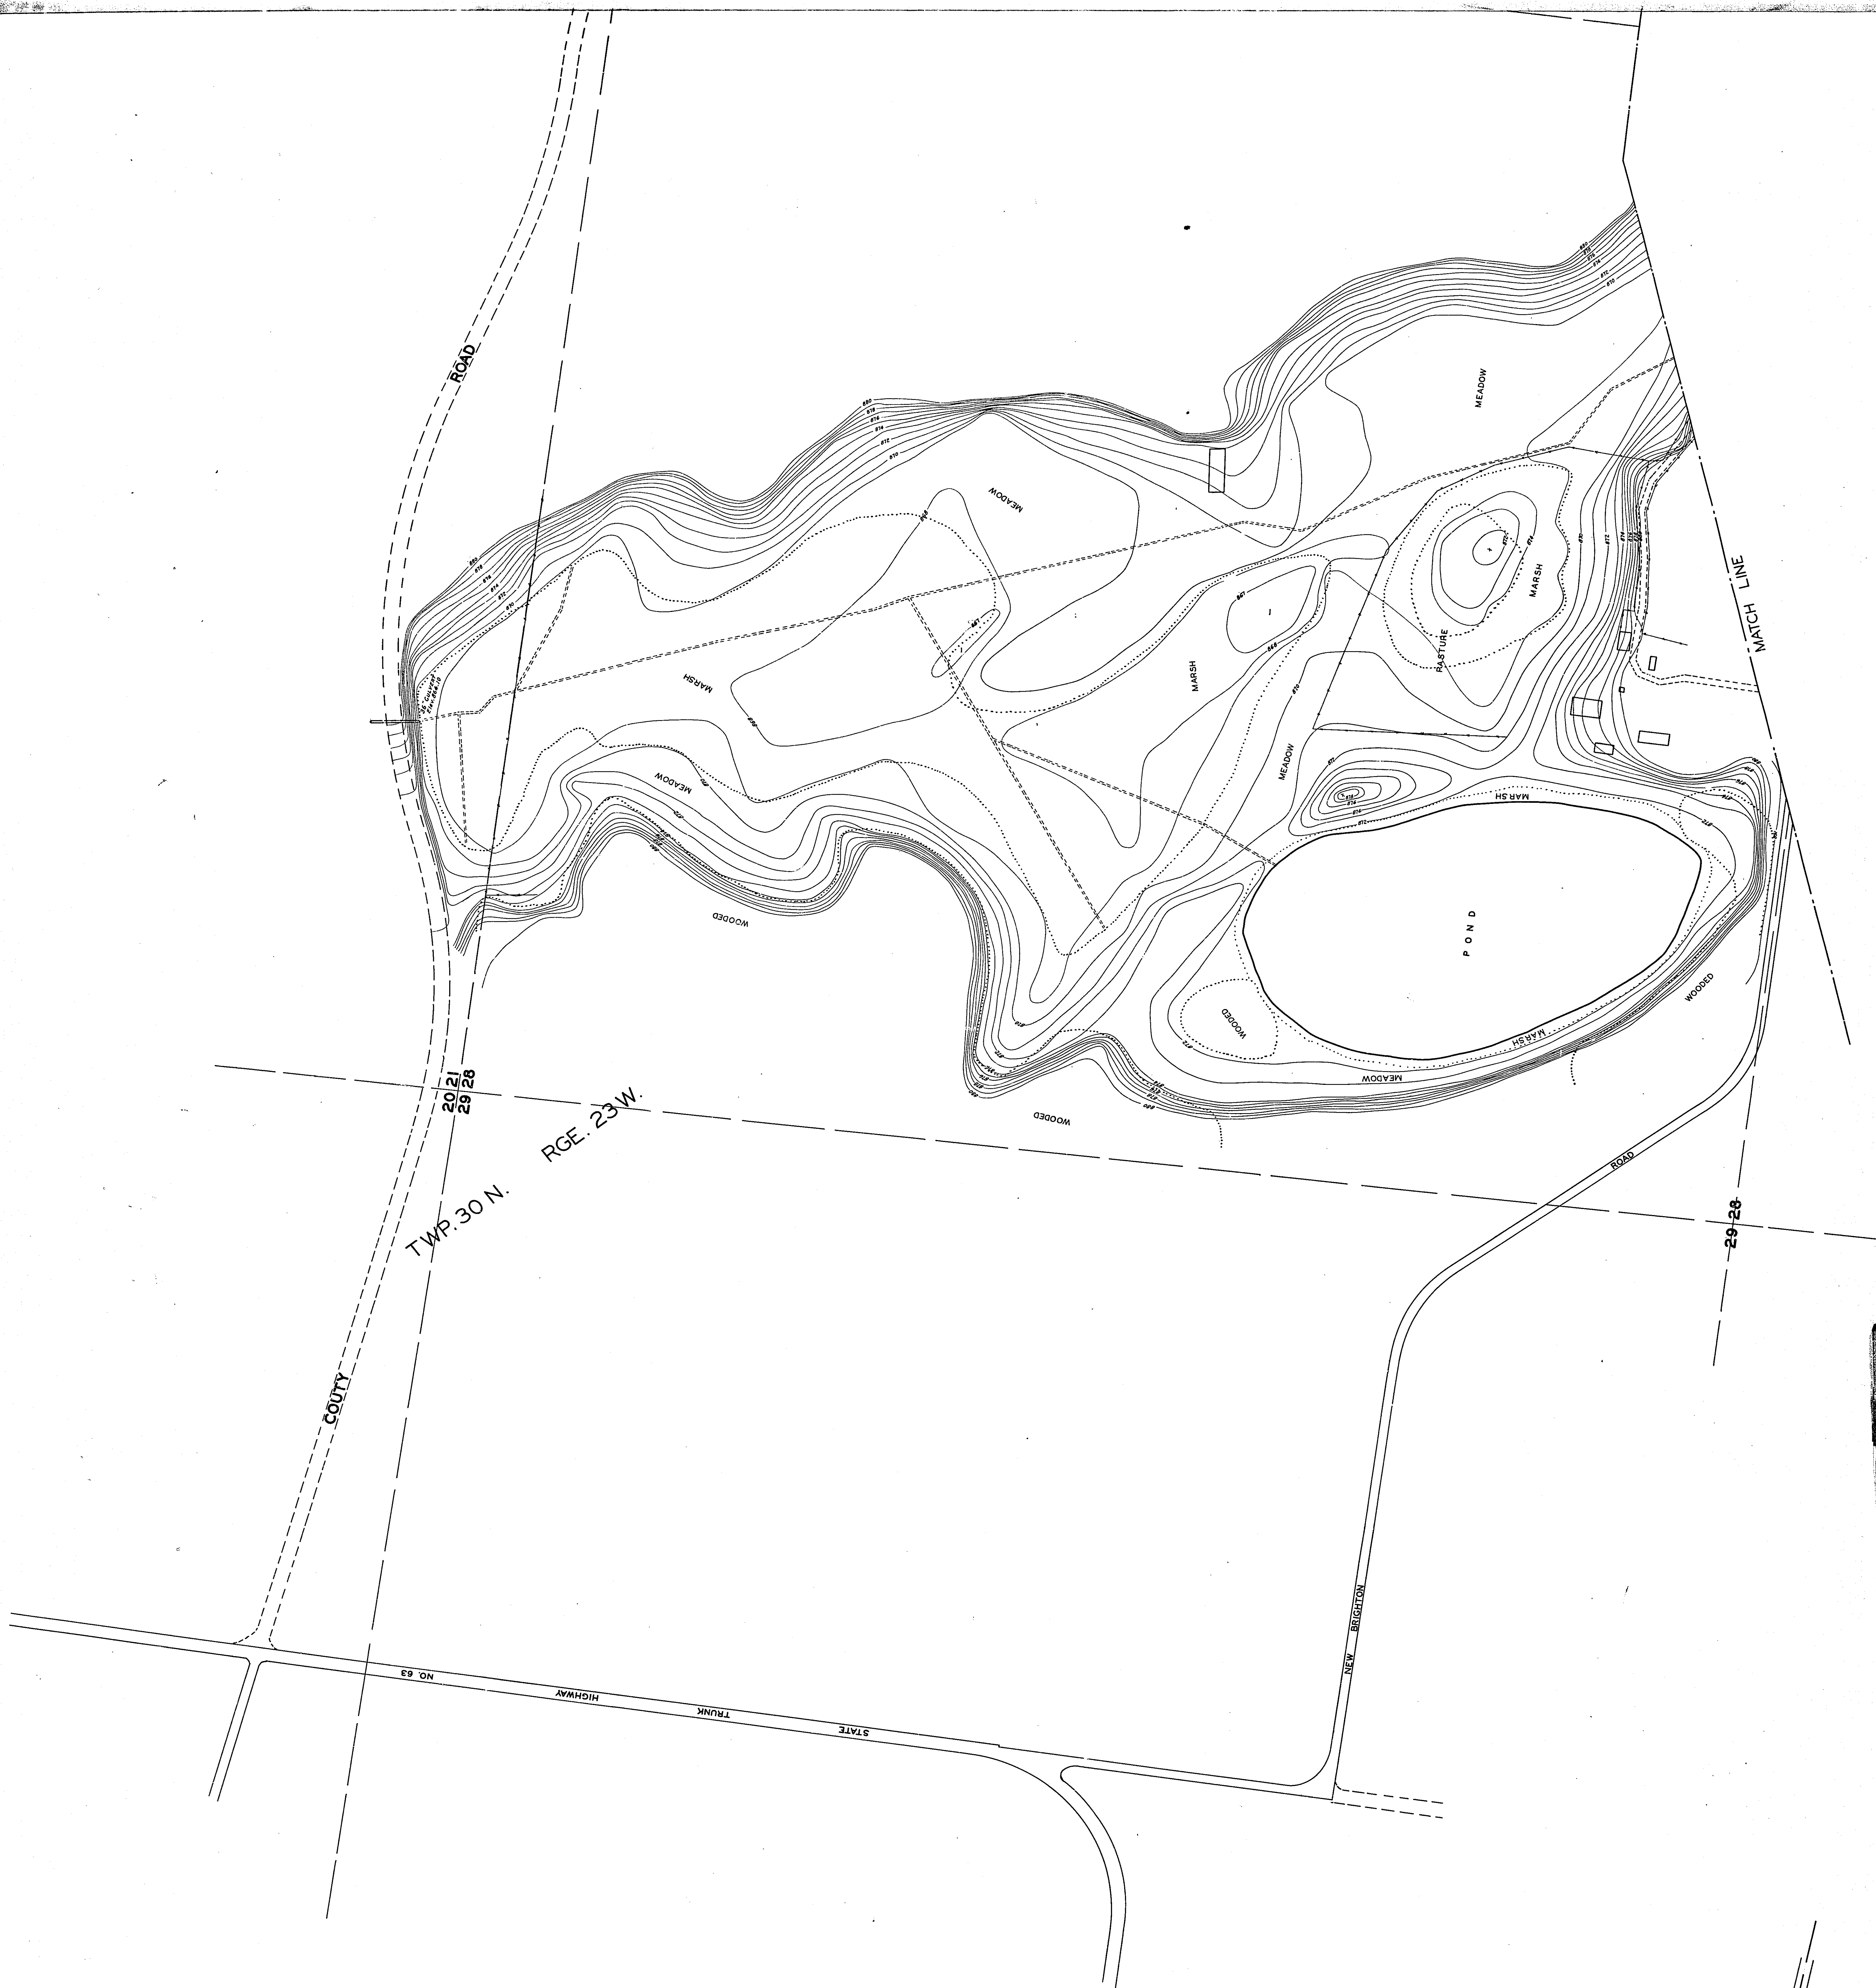

2 36 X

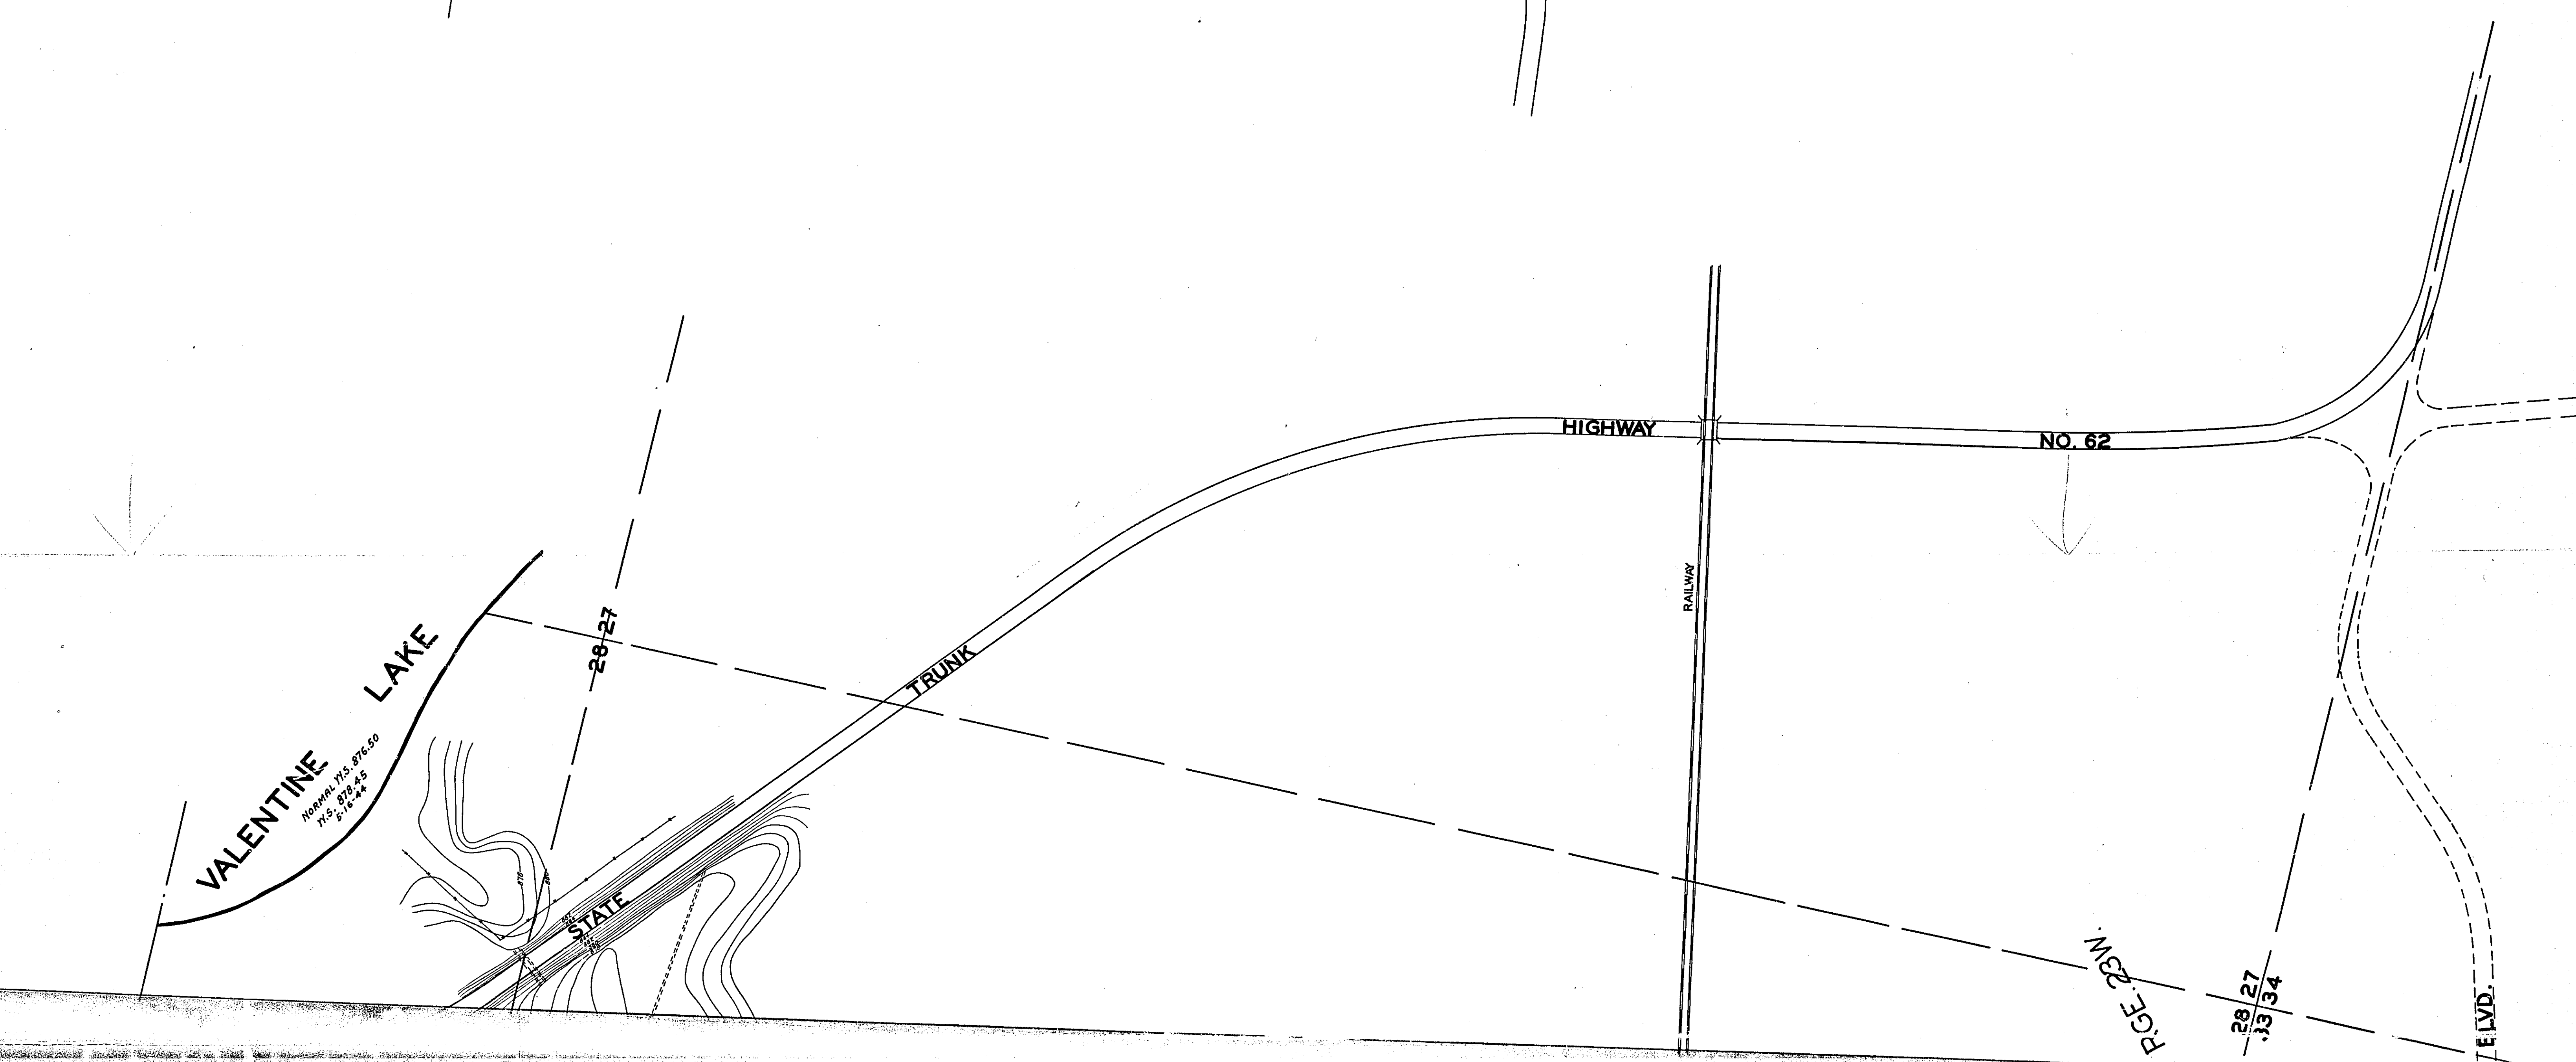

VALENTINE LAKE

28/27

TRUNK


HIGHWAY

NO. 62


RGE. 23 W.

28/27
13/34

E LVD.

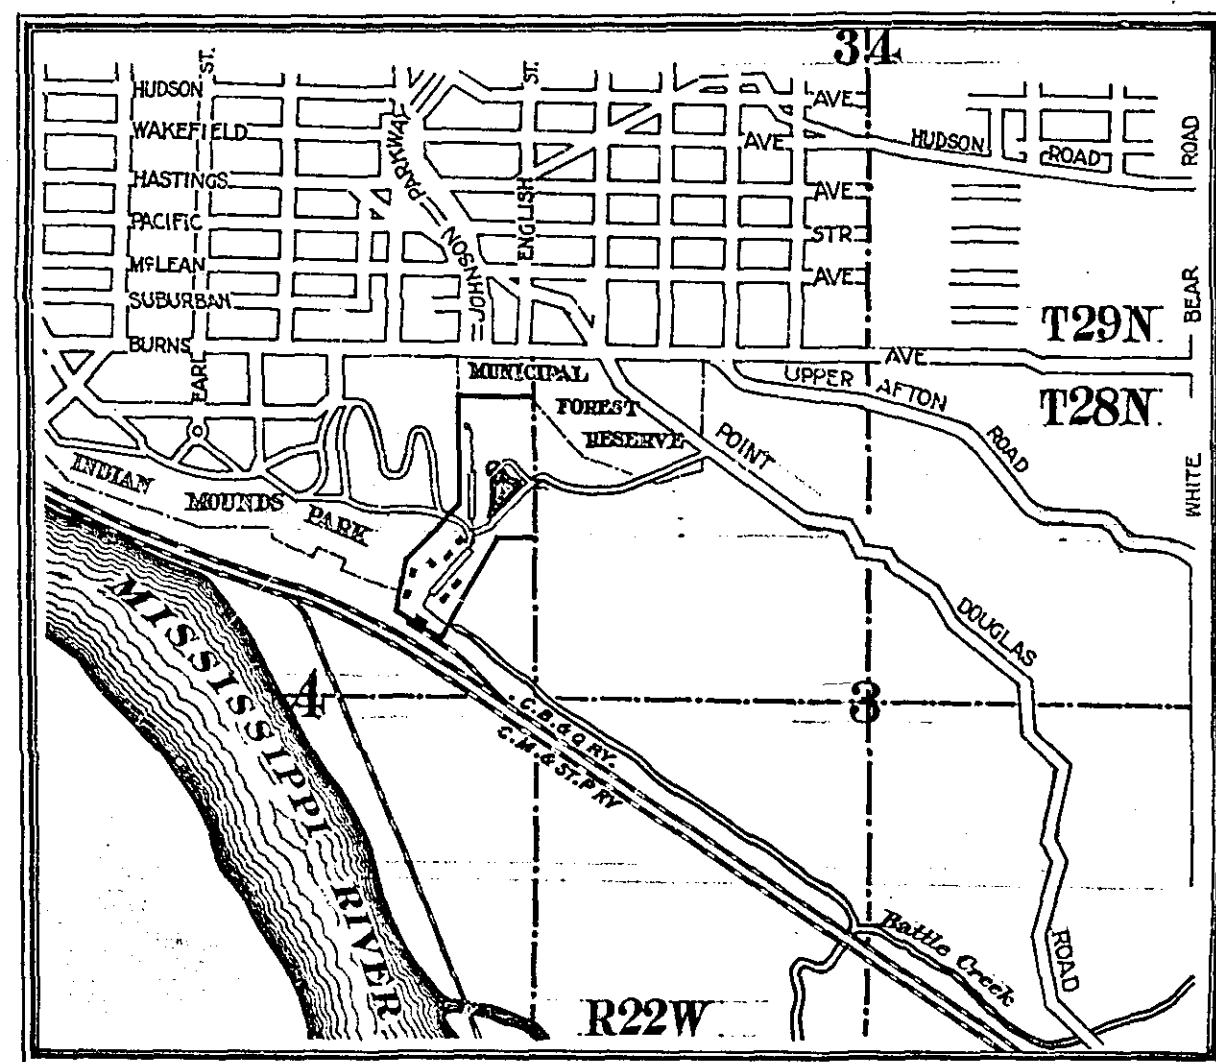

SCALE 1"=1200'
KEY MAP


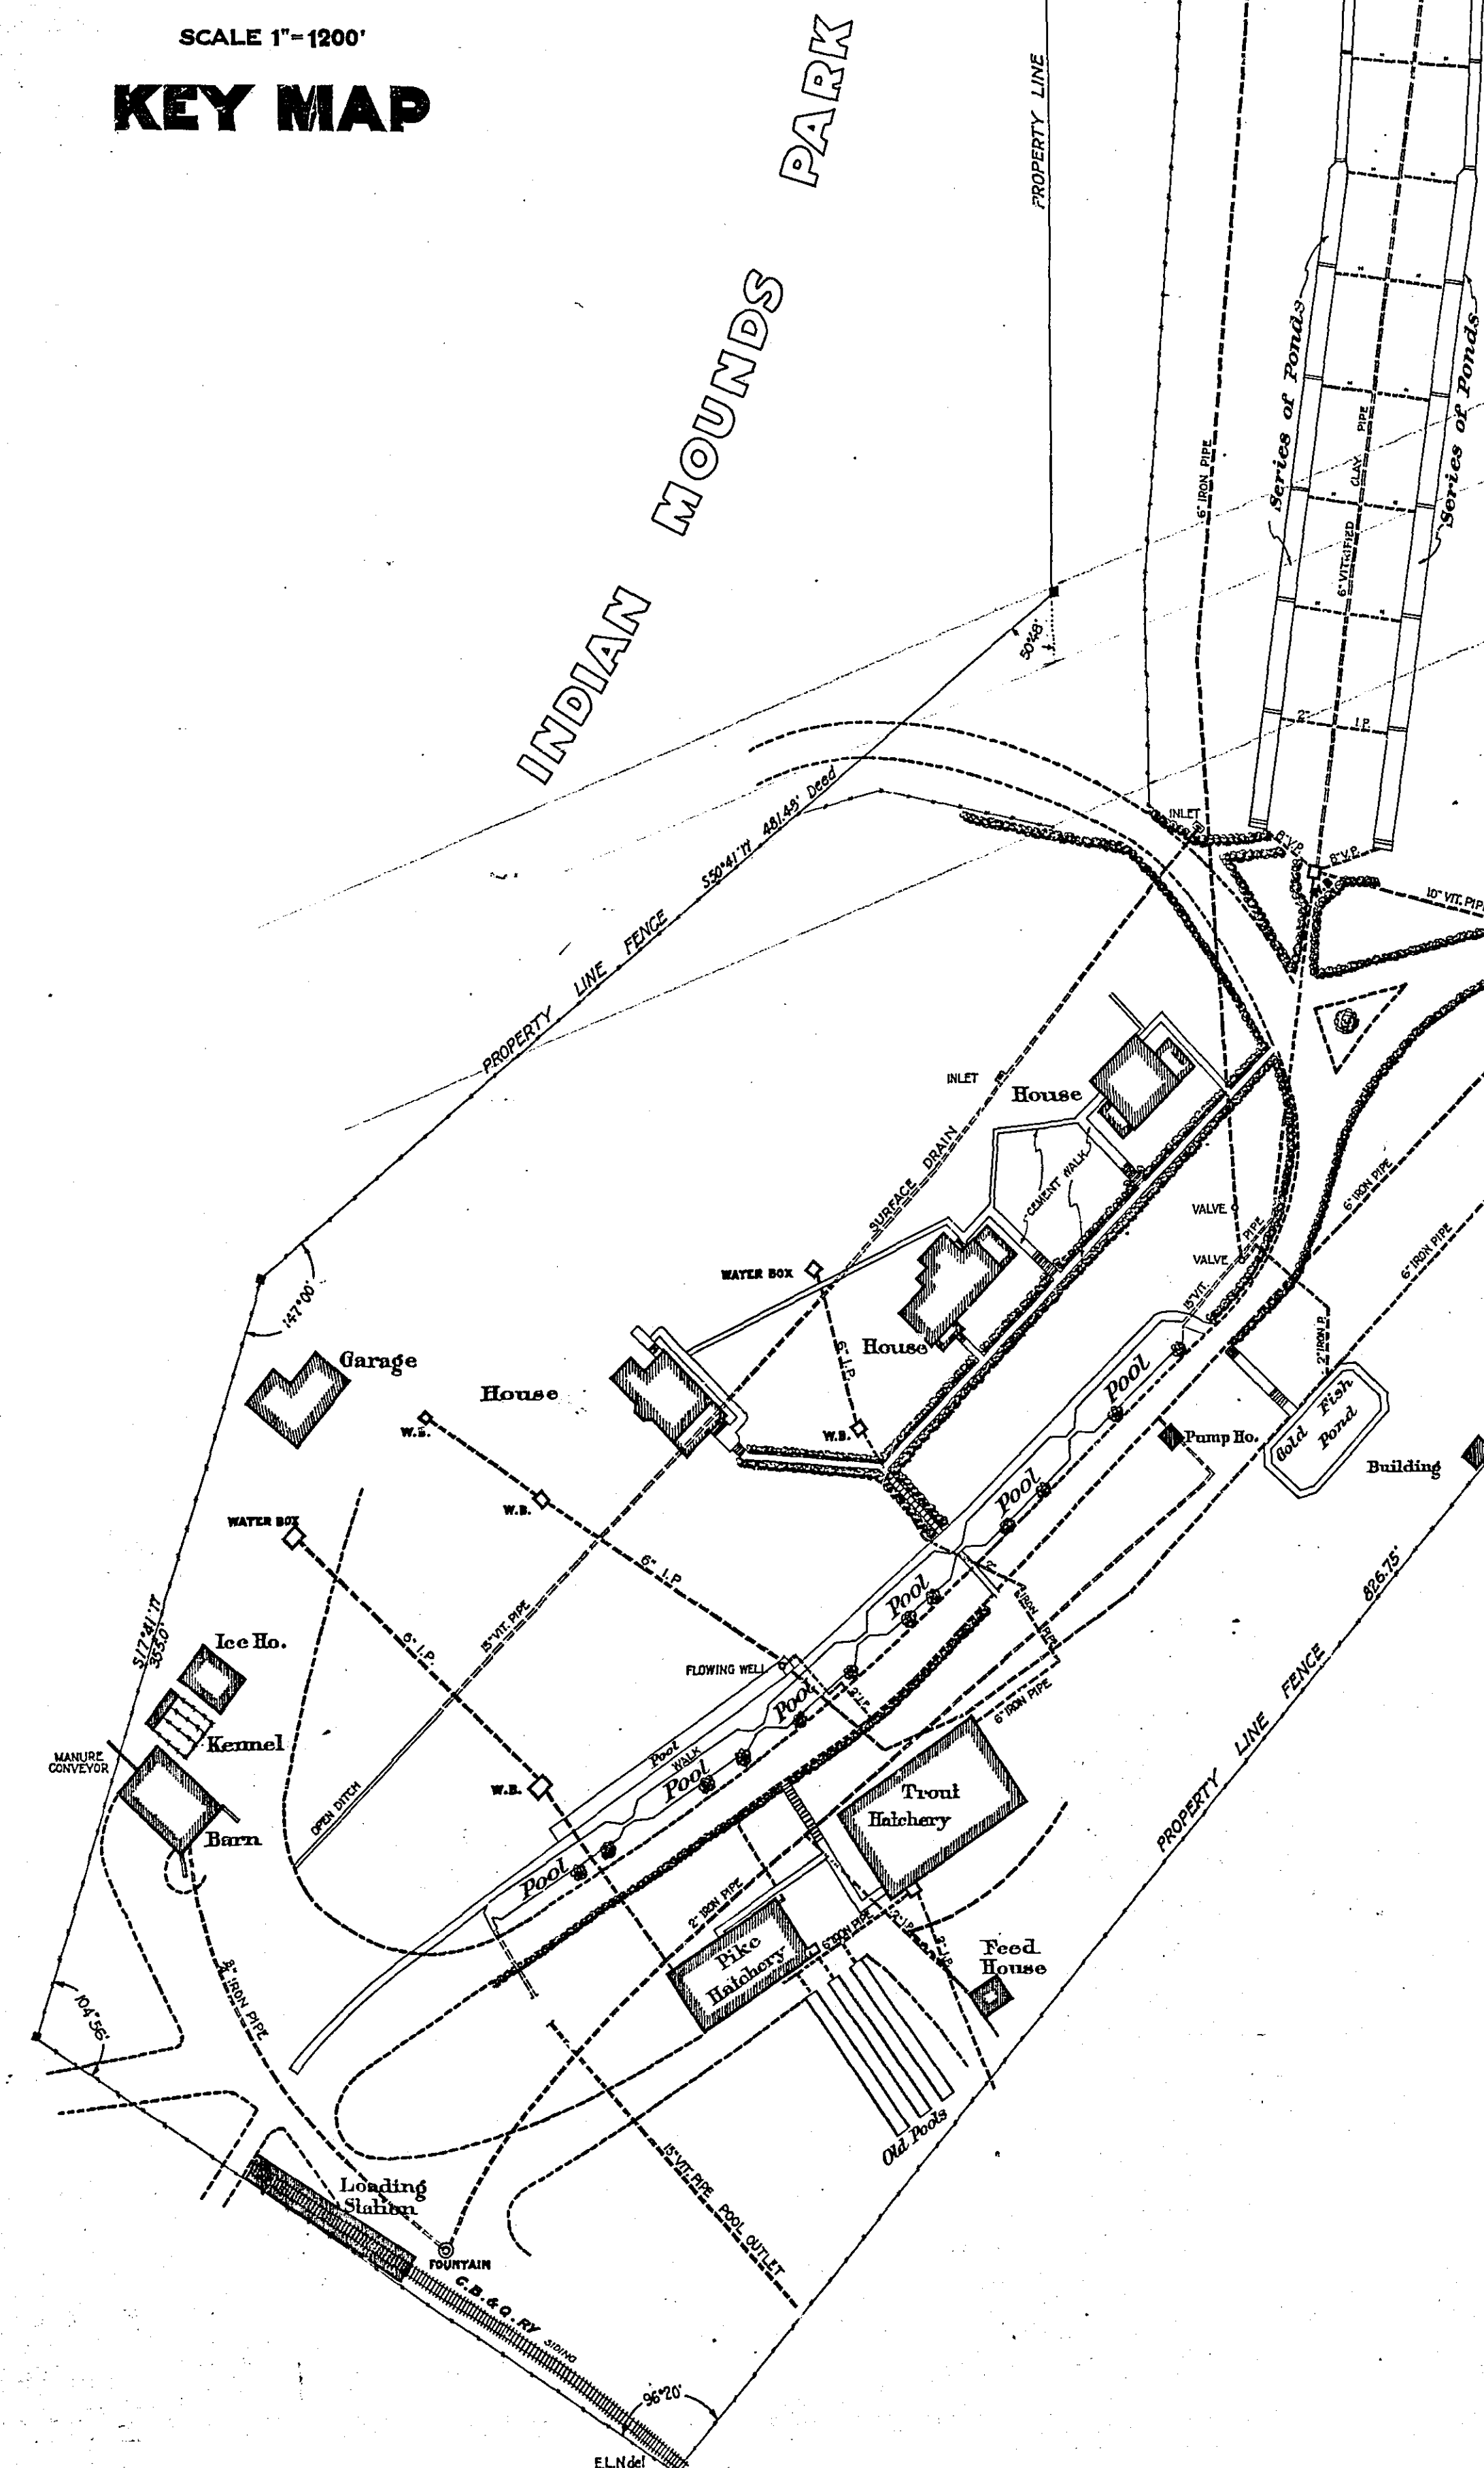



MAP OF THE
PROPERTY OF
THE
MINNESOTA STATE FISH HATCHERY
AT
ST. PAUL, MINN.
SHOWING EXISTING IMPROVEMENTS.
JULY, 1924

SURVEYED AND PLATTED BY
RAMSEY COUNTY ENGINEERS' DEPARTMENT.
ST. PAUL, MINN.

PAUL N. COATES,
COUNTY ENGINEER

SCALE 1"=50'
E.L.S.-S.E.L.

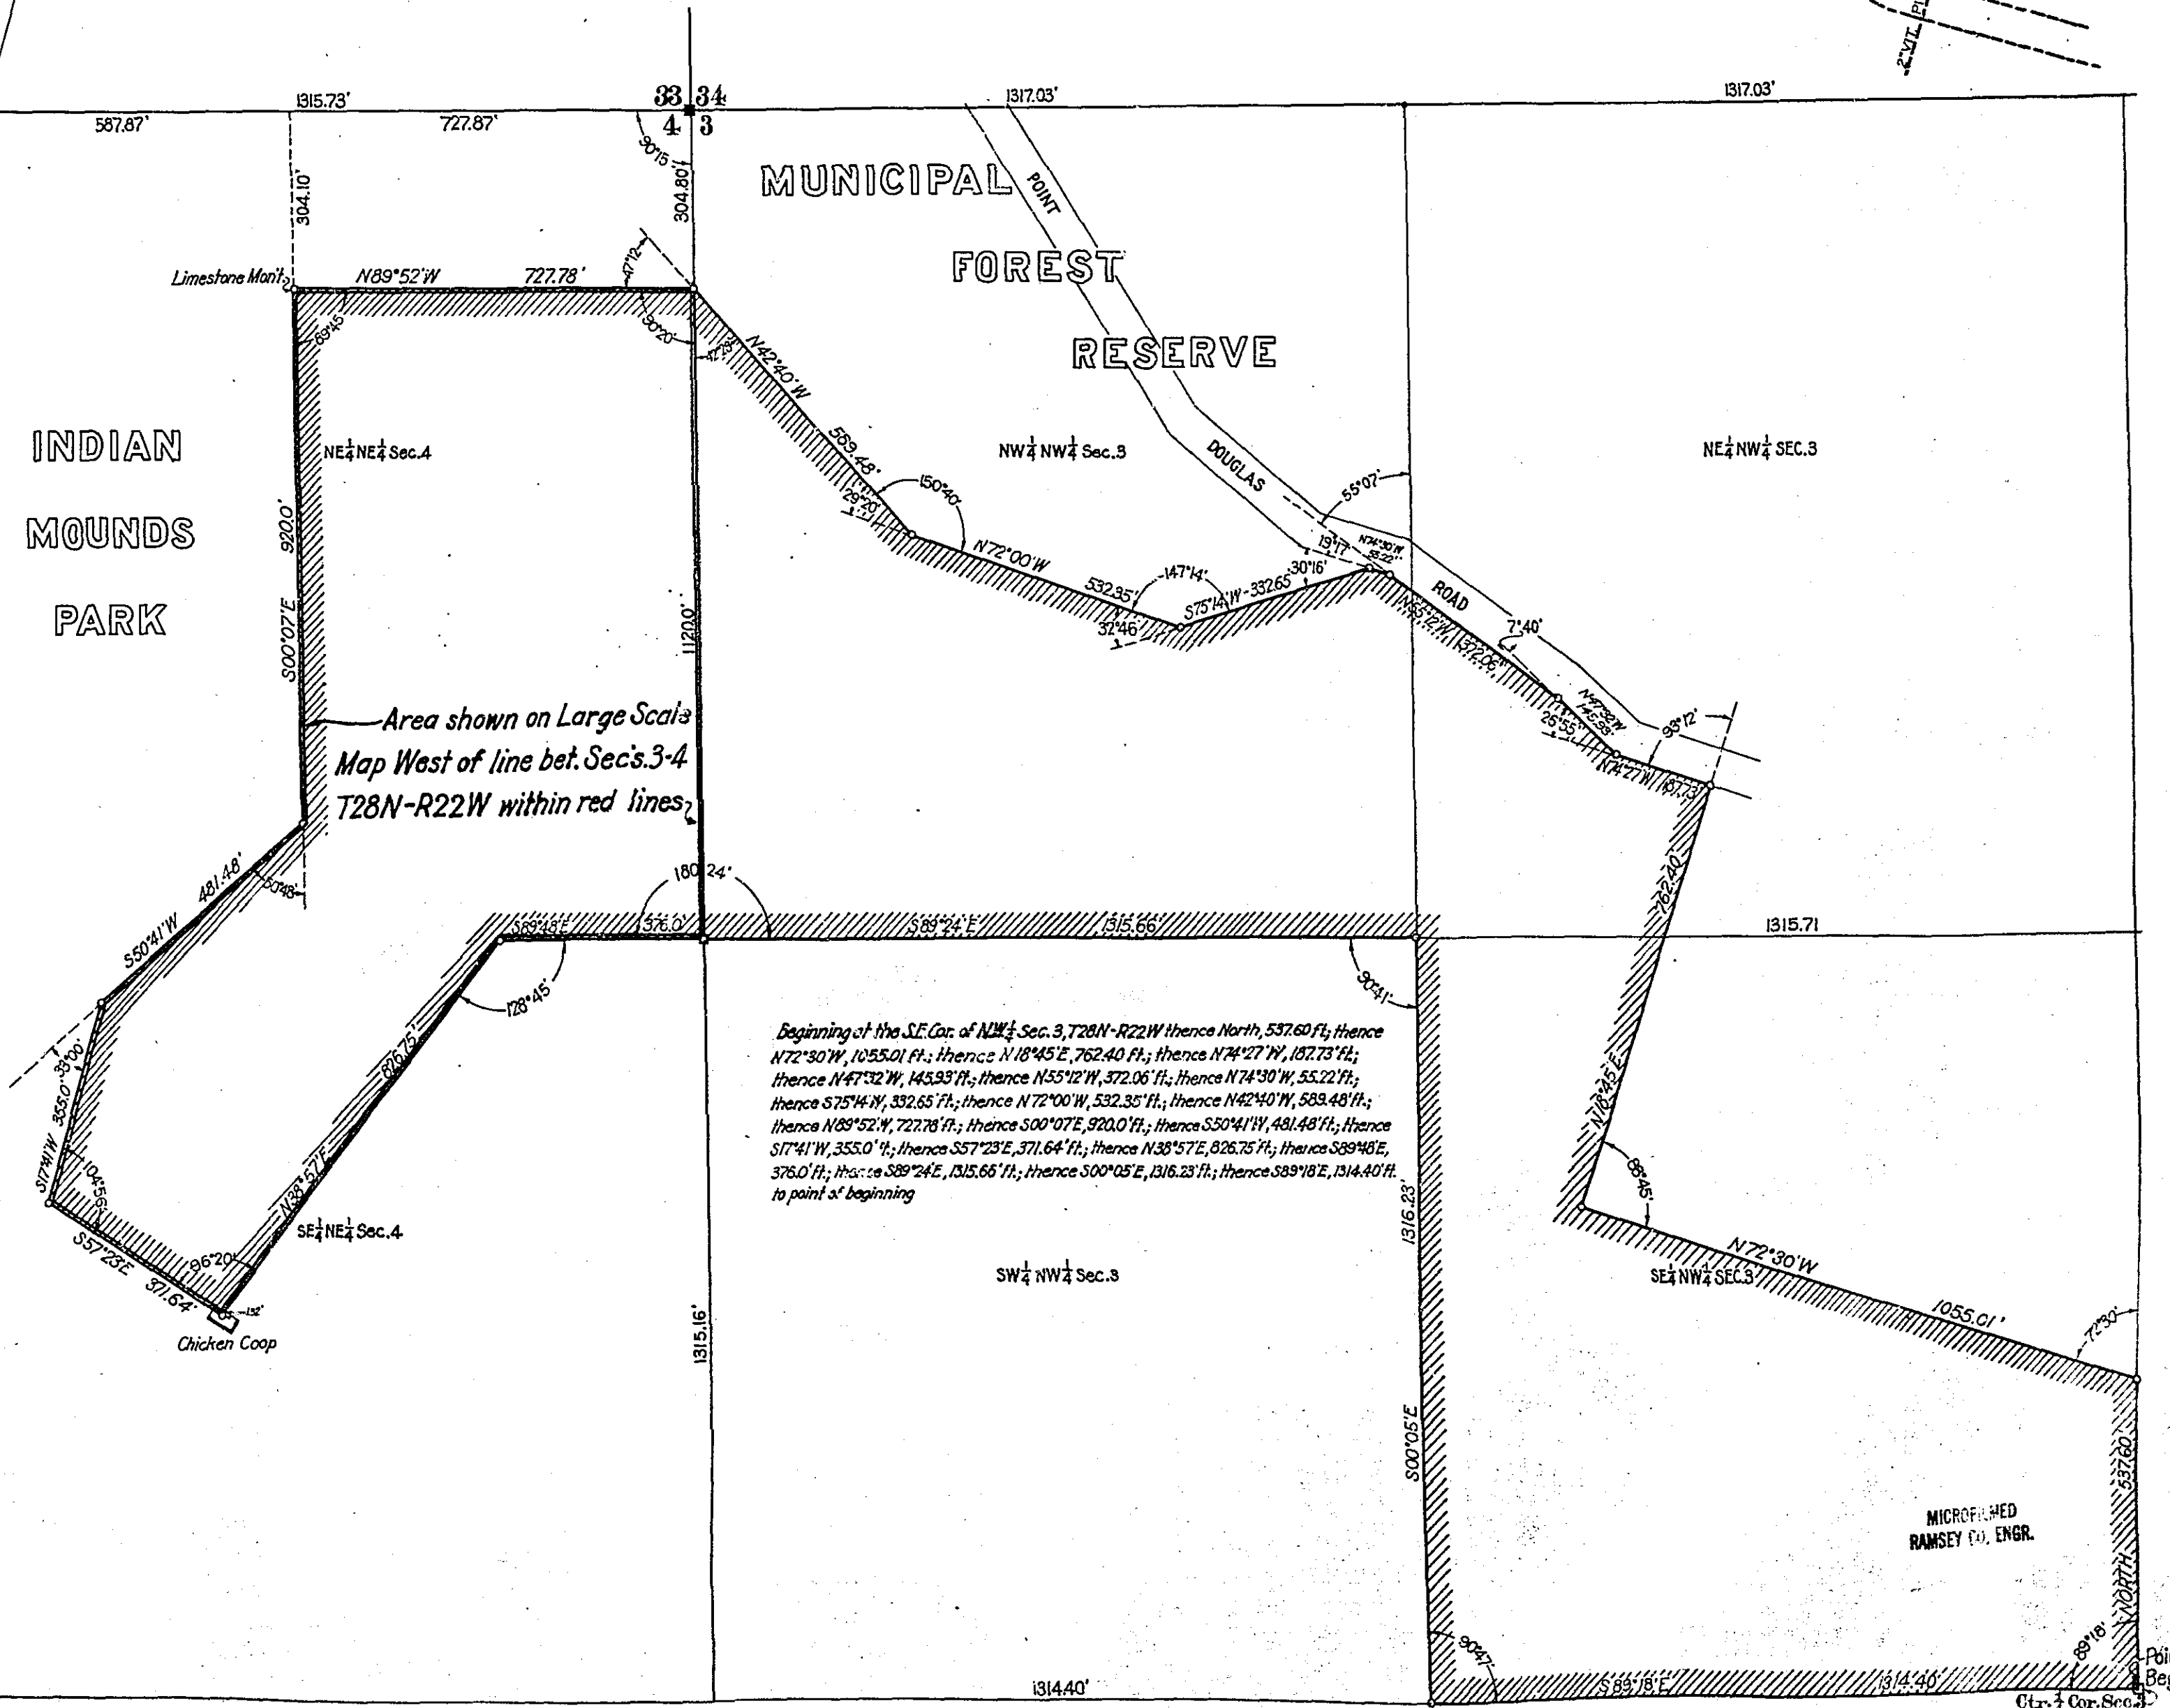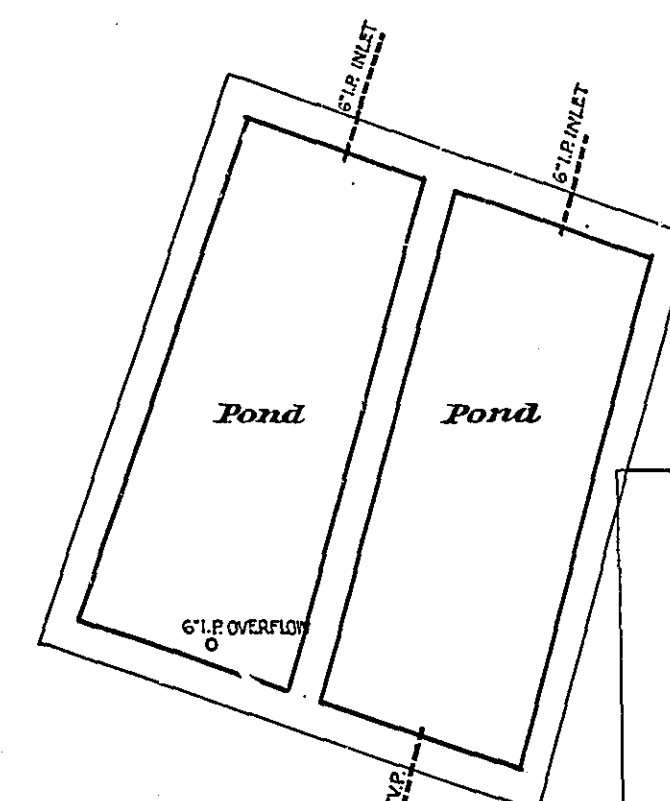

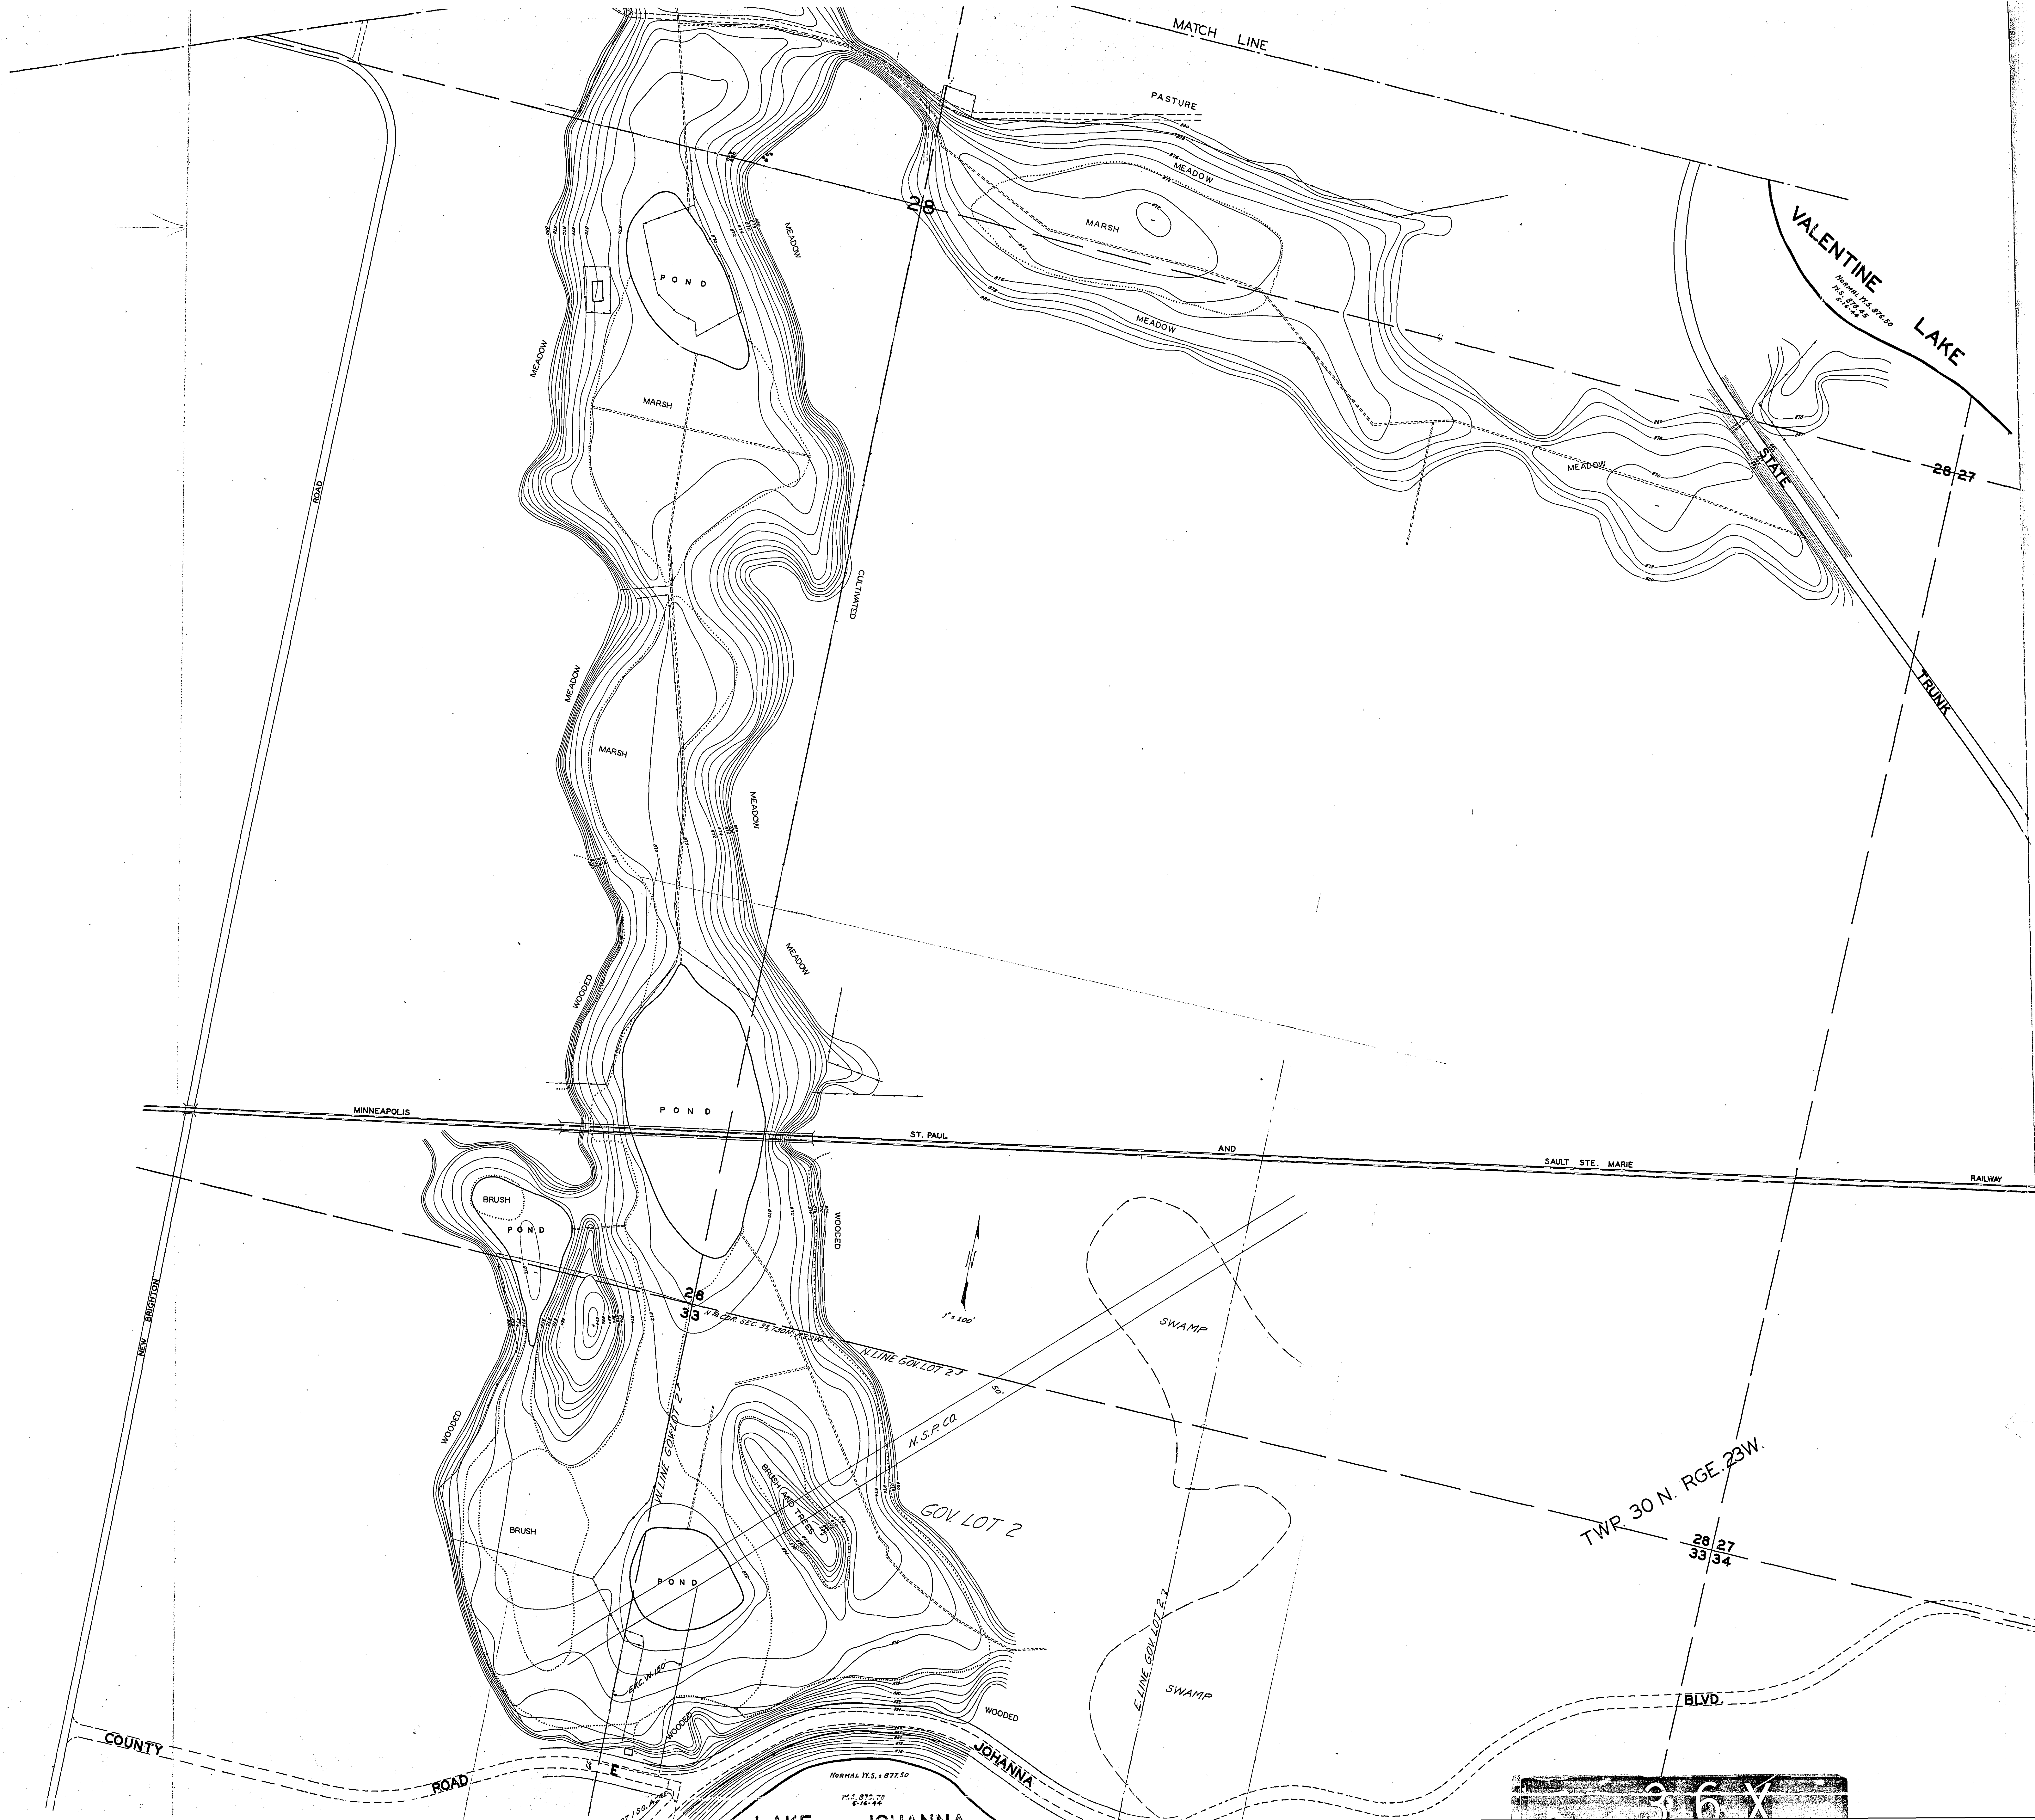

MICROFILMED
RANNEY CO. ENGR.
T-15

316X