


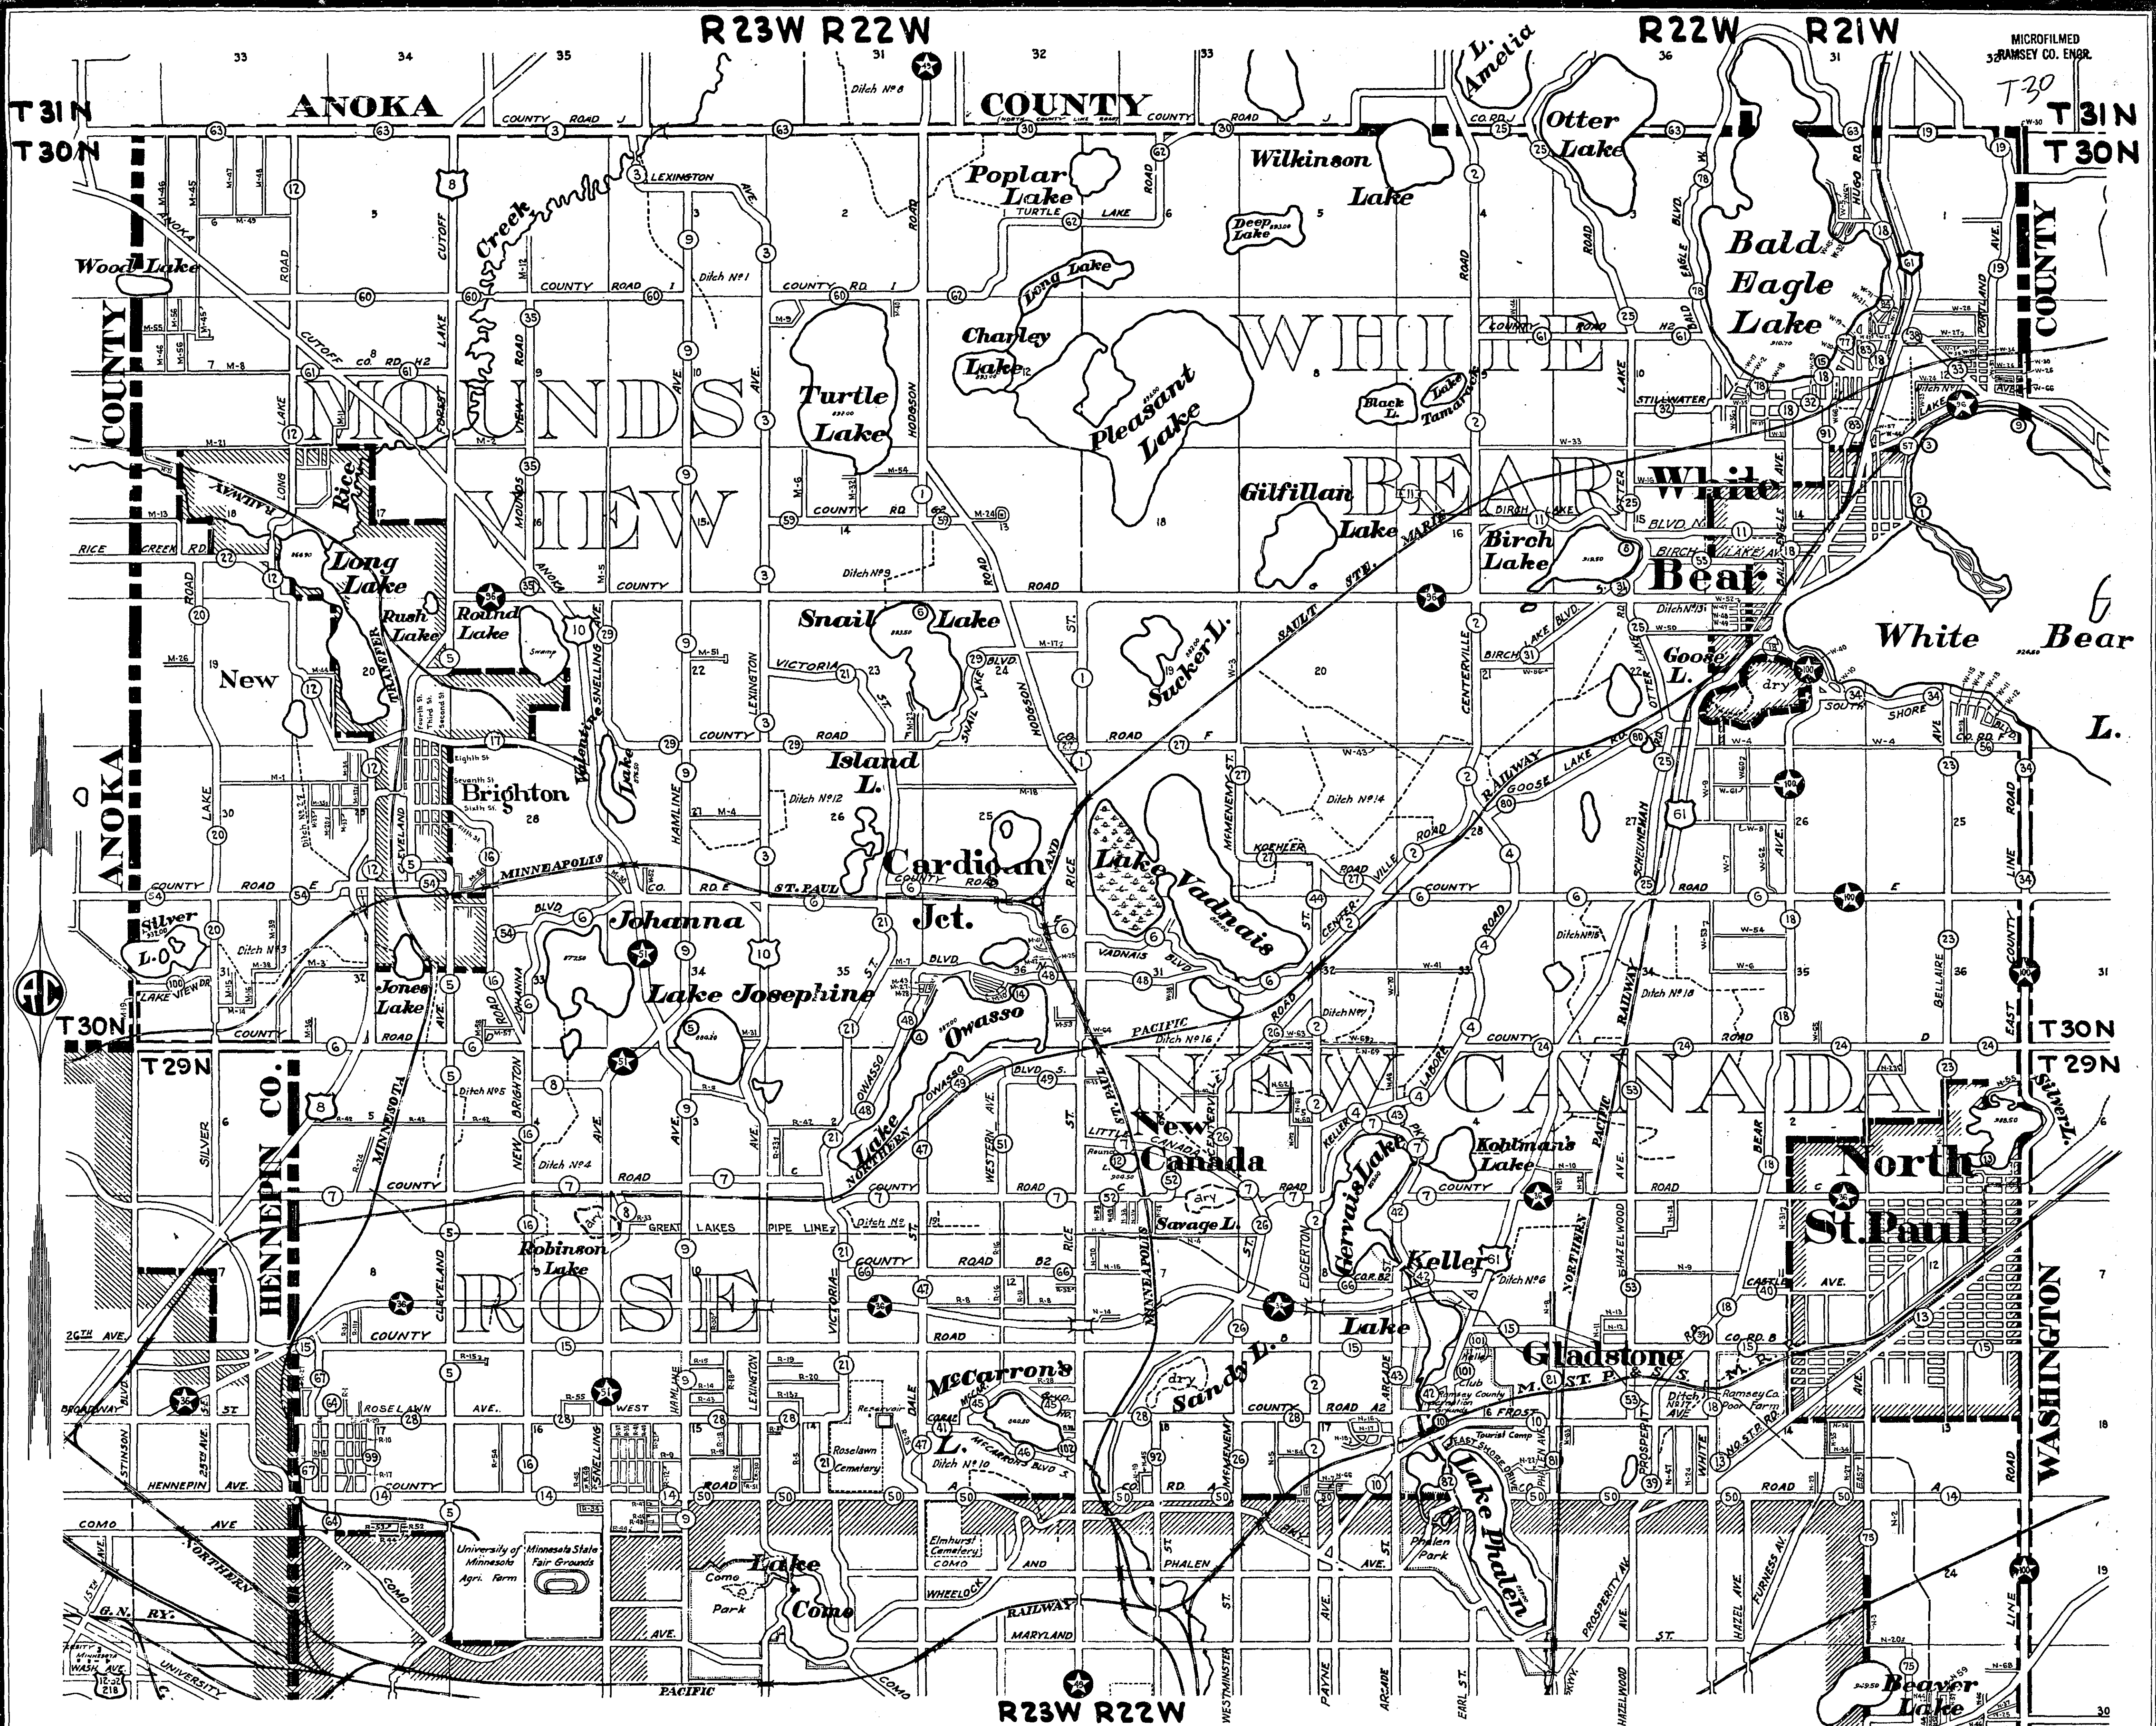

TOWNSHIP ROADS											
MOUNDS VIEW				ROSE				WHITE BEAR			
NO.	NAME	SEC.	NO.	NAME	SEC.	NO.	NAME	SEC.	NO.	NAME	SEC.
M-1 Cemetery Rd.	M-3230		M-36 Sorenson Rd.	M-32		R-1 Carl St.	M-17		W-1 Fourth St.	M-12	
M-2 County Rd. H	M-3		M-37 First Ave.	M-29		R-2 Spring St.	M-17		W-2 West St.	M-11	
M-3 Foss Rd.	M-32		M-38 Orchard Place	M-31		R-3 St. Croix St.	M-8		W-3 Gilfillan Rd.	M-19	
M-4 Koski Rd.	M-27		M-39 Oakwood Drive	M-31		R-4 Malvern St.	M-17		W-4 Ash St.	M-19	
M-5 Snelling Ave.	M-16		M-40 Carlson Rd.	M-11		R-5 Chaffinch St.	M-14		W-5 Overlake Ave.	M-12	
M-6 Hanson Rd.	M-14		M-41 Cottage Place	M-36		R-6 Josephine Rd.	M-3		W-6 Overlake Lane	M-35	
M-7 Arbogast St.	M-35		M-42 Fairview Ave.	M-36		R-7 Pleasant St.	M-17		W-7 August Ave.	M-26	
M-8 Toner Rd.	M-7		M-43 Owasso Hts. Rd. "C"	M-36		R-8 Minnesota Ave.	M-12		W-8 Cedar St.	M-26	
M-9 Lake Ave.	M-11		M-44 Fredson Rd.	M-20		R-9 Garden Ave.	M-15		W-9 Linden St.	M-27	
M-10 Horseshoe Dr. Walnut	M-36		M-45 Groveland St.	M-67		R-10 Summer St.	M-17		W-10 Lakeview Ave.	M-23	
M-11 Ironside Rd.	M-4		M-46 Spring Lake Park Rd.	M-67		R-11 St. Stephens St.	M-8		W-11 Forest Court	M-24	
M-12 Schutte Rd.	M-4		M-47 Red Oak Drive	M-6		R-12 Albert St.	M-15		W-12 Summit Lane	M-24	
M-13 Crepeau Rd.	M-18		M-48 Eastwood Rd.	M-6		R-13 Shryer Ave.	M-14		W-13 First St. (Bellair)	M-24	
M-14 Sunset Lane	M-31		M-49 Sherwood Rd.	M-6		R-14 Ryan Ave.	M-15		W-14 Second St. (Bellair)	M-24	
M-15 Fairfield Drive	M-31		M-50 Thom Drive	M-18		R-15 Eldridge Ave.	M-15		W-15 Third St. (Bellair)	M-24	
M-16 Valley View Rd.	M-31		M-51 Amble Road	M-22		R-16 Western Ave.	M-12		W-16 Ninth St.	M-12	
M-17 Atlantic Ave.	M-24		M-52 Lakeview Ave.	M-27		R-17 Ione St.	M-17		W-17 Summit St.	M-11	
M-18 Gramsie Rd.	M-16		M-53 Ballard Road	M-36		R-18 Sedalia Ave.	M-15		W-18 St. Anthony Ave.	M-11	
M-19 Sunnyside Blvd.	M-31		M-54 Schifsky Road	M-11		R-19 Burke Ave.	M-14		W-19 East St.	M-11	
M-20 Fourth Ave.	M-29		M-55 Bronson Drive	M-7		R-20 Parker Ave.	M-14		W-20 Short St.	M-11	
M-21 Central Ave.	M-23		M-56 Knollwood Drive	M-33		R-21 Holton Ave.	M-15		W-21 William St.	M-12	
M-22 Reiland Lane	M-23		M-57 Glenpaule Ave.	M-59		R-22 Oxford St.	M-2		W-22 Hoxie Ave.	M-12	
M-23 Sixth Ave.	M-13		M-58 Prior Ave.	M-60		R-23 Pipe Line Rd.	M-5		W-23 Pacific St.	M-12	
M-24 County Road "G"	M-13					R-24 Dale St.	M-14		W-24 Stillwater St.	M-12	
M-25 See St.	M-36					R-25 Dunlap St.	M-15		W-25 First St.	M-12	
M-26 Swanson Rd.	M-19					R-26 Sather St.	M-17		W-26 Second St.	M-12	
M-27 Owasso Hts. Rd. "F"	M-36					R-27 Elmer St.	M-13		W-27 Sixth St.	M-12	
M-28 "G" M-36						R-28 Lake St.	M-17		W-28 Taylor Ave.	M-12	
M-29 "H" M-36						R-29 Lake St.	M-17		W-29 Grand Ave.	M-12	
M-30 Oak Ave.	M-27					R-30 Dellwood St.	M-10		W-30 East County Line Rd.	M-11	
M-31 Edgewater St.	M-24					R-31 Hand Ave.	M-12		W-31 Kach Rd. (Garden Lane)	M-11	
M-32 Larson Rd.	M-14					R-32 Moller Rd.	M-12		W-32 Orchard St.	M-12	
M-33 Third Ave.	M-29					R-33 Rose Place	M-10		W-33 Hammond Rd.	M-12	
M-34 Second Ave.	M-29					R-34 Hollywood Court	M-21		W-34 Third St.	M-12	
M-35 Washington Ave.	M-29					R-35 Arona Ave.	M-15		W-35 Alley Summit to West	M-11	

RAMSEY COUNTY HIGHWAY MAINTENANCE MAP 1940


HARRY S. BRONSON
COUNTY SURVEYOR

S - Indicates roads on which snow removal has been requested.
M - Indicates roads on which maintenance has been requested.


REVISED	DATE	BY
12-14-37	A.D.C.	
12-1-38	A.D.C.	
11-18-39	W.J.B.	
2-20-40	W.J.B.	
7-19-40	W.J.B.	

See revised pricing

MICROFILMED
RAMSEY CO. ENGR.

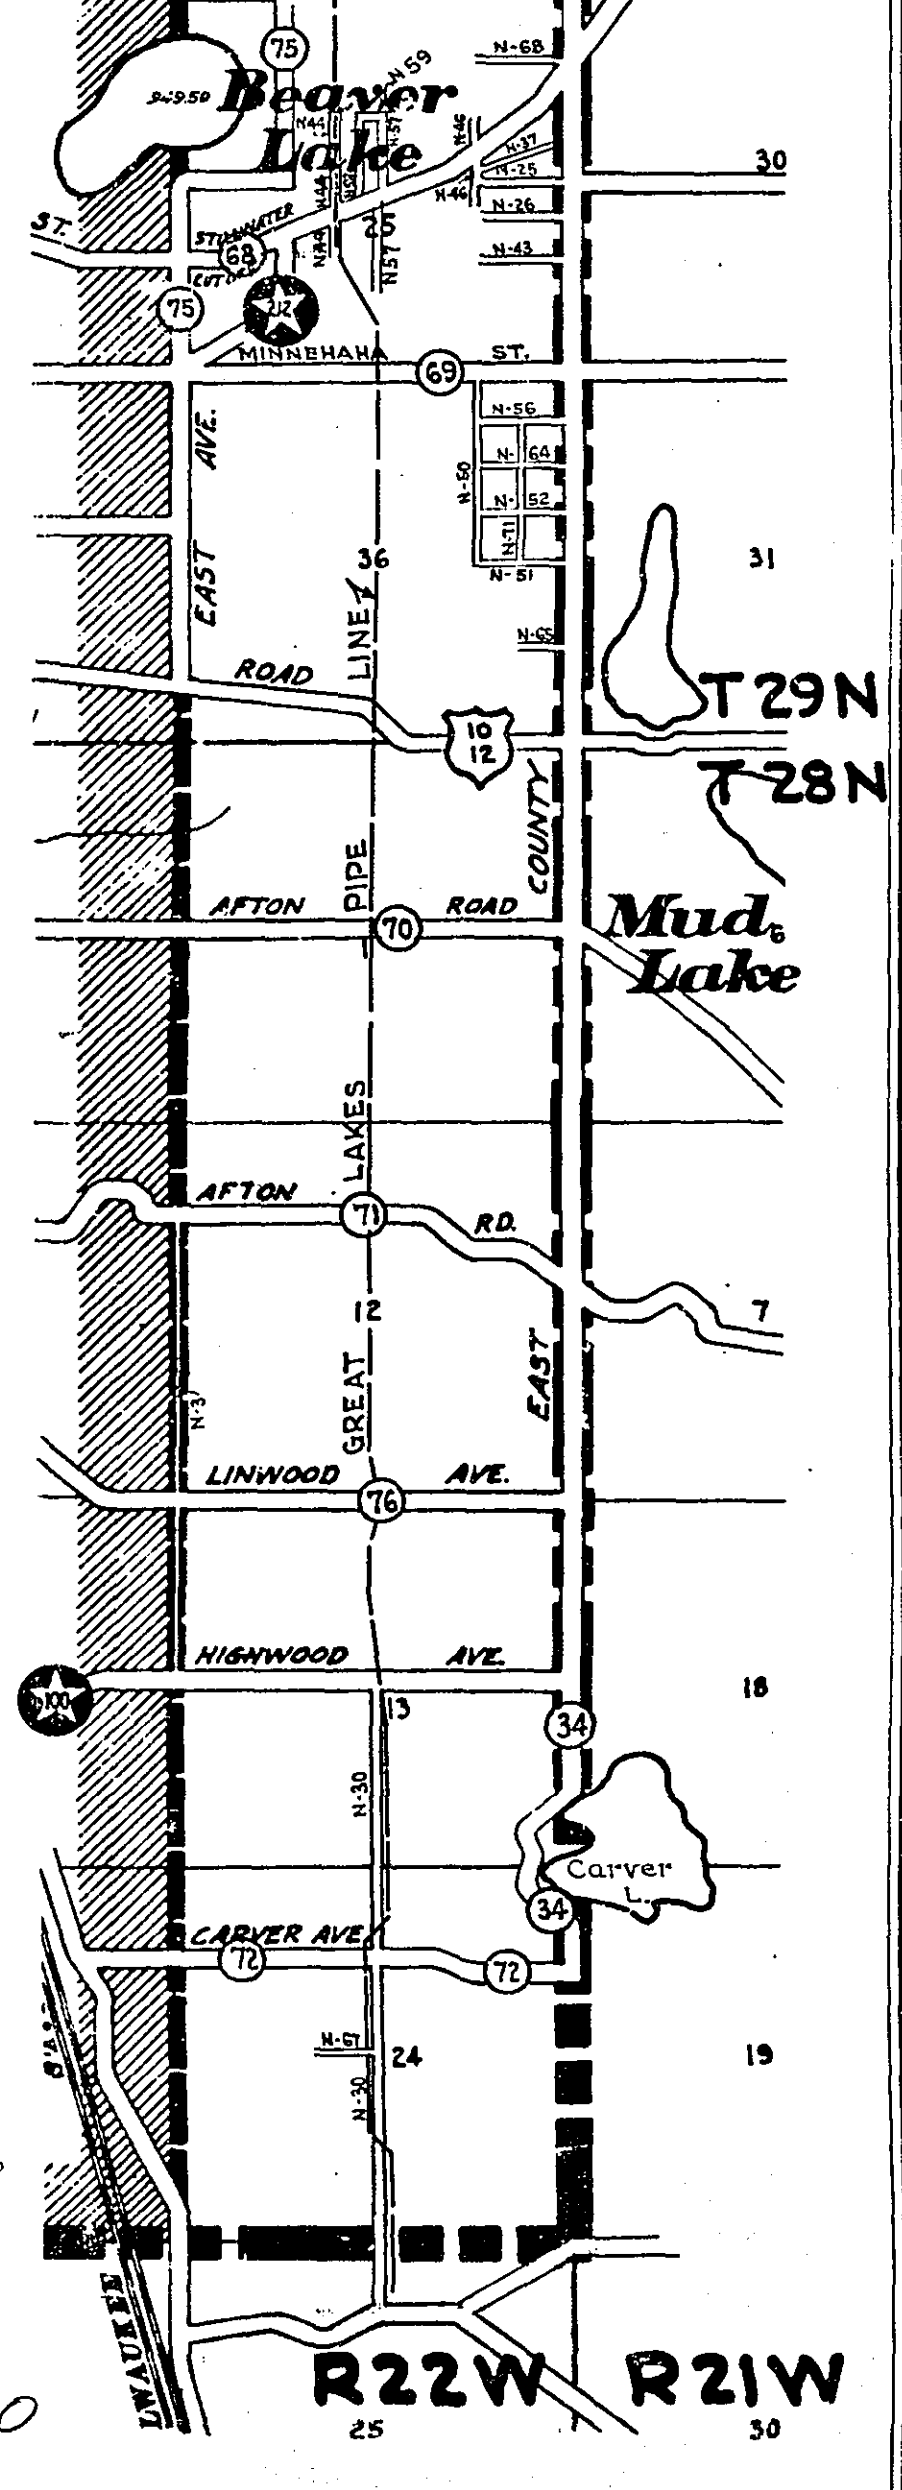

M.W.C. & A.D.C.

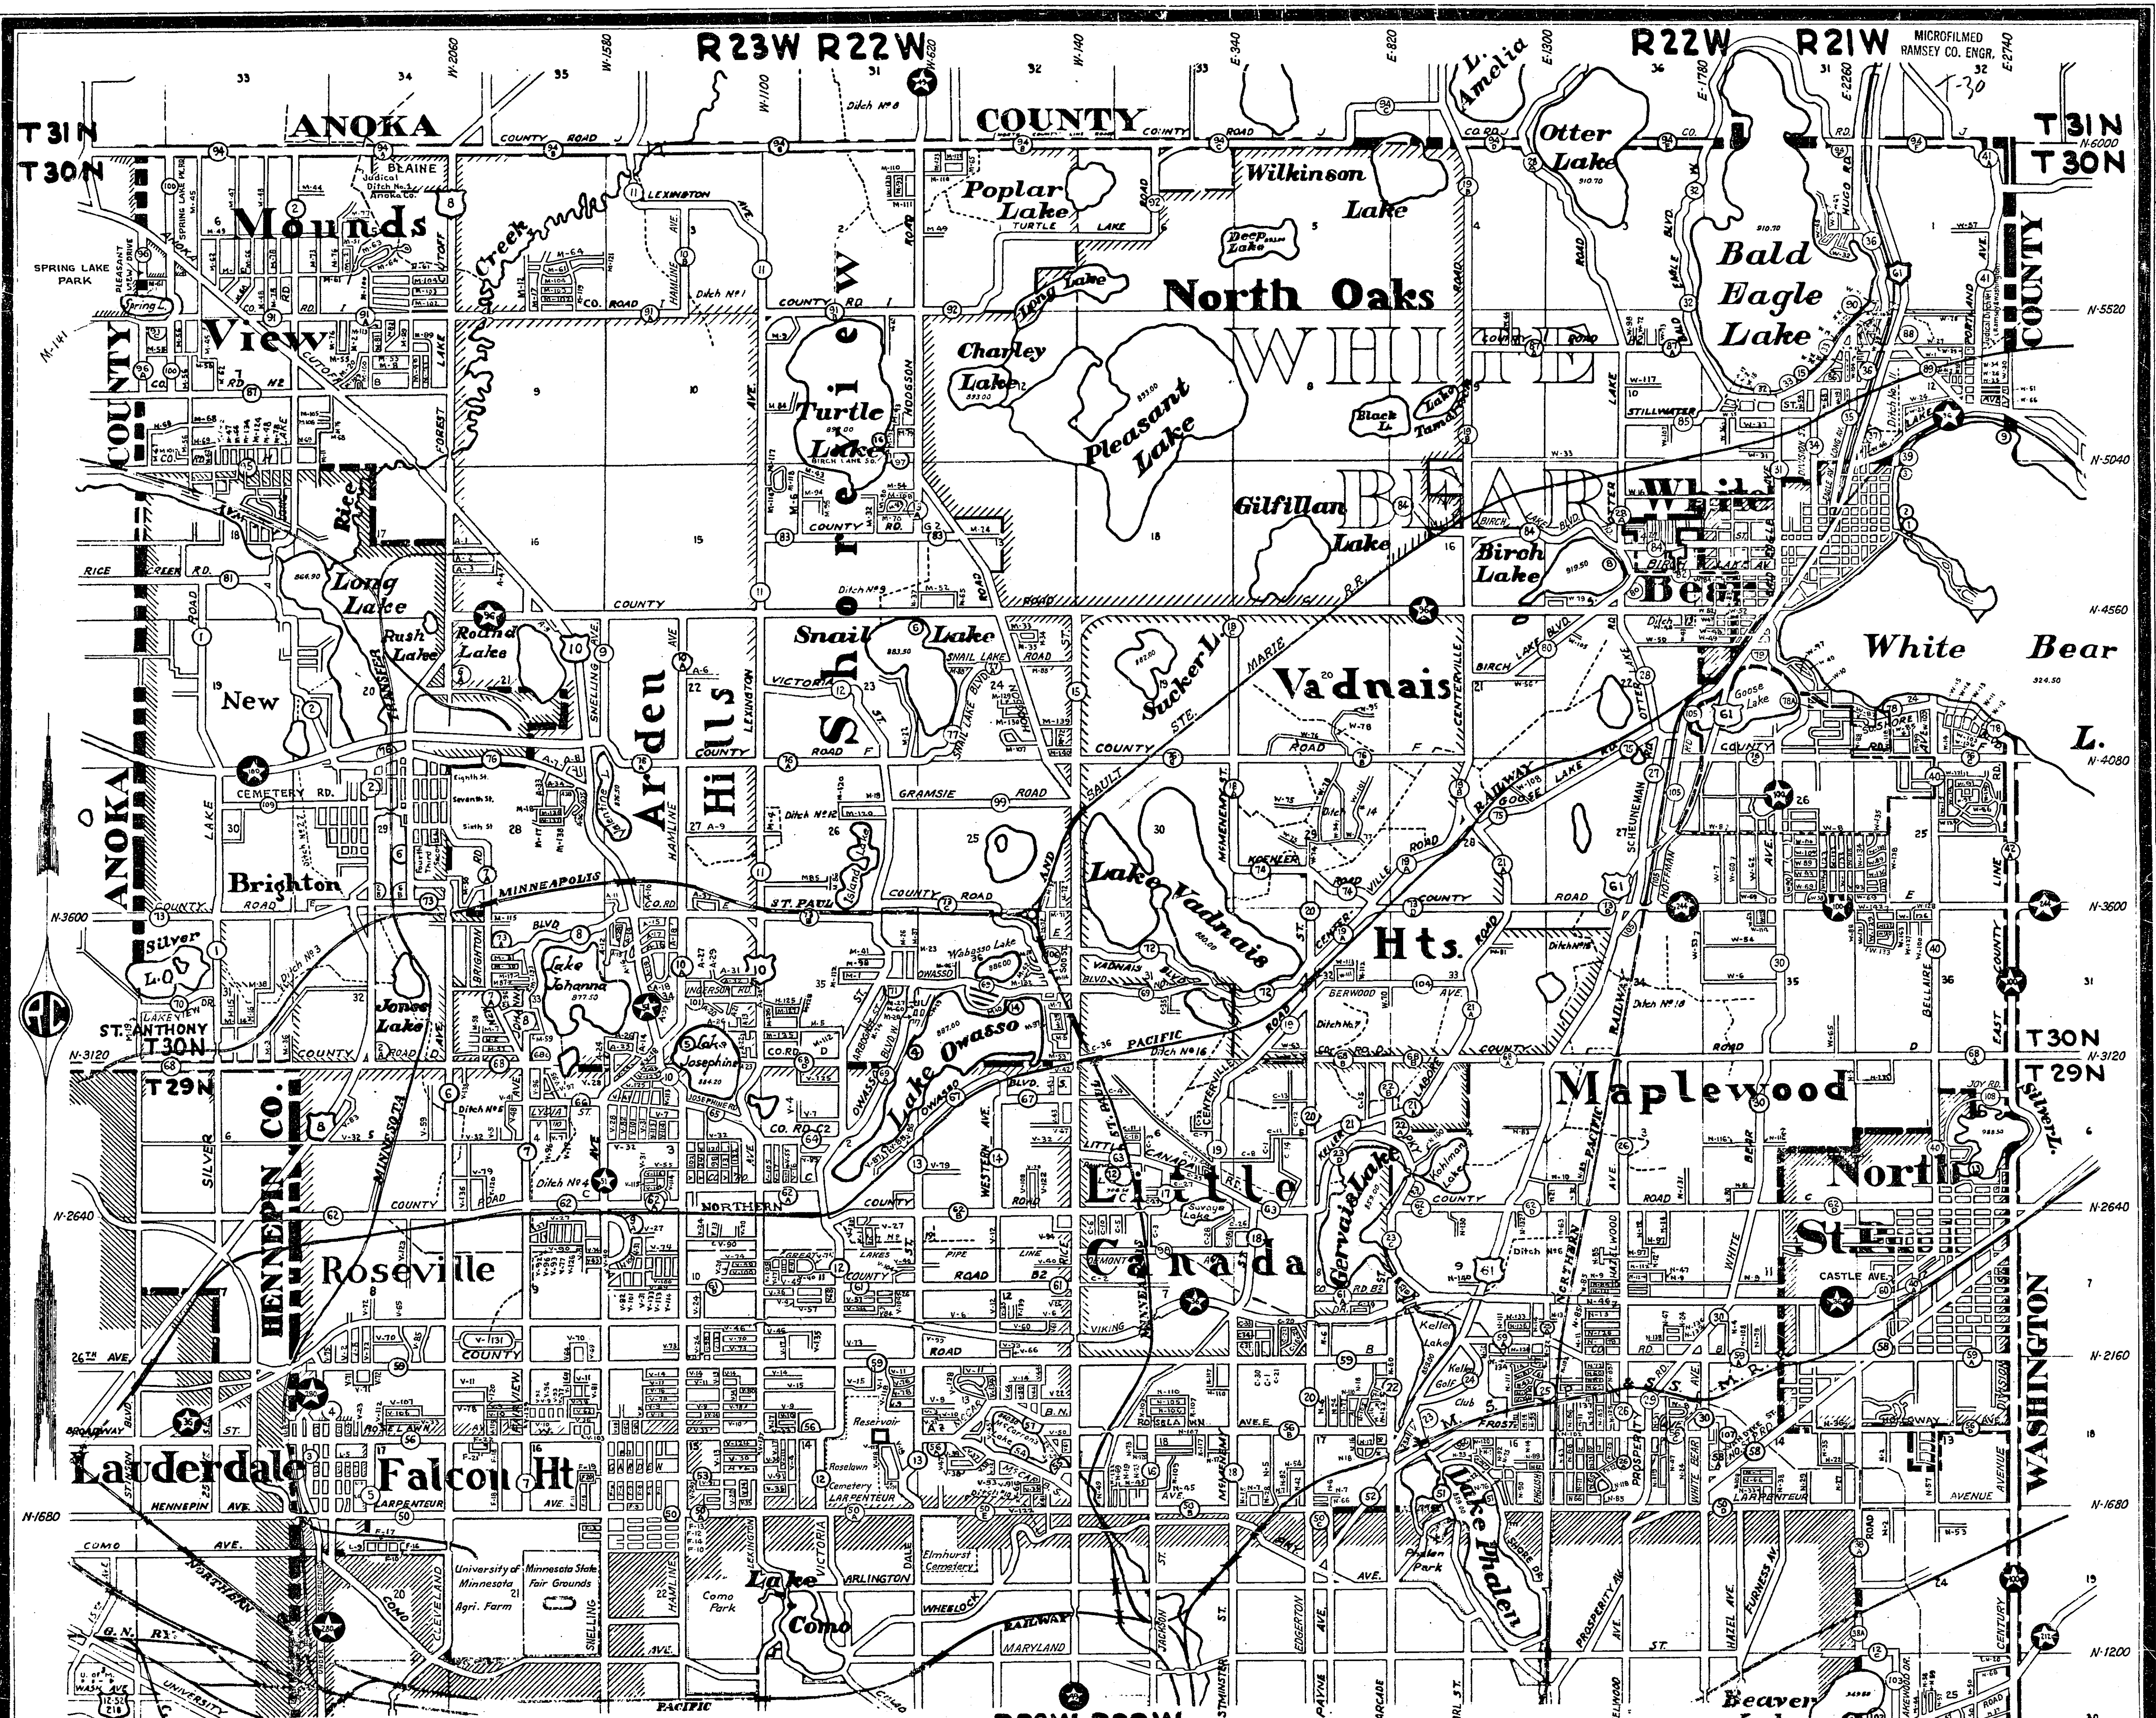

MOUNDS VIEW				(VILLAGE OF) ROSEVILLE				WHITE BEAR				MAPLEWOOD					
NO.	NAME	SEC.	NO.	NAME	SEC.	NO.	NAME	SEC.	NO.	NAME	SEC.	NO.	NAME	SEC.	NO.	NAME	SEC.
M-1	Arbogast St.	35	M-81	Adams St.	8	V-1	Aven St.	11-4	V-81	Fry St.	9-4	W-1	Fourth St.	12	W-81	Einum Rd.	33
M-2	Greenfield Ave.	5-8	M-82	Ericksen Rd.	8	V-2	St. Croix St.	12	V-82	Arno Ave.	10-15	W-2	Fourth St.	12	W-82	Fourth Ave.	14-23
M-3	Pass Rd.	31	M-83	Maywood St.	16	V-3	Trask St.	13	V-83	Trask St.	13	W-3	Myrtle St.	11	W-83	Myrtle St.	11
M-4	Kaaski Rd.	26	M-84	Nelson Drive	26	V-4	Chatsworth St.	21-14	V-84	Grota St.	11	W-4	McKnight Rd.	1	W-84	McKnight Rd.	1
M-5	Edgewater Ave.	33-36	M-85	Island Lake Ave.	26	V-5	Arthur Place	4	V-85	Acorn Rd.	8	W-5	Van Dyke Ave.	11	W-85	Webster St.	14
M-6	Hickson Rd.	14	M-86	Milton St.	33	V-6	Minnesota Ave.	12	V-86	Owasso Blvd. So.	2	W-6	De Soto St.	17	W-86	Floral Drive	24
M-7	Jennell Ave.	33-36	M-87	Lake Lane	33	V-7	Willow Ave.	2-34	V-87	Heinl Drive	2	W-7	Payne Ave.	8-17	W-87	Floral Drive	24
M-8	Lambert Ave.	8	M-88	Snail Lake Rd.	24	V-8	St. Stephen St.	13	V-88	McOwasso Ct.	2	W-8	De Soto St.	17	W-88	Payne Ave.	23
M-9	Long Lake Ave.	31	M-89	Belle Lane	8	V-9	Shryver Ave.	13-15	V-89	Waverly Rd.	24	W-9	Kingston St.	10	W-89	McKnight Rd.	1
M-10	Marshall Ave.	36	M-90	Clifton Dr.	8	V-10	Ryan Ave.	14-15	V-90	Oakcrest Ave.	9-10	W-10	Rosewood Ave.	15	W-90	Garvey Ave.	10-11
M-11	Ironclad Rd.	31	M-91	Raymond Ave.	8	V-11	Eldridge Ave.	13-14	V-91	Roma Ave.	10-14	W-11	Garvey Ave.	10-11	W-91	Garvey Ave.	10-11
M-12	Schultz Rd.	4	M-92	Alameda St.	2-11	V-12	Western Ave.	12-13	V-92	Beacon St.	9-16	W-12	Kohlman Ave.	3-4	W-92	Kohlman Ave.	3-4
M-13	Capeau Rd.	18	M-93	St. Albans St.	2-11	V-13	Fernwood Ave.	3-15	V-93	Herschel St.	9-16	W-13	Birmingham St.	10-15	W-93	Birmingham St.	10-15
M-14	Sunrise Lane	31	M-94	Robinson Place	34	V-14	Burke Ave.	15-16	V-94	Waverly Rd.	24	W-14	Germain St.	10	W-94	Germain St.	10
M-15	Westfield Dr.	31	M-95	Nottingham Pl.	31	V-15	Parker Ave.	17-18	V-95	Shorewood Lane	24	W-15	Adams Ave.	15	W-95	Adams Ave.	15
M-16	Valley View Dr.	31	M-96	Beckman Ave.	31	V-16	Lakeview Ave.	2	V-96	Wheeler St.	9-14	W-16	Adams Ave.	15	W-96	Adams Ave.	15
M-17	Fairview Ave.	4-33	M-97	Woodbridge St.	36	V-17	Oxford St.	2-14	V-97	Shorewood Curve	4	W-17	Adams Ave.	15	W-97	Adams Ave.	15
M-18	Granville Rd.	26-28	M-98	Cannon Ave.	35	V-18	County Road D	3	V-98	Merrill St.	9-10	W-18	Adams Ave.	15	W-98	Adams Ave.	15
M-19	Sinclair Blvd.	31	M-99	Quincy St.	5-8	V-19	Alta Vista Drive	10-11	V-99	Service Drive	12	W-19	Adams Ave.	15	W-99	Adams Ave.	15
M-20	St. Stephen St.	8	M-100	Jackman St.	8	V-20	Dunlap St.	16	V-100	Sextant Ave.	10	W-20	Adams Ave.	15	W-100	Adams Ave.	15
M-21	Central Ave.	18	M-101	Springview Lane	7	V-21	Kent St.	13	V-101	Simpson St.	10-13	W-21	Adams Ave.	15	W-101	Adams Ave.	15
M-22	Redland Lane	23	M-102	Pineview Drive	4-5	V-22	Elmer St.	13	V-102	Huron St.	13	W-22	Adams Ave.	15	W-102	Adams Ave.	15
M-23	Harriet Ave.	35	M-103	Terrace Drive	4-5	V-23	Lake St.	17	V-103	Midway Rd.	11	W-23	Adams Ave.	15	W-103	Adams Ave.	15
M-24	County Road G	13	M-104	Oakwood Drive	4-5	V-24	Dallwood St.	3-10-15	V-104	St. Albans St.	11	W-24	Adams Ave.	15	W-104	Adams Ave.	15
M-25	Sea St.	36	M-105	Clearview Ave.	8	V-25	Hall Ave.	12	V-105	Churchill St.	2-11	W-25	Adams Ave.	15	W-105	Adams Ave.	15
M-26	Owasso St.	35	M-106	Ridge Lane	8	V-26	Grandview Ave.	11-12	V-106	Rosewood Lane S.	17	W-26	Adams Ave.	15	W-106	Adams Ave.	15
M-27	Owasso Hills Rd.	36	M-107	Floral Drive West	24	V-27	Rose Place	9-10	V-107	Madison Ave.	1	W-27	Adams Ave.	15	W-107	Adams Ave.	15
M-28	Owasso Hills Rd.	36	M-108	Woodland Drive	14	V-28	Assury Ave.	3-15	V-108	Madilla Ave.	1	W-28	Adams Ave.	15	W-108	Adams Ave.	15
M-29	Owasso Hills Rd.	36	M-109	Pineview Court	36	V-29	Center St.	13	V-109	Polson Curve	3	W-29	Adams Ave.	15	W-109	Adams Ave.	15
M-30	Noble Rd.	33	M-110	Emil Ave.	1-2	V-30	Ruggles St.	14-15	V-110	Blomquist Ave.	4	W-30	Adams Ave.	15	W-110	Adams Ave.	15
M-31	Grant Rd.	33	M-111	Bucher Ave.	2	V-31	N. Pascar Ave.	3-10-15	V-111	Aglen St.	2-14-11	W-31	Adams Ave.	15	W-111	Adams Ave.	15
M-32	Larson Rd.	14	M-112	Vivian Ave.	35	V-32	County Road C	13-14	V-112	Shiloh Hills Rd.	1	W-32	Adams Ave.	15	W-112	Adams Ave.	15
M-33	Graber St.	24	M-113	Graber St.	24	V-33	Draper Ave.	17-18	V-113	N. Albert St.	3-40	W-33	Adams Ave.	15	W-113	Adams Ave.	15
M-34	Galt St.	24	M-114	Grand Ave.	34	V-34	Lindsey St.	15	V-114	Sheldon St.	3-40	W-34	Adams Ave.	15	W-114	Adams Ave.	15
M-35	Lion Lane	36	M-115	Hudson Ave.	33	V-35	Dionne St.	13-14-15	V-115	Primrose Curve	3	W-35	Adams Ave.	15	W-115	Adams Ave.	15
M-36	Higginbotham Rd.	31	M-116	Johns Rd.	14	V-36	Midway Rd.	11	V-116	Rambler Rd.	3	W-36	Adams Ave.	15	W-116	Adams Ave.	15

	
---	--	--	