



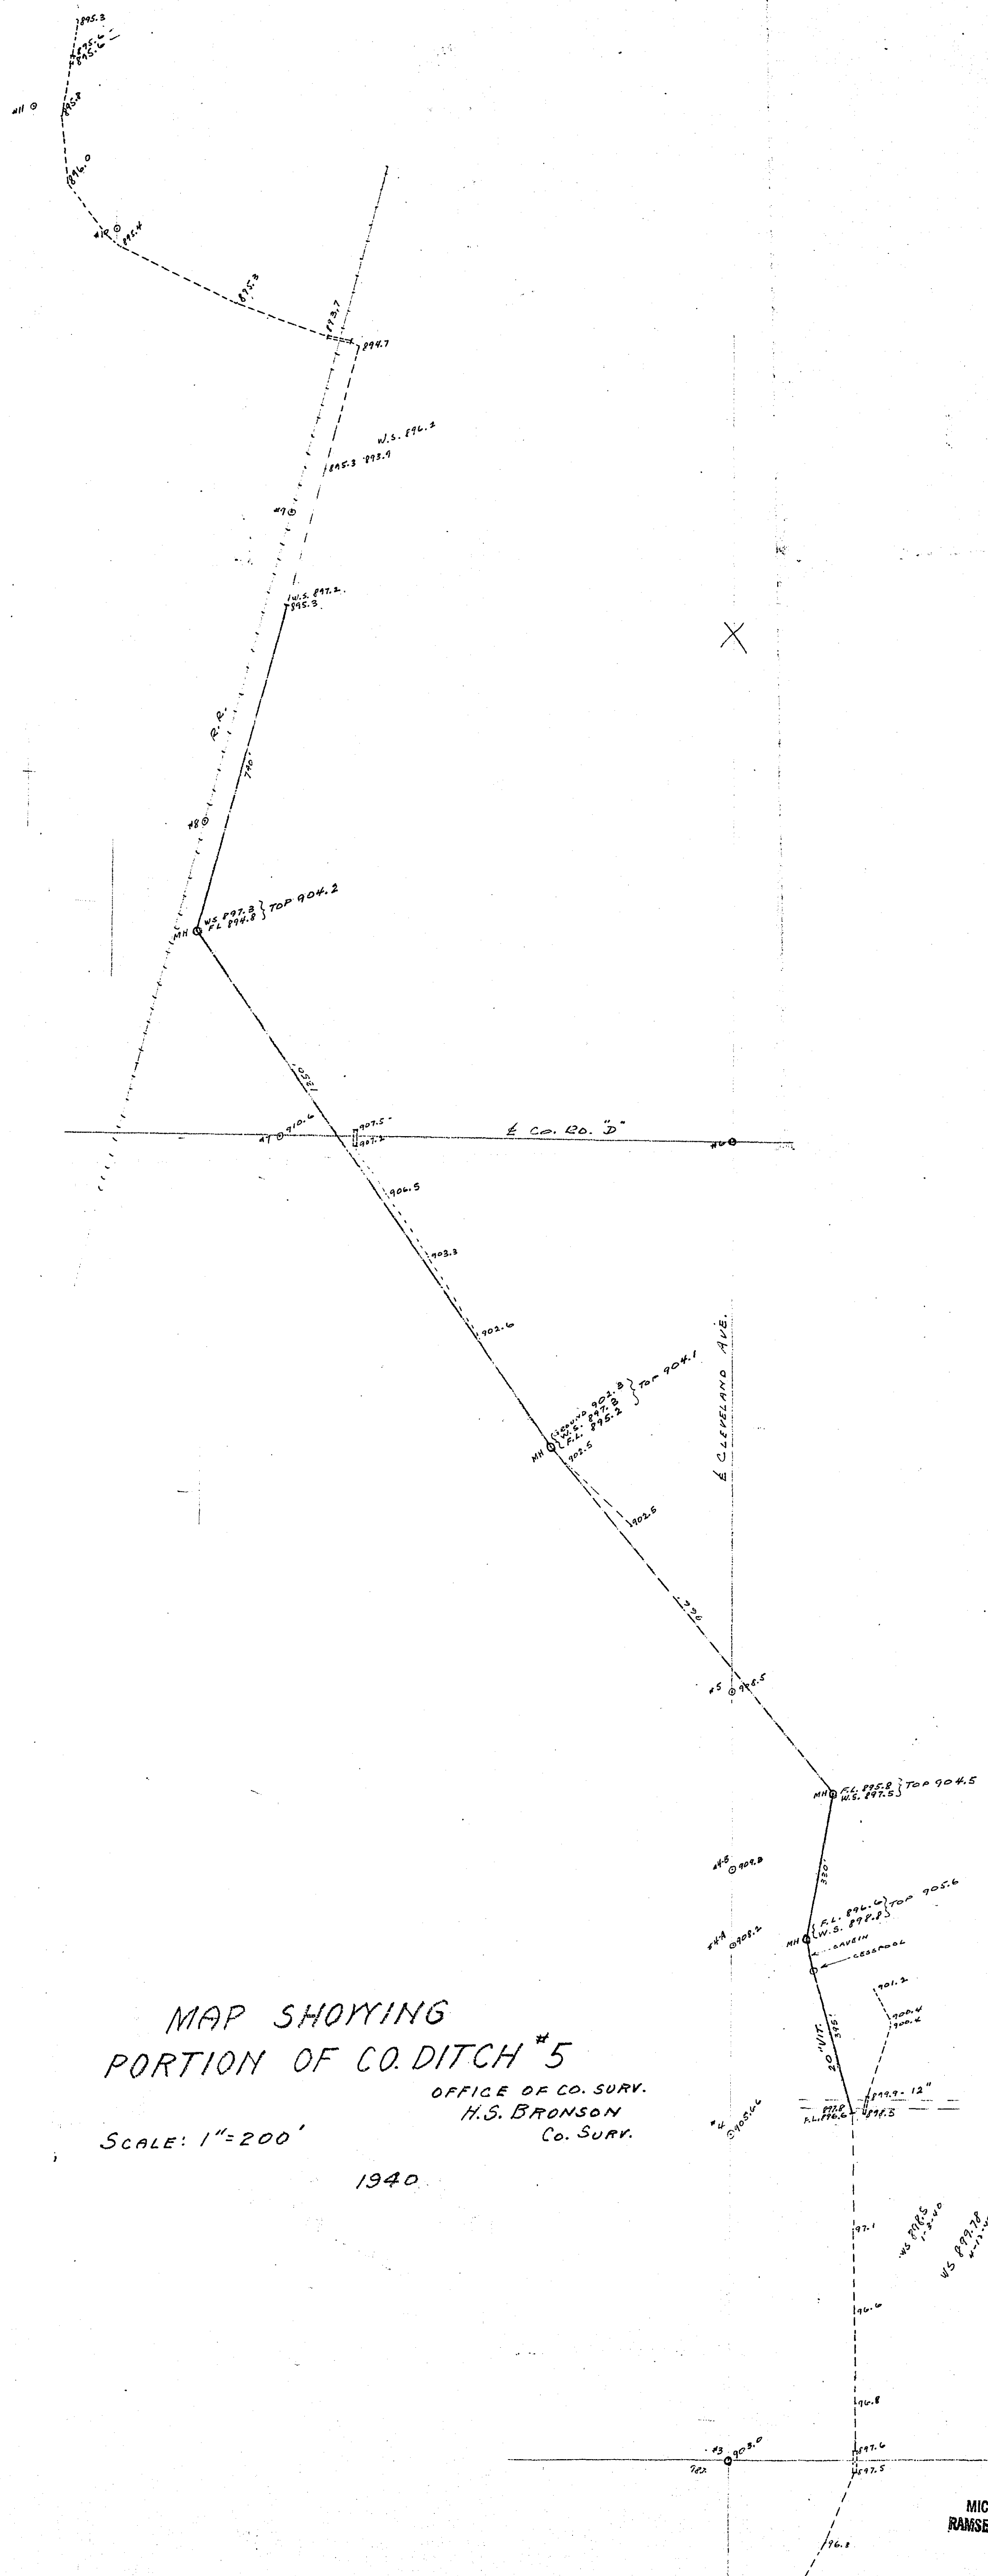

MAP SHOWING
 PORTION OF CO. DITCH #5
 OFFICE OF CO. SURV.
 H.S. BRONSON
 CO. SURV.
 SCALE: 1"=200'
 1940

T-47

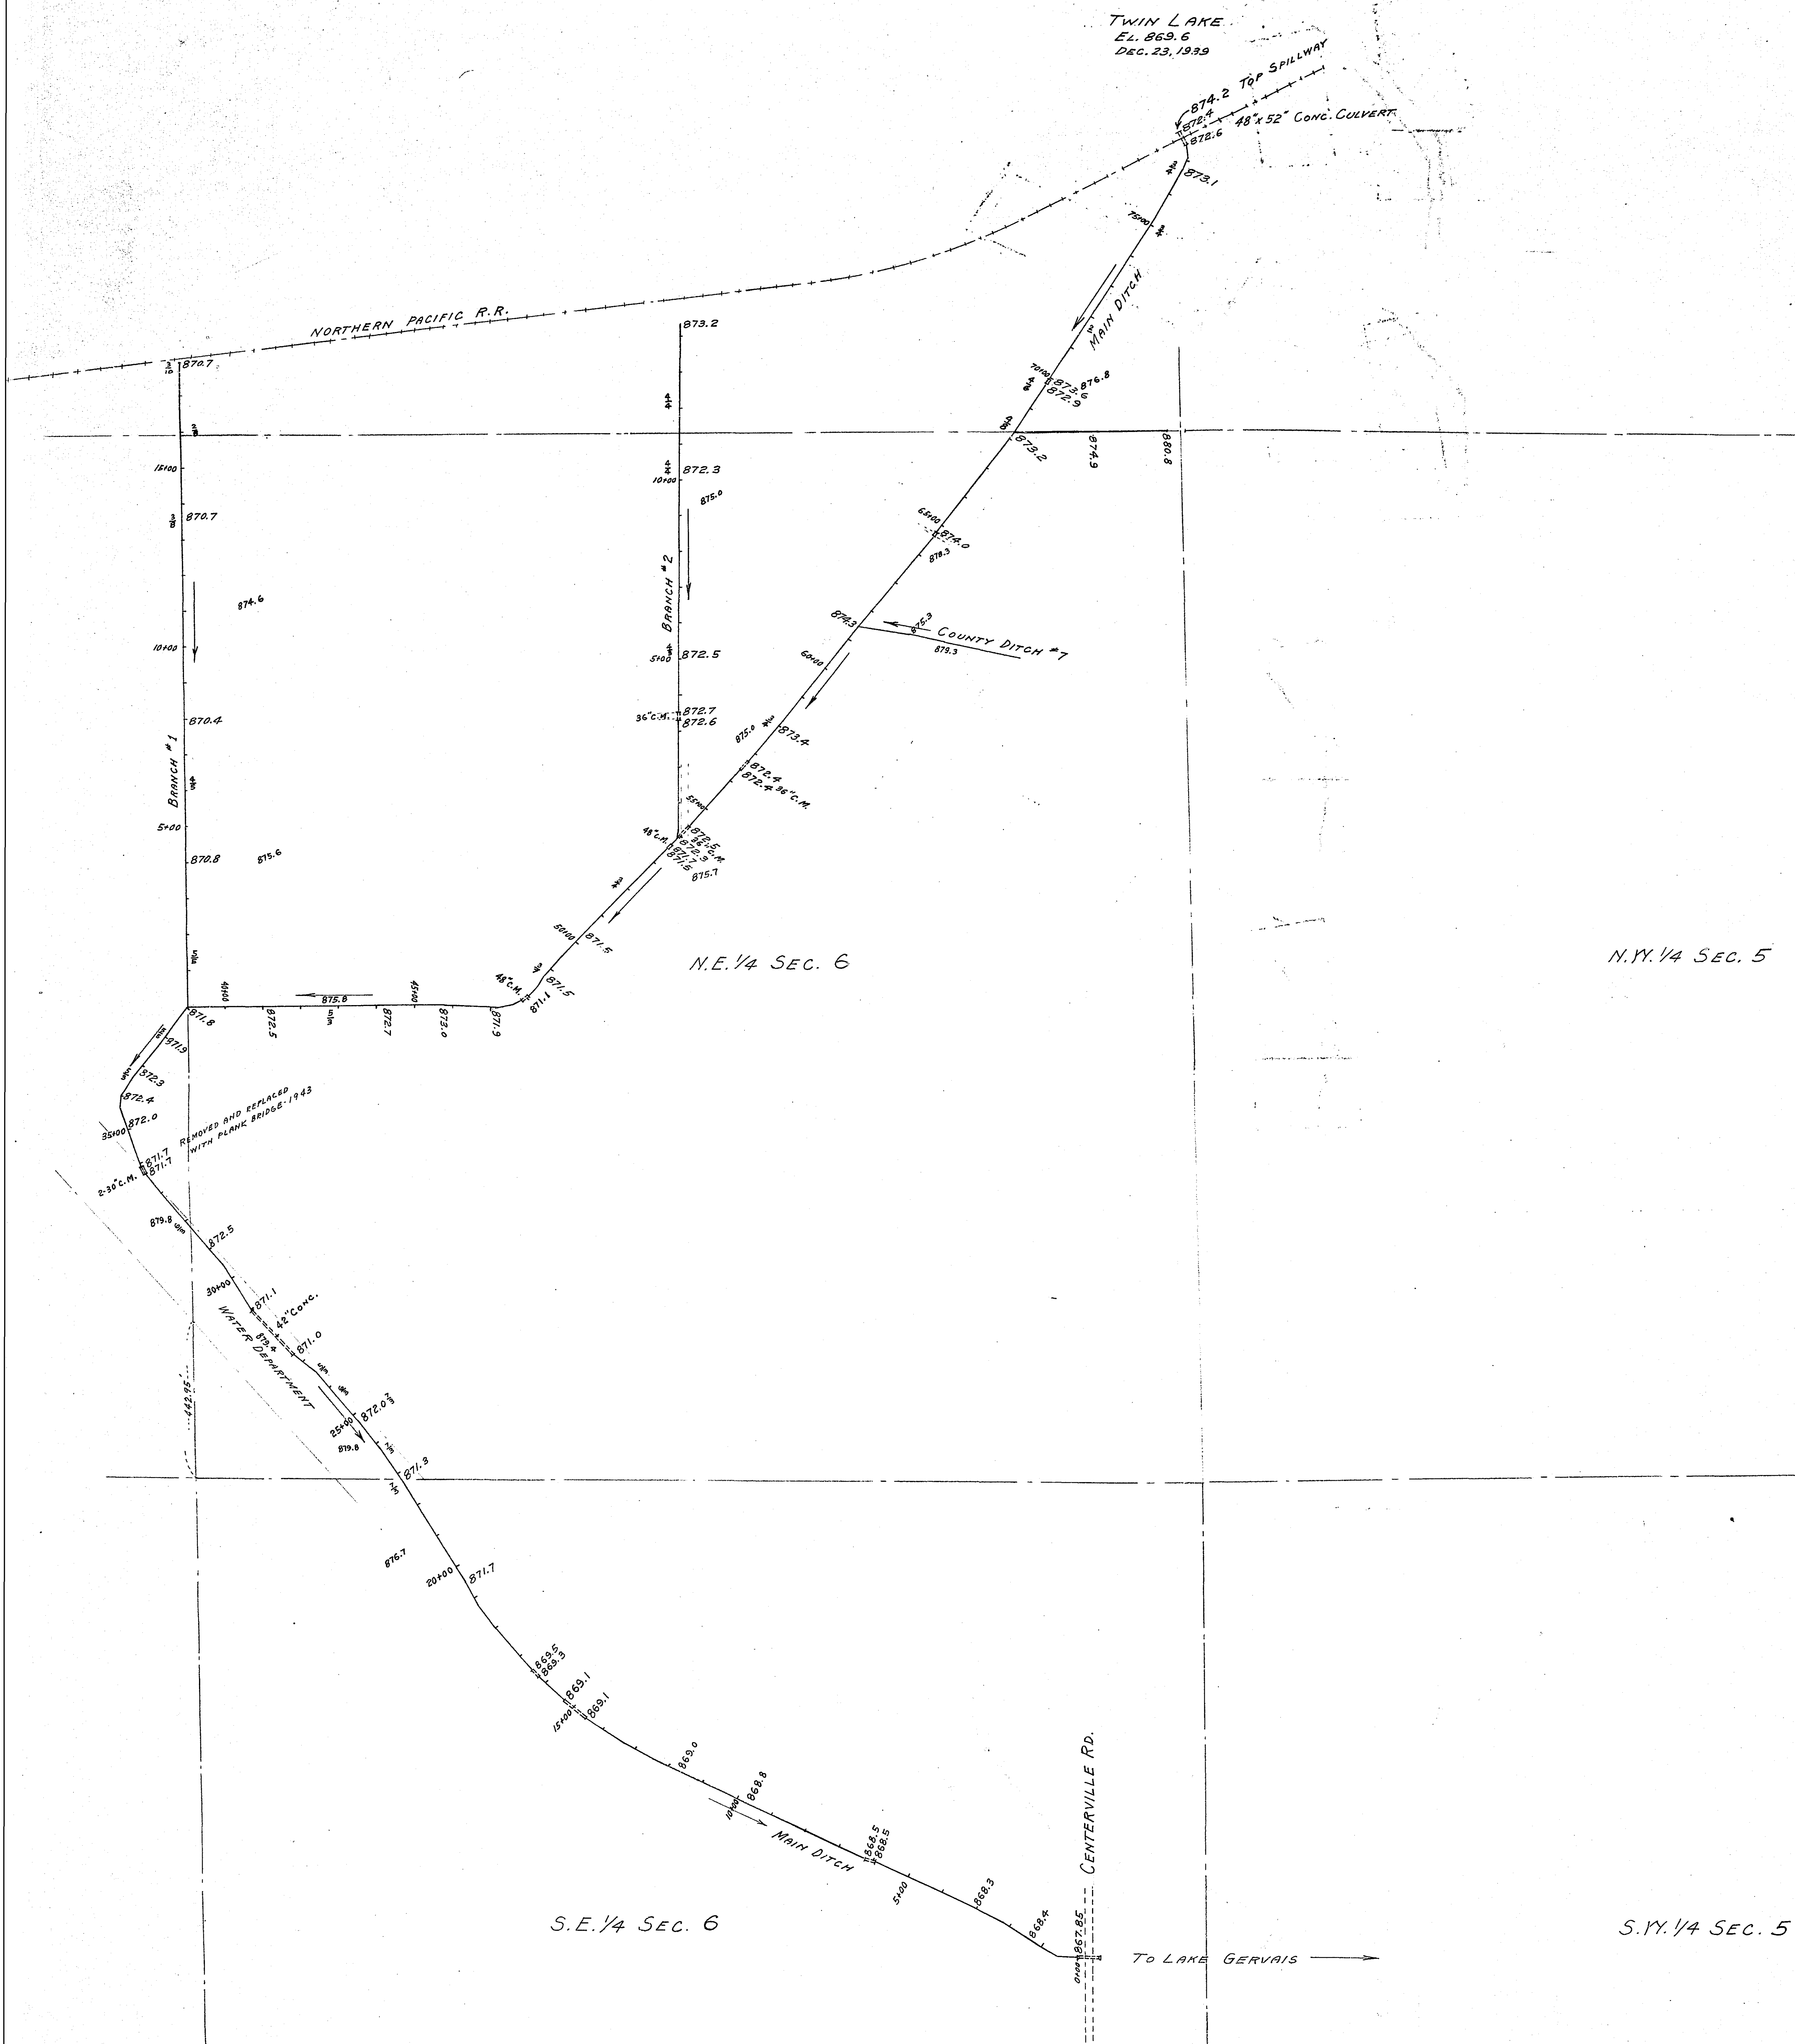

OFFICE OF
RAMSEY COUNTY SURVEYOR
MAP
SHOWING LOCATION
COUNTY DITCH No 16
H.S. BRONSON
Co. SURVEYOR

SCALE: 1 IN. = 200 FT.
U.S.G.S. DATUM

FEB. 1940

T-47


PLAN	SURVY	DATE
NO.	BY	
NOTE: BORING ALUMINUM CHECKS		
NO. OF HAN. CHECKS		

0+00 DITCH No 7=
97+55 DITCH No 16


DITCH No 16

Sta. 8+51.3 to 8+60.6
Inp. Conc. Apron 8' Wide

Sta. 8+60.6 to 9+27.43
Inp. 48"x 66.73 S.C. Culv.

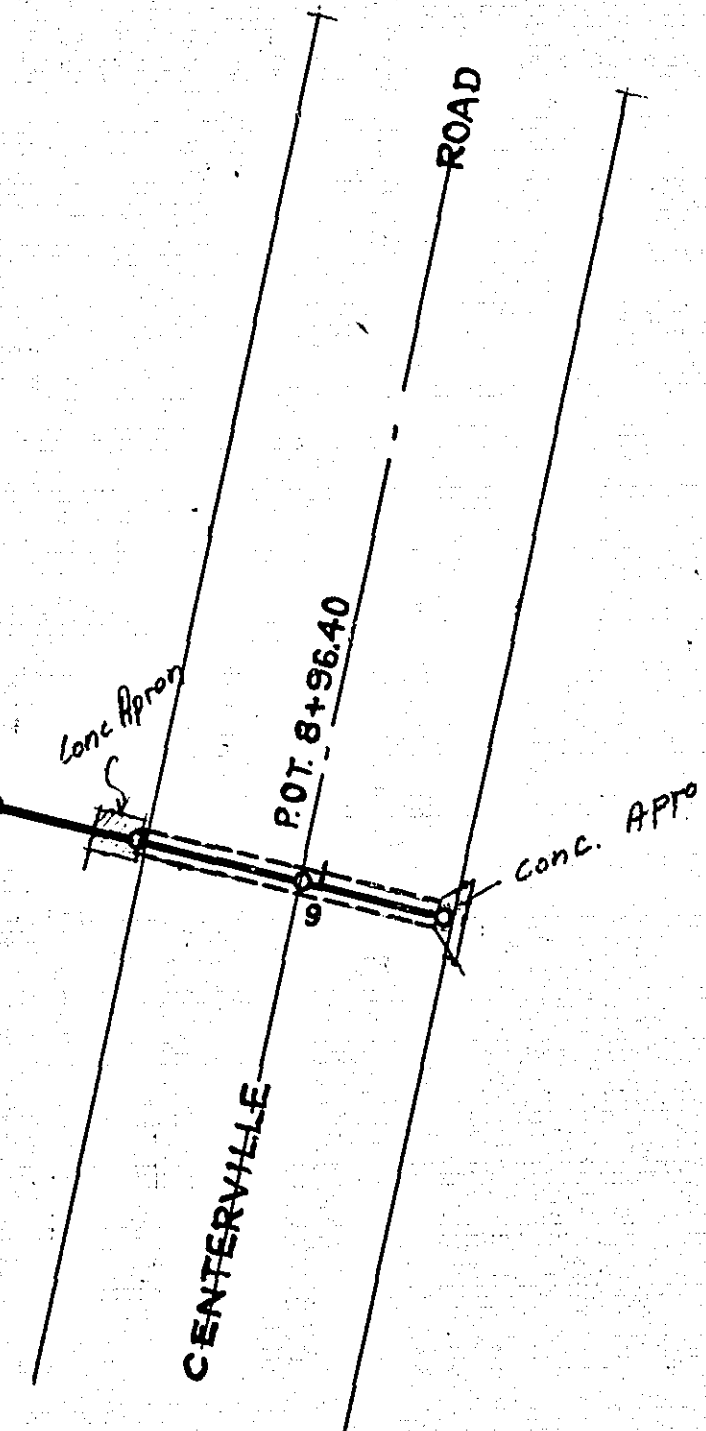

PROFILE	SURVY	DATE
NO.	BY	
NOTE: BORING ALUMINUM CHECKS		
NO. OF HAN. CHECKS		

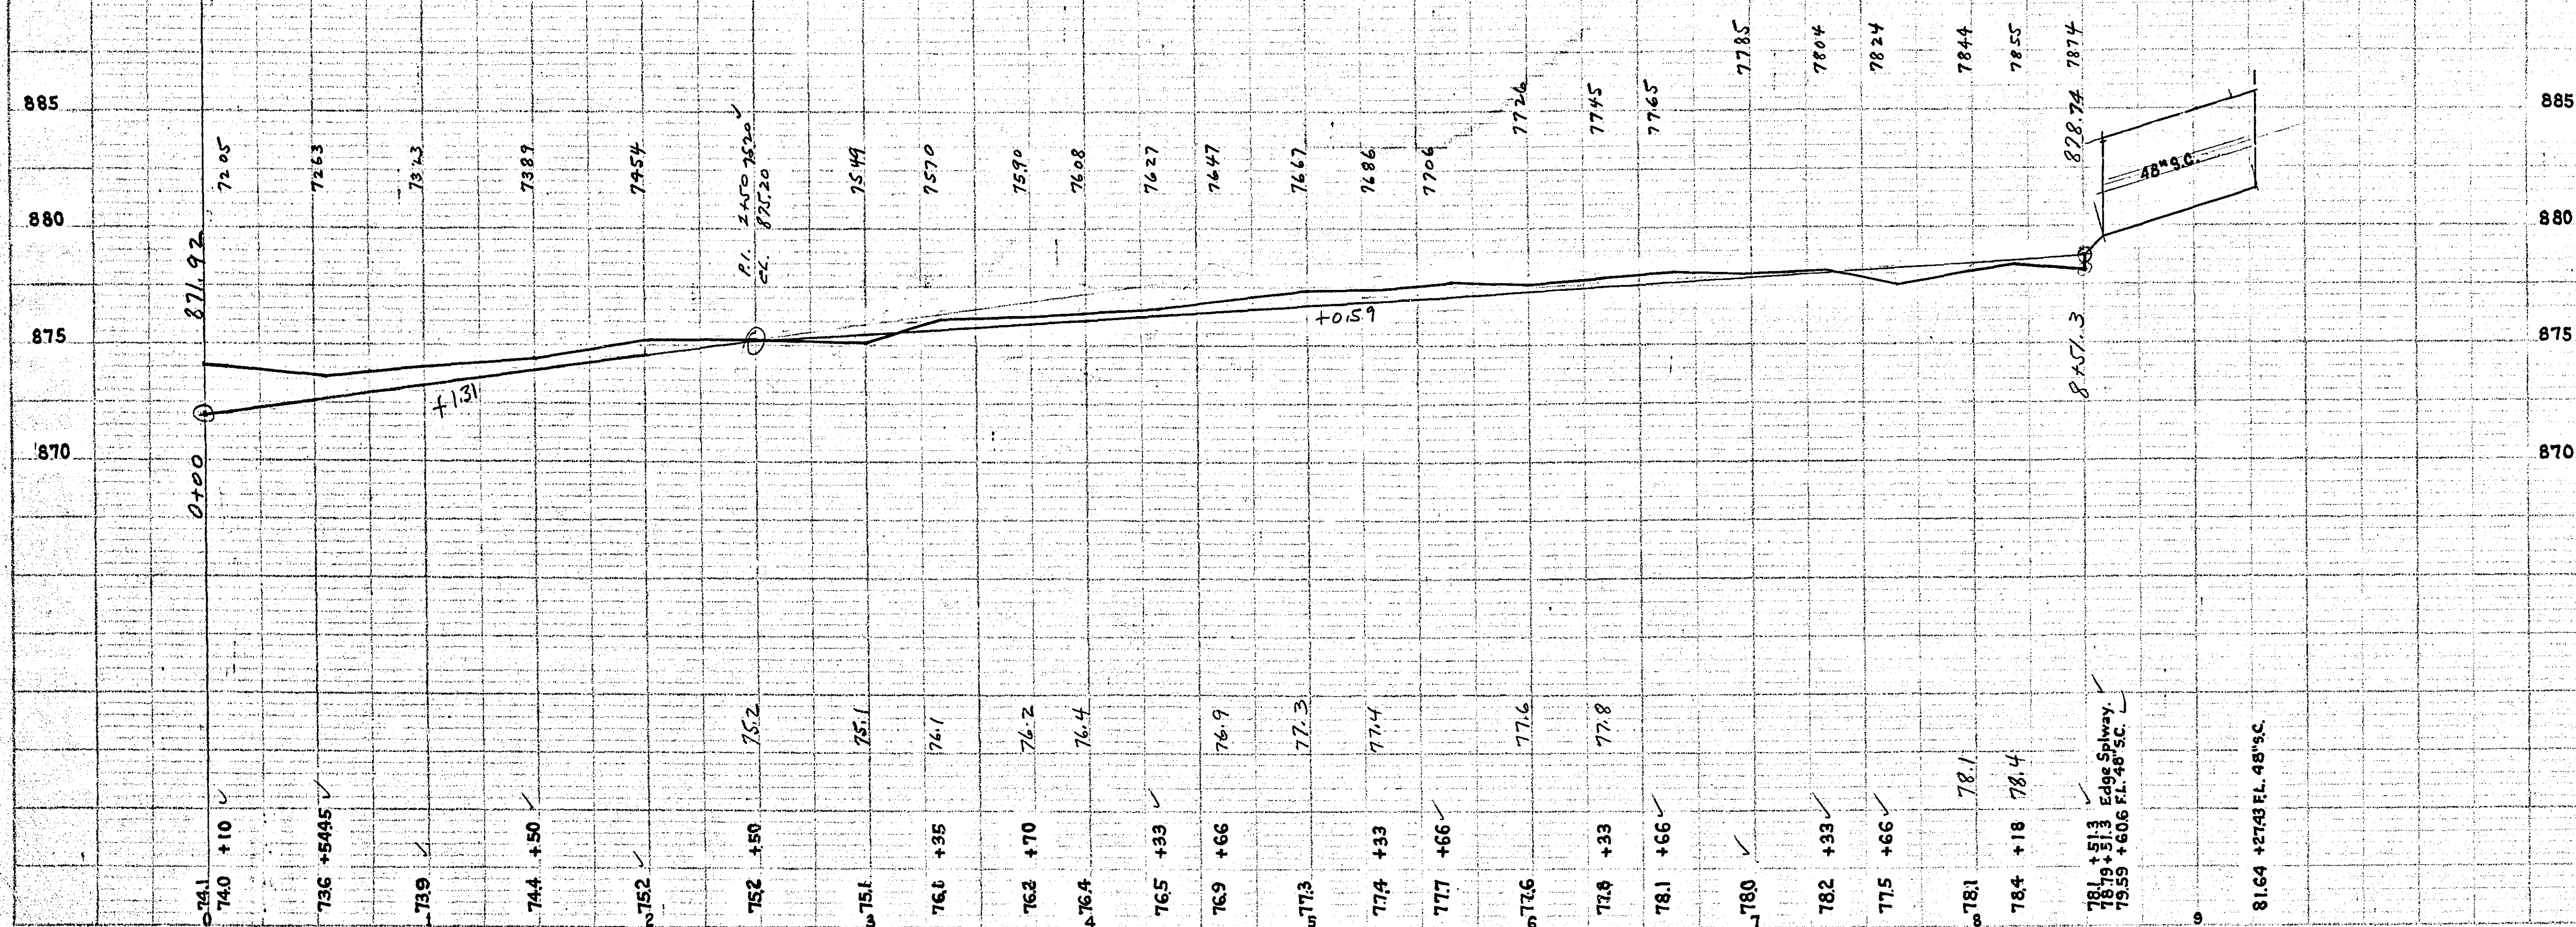

T-47

MICROFILMED
RAMSEY CO. ENGR.

DITCH 7