

REGISTERED LAND SURVEY NO. 198

198

452219 ORIGINAL


OFFICE OF REGISTRAR OF TITLES
RAMSEY COUNTY, MINNESOTA

I hereby certify that the within Registered Land Survey No. 198
File of Registrar of Titles, Ramsey County, was filed in this office
On 21 day of Jan A.D. 1963 at 2:30 o'clock P.M.

ROBERT T. GIBBONS

Registrar of Titles

J. X. Miller
Surveyor

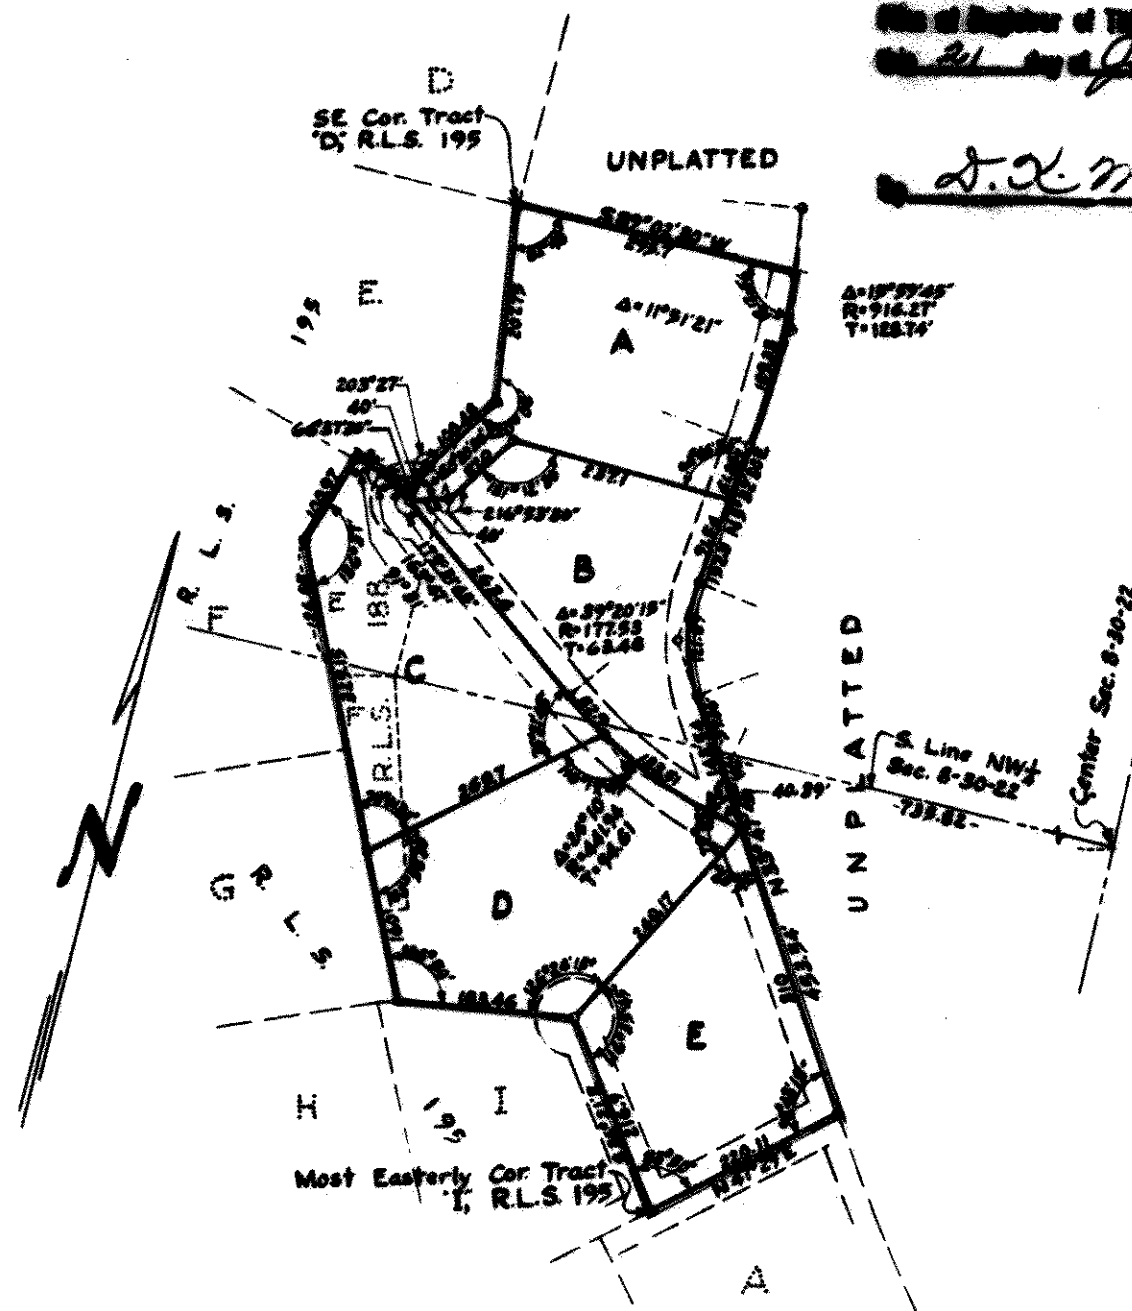

I hereby certify that in accordance with the provisions of Chapter 508, Minnesota Statutes of 1949 as amended, I have surveyed the following described tract of land in the County of Ramsey State of Minnesota to wit: Part of Tracts "E" and "F" Registered Land Survey No. 188 and that part of the West 1/2 of Section 8, Town 30 N, Range 22 W lying Easterly of Registered Land Survey No. 195 and westerly of the following described line; Commencing at the most Easterly corner of Tract "I" Registered Land Survey No. 195, for descriptive purposes only, the Northeasterly line of said Tract "I" has a bearing of S 36°21' E; thence N 47°29' E 220.11 feet; thence N 33° 47'45" W 453.54 feet; thence on a curve to the right central angle of 39°20'15" radius of 177.53 feet for a distance of 121.89 feet; thence N 5°32'30" E 152.8 feet; thence on a curve to the left central angle of 11°51'21" radius of 916.27 feet for 189.33 feet; thence S 89°02'30" W 295.7 feet to the Southeast corner of Tract "D" Registered Land Survey No. 195 and there terminating; that the survey shown herein is a correct delineation of said survey.

This 4th day of January 1963.

0 indicates iron monument

Scale 1" = 200'

Donald J. Cady
Registered Surveyor No. 3527

Accepted and Approved this 16th day of Jan 1963.

Alvah B. Crampton) Plat
Frederick B. Crampton) Commission
Frederick B. Crampton)
William Rosen
Commissioner of Public Works

Approved by the Village Council of the Village of North Oaks, Minnesota, this 10th day of January A.D. 1963.

Stanley A. Shale
Mayor
Sally A. Shale
Village Clerk