

REARRANGEMENT OF BLOCKS 62, 67, 68 AND LOT 1 OF BLOCK 75 ST ANTHONY PARK

No 123663
 STATE OF MINNESOTA } ss
 County of Ramsey }
 Office of the Register of Deeds.
 This is to certify that the within instrument was filed for Record in this Office, at St. Paul, on the 18th day of September, A. D. 1890, at 7 o'clock P. M., and that the same was duly recorded in Book 123, page 663.
 By: *Wm. J. Lee*
 Register of Deeds.

I hereby certify to having surveyed and platted the property described on this map as Rearrangement of Blocks 62, 67, 68 and Lot 1 of Block 75 St Anthony Park, and have placed iron monuments at the corners of the Blocks as shown on this map and the same is correct.

State of Minnesota } ss
 County of Ramsey } On this 4th day of August, A. D. 1890 personally appeared before me *George W. Smith* a man well known and acknowledged, that he executed the foregoing certificate as his own free act and deed.

W. H. Pratt
 Notary Public, Ramsey County, Minnesota

This is to certify that the St Anthony Park Company, a corporation organized and existing under and by virtue of the laws of the State of Minnesota, owner of the land included in this plat, and described as follows, to-wit: Commencing at a point on the East line of Raymond Avenue where said line is intersected by the line between Lots 1 and 2 Block 75, St. Anthony Park; thence Northerly on a line parallel to and 55 feet Easterly from the centre line of said Raymond Avenue to the Southerly line of the right of way of the St. Paul and Northern Pacific Railway; thence Southerly along the Southerly line of said right of way to the West line of Hersey Avenue; thence Southerly along the West line of said Hersey Avenue to the Northerly line of Endicott Street; thence Westerly along the Northerly line of said Endicott Street to the Centre of Dudley Street; thence Westerly along the centre line of Dudley Street to the centre of the alley between Blocks 74 and 75; thence Southerly along the centre of said alley to a point where the line between Lots 1 and 2, Block 75 if extended Easterly would intersect the centerline of said alley; thence Westerly to the place of beginning, have caused the same to be platted and hereafter known as Rearrangement of Blocks 62, 67, 68 and Lot 1 of Block 75, St. Anthony Park, as shown by this plat, and hereby dedicate to the public and for the public use forever all streets, avenues and alleys as shown on this plat except Private Rail Road Alleys, which are dedicated for sewerage purposes only. Witness our hands and seal this 4th day of August, A. D. 1890.

In Presence of
C. J. Harty
 State of Minnesota } ss
 County of Ramsey } On this 4th day of August, A. D. 1890 before me appeared Charles H. Pratt & Anson Blake both personally known who being by me duly sworn did say that they are the President and Secretary of the St Anthony Park Company and that the seal affixed to said instrument is the Corporate seal of said Corporation and that said instrument was signed and sealed in behalf of said Corporation by authority of its board of directors and said Charles H. Pratt and Anson Blake acknowledged said instrument to be the free act and deed of said Corporation.


W. H. Pratt
 Notary Public, Ramsey County, Minnesota

J. John Miller
 Iana do hereby consent to the platting of said land as above indicated and the dedication to the public of the streets and alleys shown thereon.
John Miller

State of Minnesota } ss
 County of Ramsey } On this 18 day of Sept A. D. 1890 before me appeared *J. John Miller* to me well known and acknowledged that he executed the above certificate as his free act and deed.
Wm. B. Bebb
 Notary Public, Ramsey County, Minnesota

Accepted and approved this 13th day of September, A. D. 1890

Wm. J. Lee } Plat Commissioners.
William E. Dunton }
Wm. J. Lee } City Engineer.

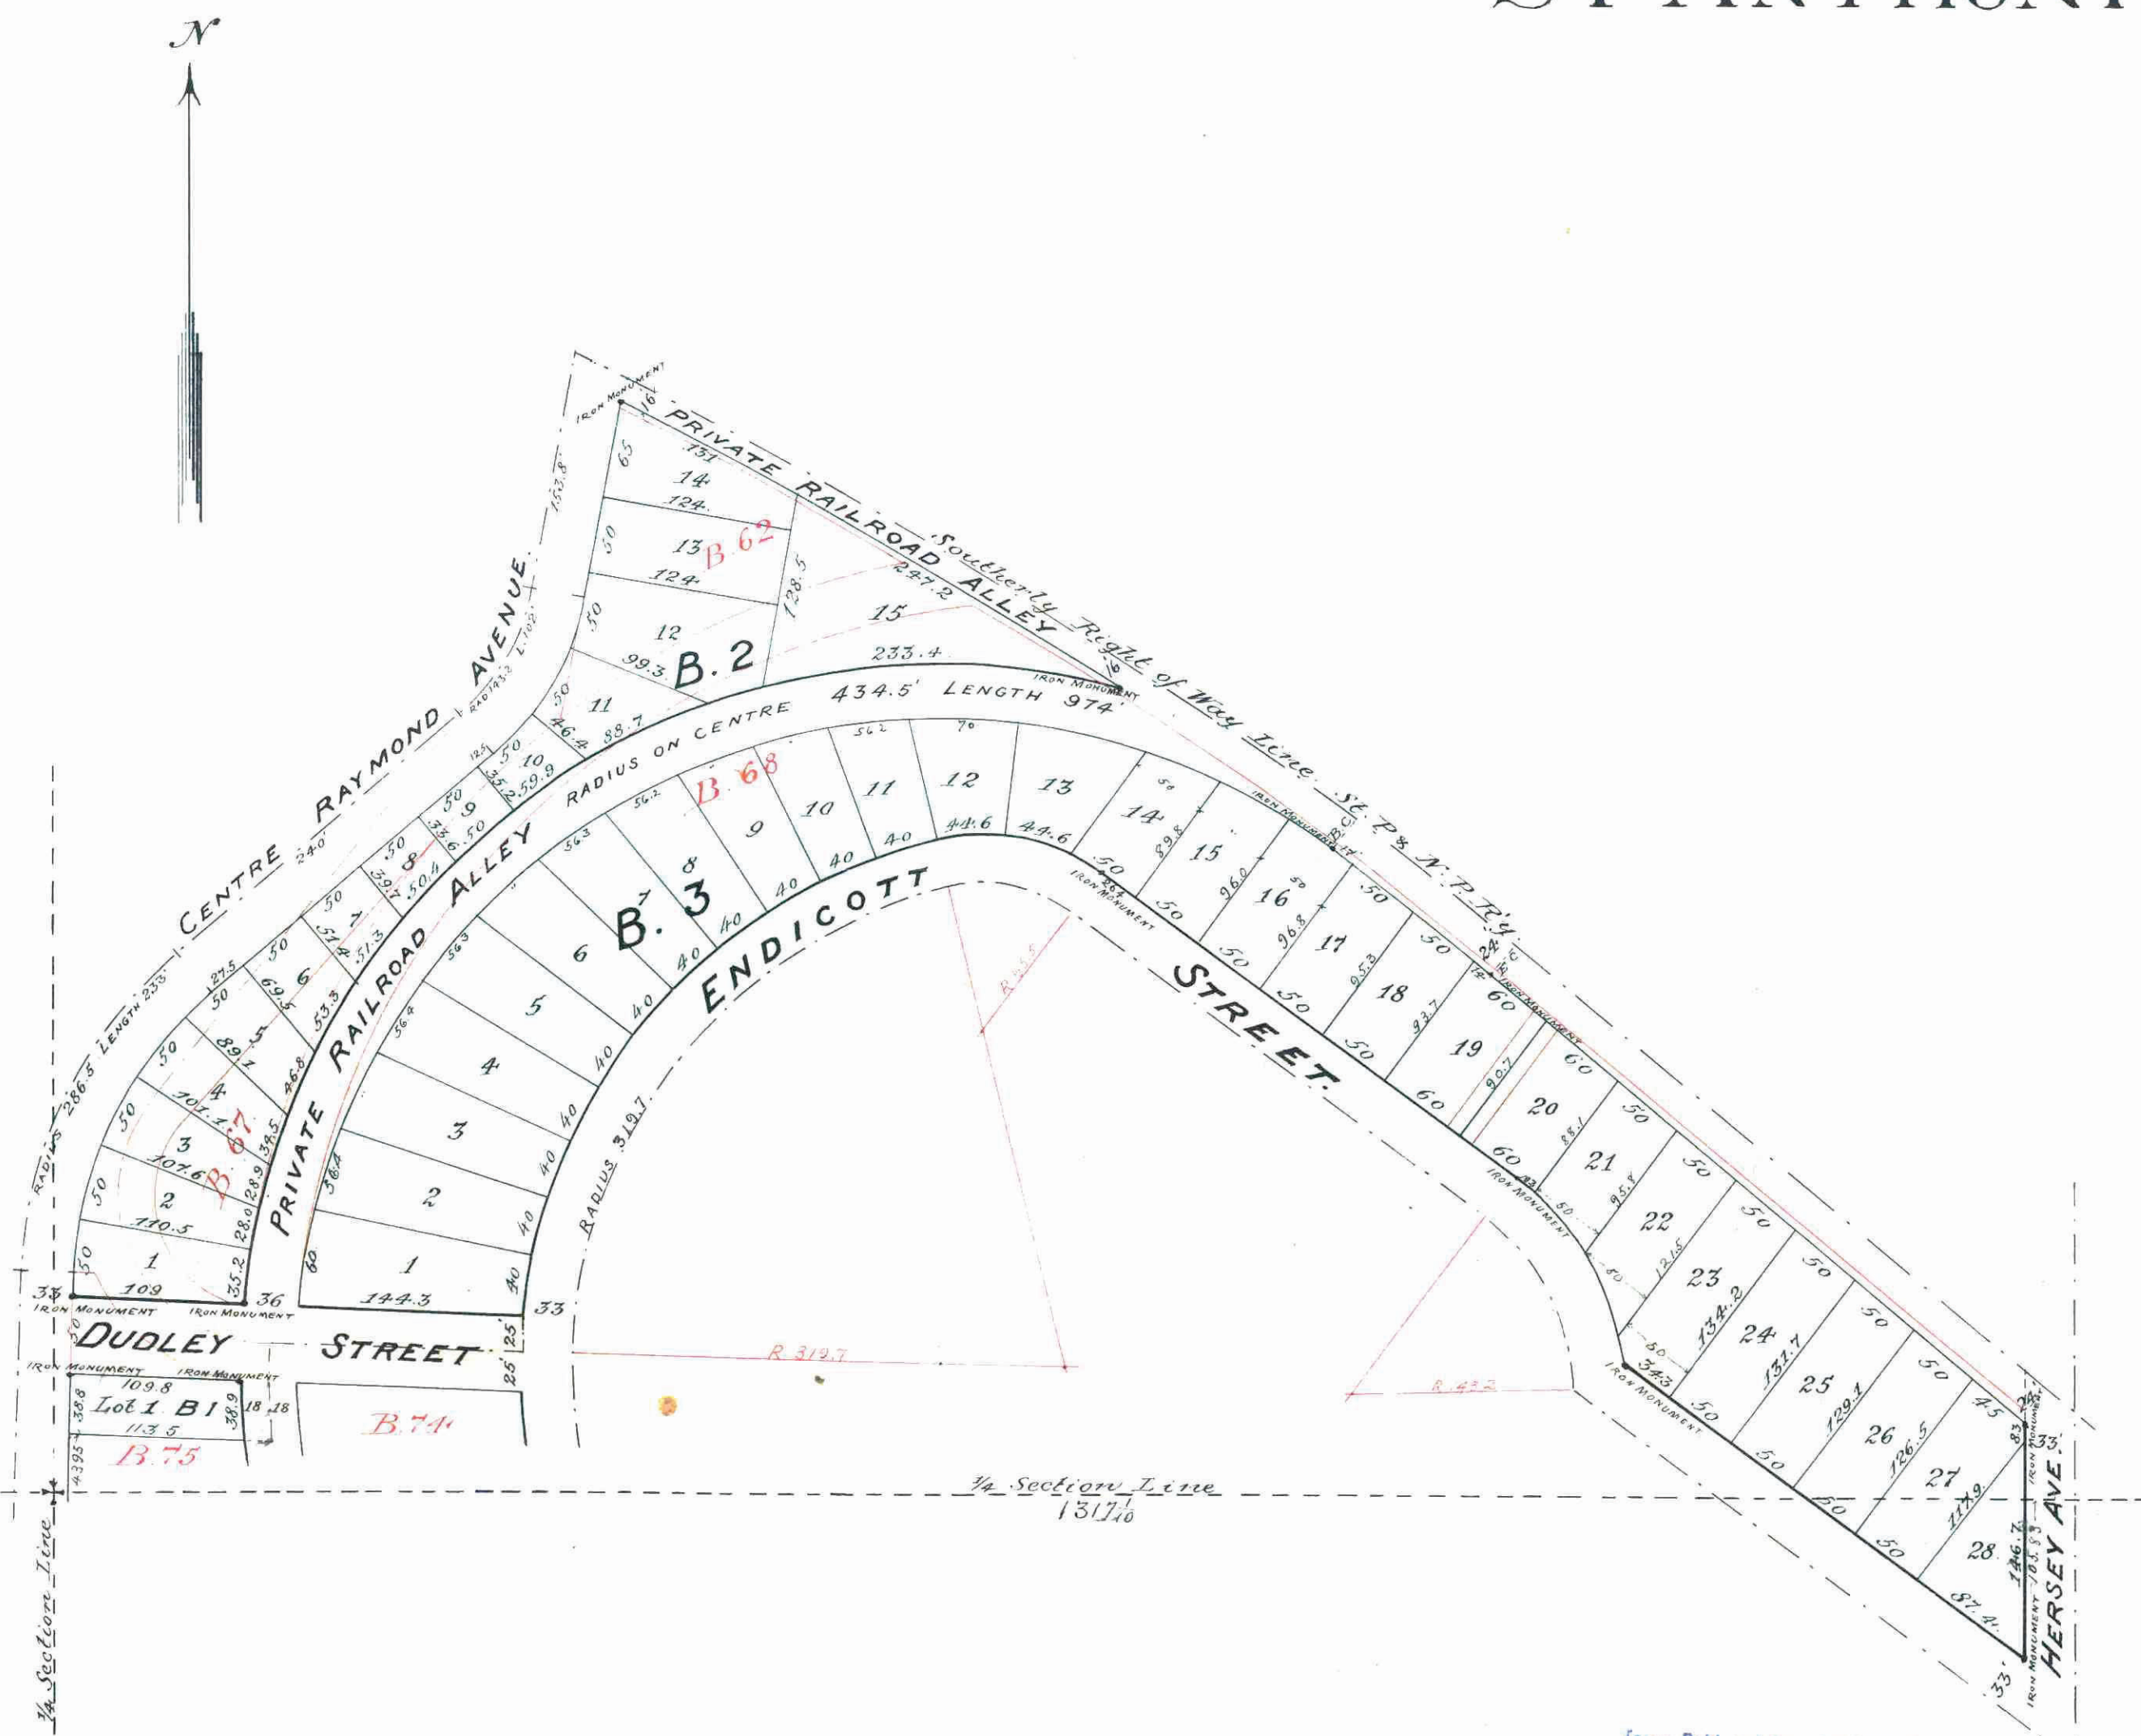

Taxes Paid and Transfer Entered
 SEP 15 1890
 M. F. KAIN, County Auditor

ACCEPTED BY THE COMMON COUNCIL OF THE CITY OF ST. PAUL ON THE 7th DAY OF SEPTEMBER 1890.
Thos. H. Frank
 CITY CLERK.

CITY TREASURER'S OFFICE
 ST. PAUL, MINN.
 SEP 15 1890
 ASSESSMENTS PAID
Wm. J. Lee
 CITY CLERK

Office of the City Engineer
 SEP 15 1890
 A. H. HESLER, COUNTY TREASURER

This plat document is an UNOFFICIAL copy of a Subdivision Plat or Registered Land Survey and is made available for information purposes only.
 To obtain an official copy please contact the Ramsey County Recorder's Office.

