

P. R. McDONNELL'S
 REARRANGEMENT OF BLOCK 62
 BANNING & OLIVER'S
 ADDITION TO WEST SAINT PAUL.

This plat document is an UNOFFICIAL copy of a Subdivision Plat or Registered Land Survey and is made available for information purposes only.



To obtain an official copy please contact the Ramsey County Recorder's Office.

I hereby certify to having surveyed and platted the property described on this map as P. R. McDonnell's Rearrangement of Block 62 of Banning and Oliver's Addition to West Saint Paul, Minnesota, and have placed iron monuments at the corners as shown on this map and the same is correct.
 J. B. Hawley,
 Surveyor.

I hereby certify that I have examined the above plat and recommend its approval.
 Feb 19 1884.
 W. B. J. J. J.
 City Engineer

Approved this 4th day of Feb 9 1884
 J. A. J. J. J. } Plat Commission.
 J. A. J. J. J. }
 J. A. J. J. J. }
 Accepted by the Common Council of the City of Saint Paul, on the 14th day of Feb 1884
 J. A. J. J. J. } City Clerk.


We Patrick Randal McDonnell and Mary Ellen McDonnell his wife - the owners of Block 62 of Banning and Oliver's Addition to West Saint Paul, Minnesota, hereby certify to having caused the same to be surveyed and platted as P. R. McDonnell's Rearrangement of Block 62 of Banning and Oliver's Addition to West Saint Paul, Minnesota, and do hereby dedicate to the public and for the public use forever, the Alley as on this map laid out and designated. In witness whereof we have placed our hands and seals this 2^d day of February 1884.
 P. R. McDonnell
 Mary E. McDonnell

In the presence of
 County of Ramsey } ss.
 State of Minnesota }
 On the 2^d day of February 1884, Personally appeared before me Patrick Randal McDonnell and Mary Ellen McDonnell his wife - to me well known to be the identical persons who executed the above certificate and acknowledged the same to be their free act and deed.
 A. E. Heywood
 Notary Public
 Ramsey County.

State of Minnesota } ss. Be it known that on this day
 County of Ramsey }
 of February A. D. 1884, personally came before me J. B. Hawley, to me well known to be the identical person who executed the foregoing Surveyors Certificate, and he acknowledged that he executed the same freely and voluntarily for the uses and purposes therein expressed.
 J. B. Hawley
 Notary Public
 Ramsey Co.
 Minn.

CITY TREASURERS OFFICE
 ST. PAUL, MINN.
 APR 12 1884
 RECEIVED PAID

Taxes paid & transferred
 April 17th 1884
 J. A. J. J. J.
 Cashier

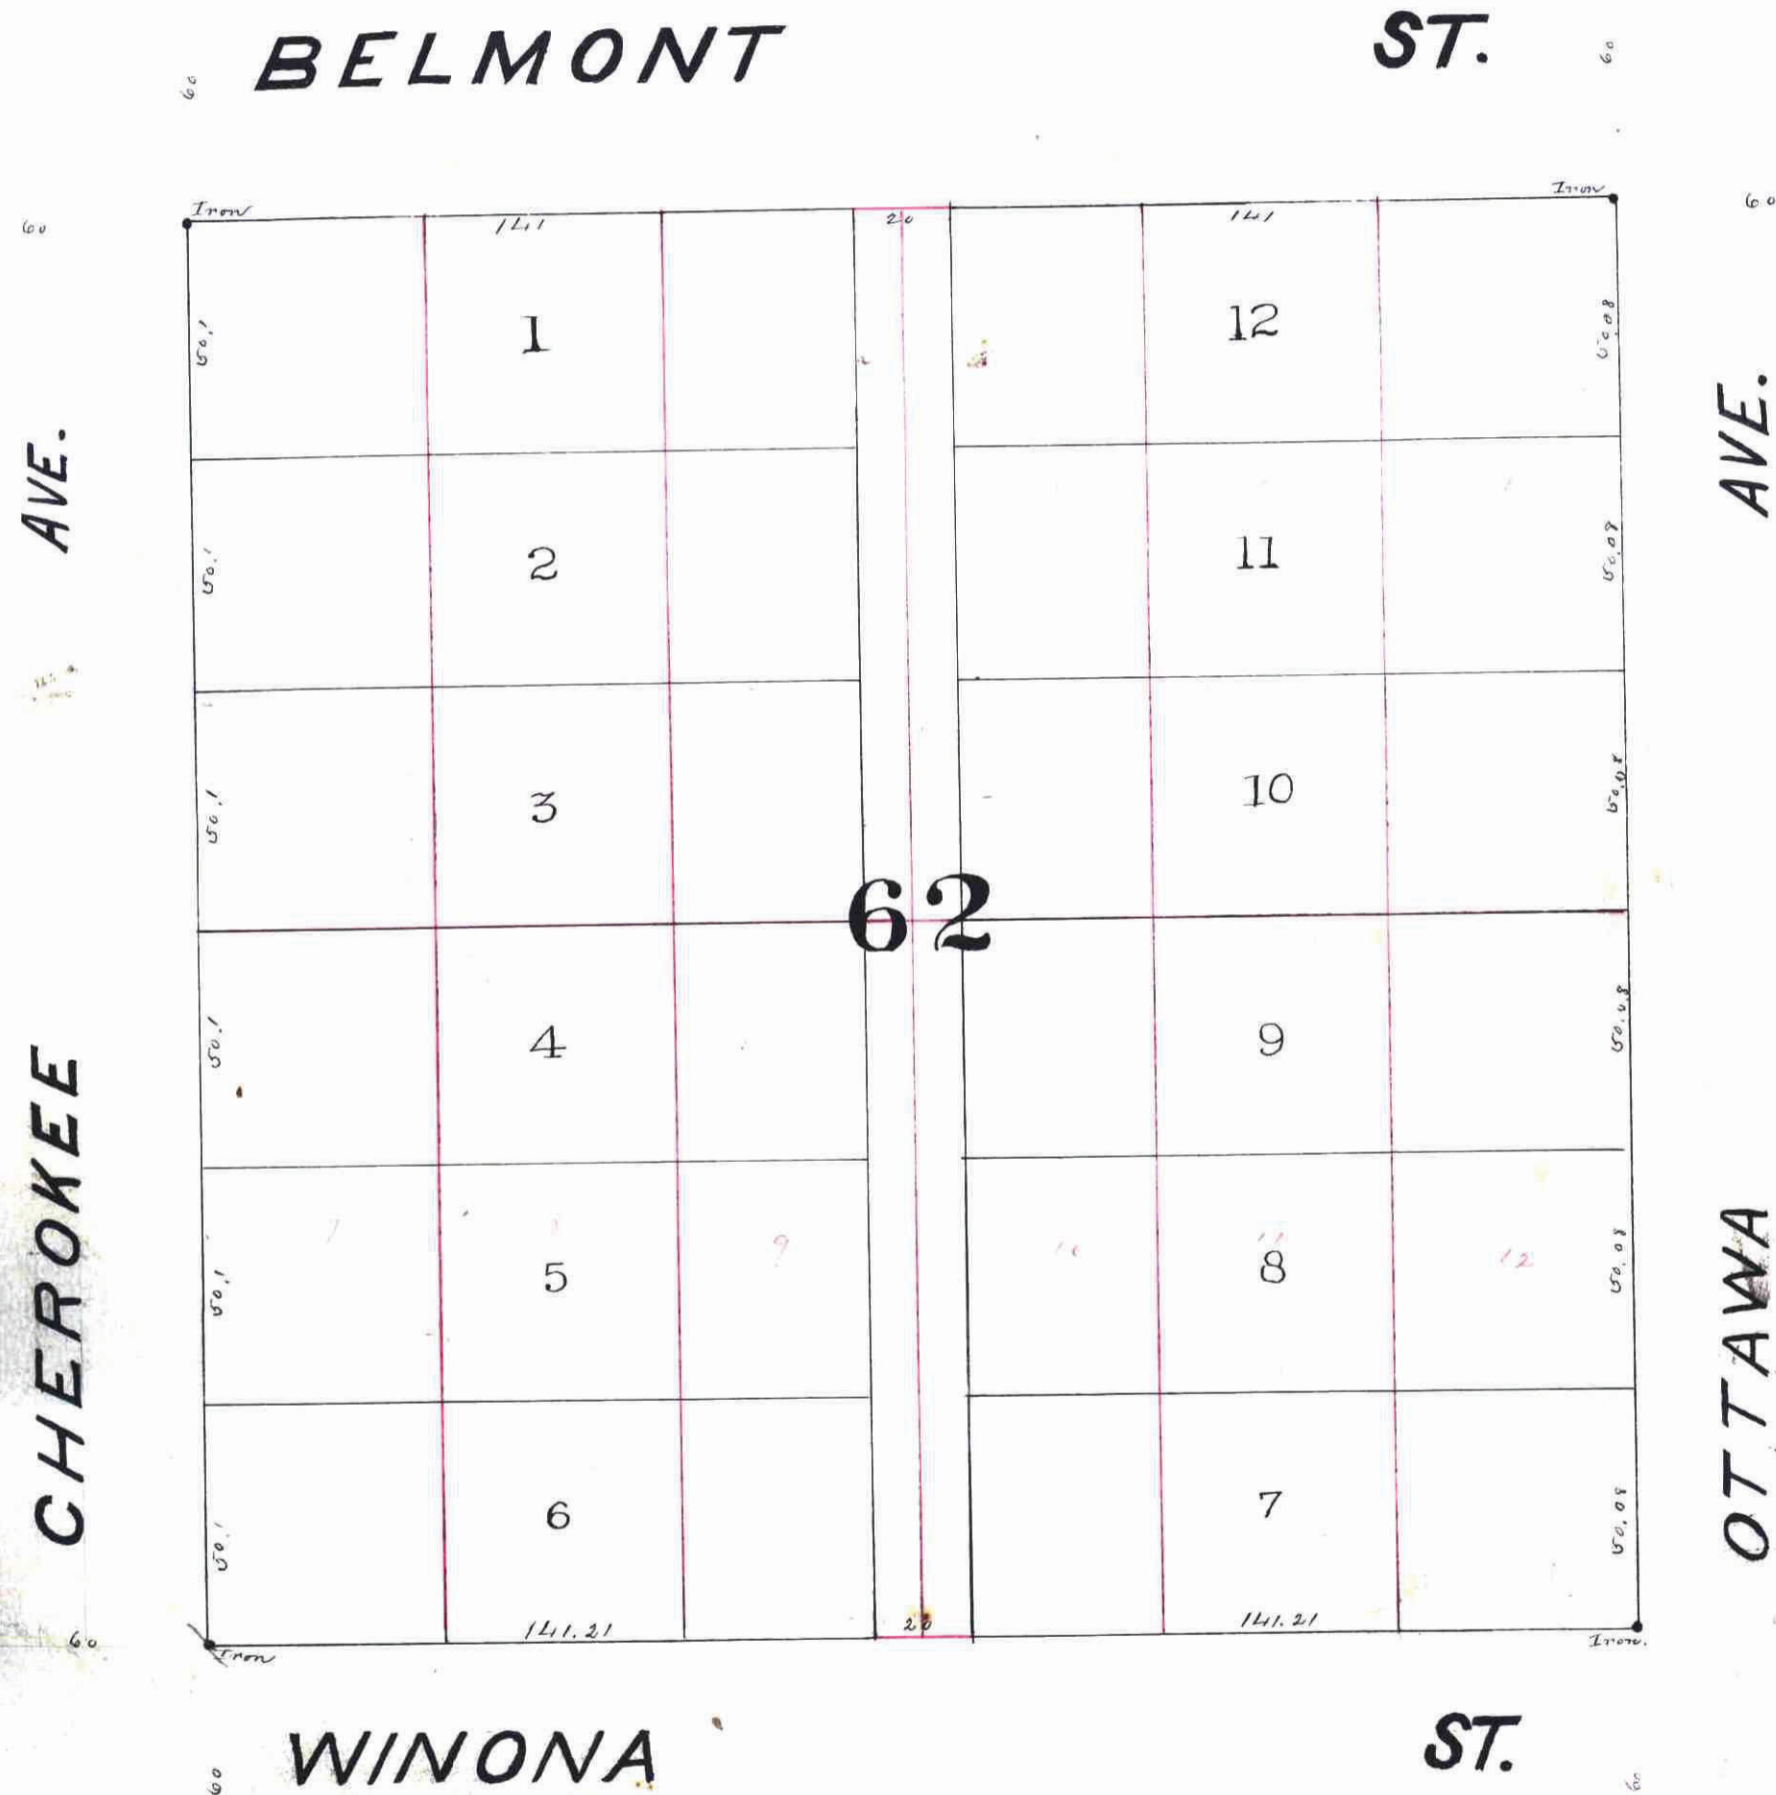

Note: The red lines show the original subdivisions of Block 62

STATE OF MINNESOTA, ss.
 County of Ramsey,
 OFFICE OF THE REGISTER OF DEEDS.
 This is to certify that the within instrument was filed for Record in this office, at St. Paul, on the 12th day of April A. D. 1884 at 2 o'clock P. M., and that the same was duly recorded in Book 26 of Plats pages 17
 Register of Deeds.
 By _____ Deputy.